




242+50

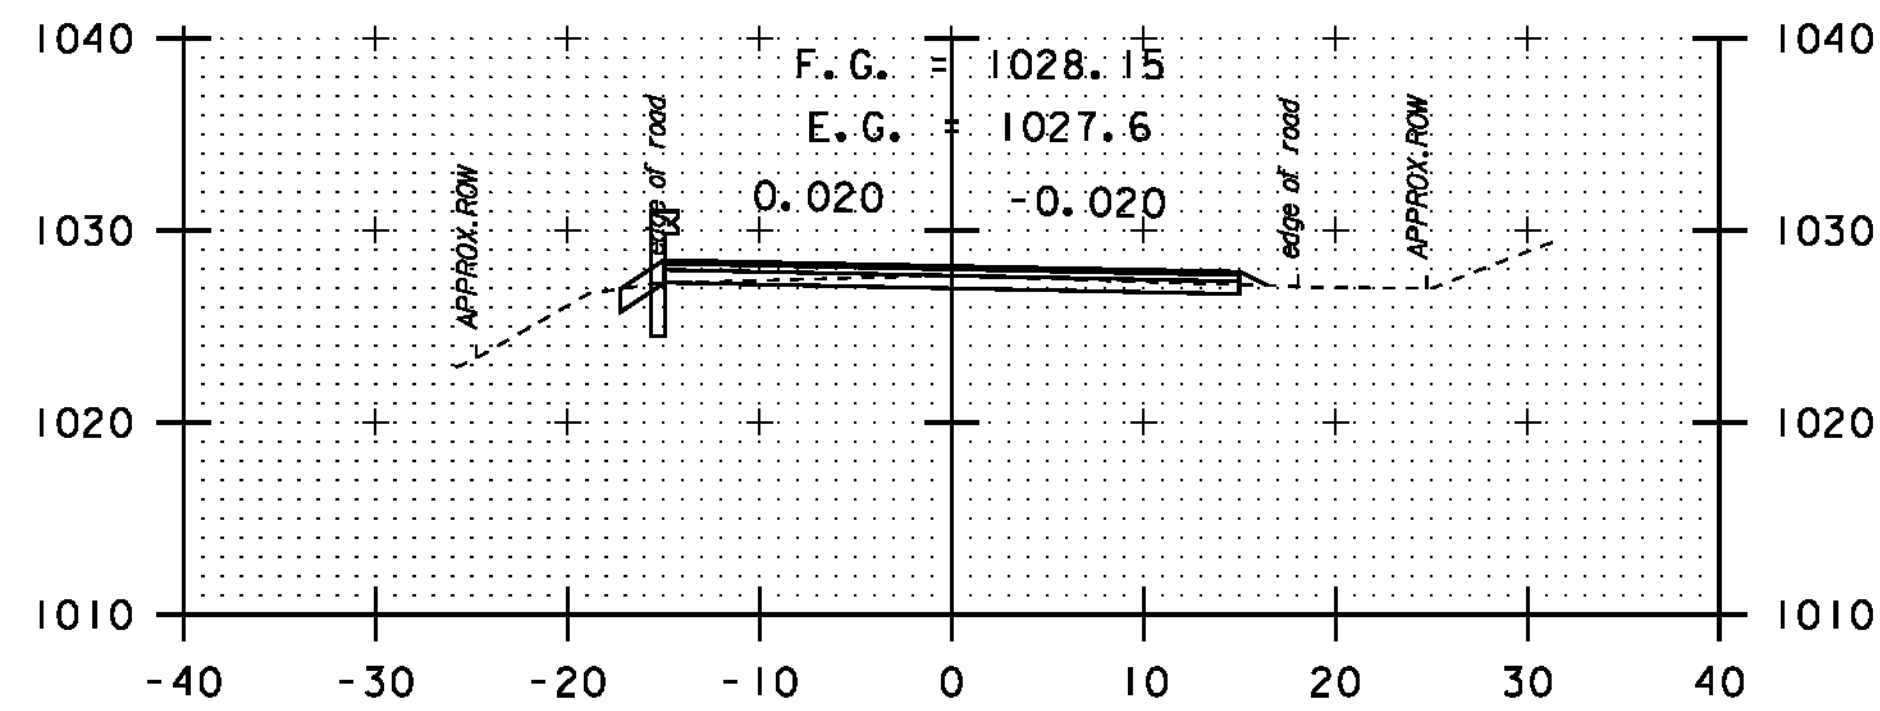


242+00

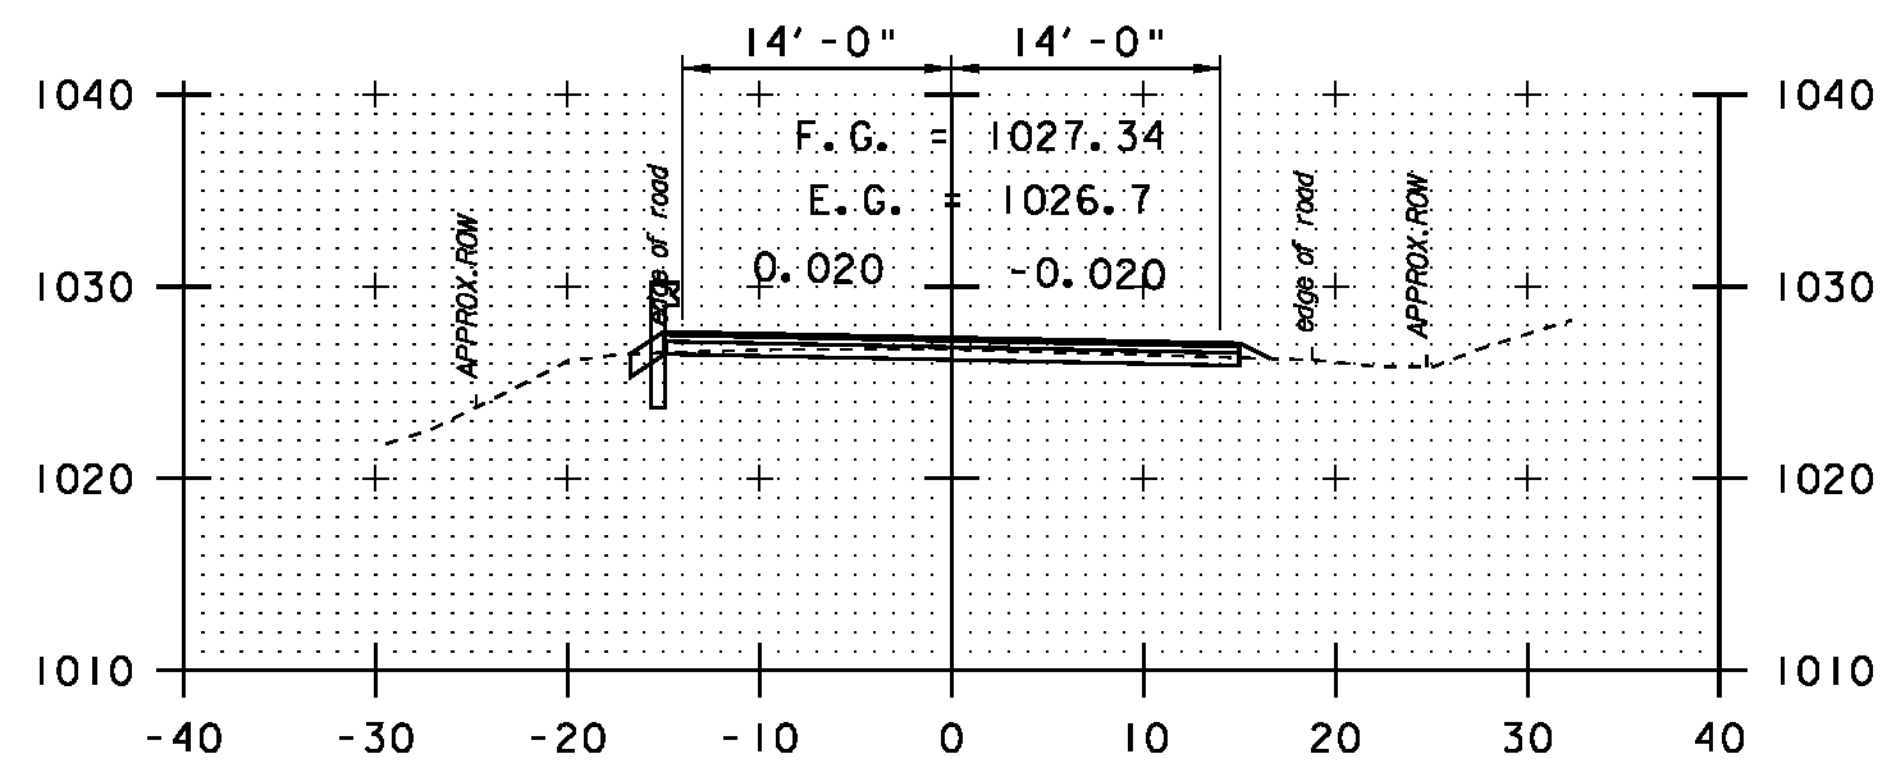


241+75

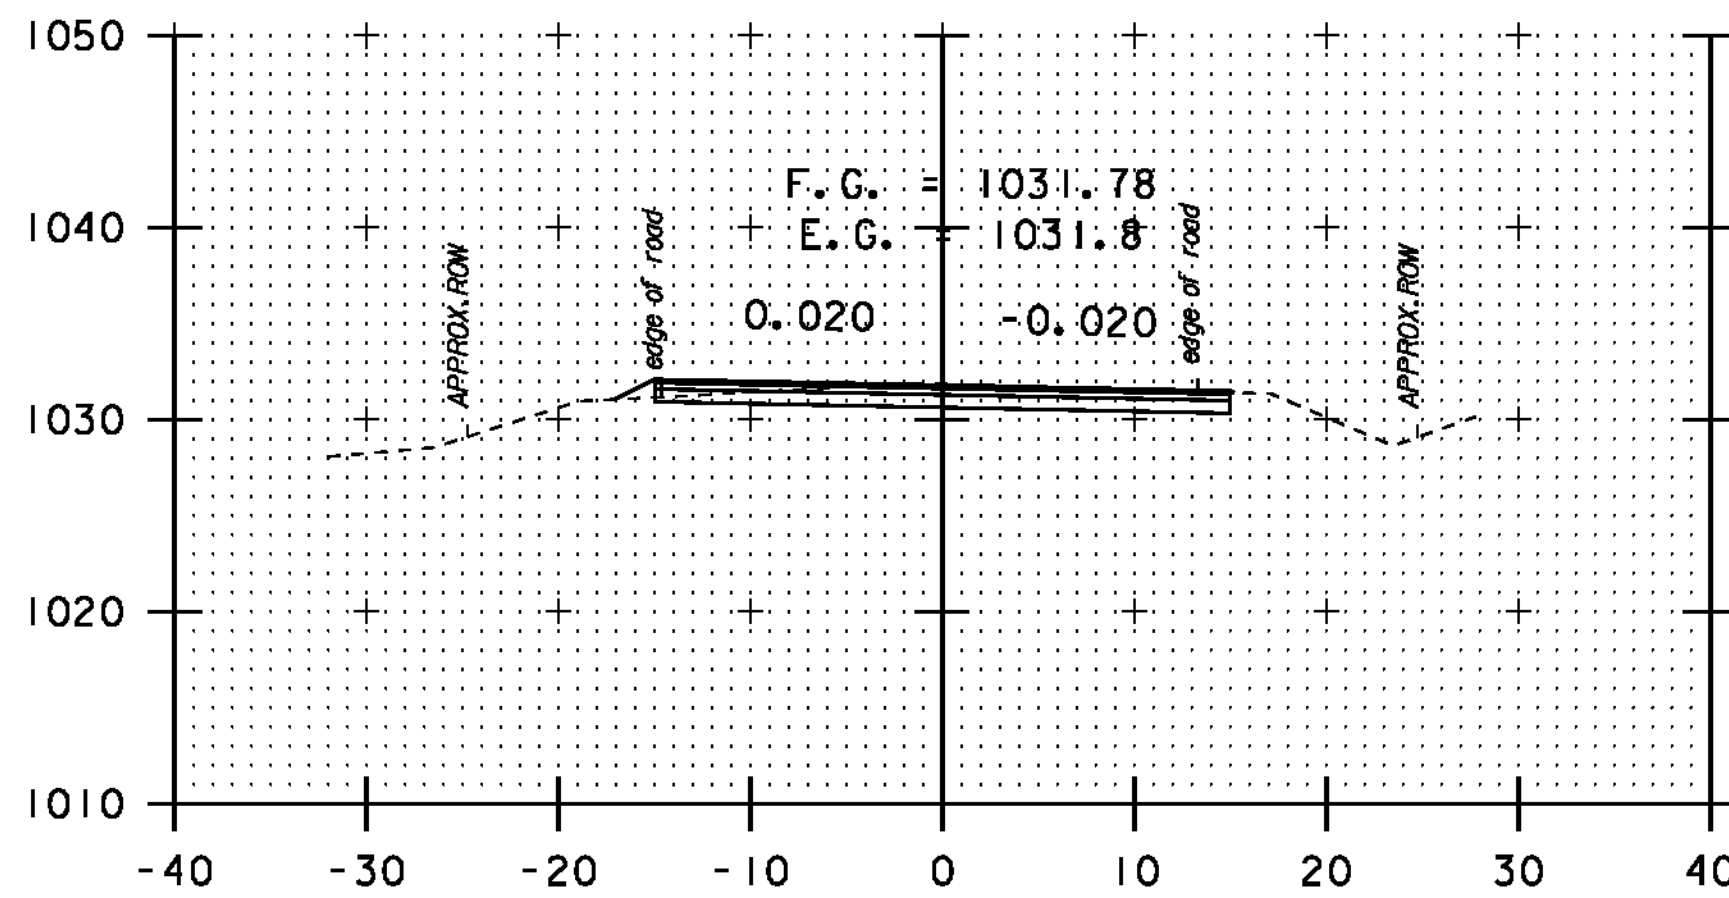


244+00

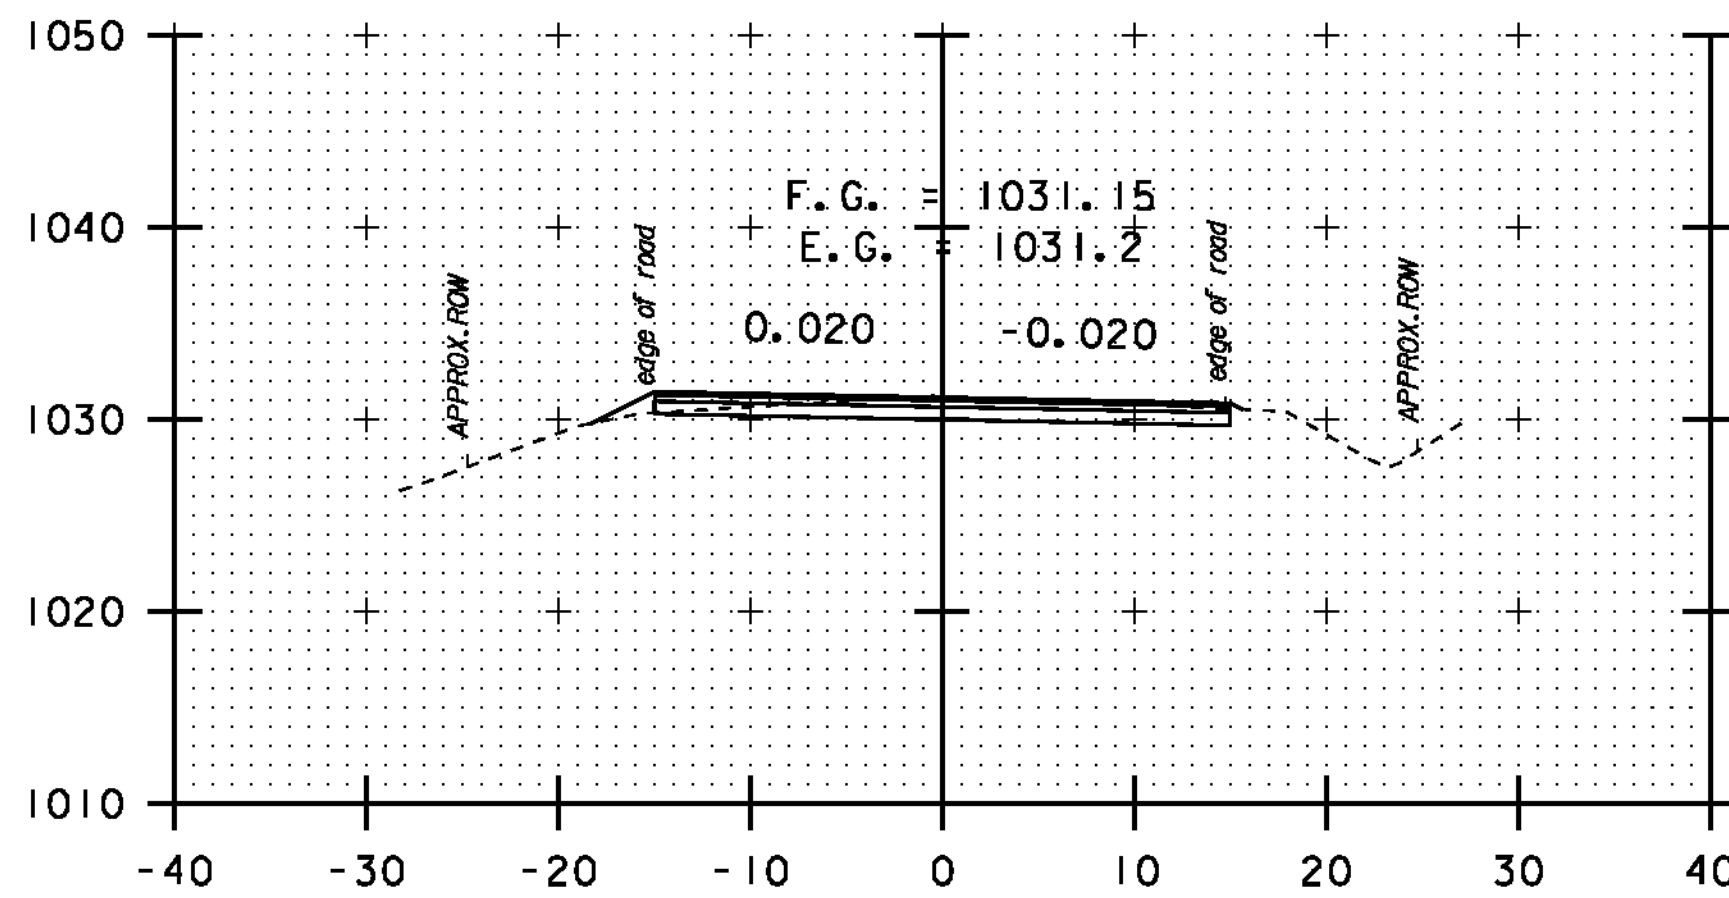


243+50

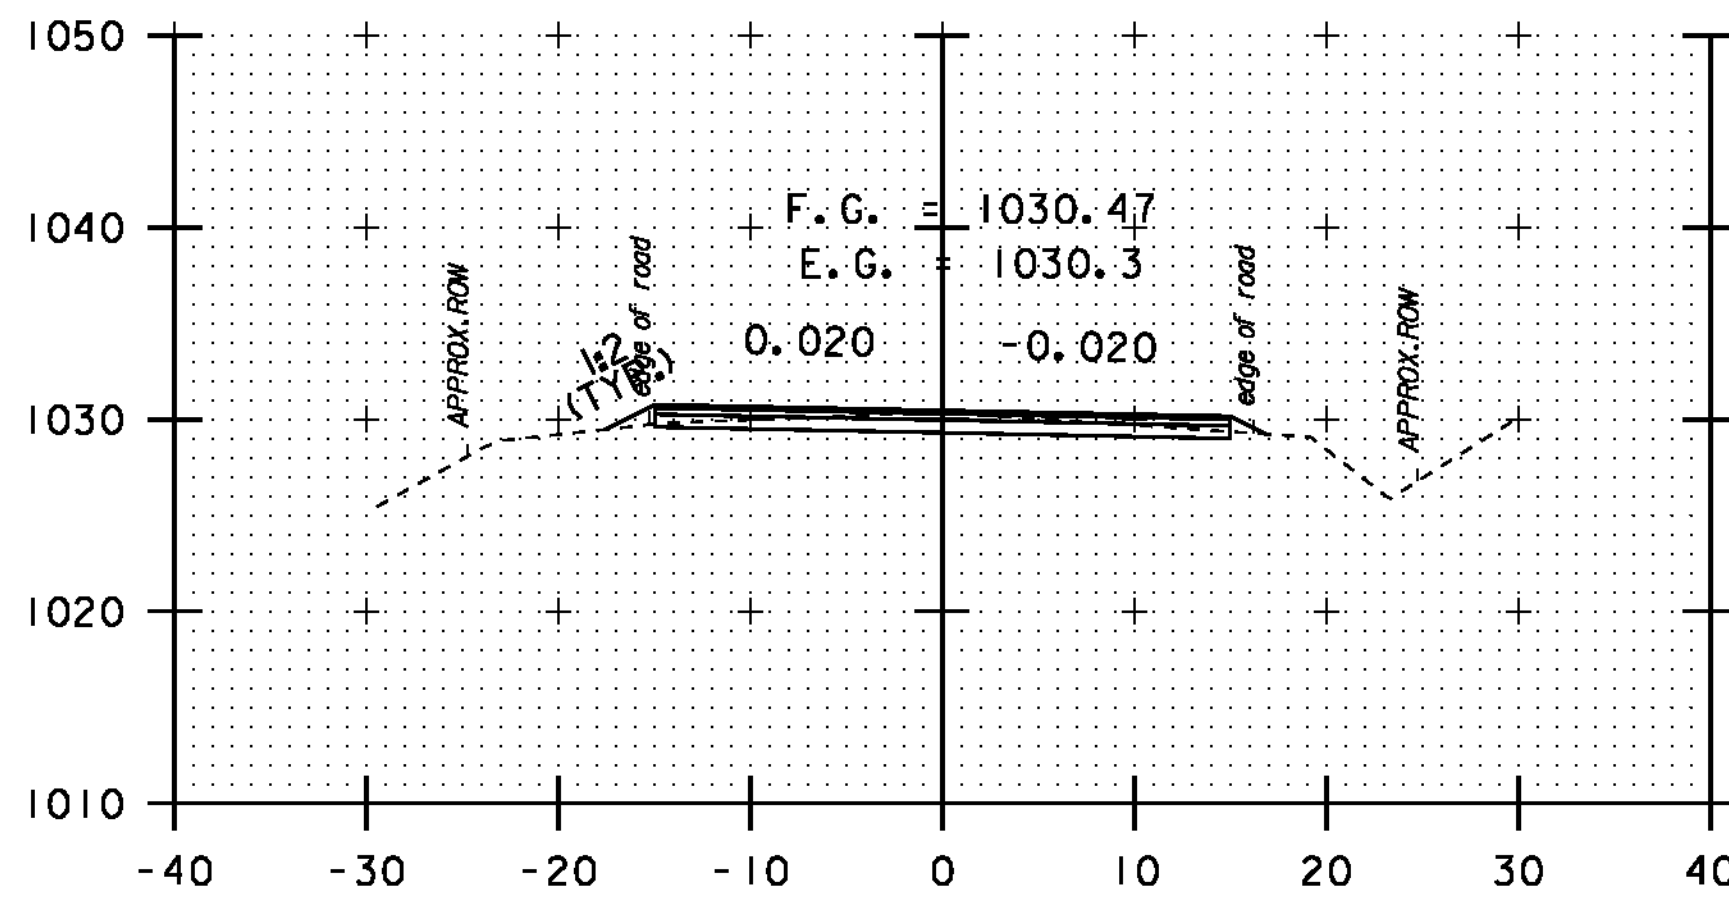


243+00

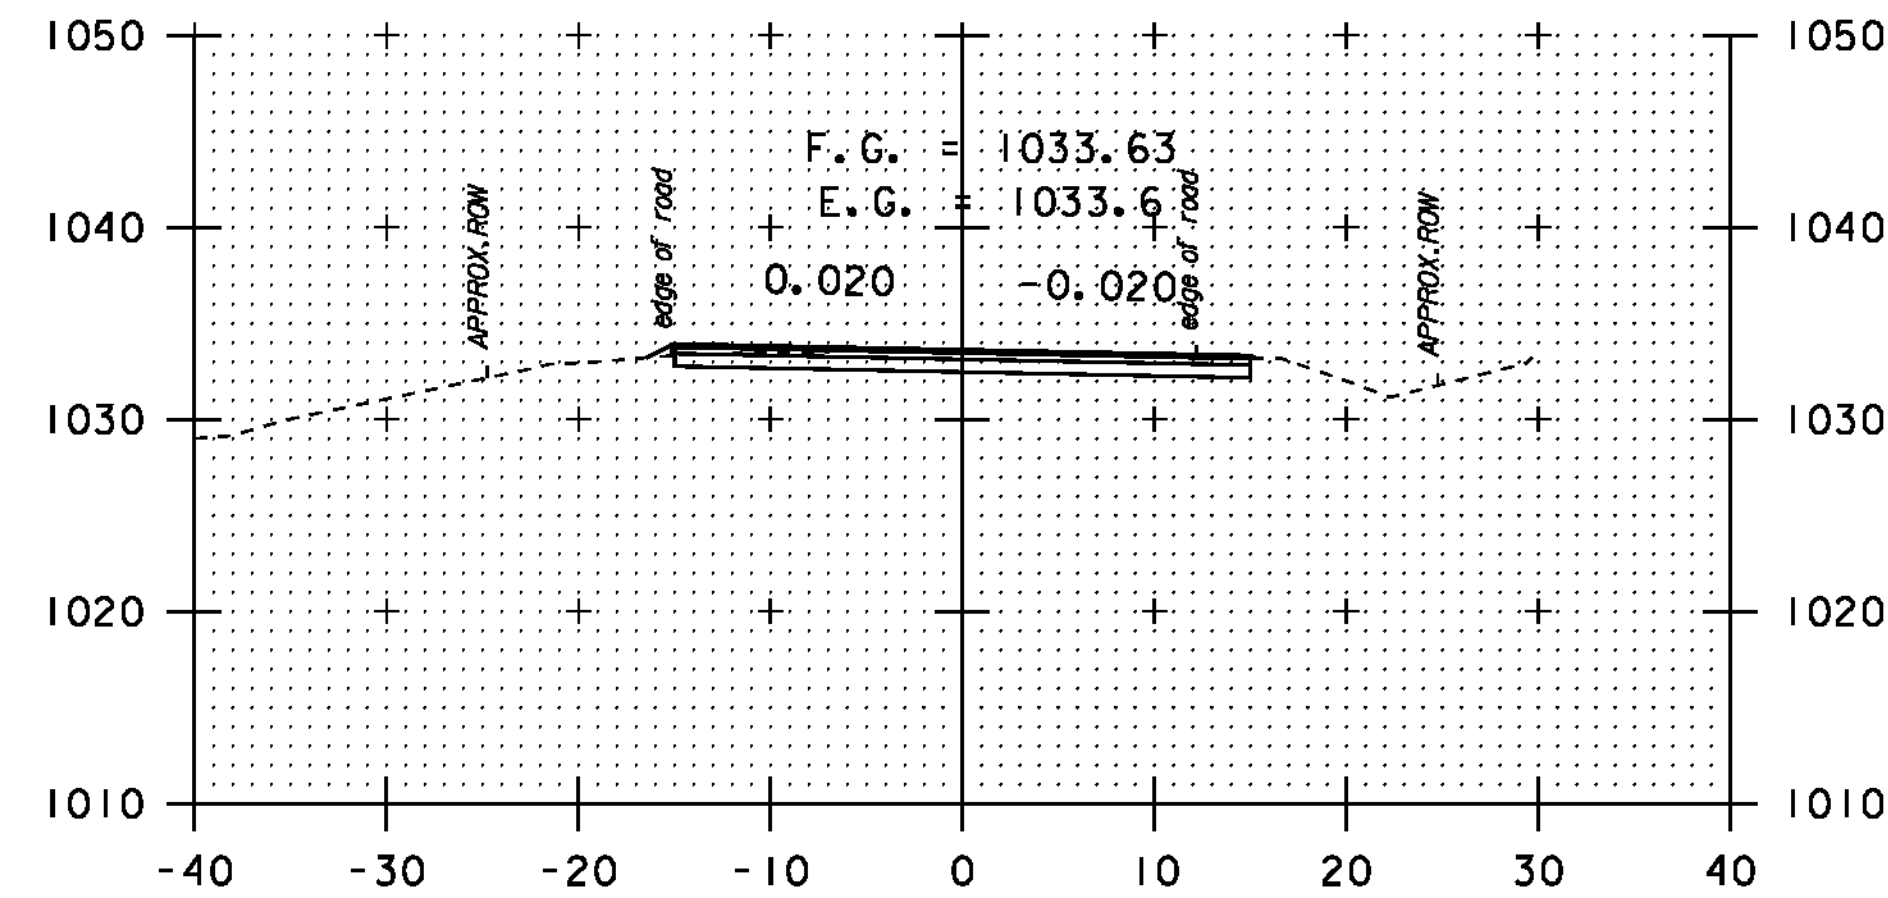

245+50

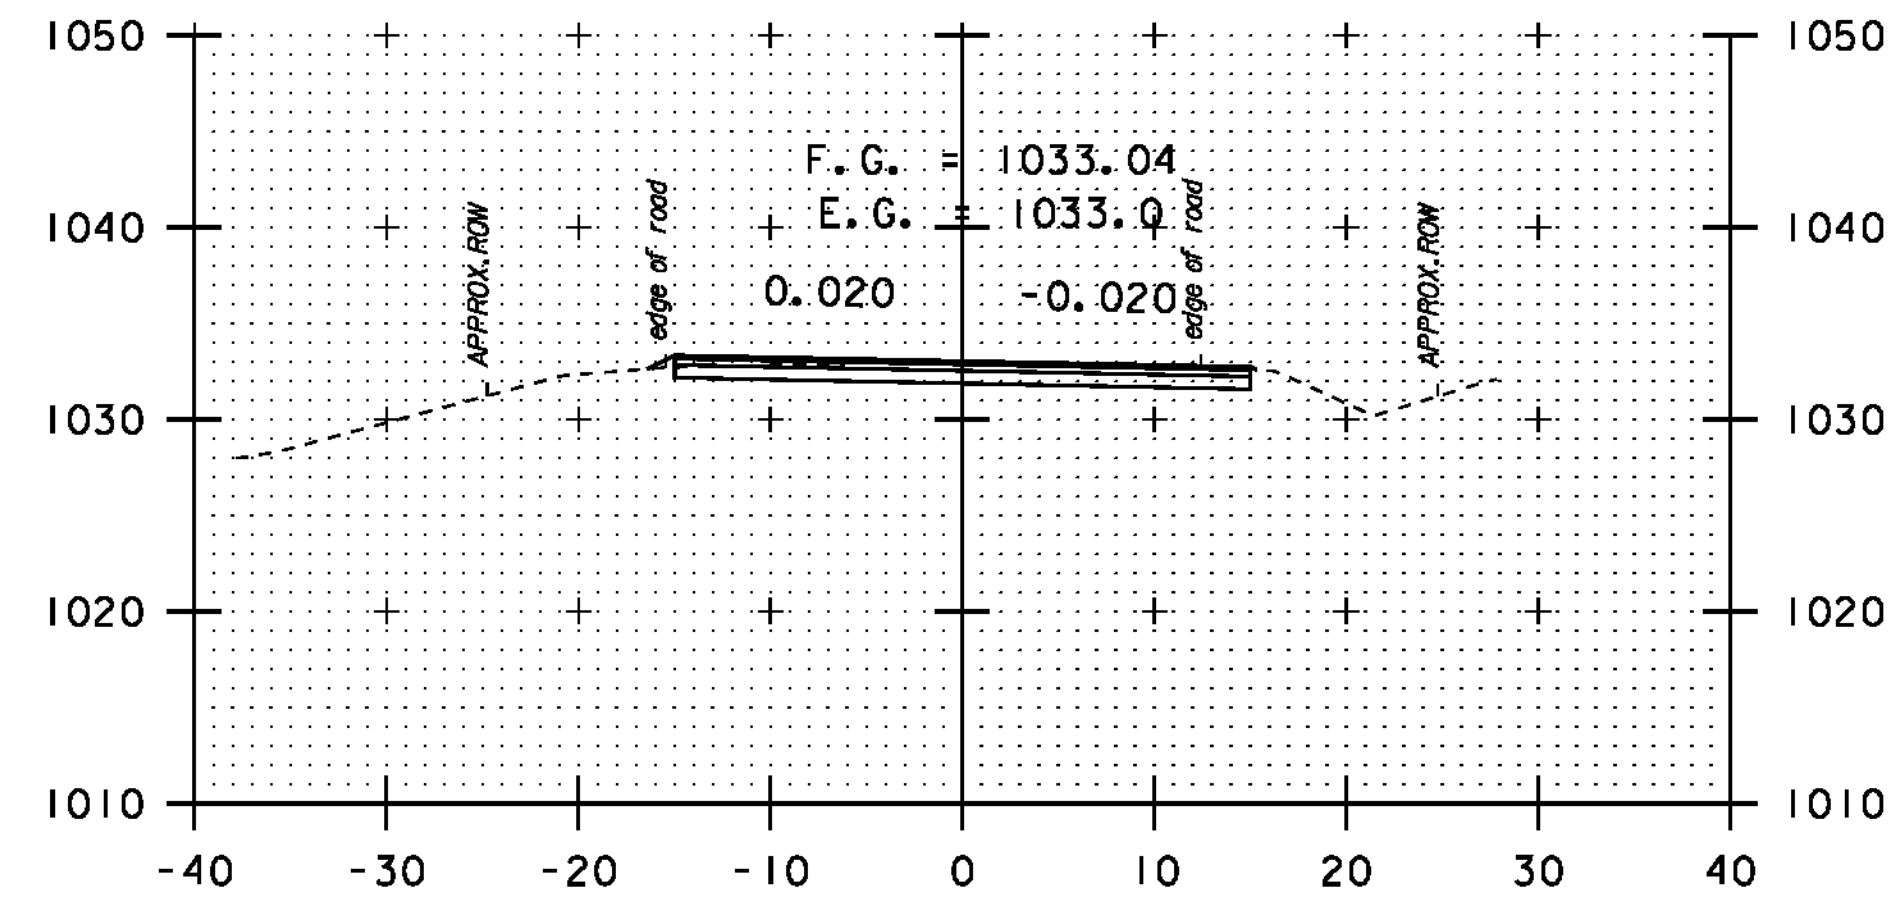

245+00

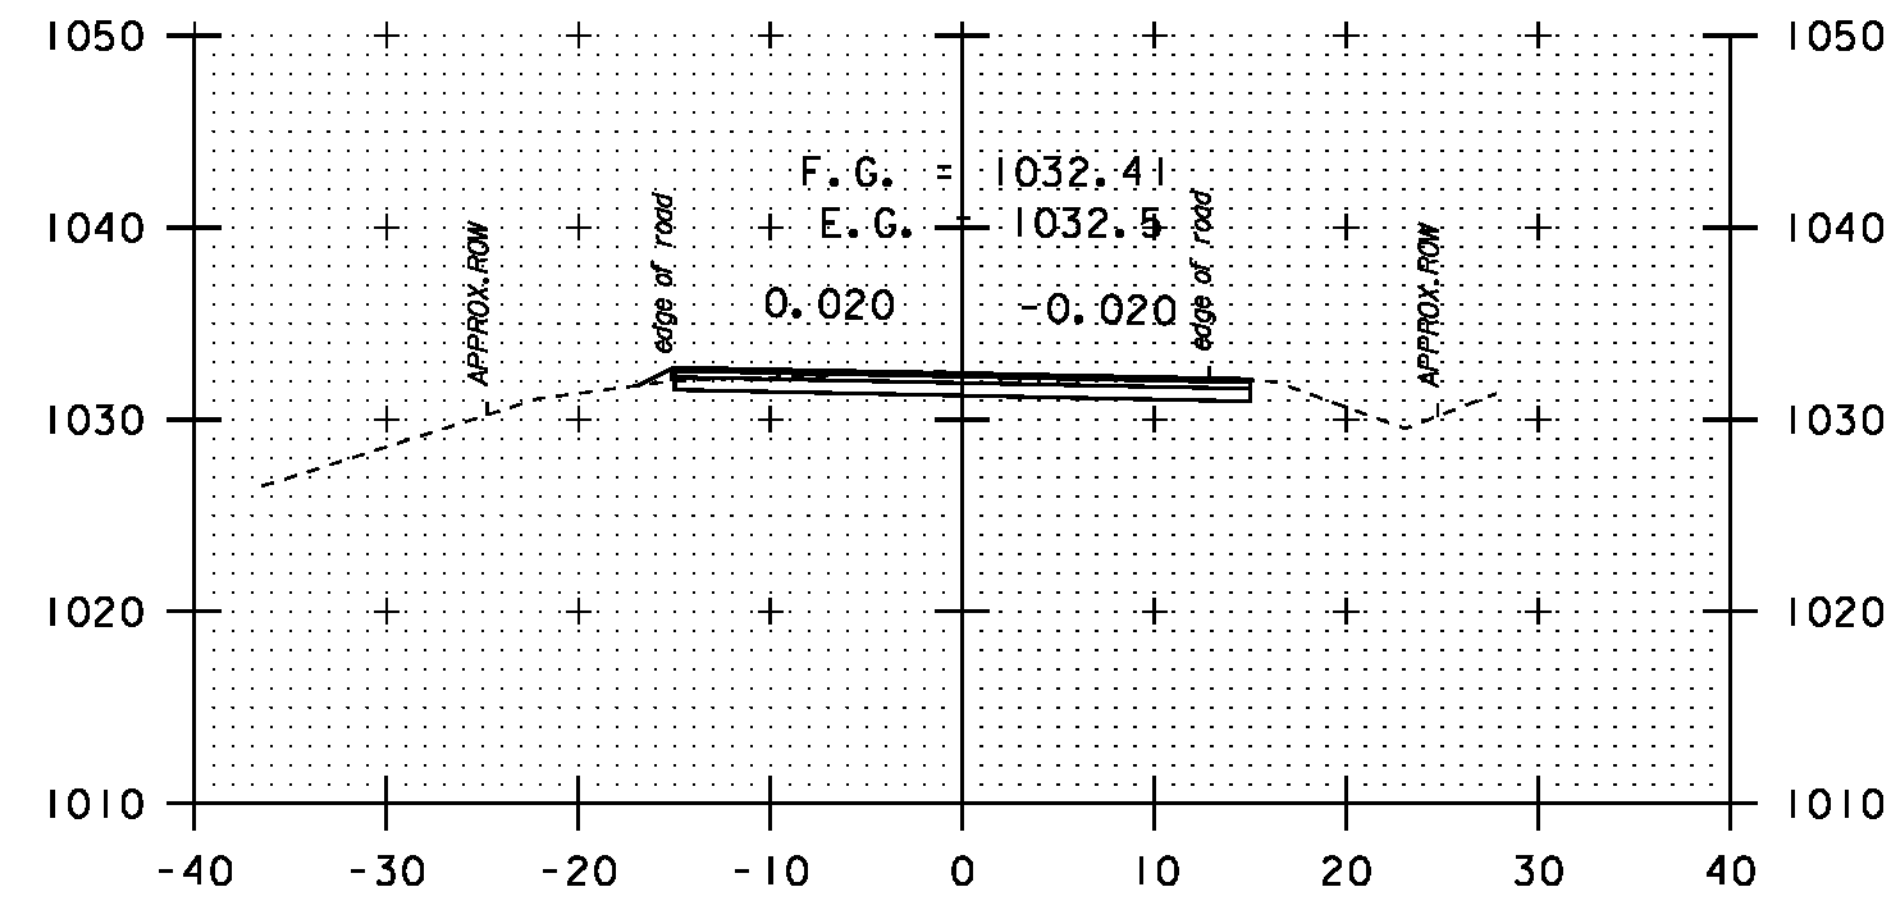

244+50

DATUM	NAVD 88
	NAD 83



STA. 241+75
-
STA. 245+50

CROSS SECTION SHEET 15

PROJECT NAME:	NEWPORT-COVENTRY-NEWPORT
PROJECT NUMBER:	STP 2802(I)
FILE NAME:	08b158.dgn
PROJECT LEADER:	CDL
DESIGNED BY:	BMB
PLOT FILE:	08b158-88.1
PLOT DATE:	8/3/2011
DRAWN BY:	BMB
CHECKED BY:	EPD
SHEET	88 OF 134