




247+00

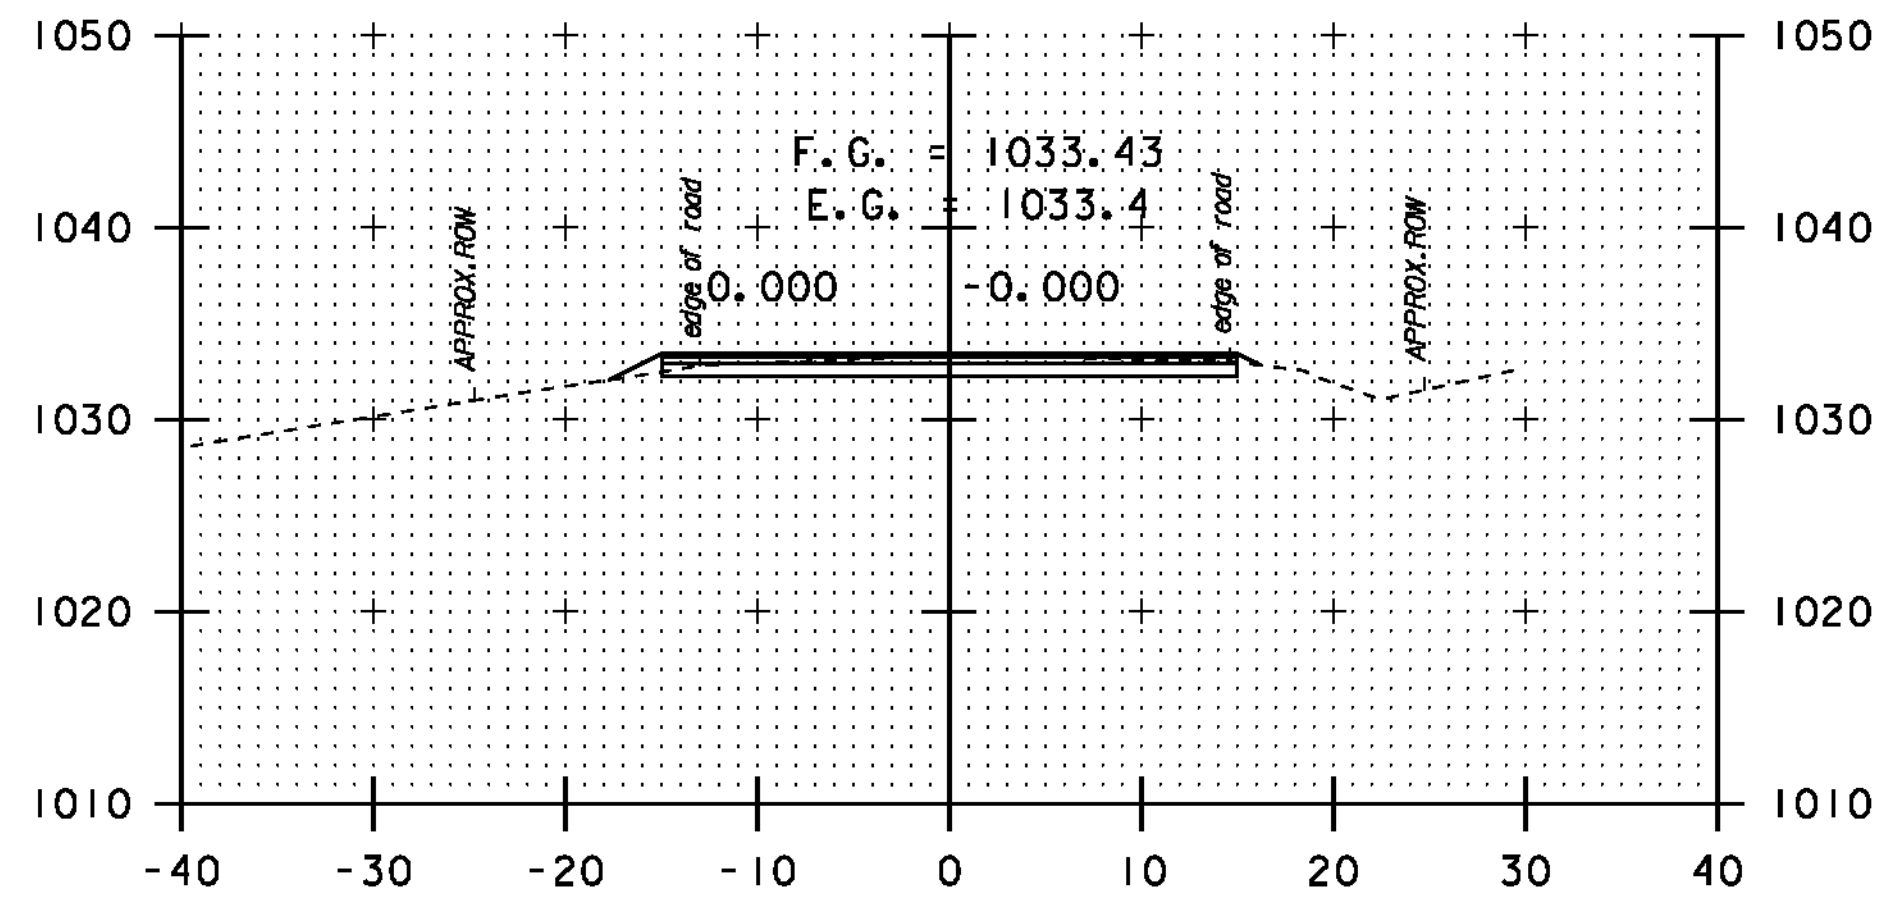


248+44

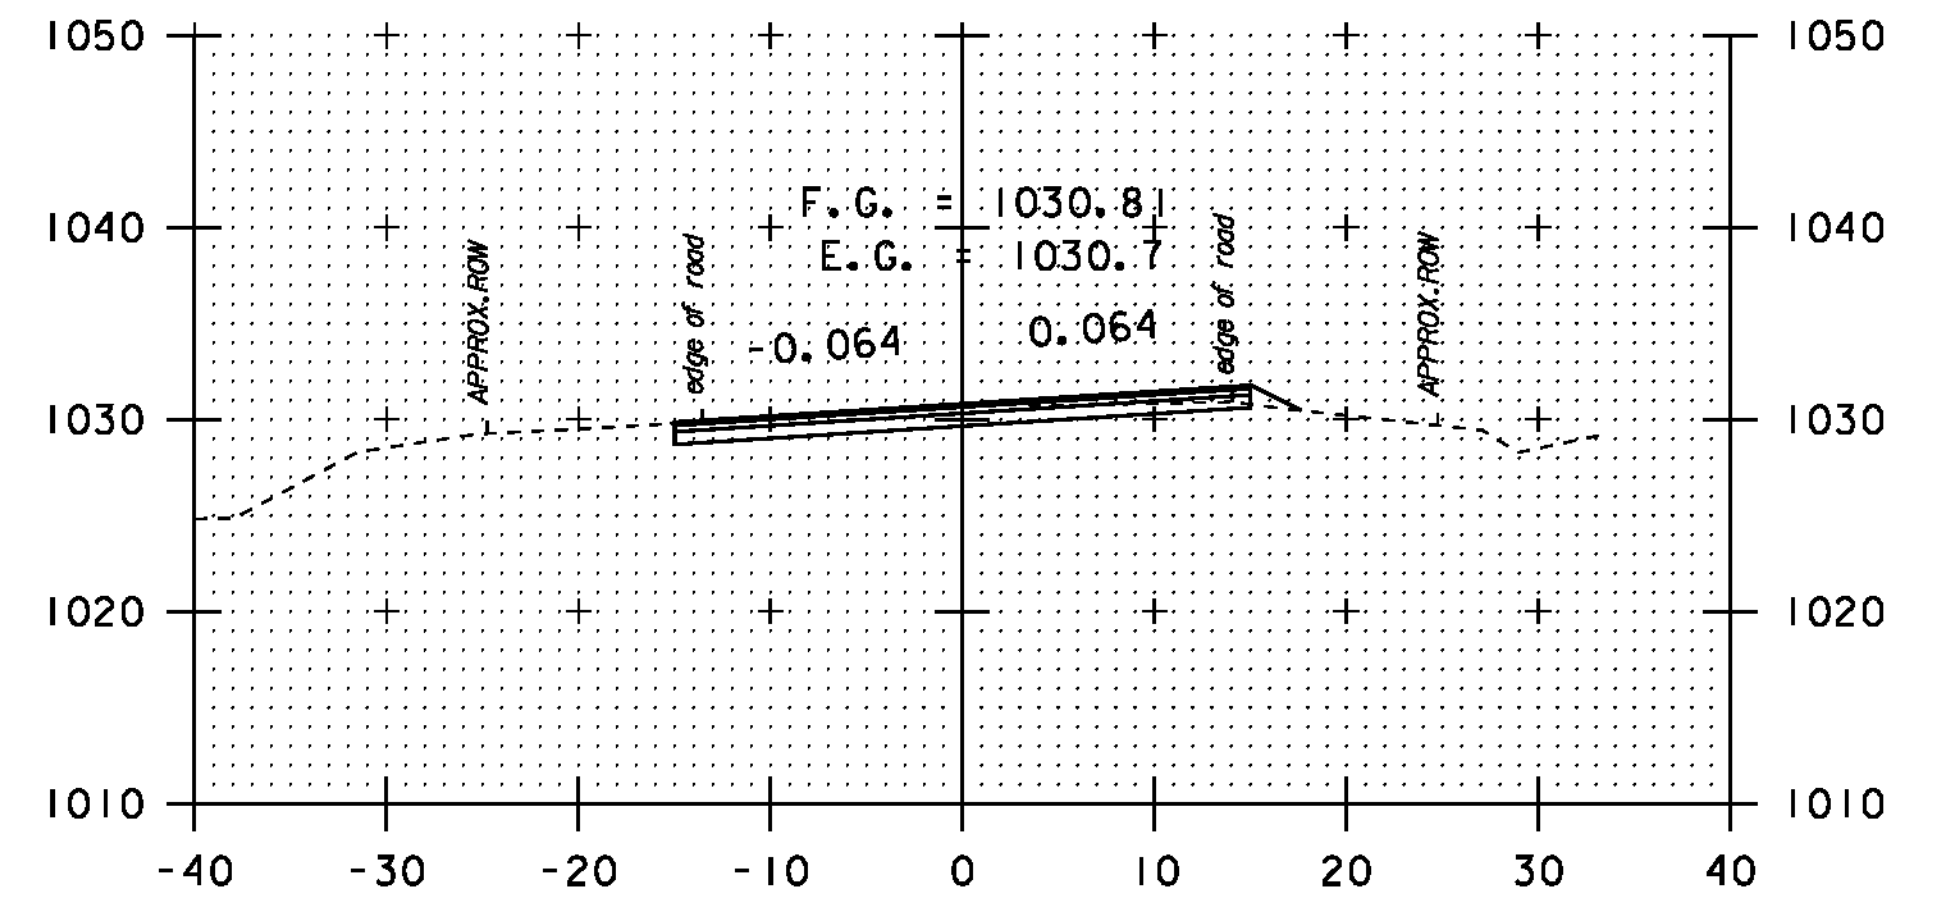


250+50

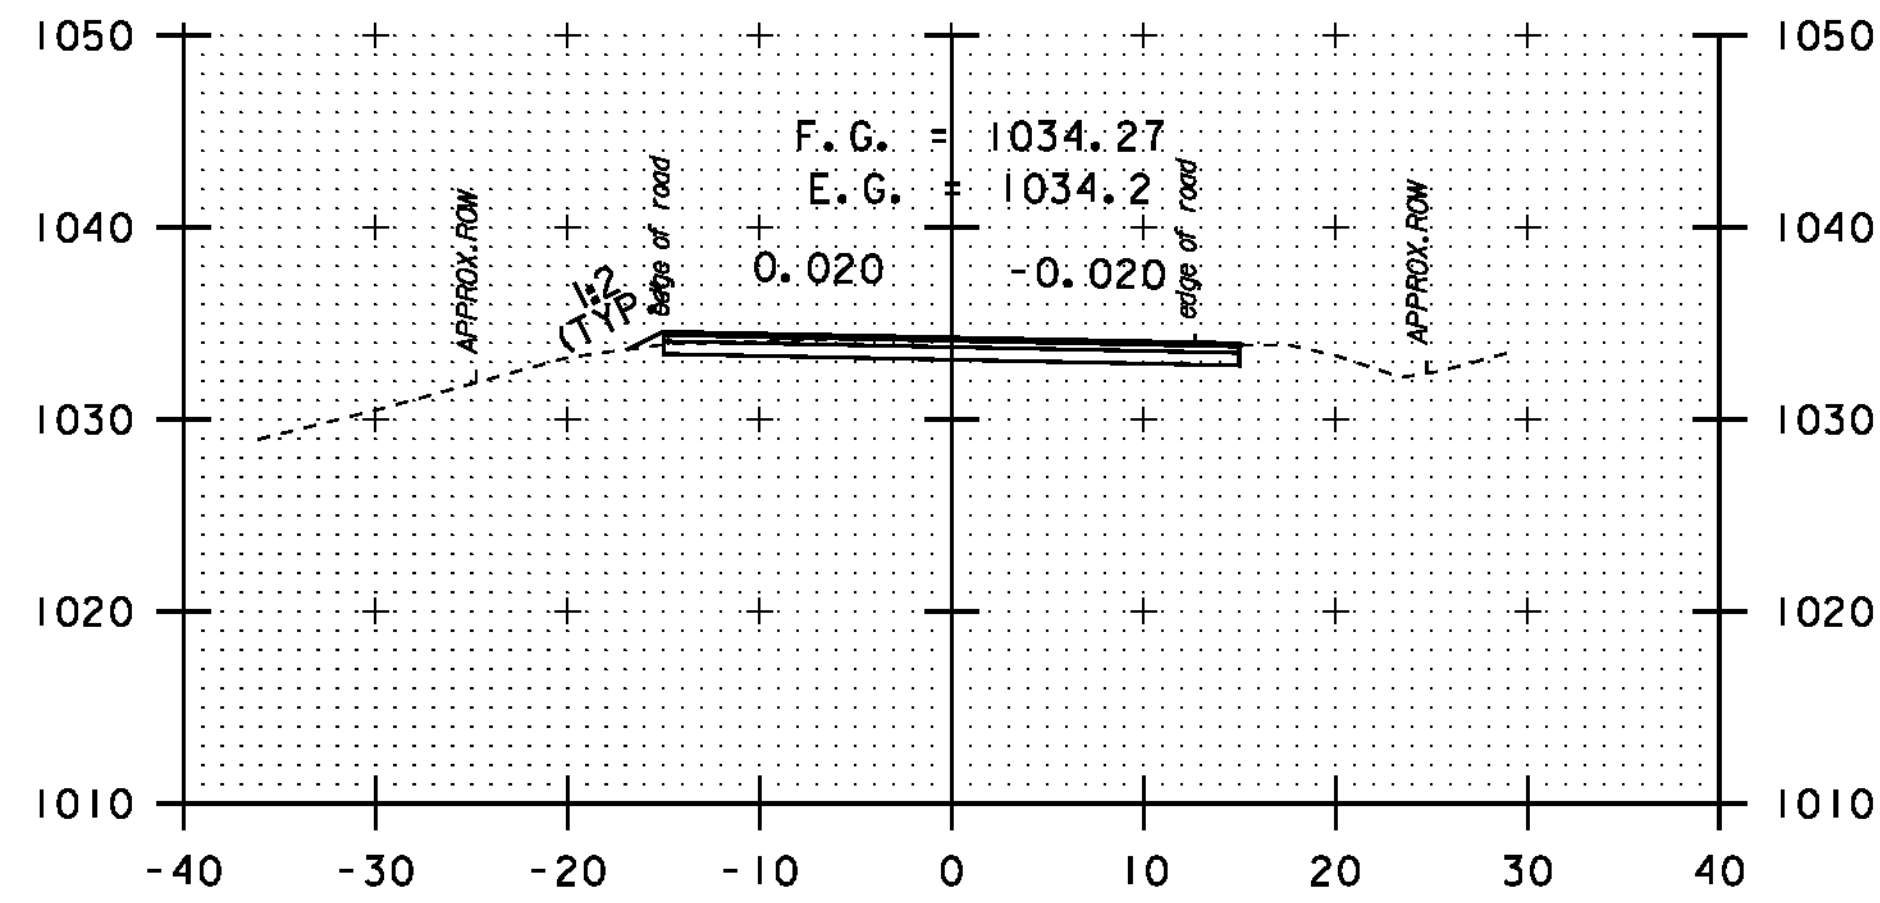


246+50

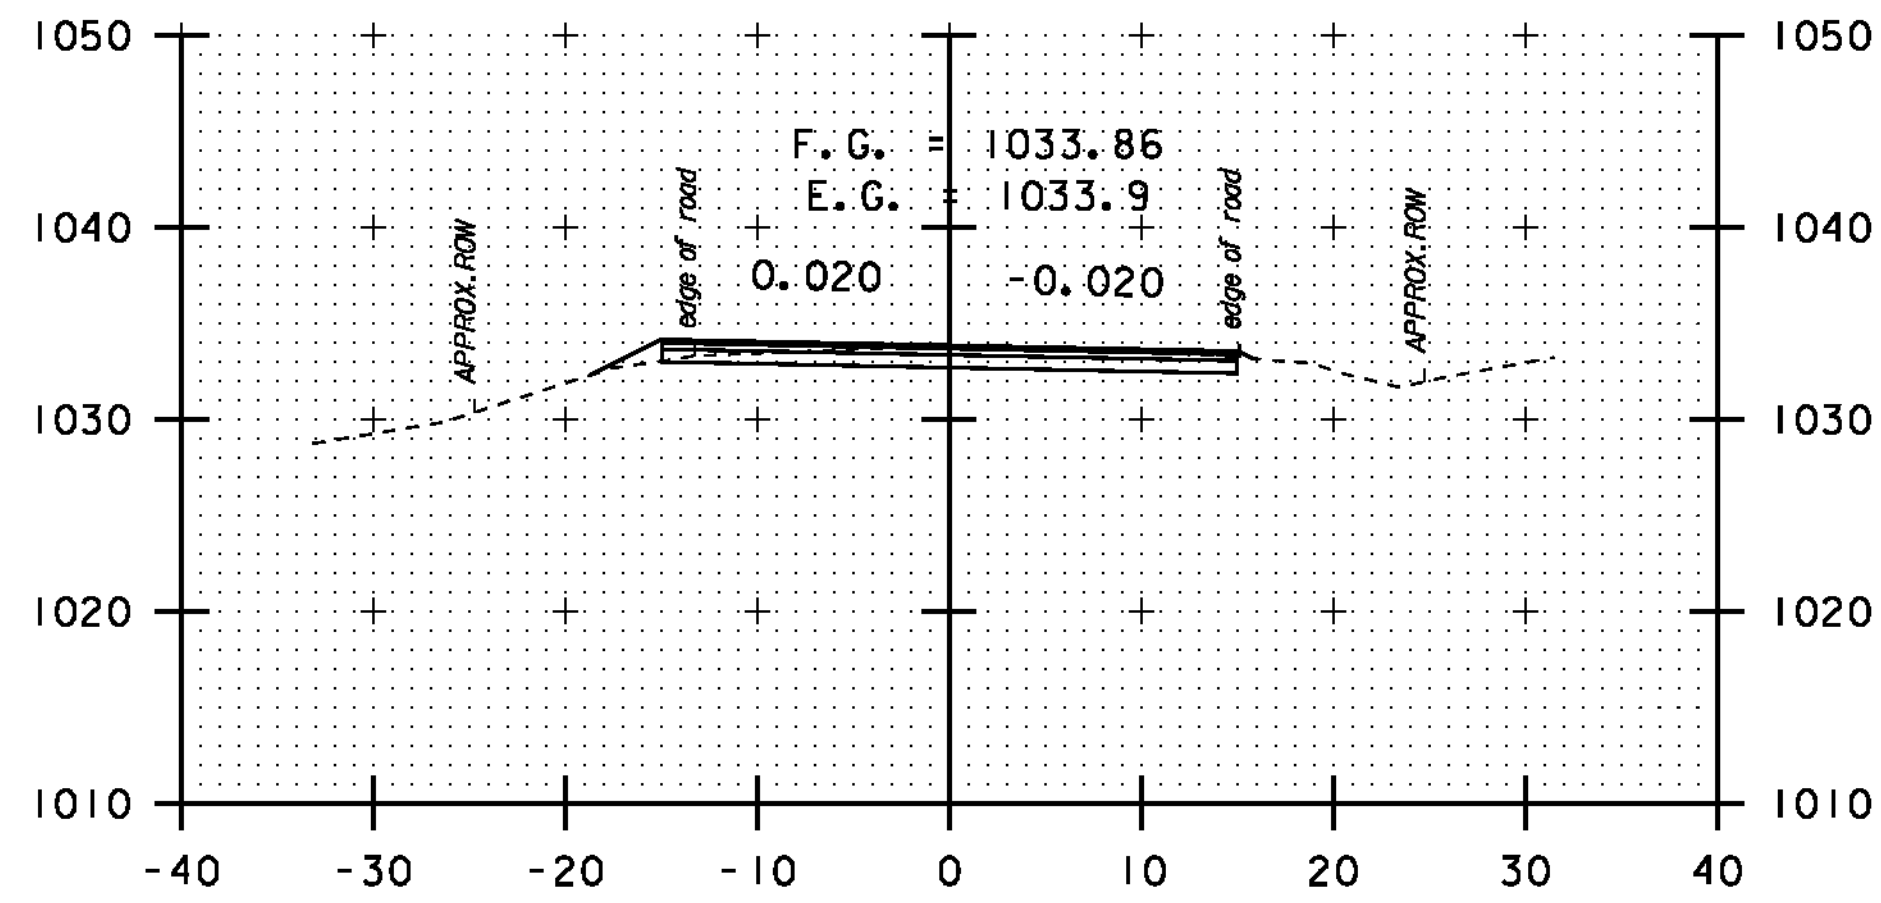


248+00

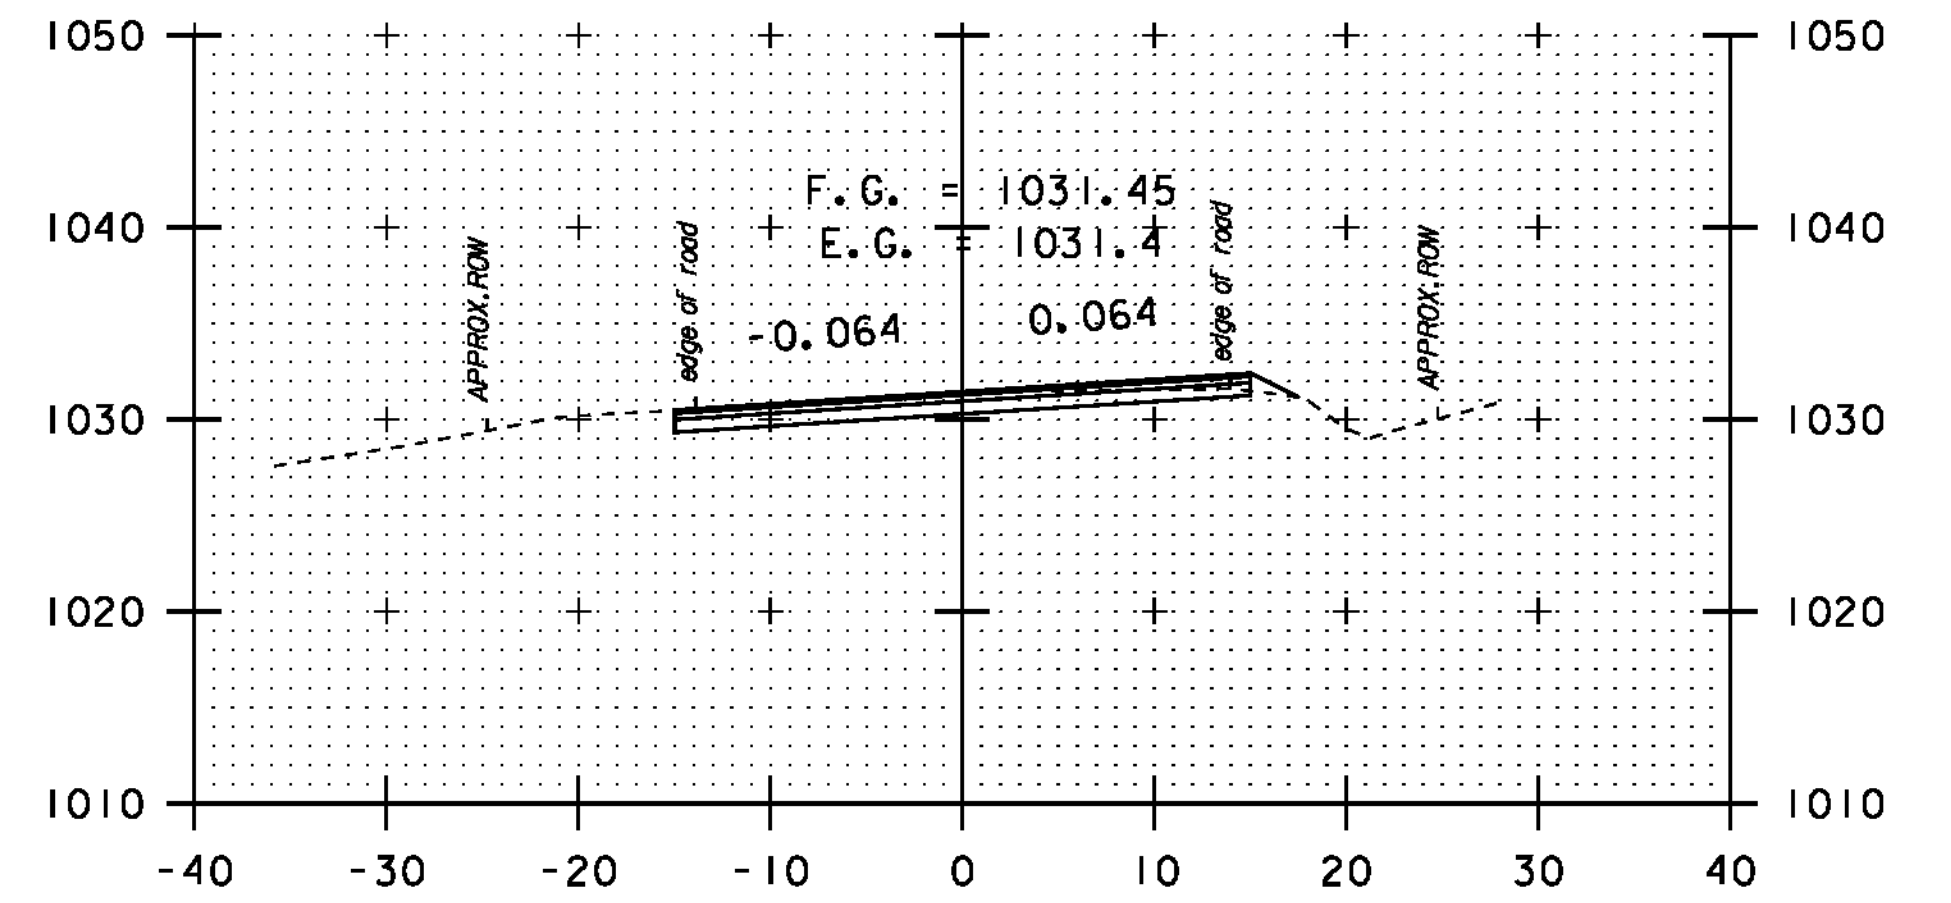


250+00

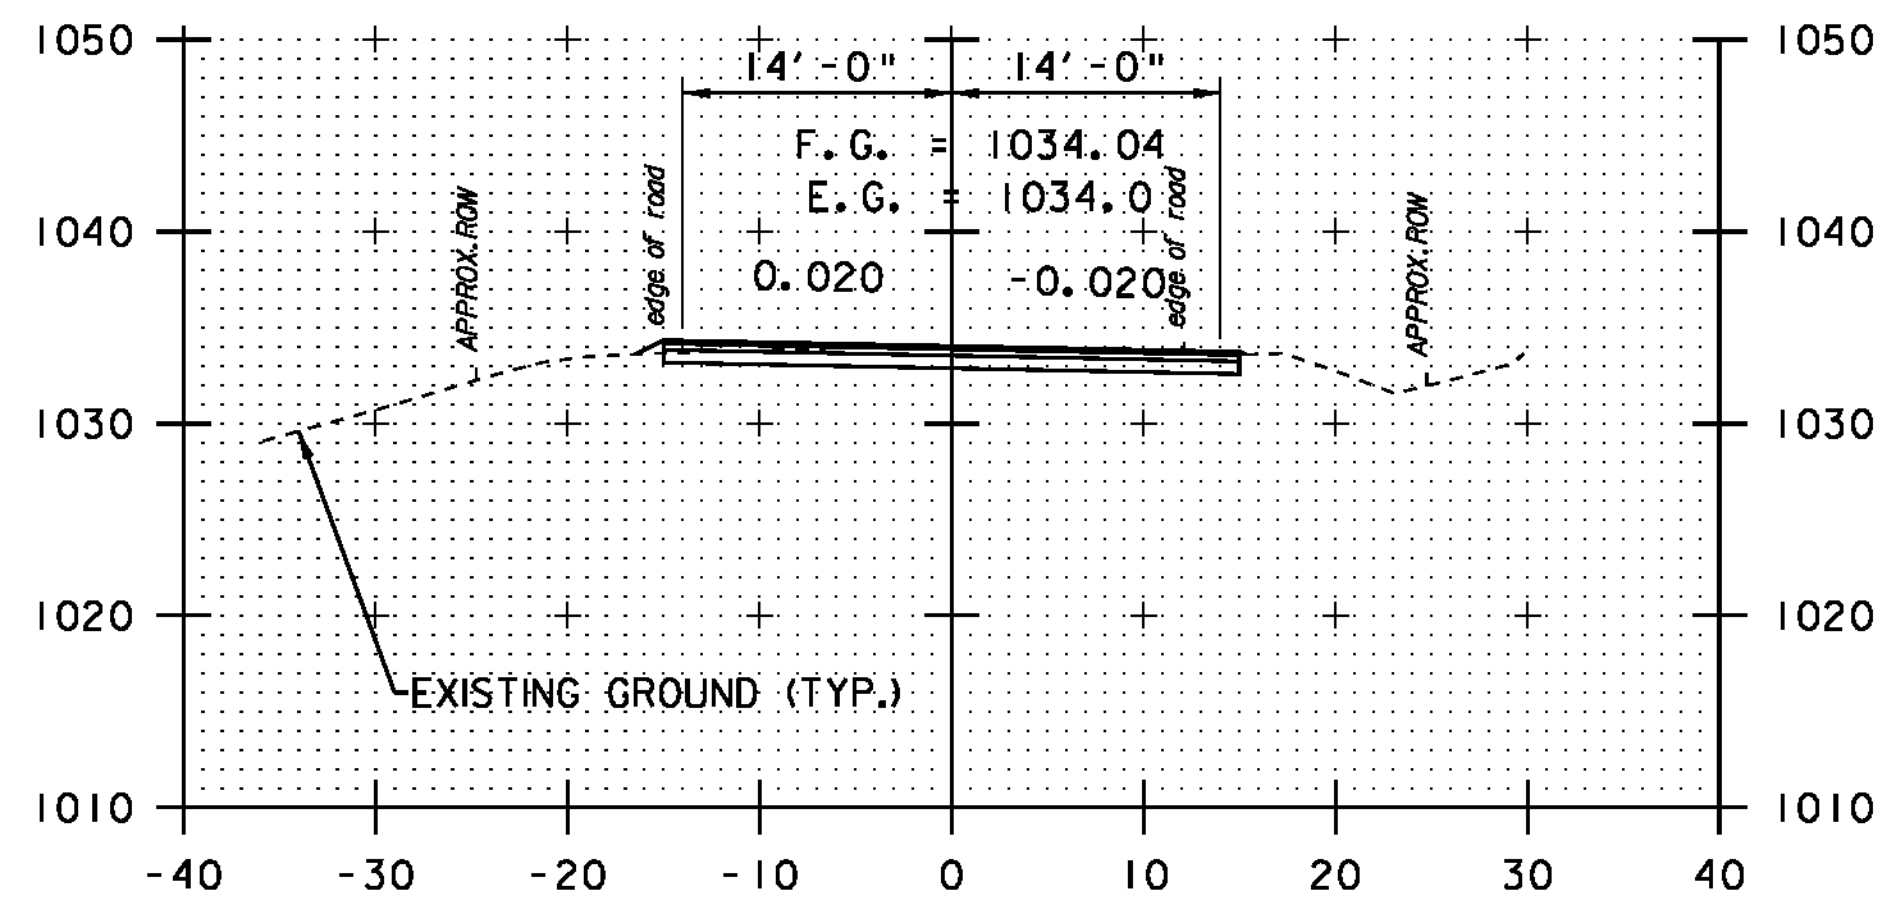

246+00

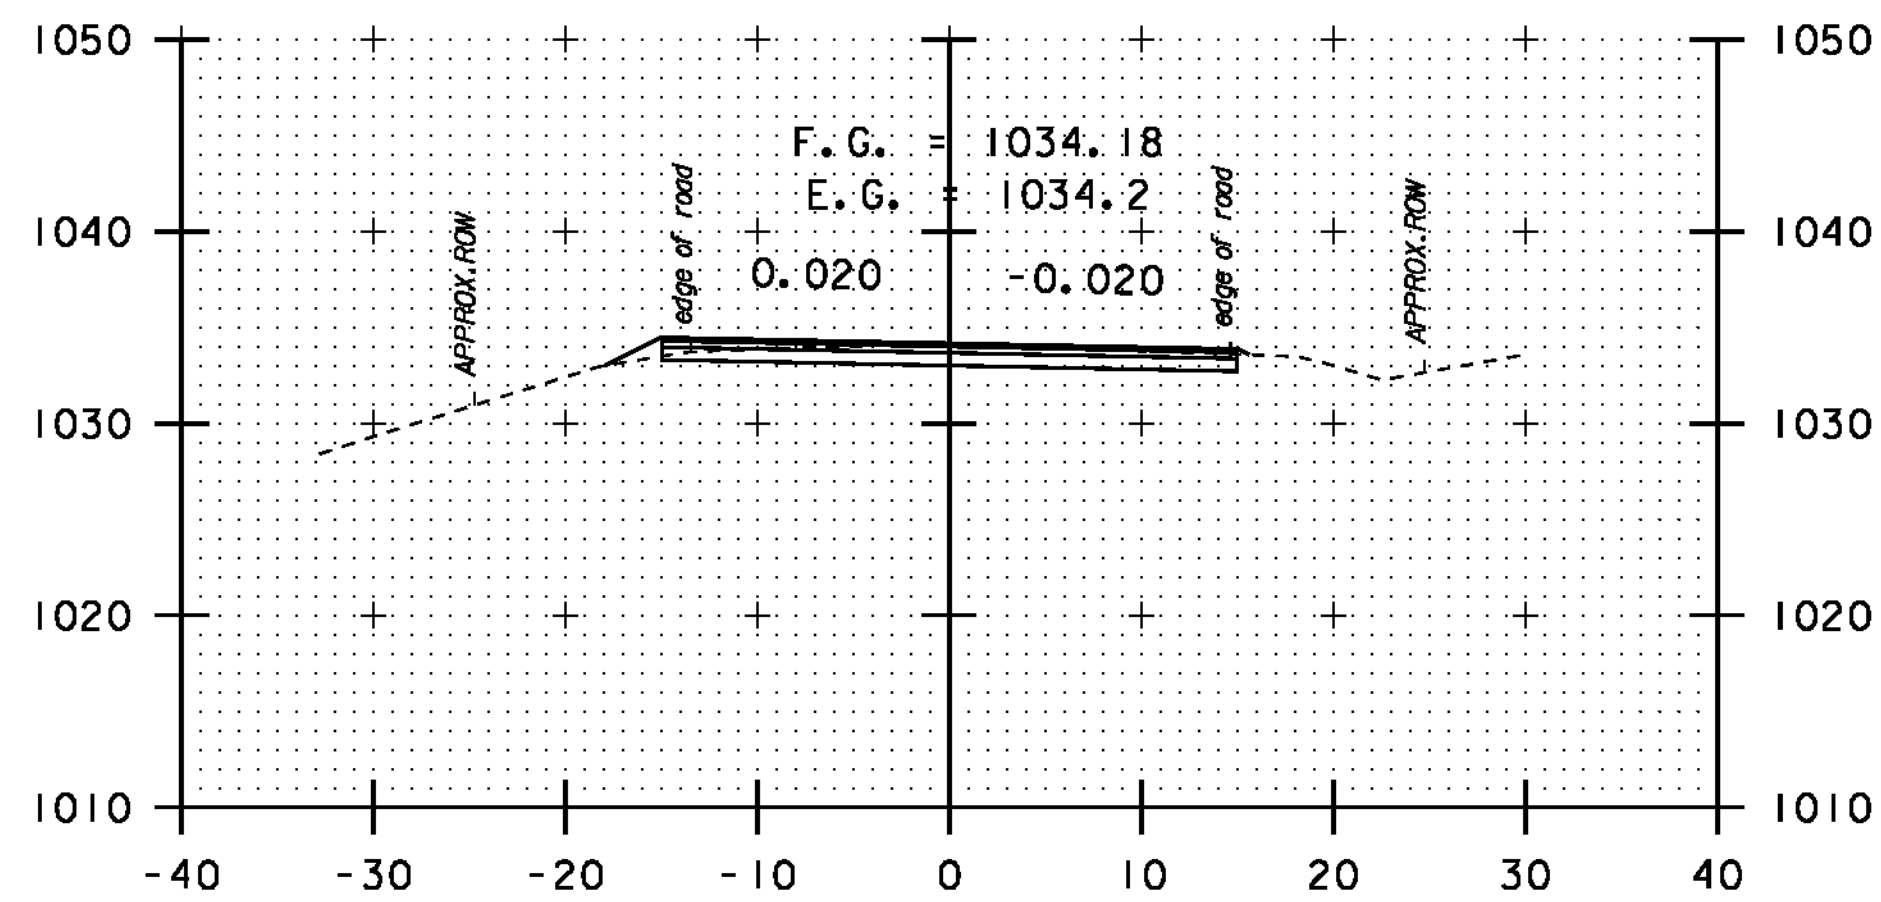

247+50

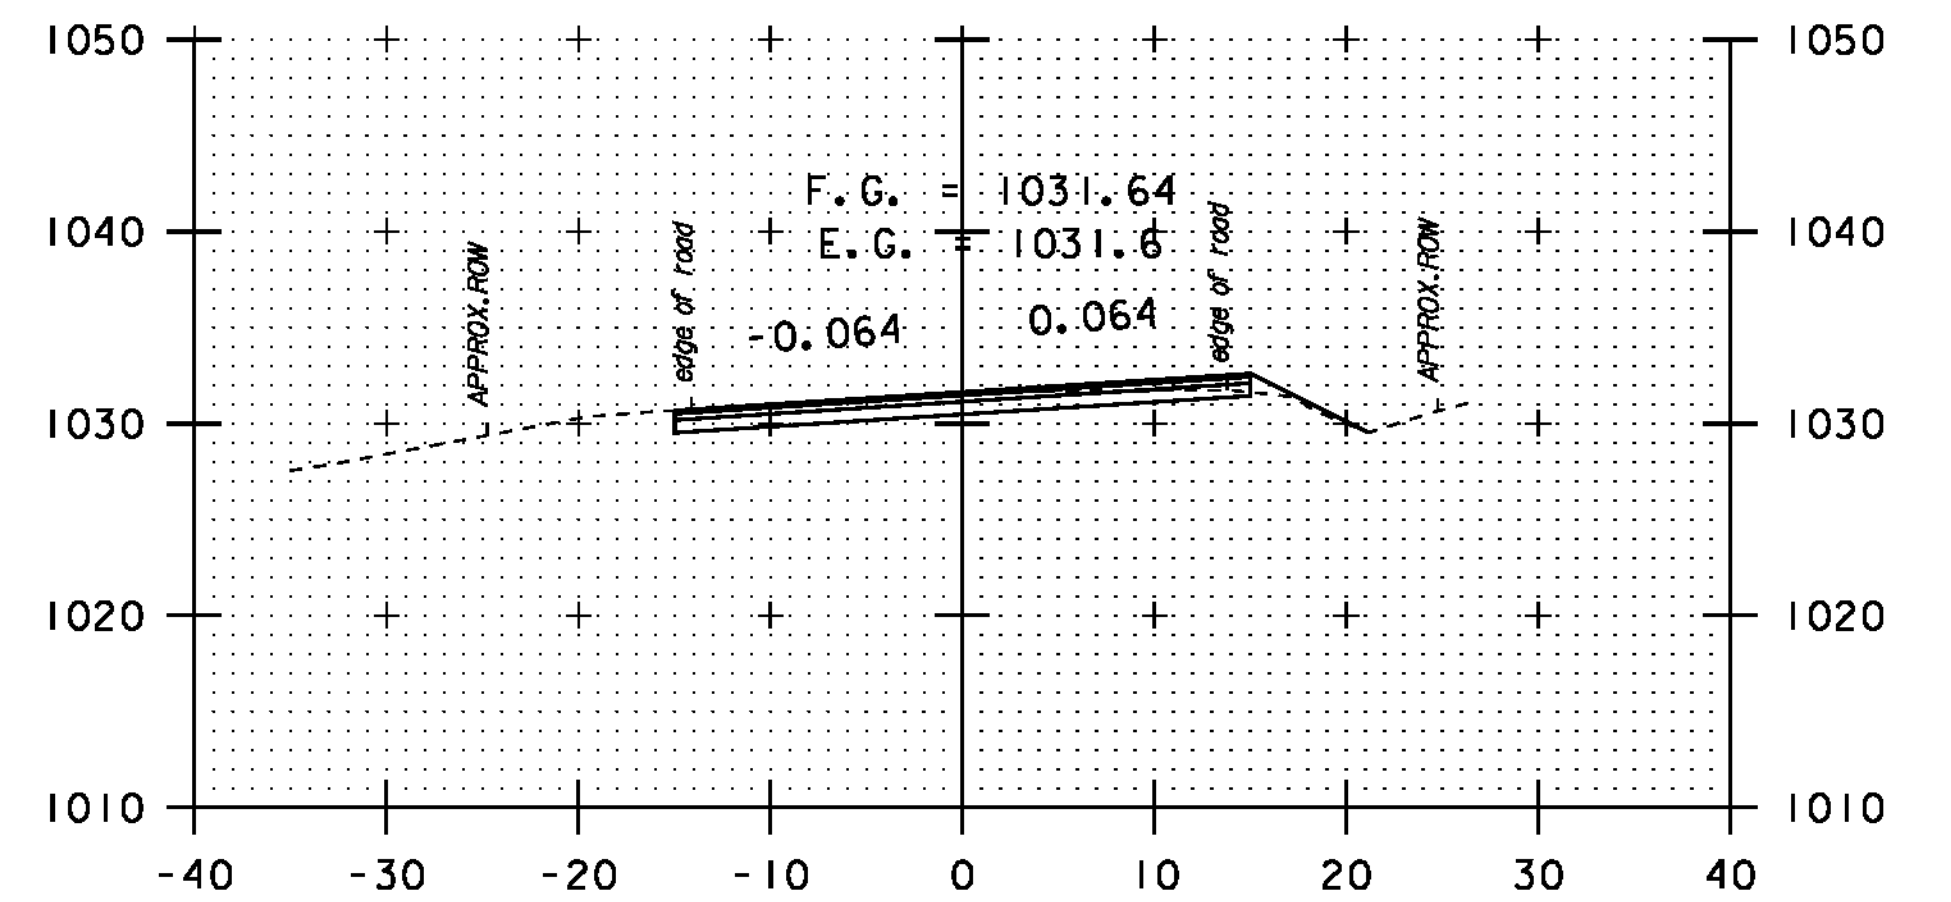

249+85

DATUM	NAVD 88
	NAD 83



STA. 246+00
-
STA. 250+50

CROSS SECTION SHEET 16

PROJECT NAME:	NEWPORT-COVENTRY-NEWPORT
PROJECT NUMBER:	STP 2802(I)
FILE NAME:	08b158.dgn
PROJECT LEADER:	CDL
DESIGNED BY:	BMB
PLOT FILE:	08b158-89.1
PLOT DATE:	8/3/2011
DRAWN BY:	BMB
CHECKED BY:	EPD
SHEET	89 OF 134