




252+00

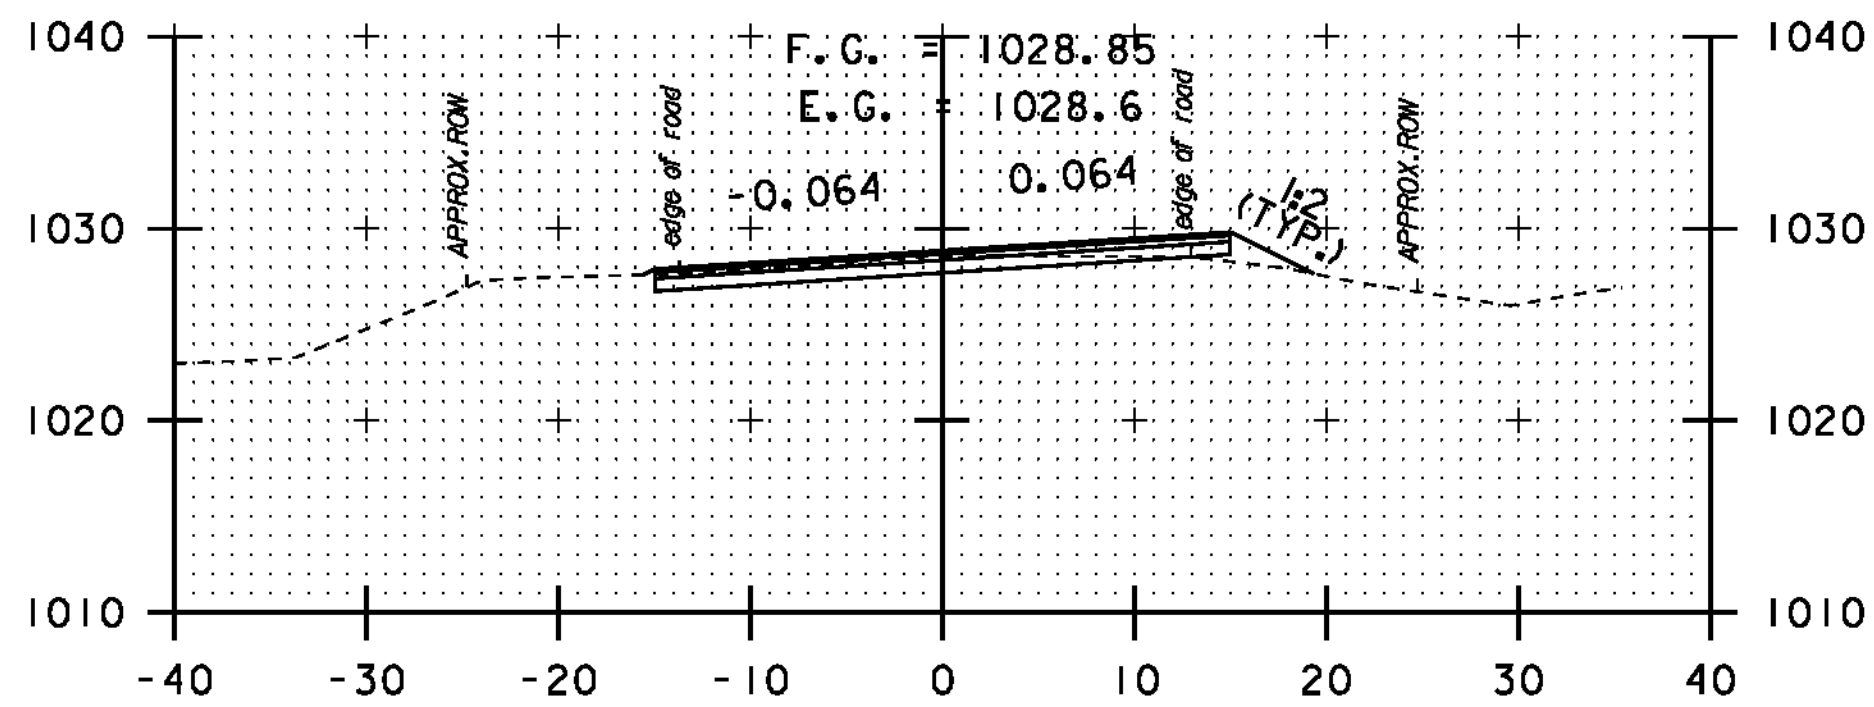


253+50

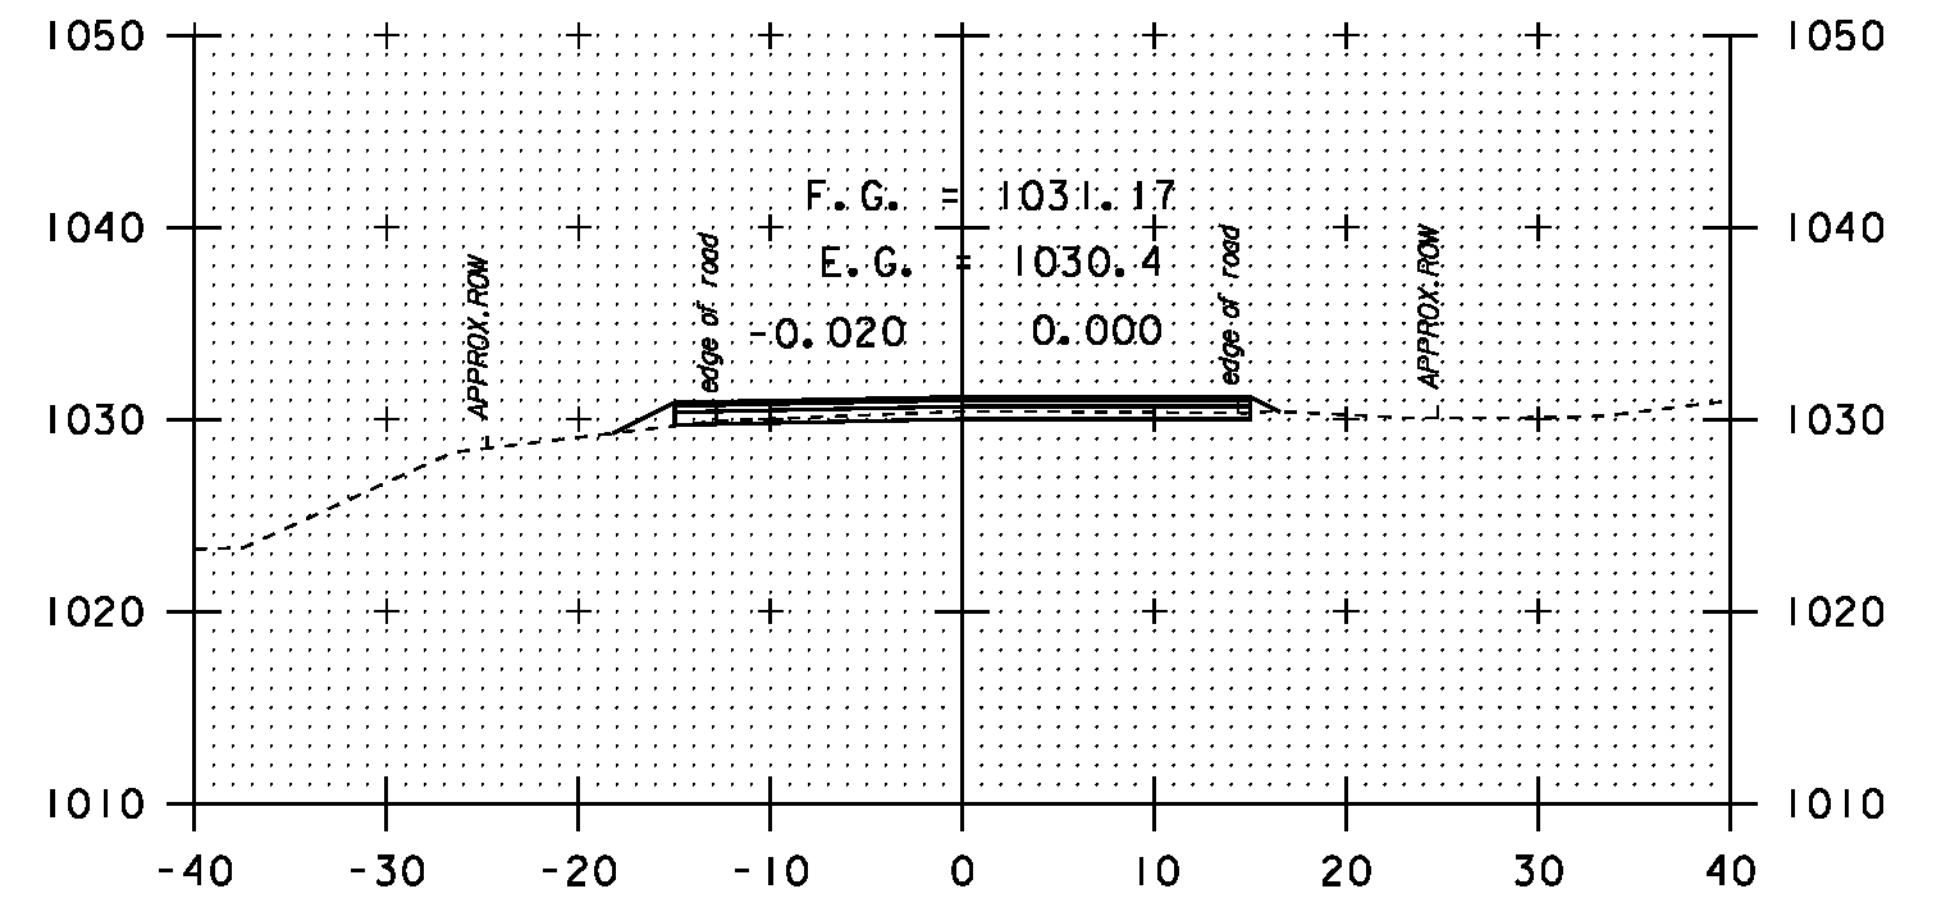


255+20

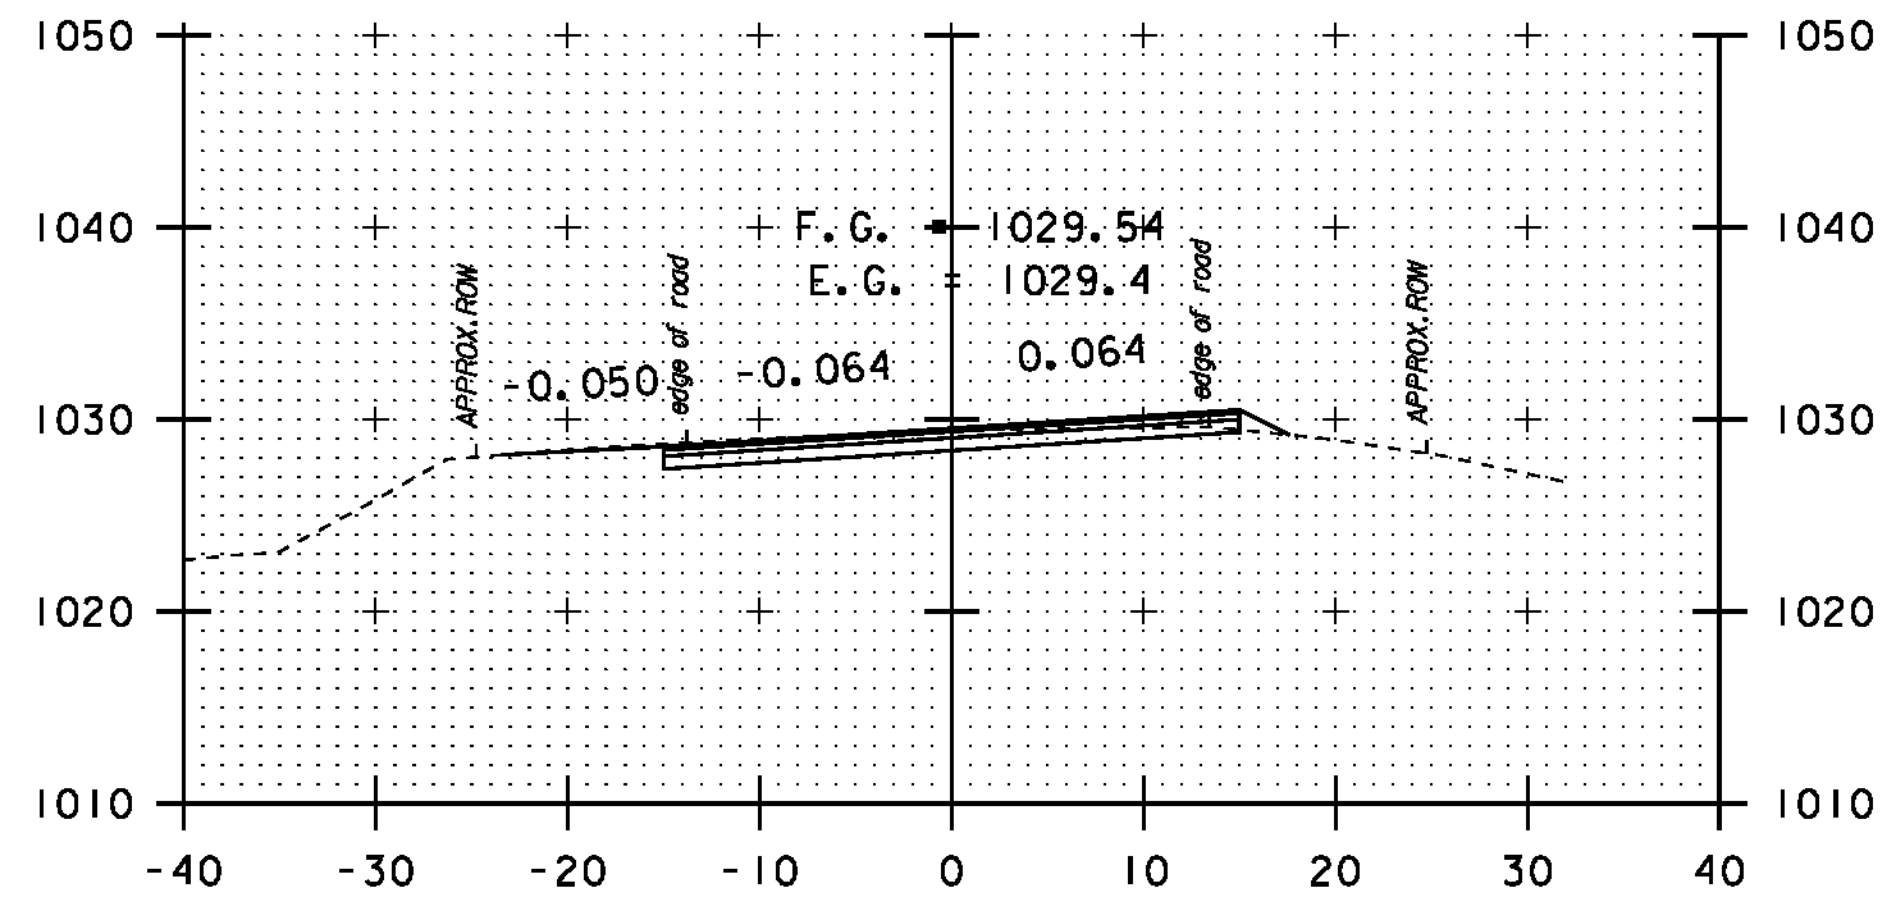


251+50

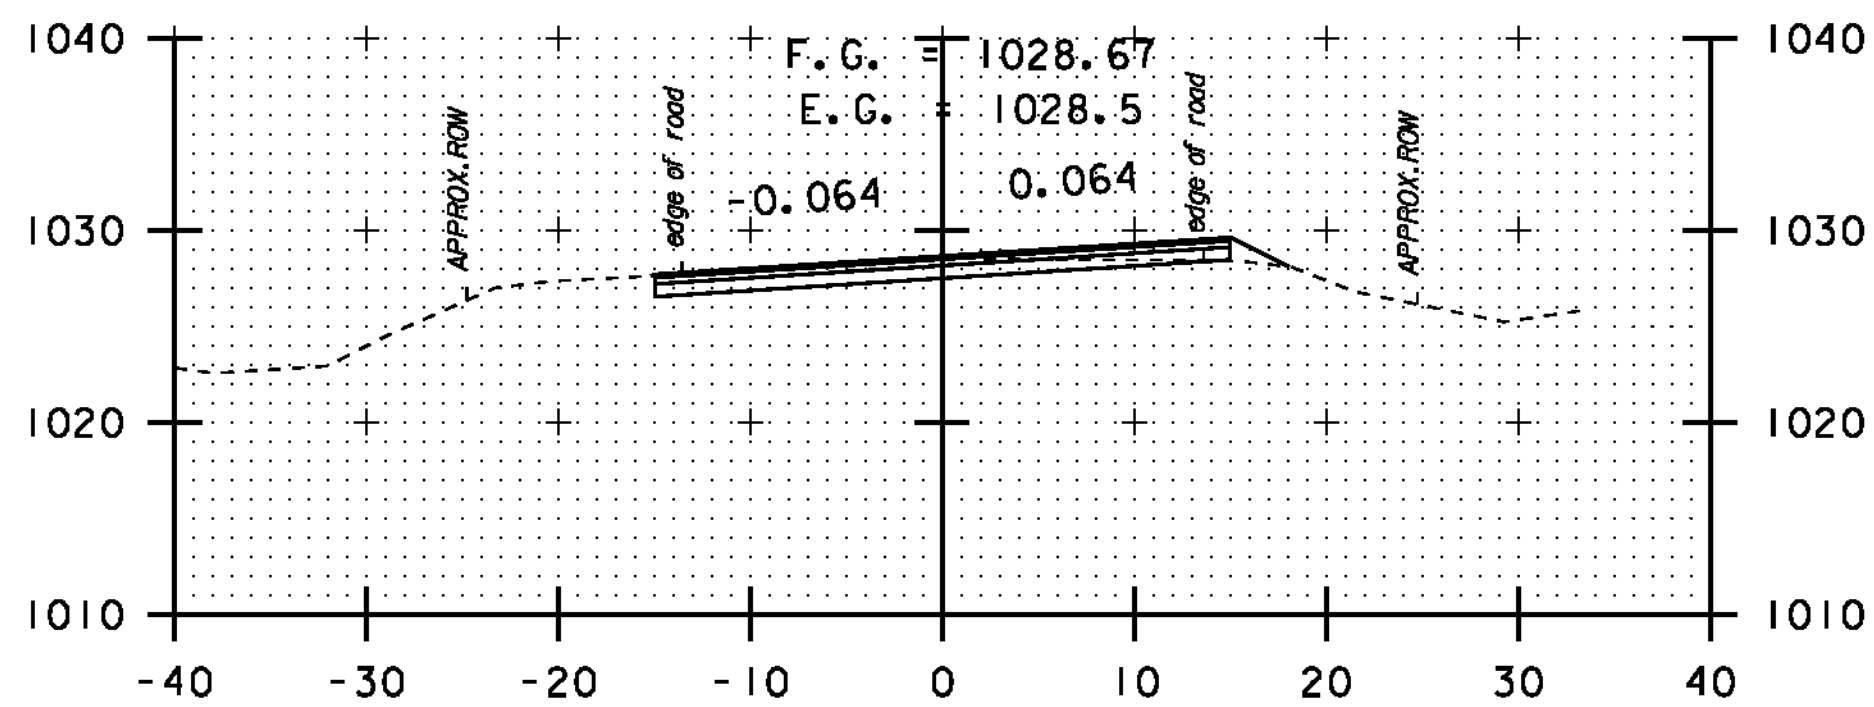


253+00

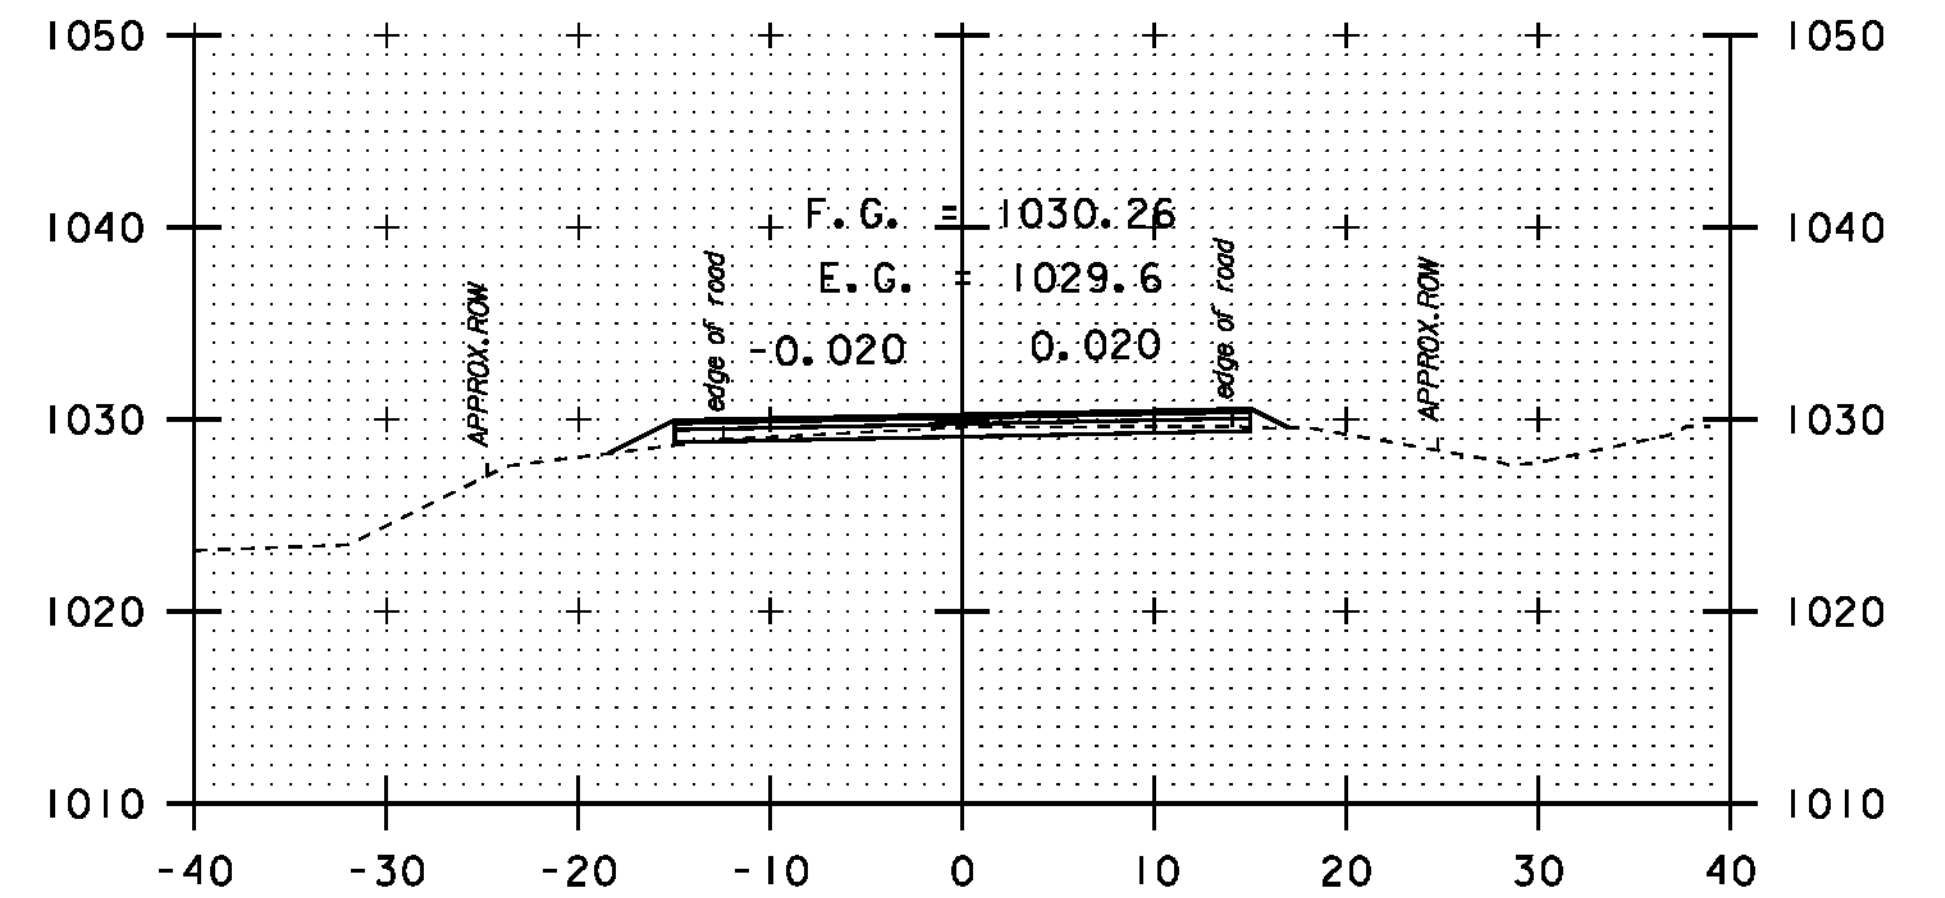


254+73

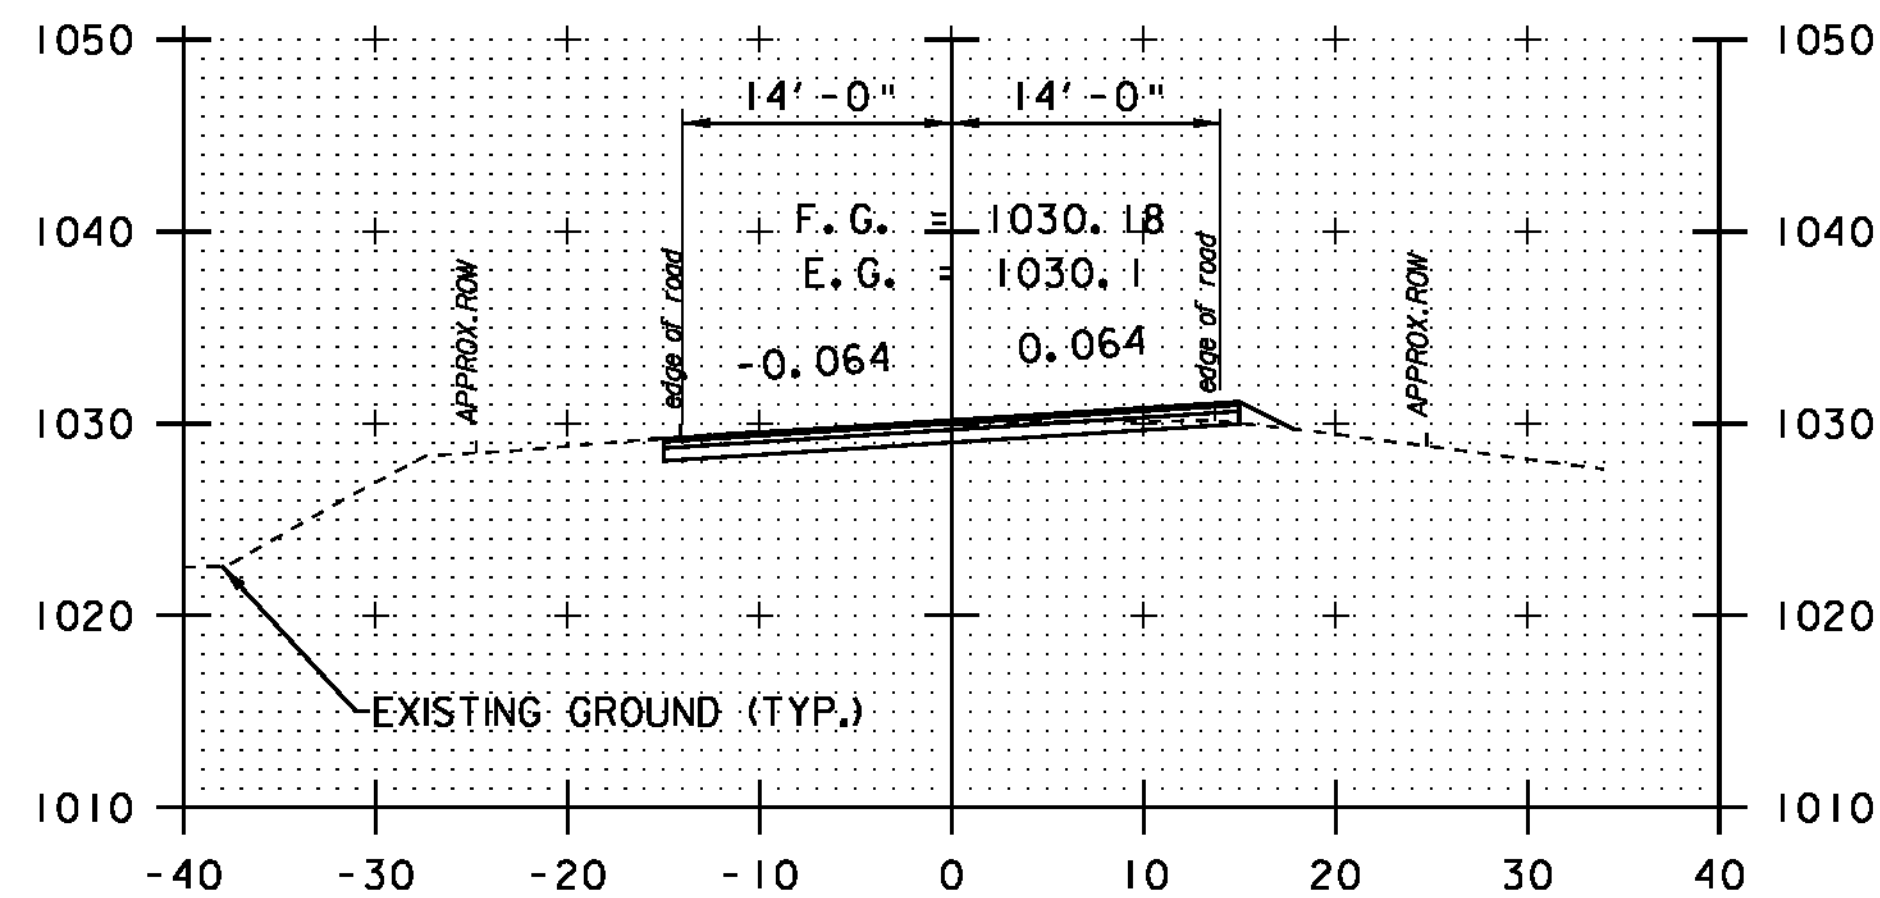

251+00

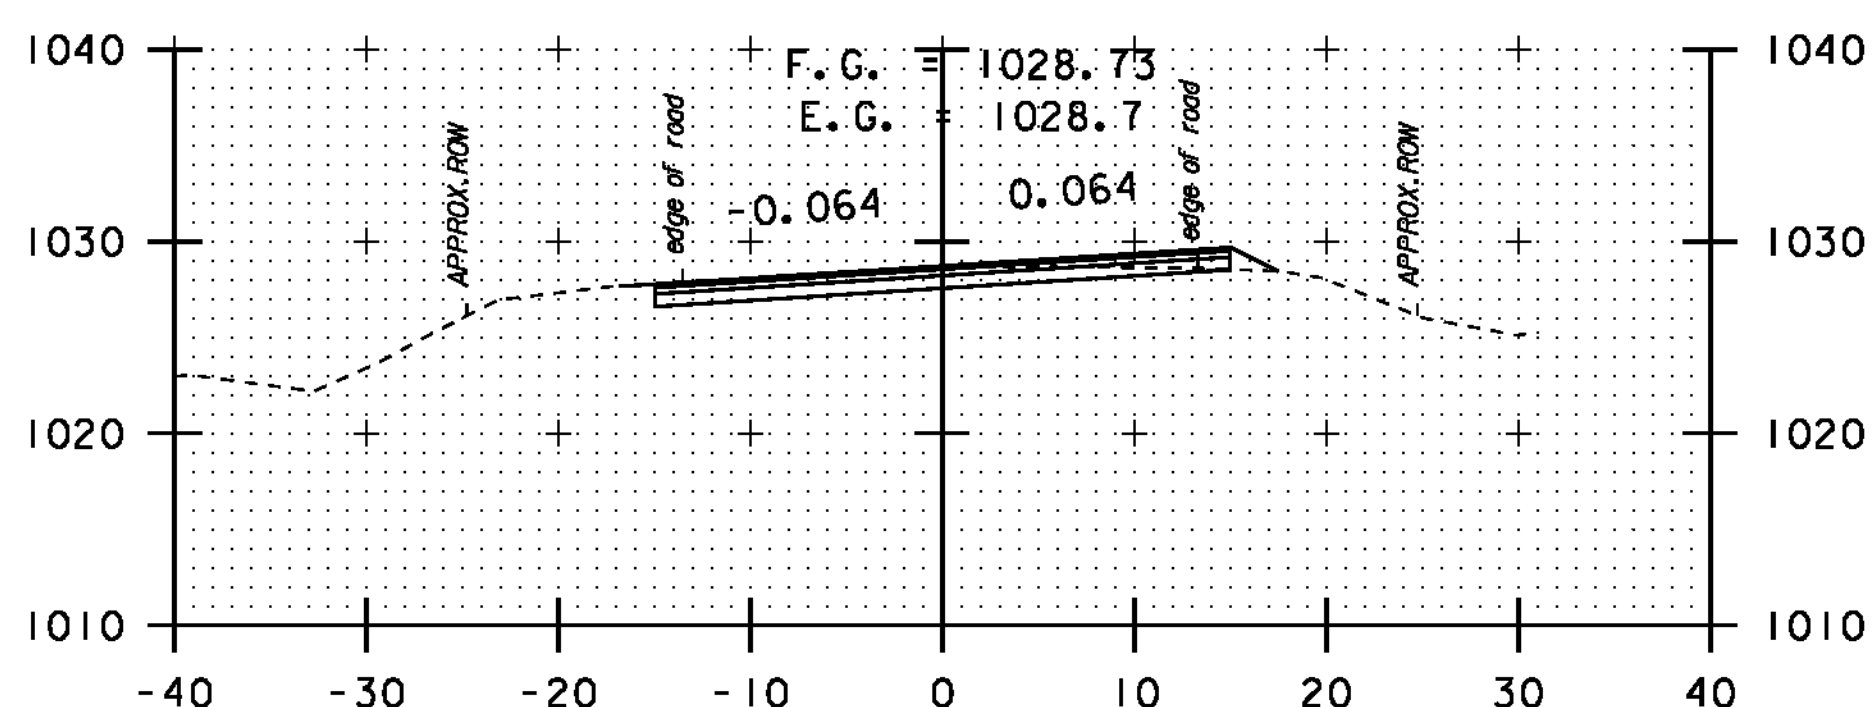

252+50

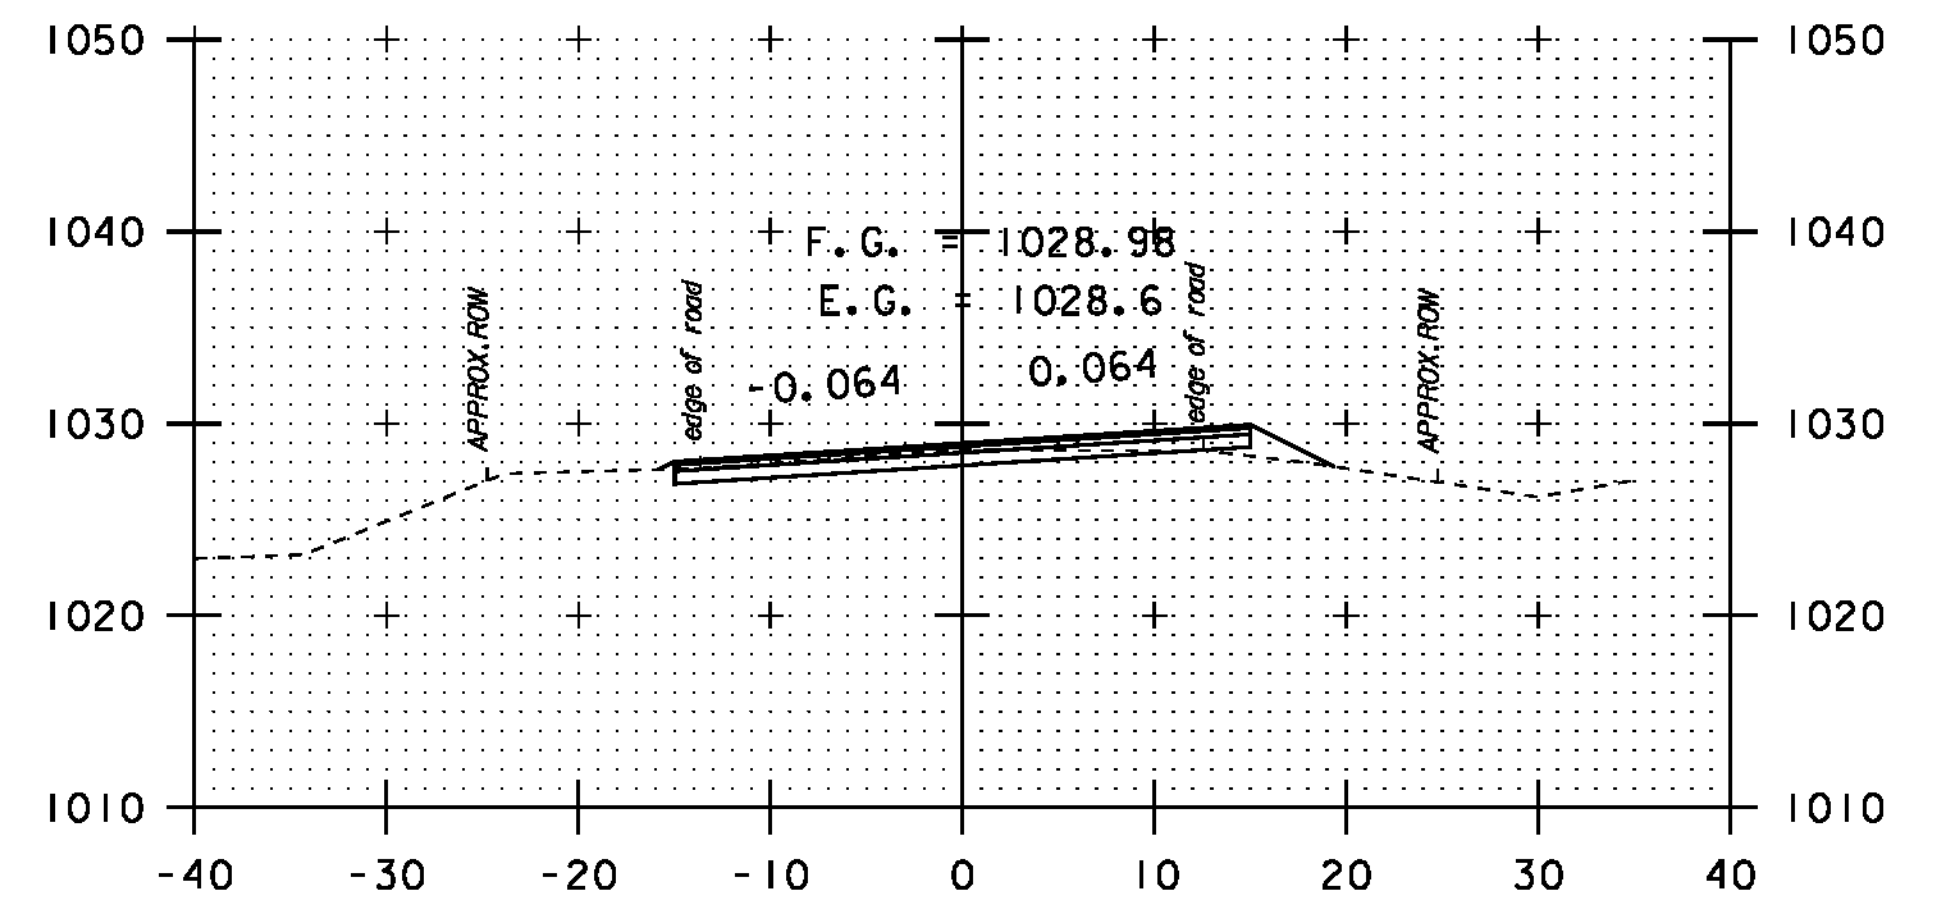

253+70

DATUM	NAVD 88
	NAD 83



**STA. 251+00**  
-  
**STA. 255+20**

**CROSS SECTION SHEET 17**

PROJECT NAME:	NEWPORT-COVENTRY-NEWPORT
PROJECT NUMBER:	STP 2802(I)
FILE NAME:	08b158.dgn
PROJECT LEADER:	CDL
DESIGNED BY:	BMB
PLOT FILE:	08b158-90.1
PLOT DATE:	8/3/2011
DRAWN BY:	BMB
CHECKED BY:	EPD
SHEET	90 OF 134