




263+50

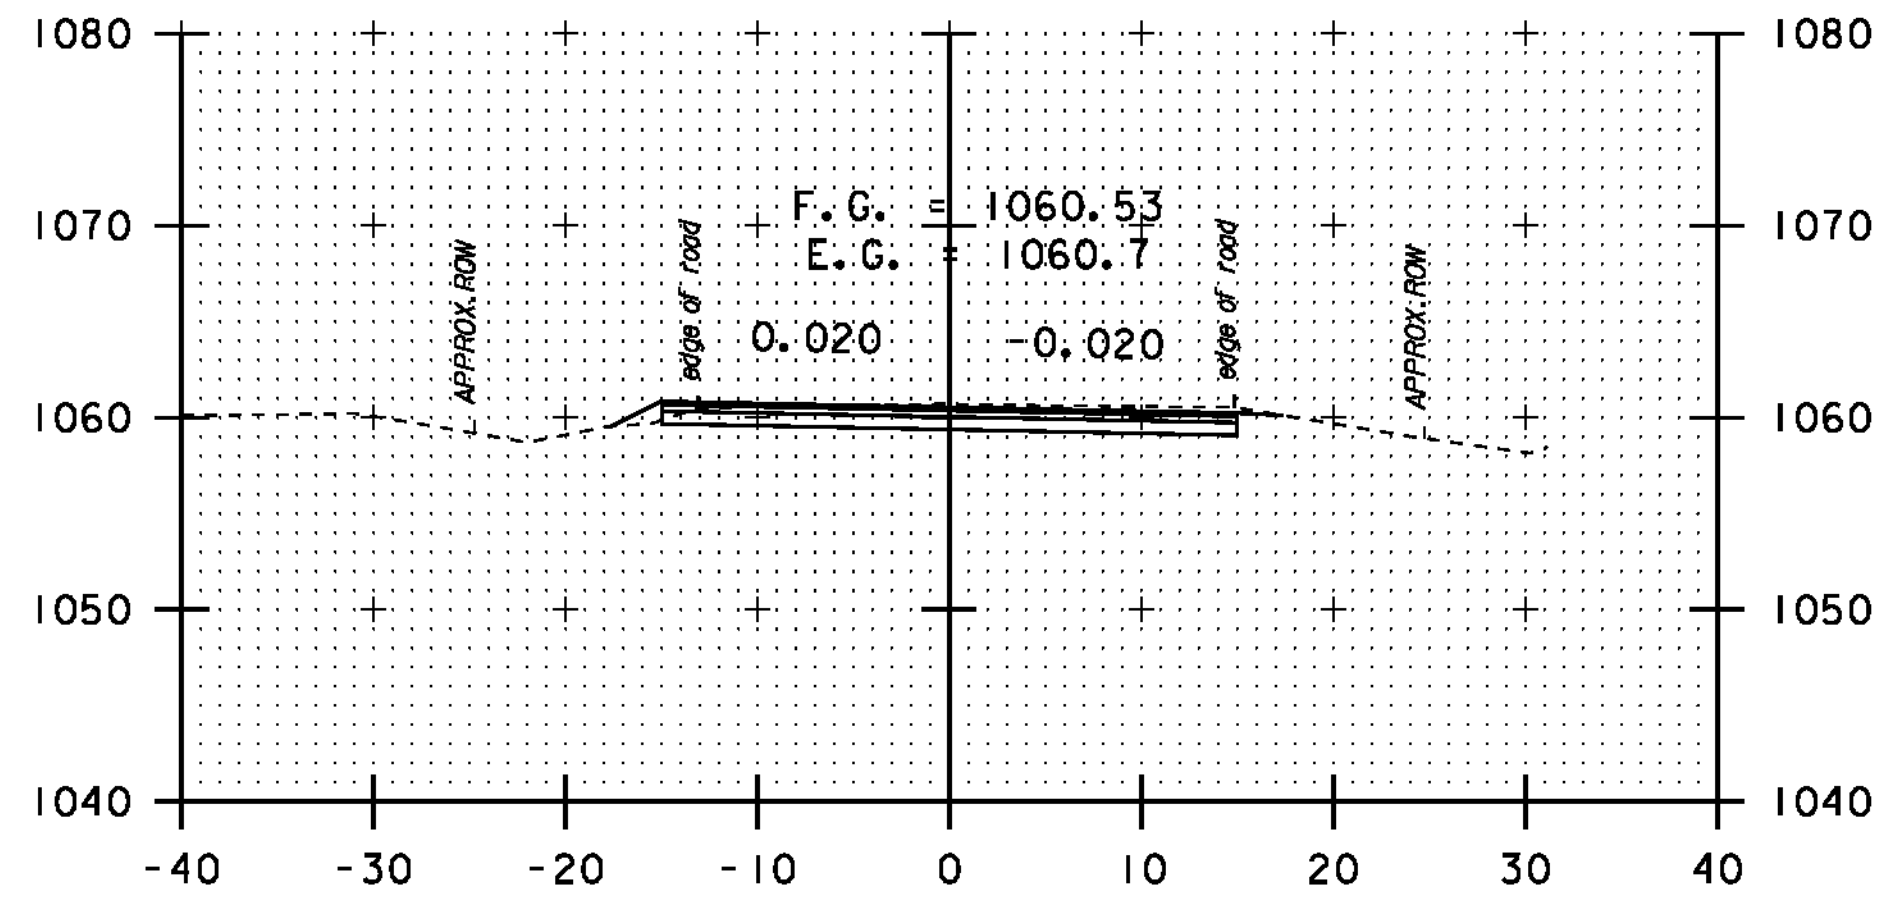


265+40

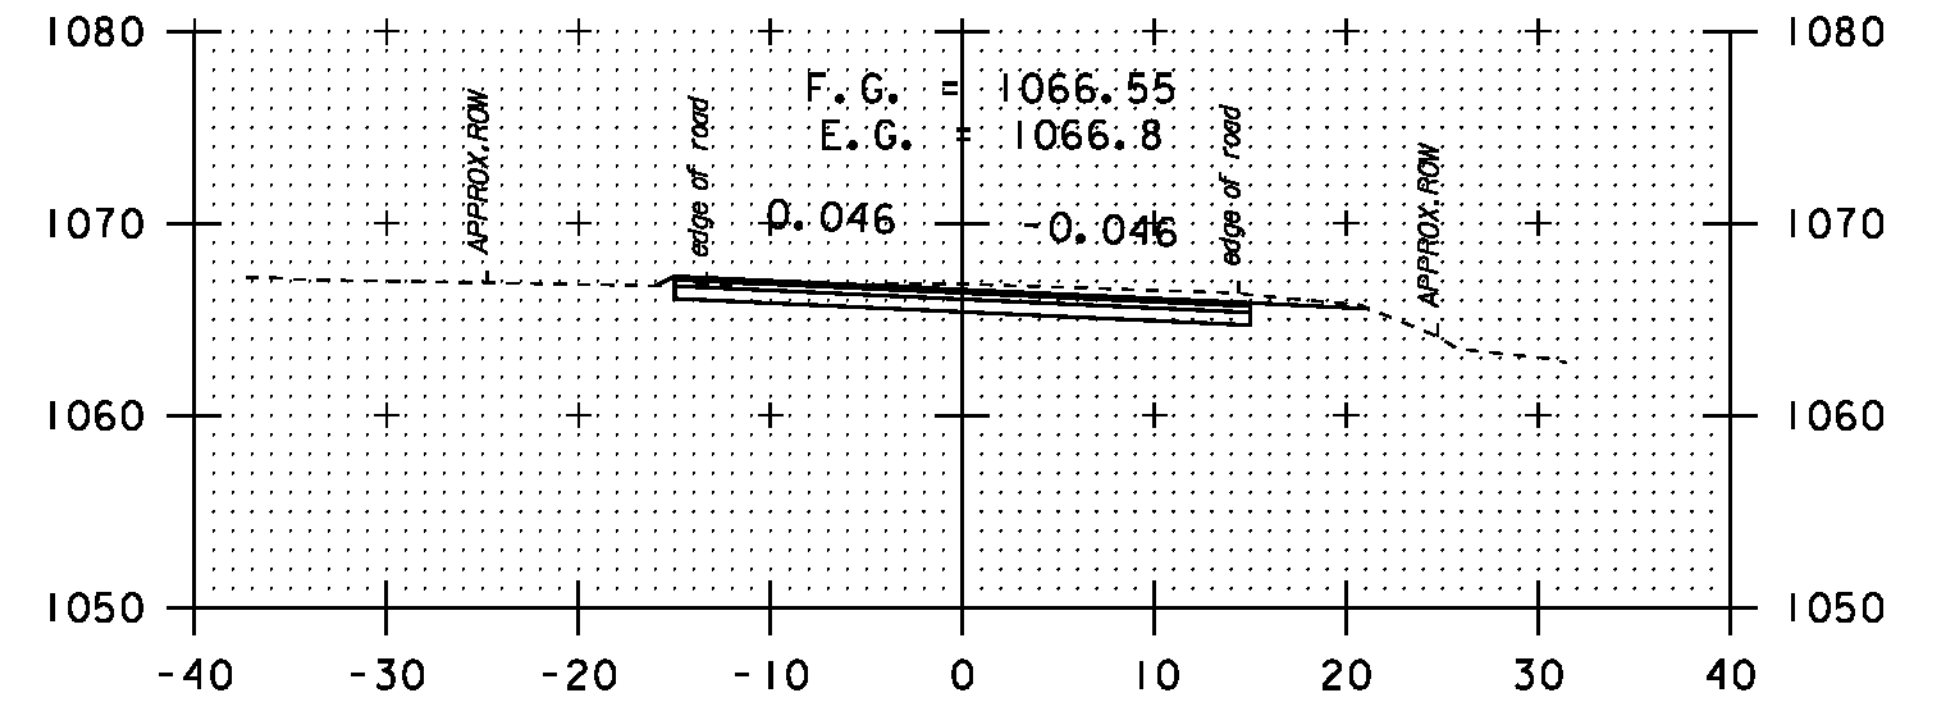


267+00

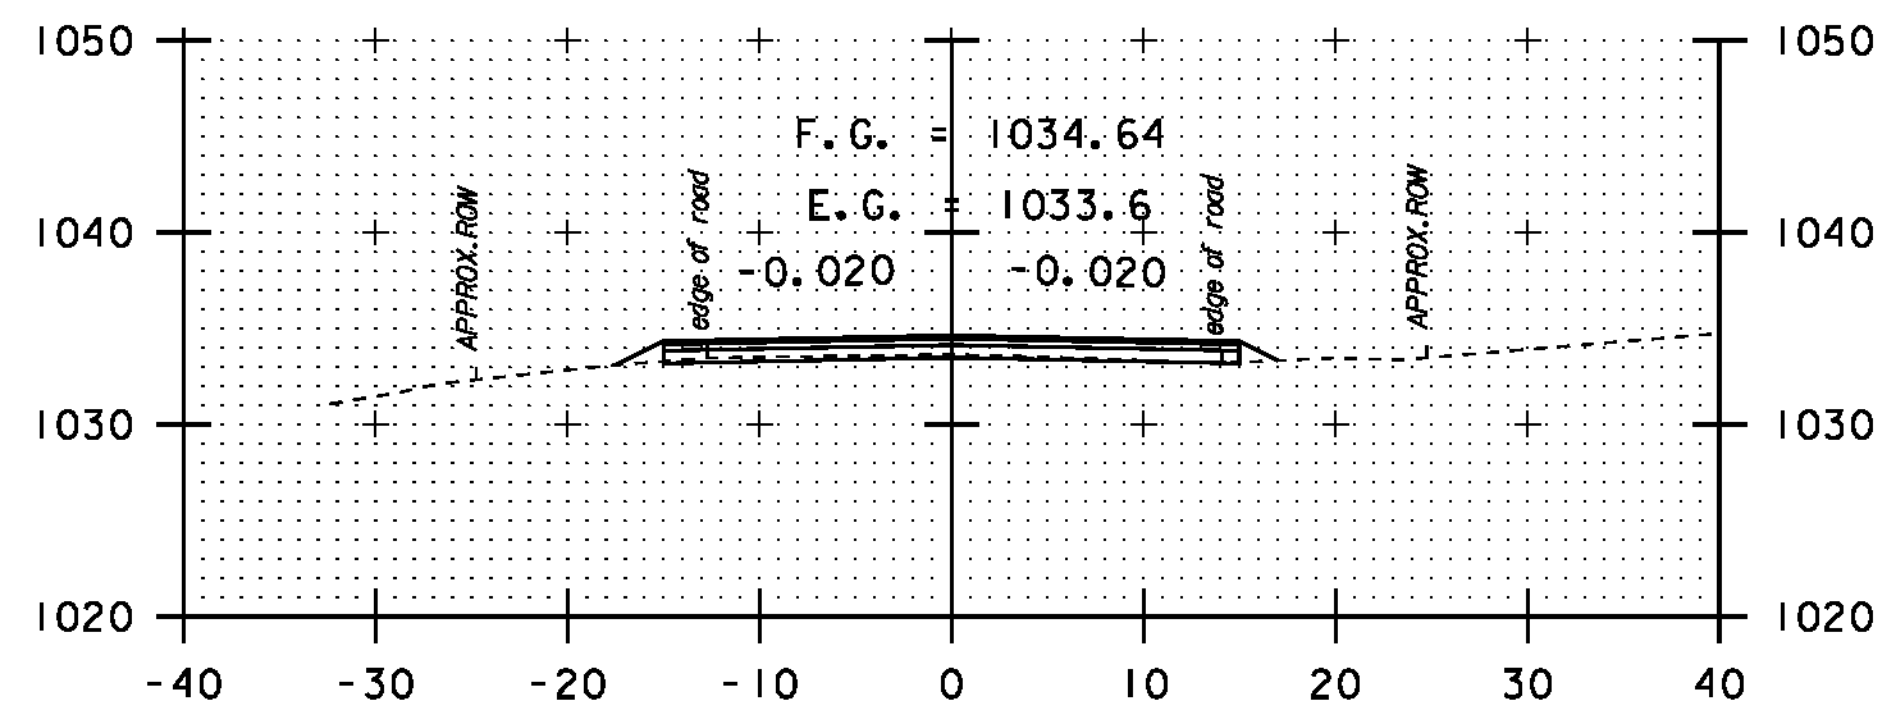


256+50

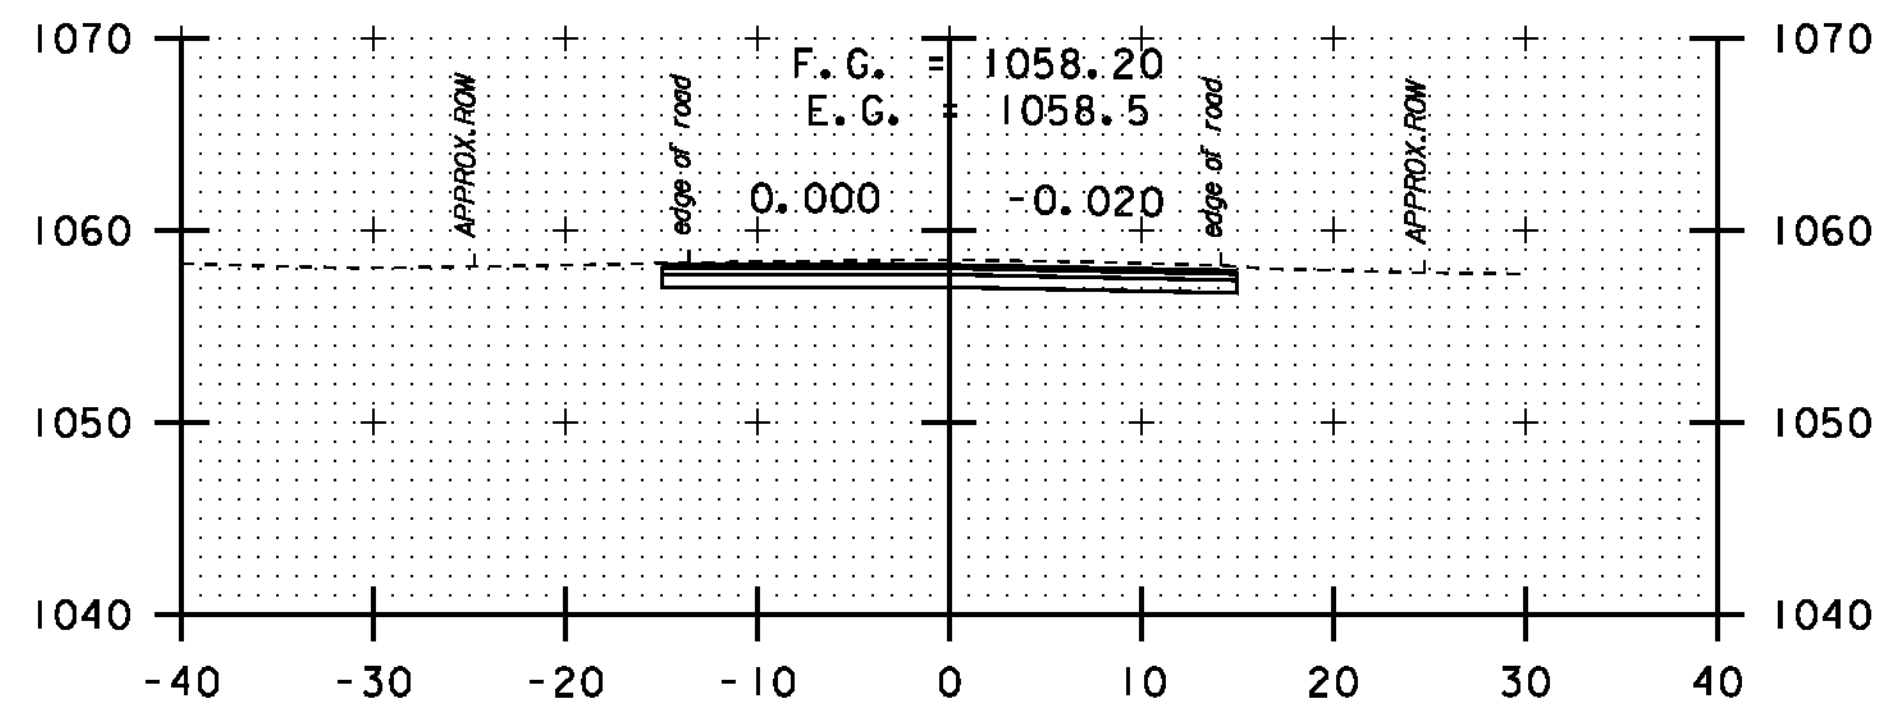


264+70

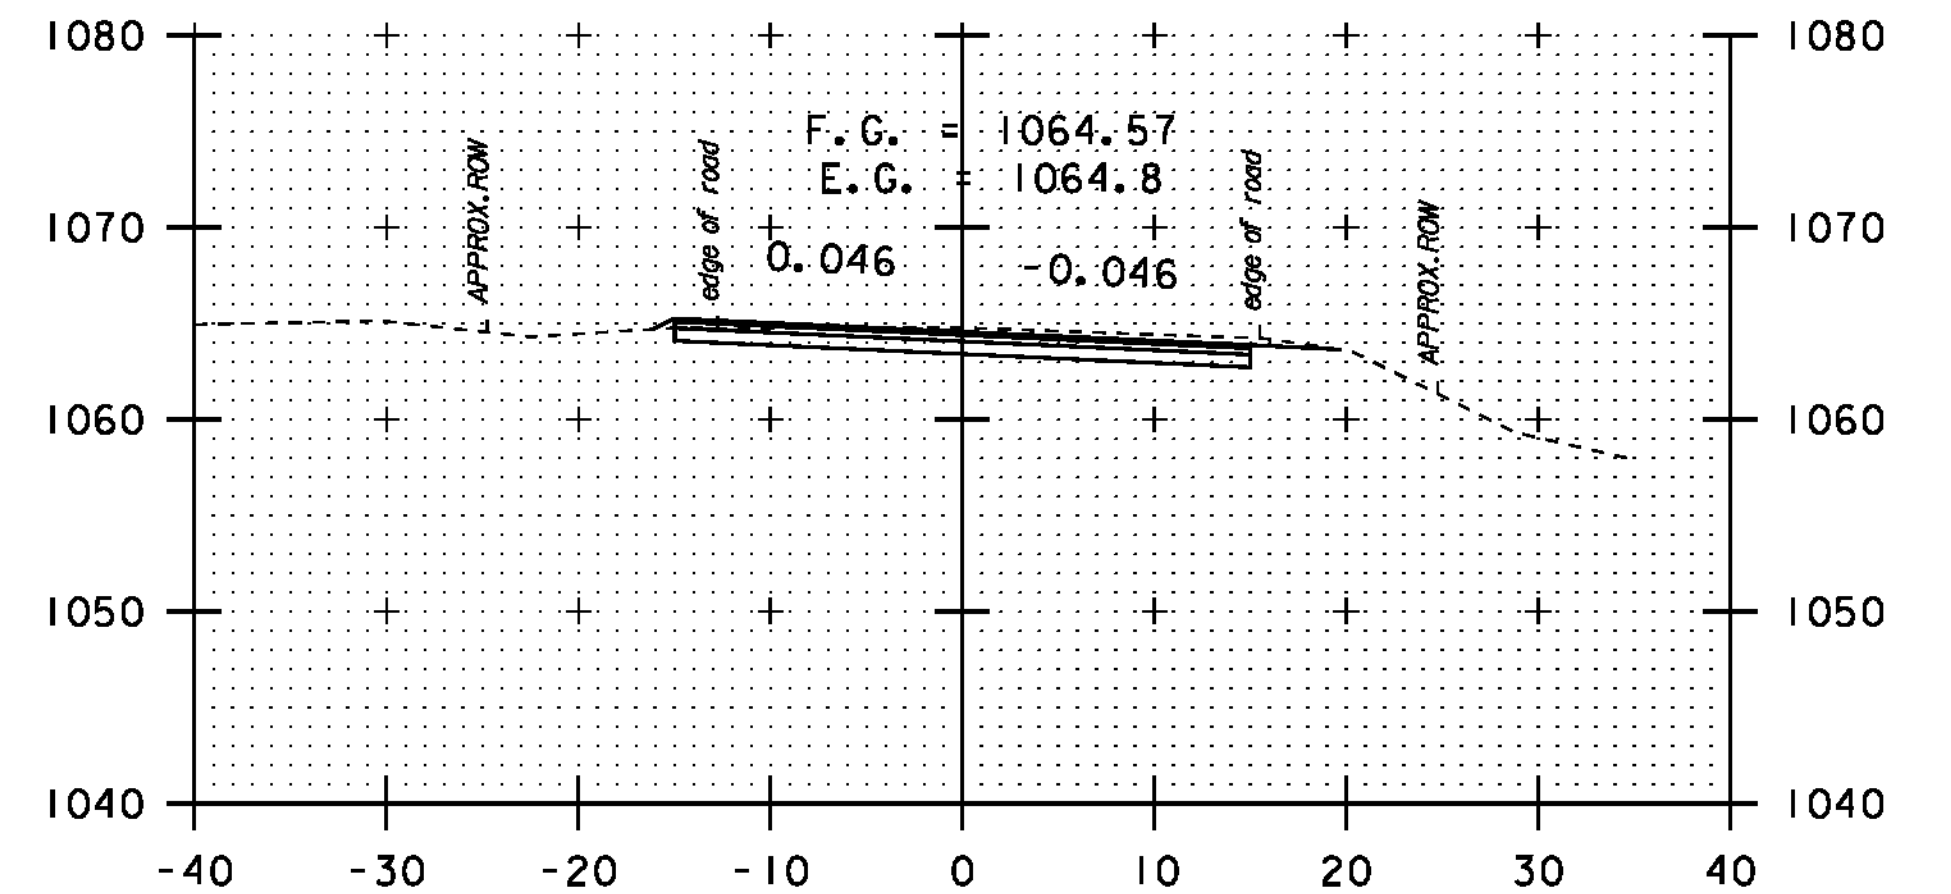


266+50

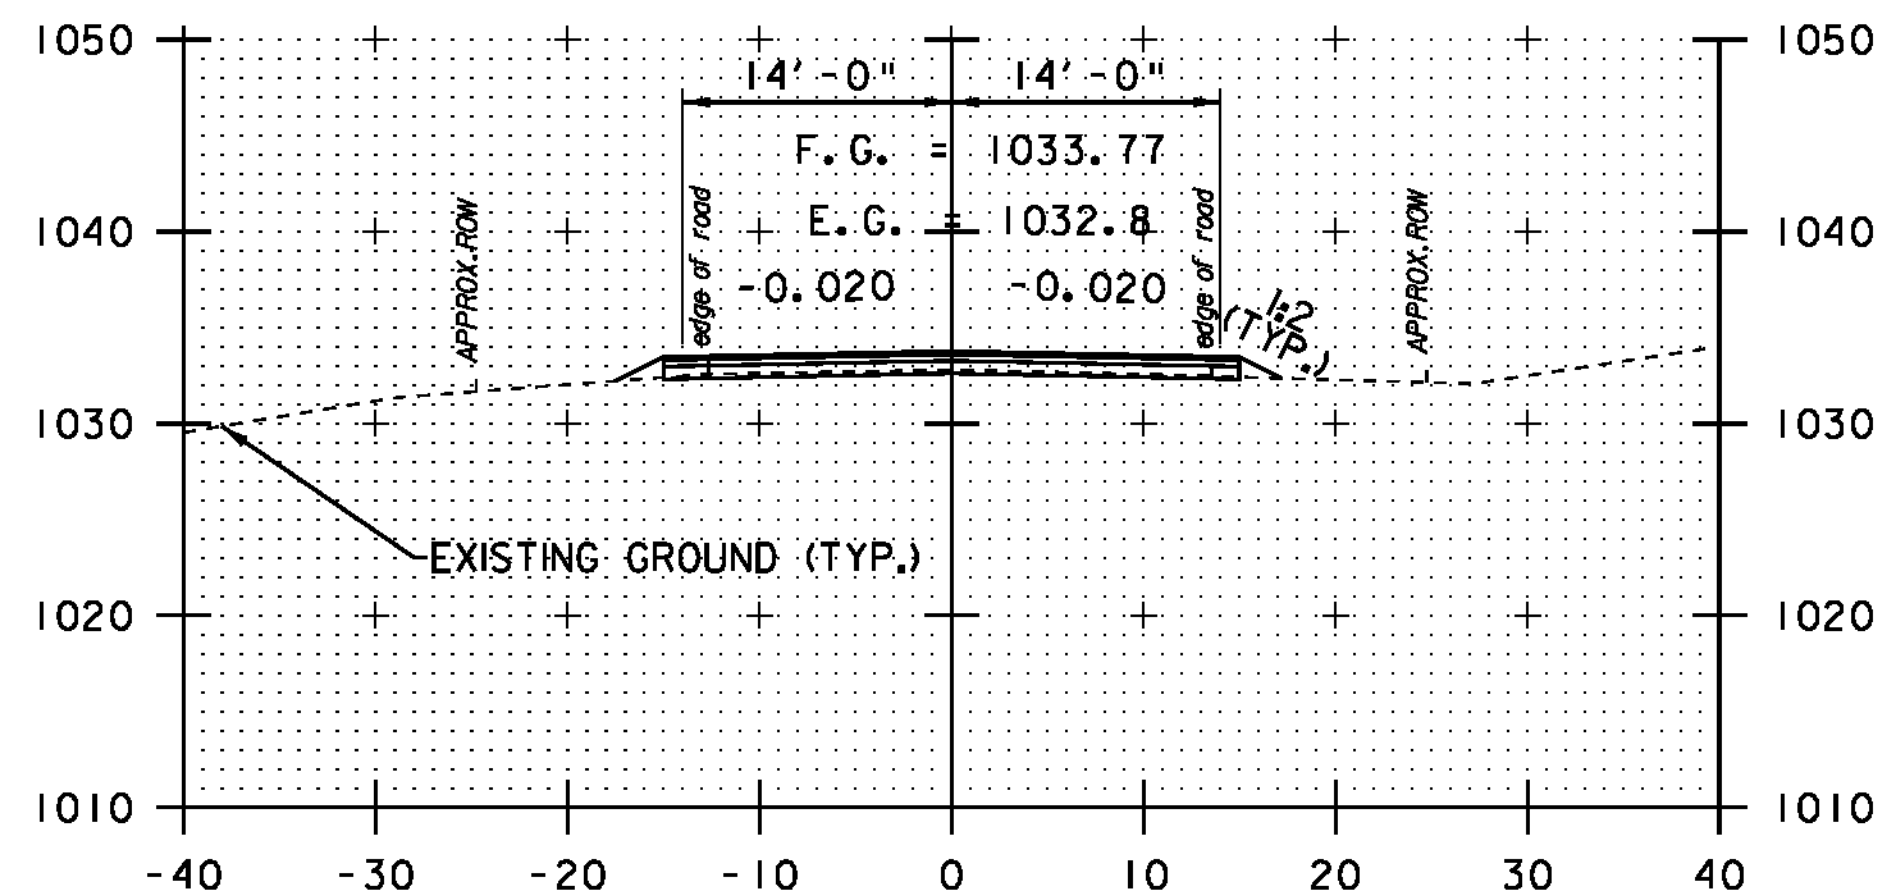

256+20

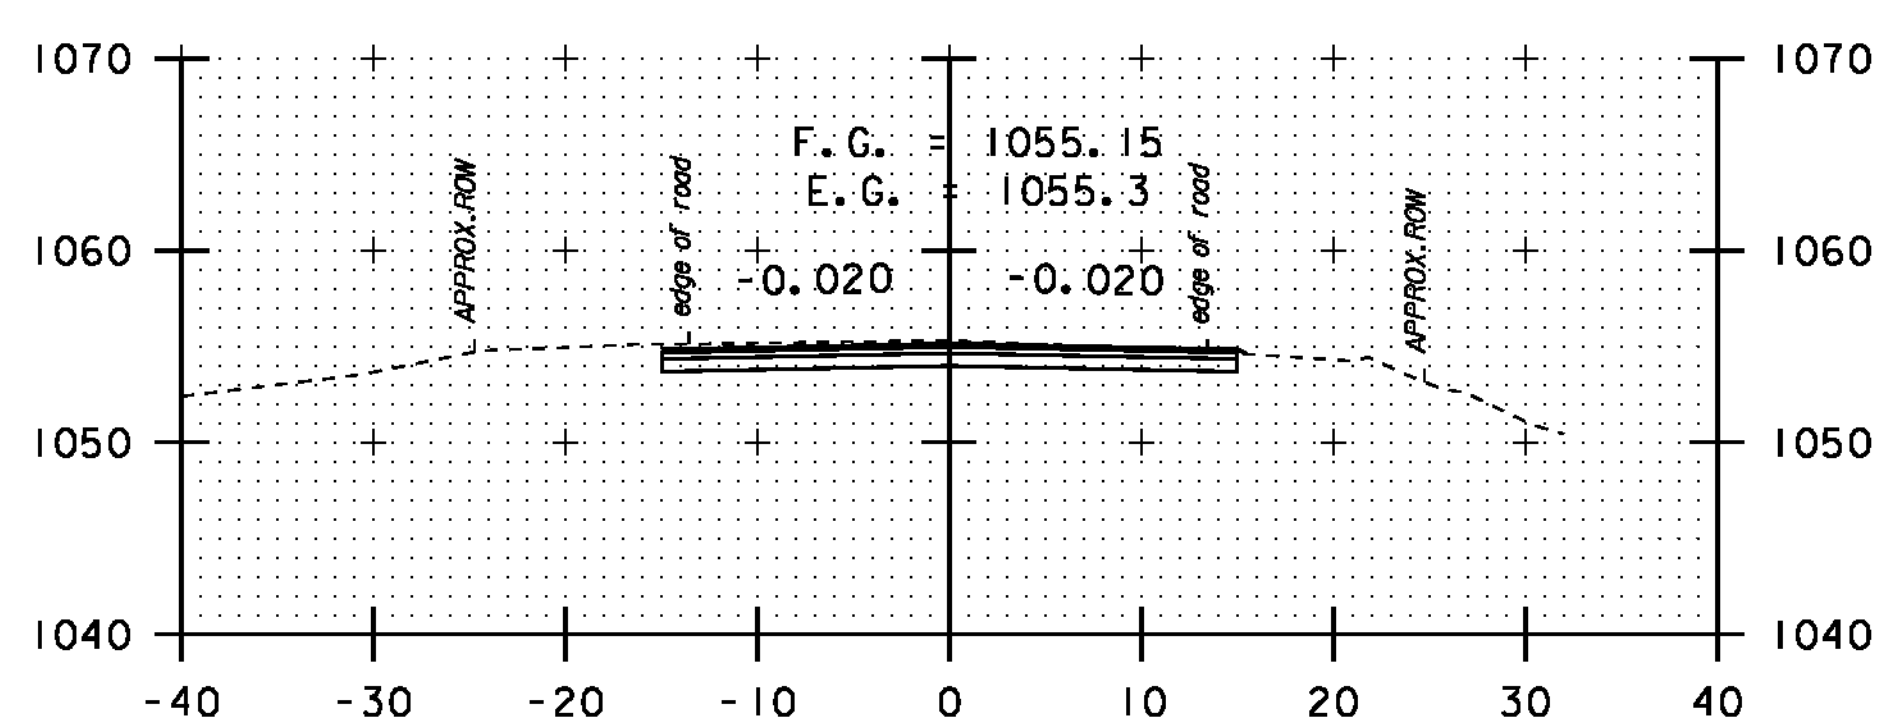


263+70

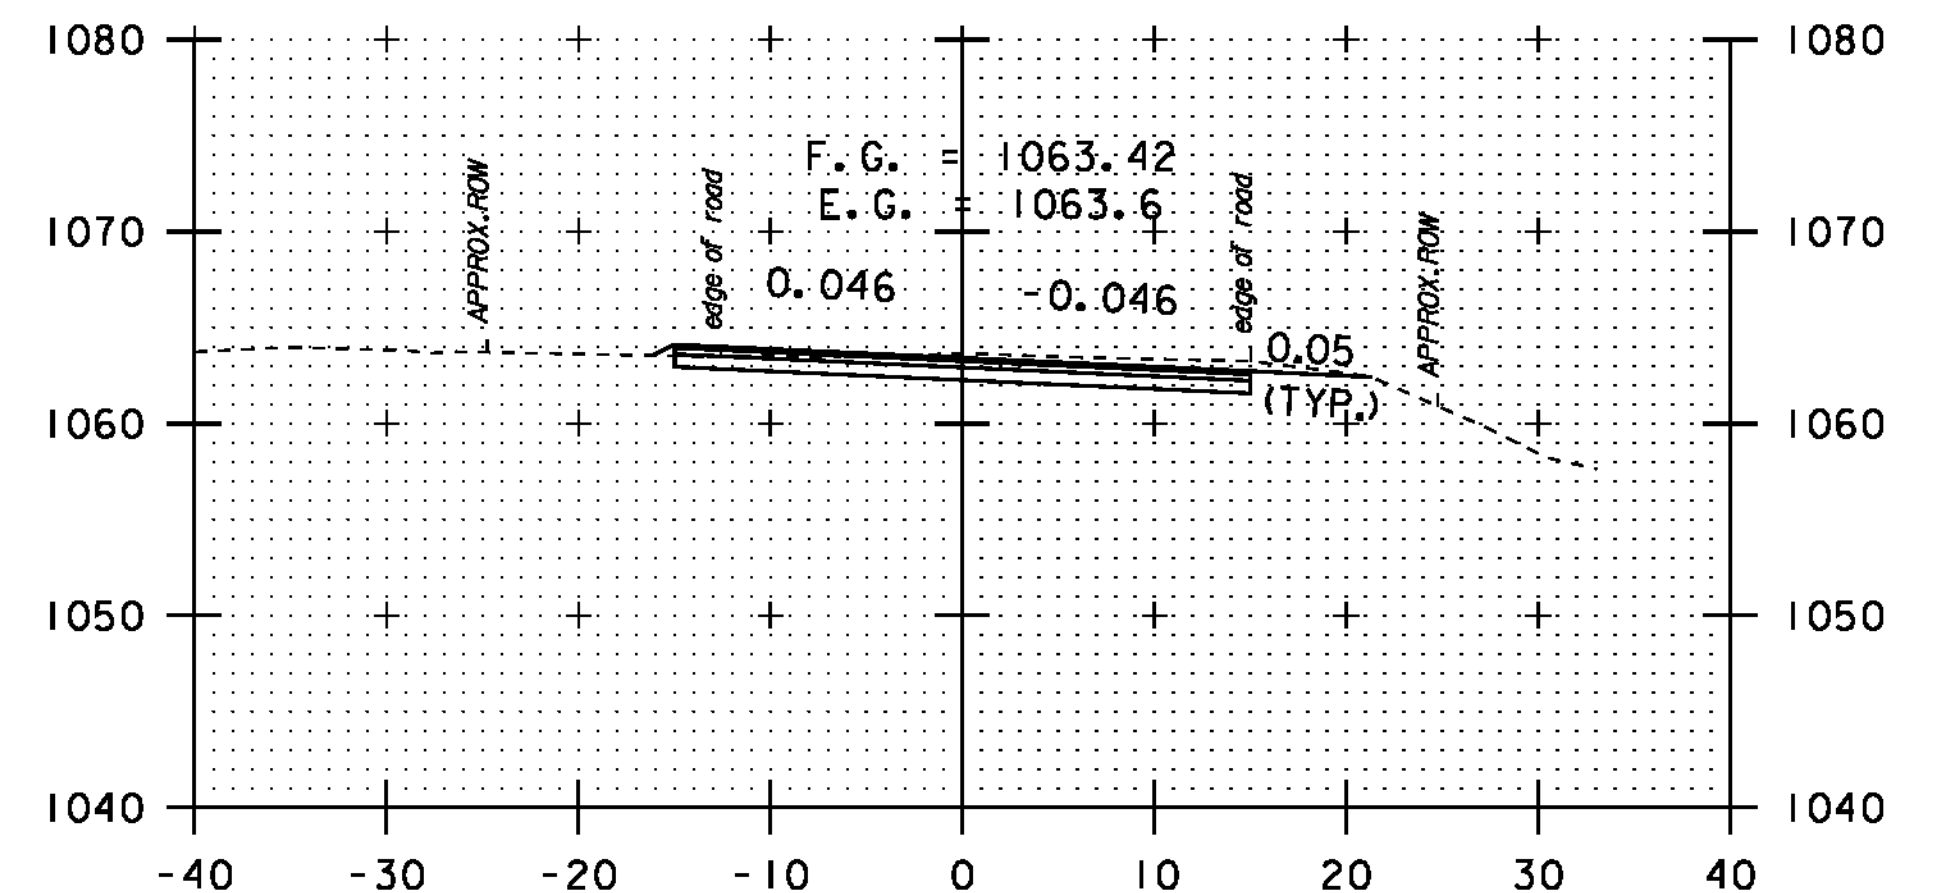

266+20

DATUM	NAVD 88
	NAD 83

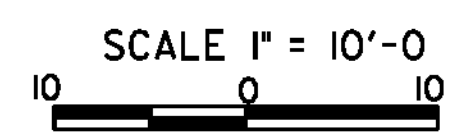

STA. 256+20
-
STA. 267+00

CROSS SECTION SHEET 18

PROJECT NAME:	NEWPORT-COVENTRY-NEWPORT
PROJECT NUMBER:	STP 2802(I)
FILE NAME:	08b158.dgn
PROJECT LEADER:	CDL
DESIGNED BY:	BMB
PLOT FILE:	08b158-91.l
PLOT DATE:	8/3/2011
DRAWN BY:	BMB
CHECKED BY:	EPD
SHEET	91 OF 134