




272+50

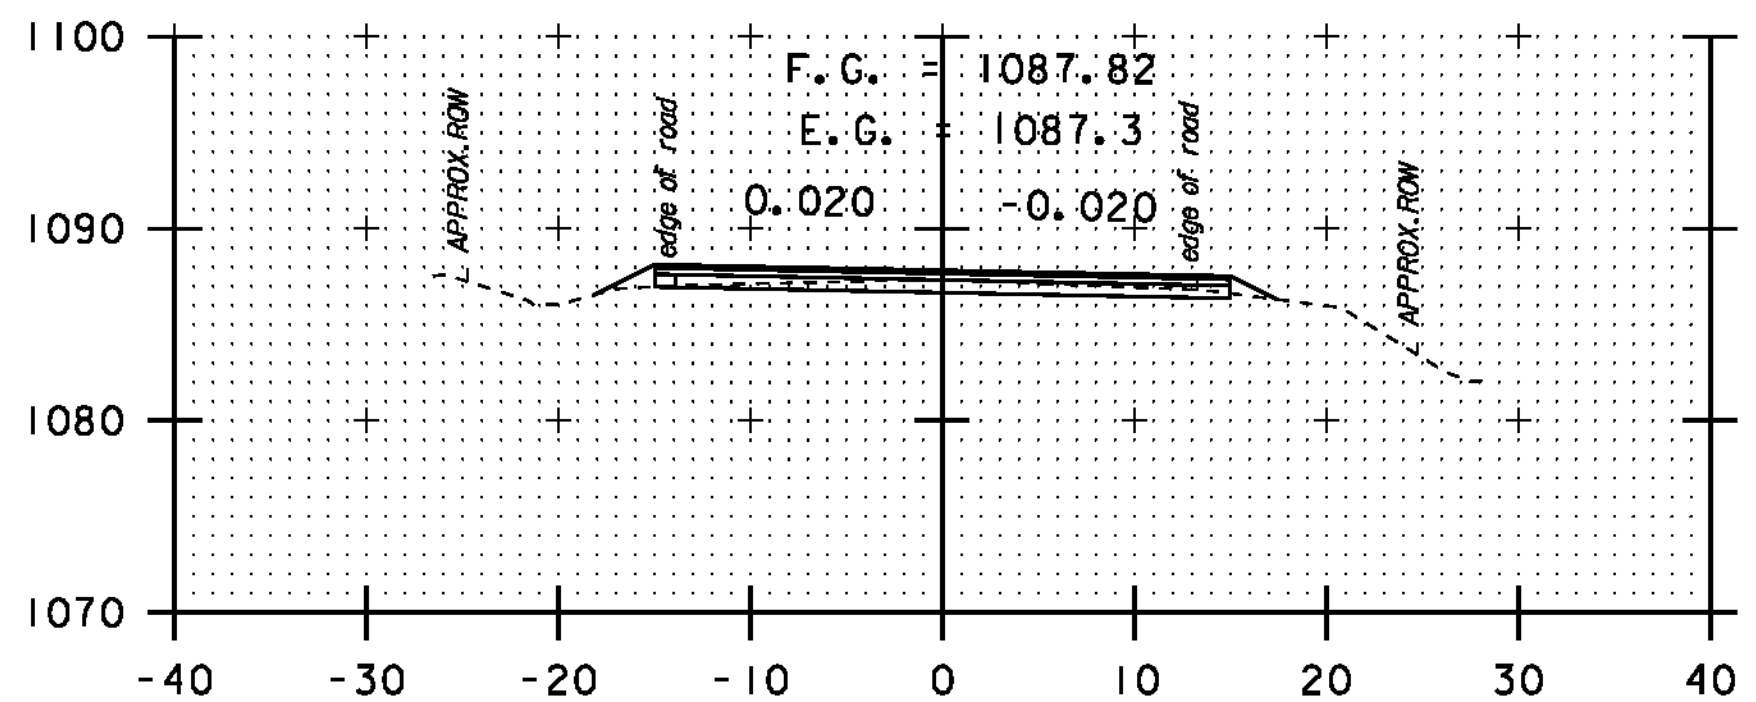


274+00

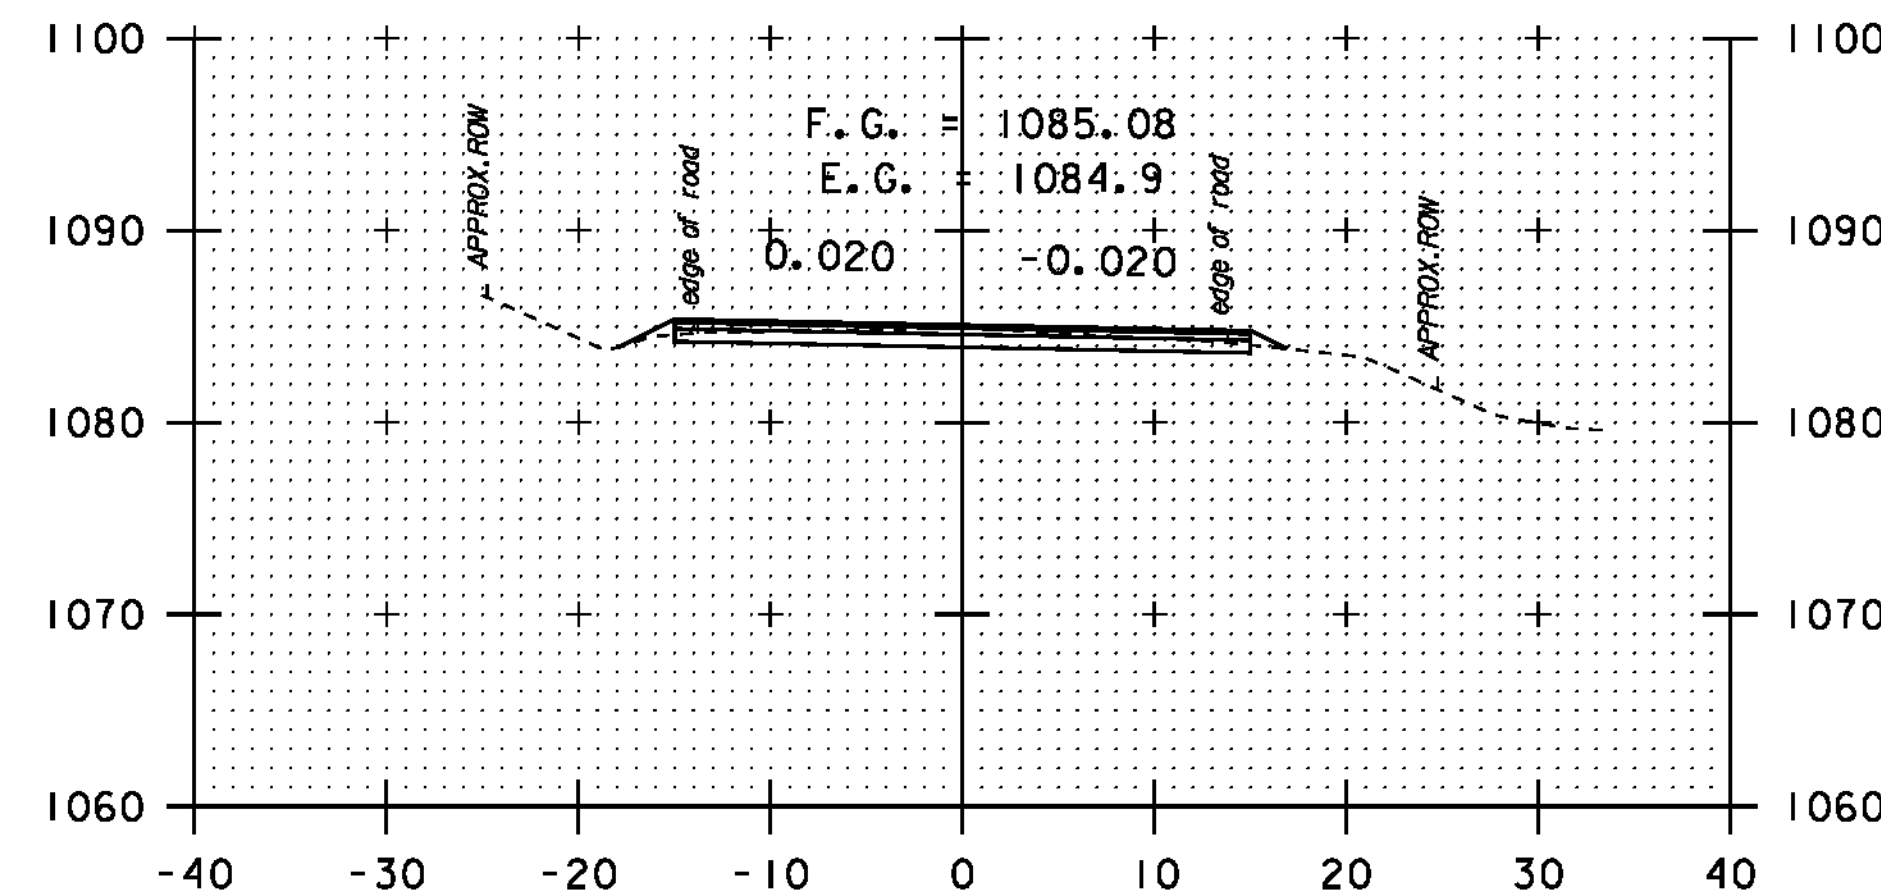


275+50

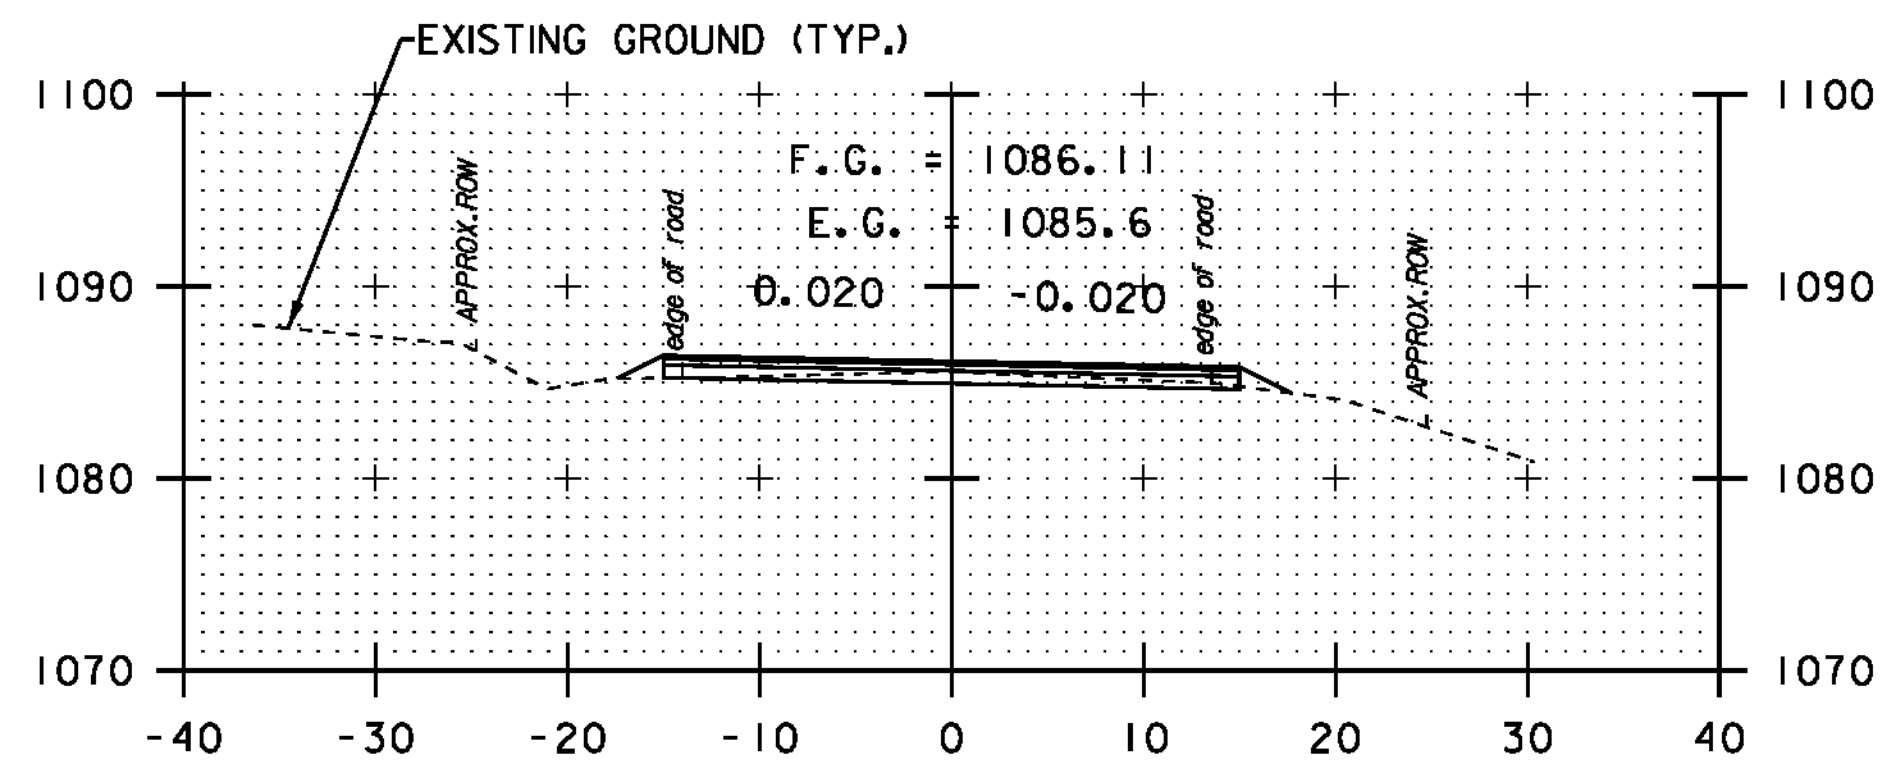


272+00

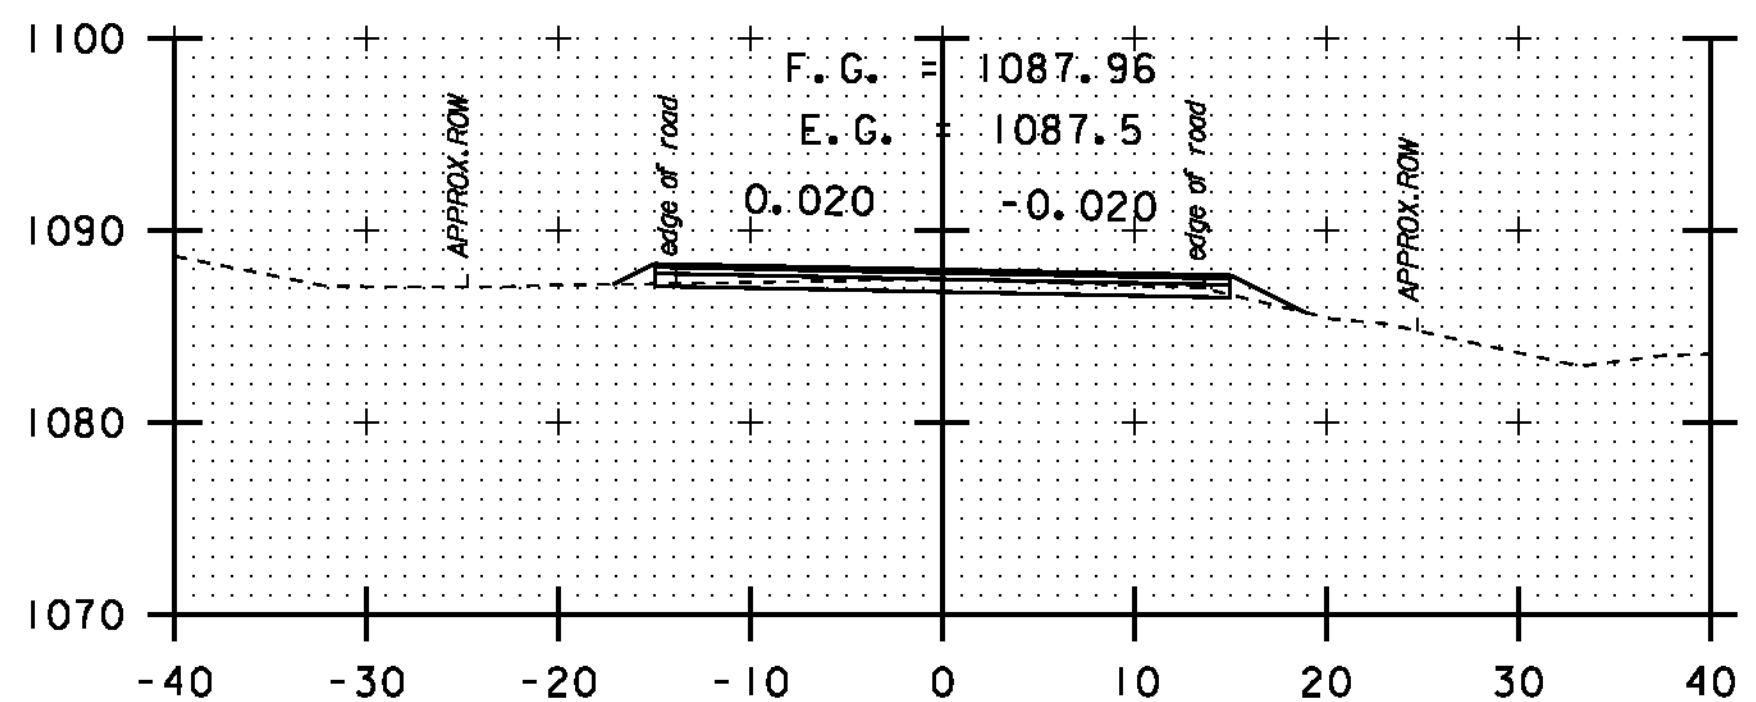


273+50

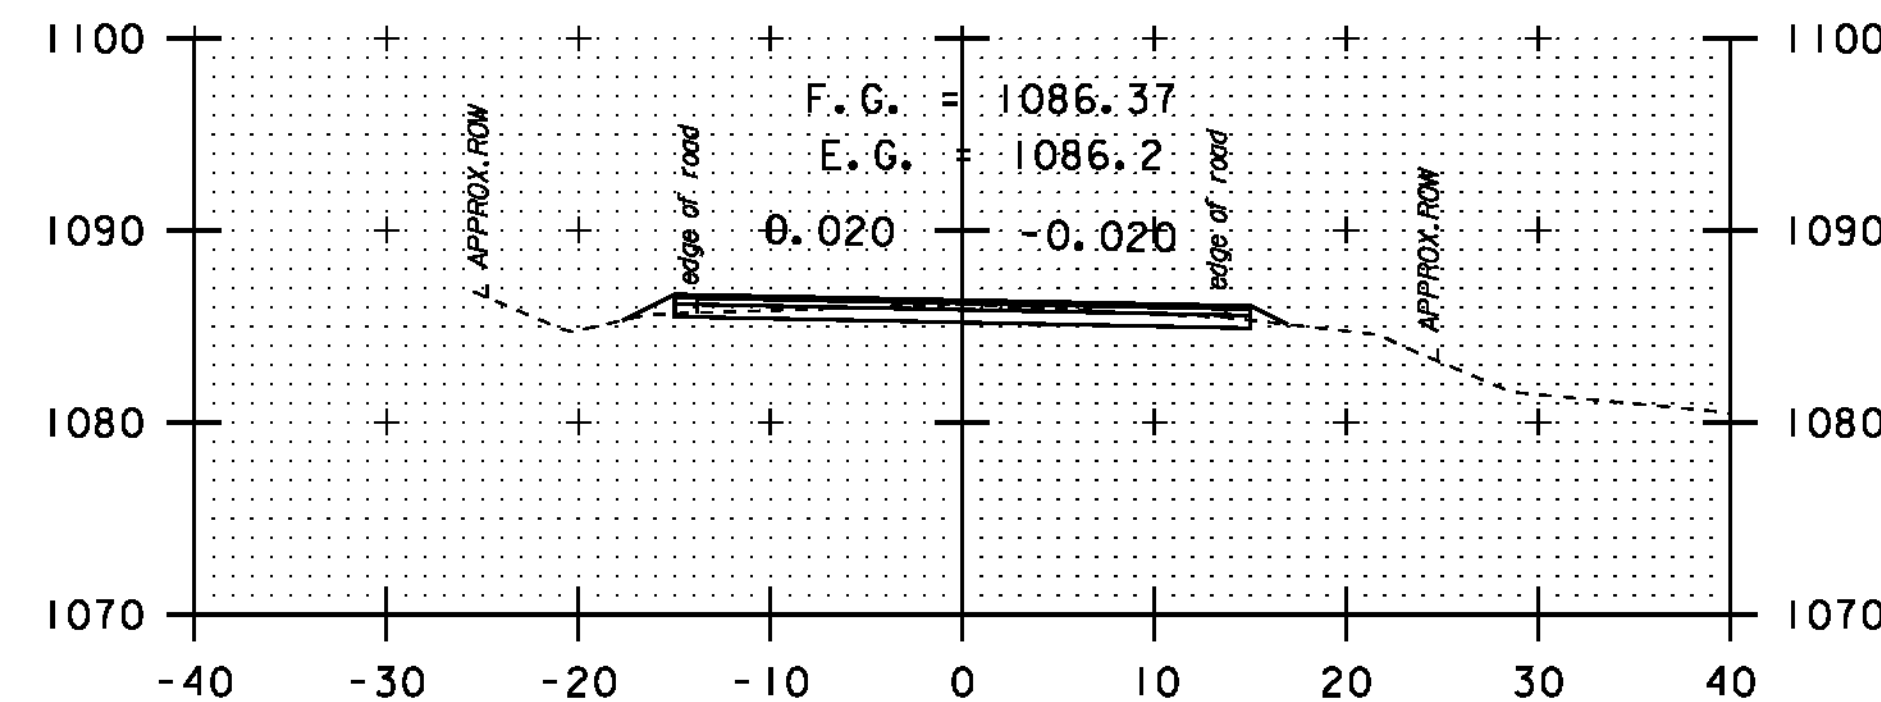


275+00

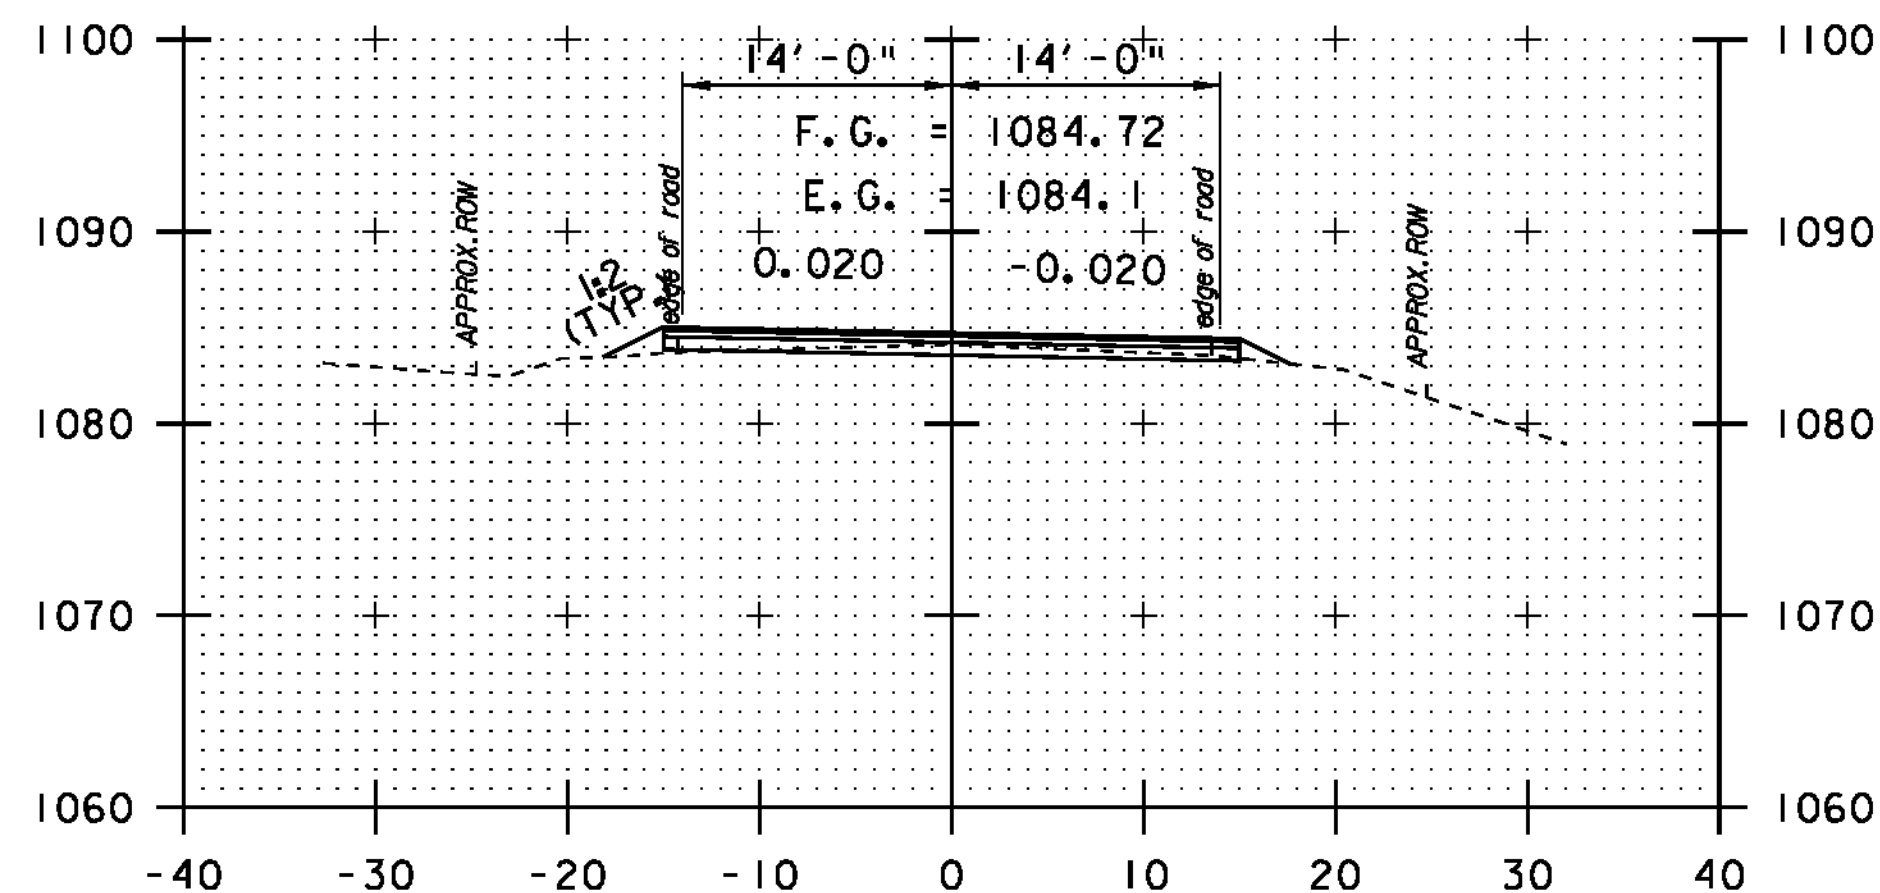

271+50

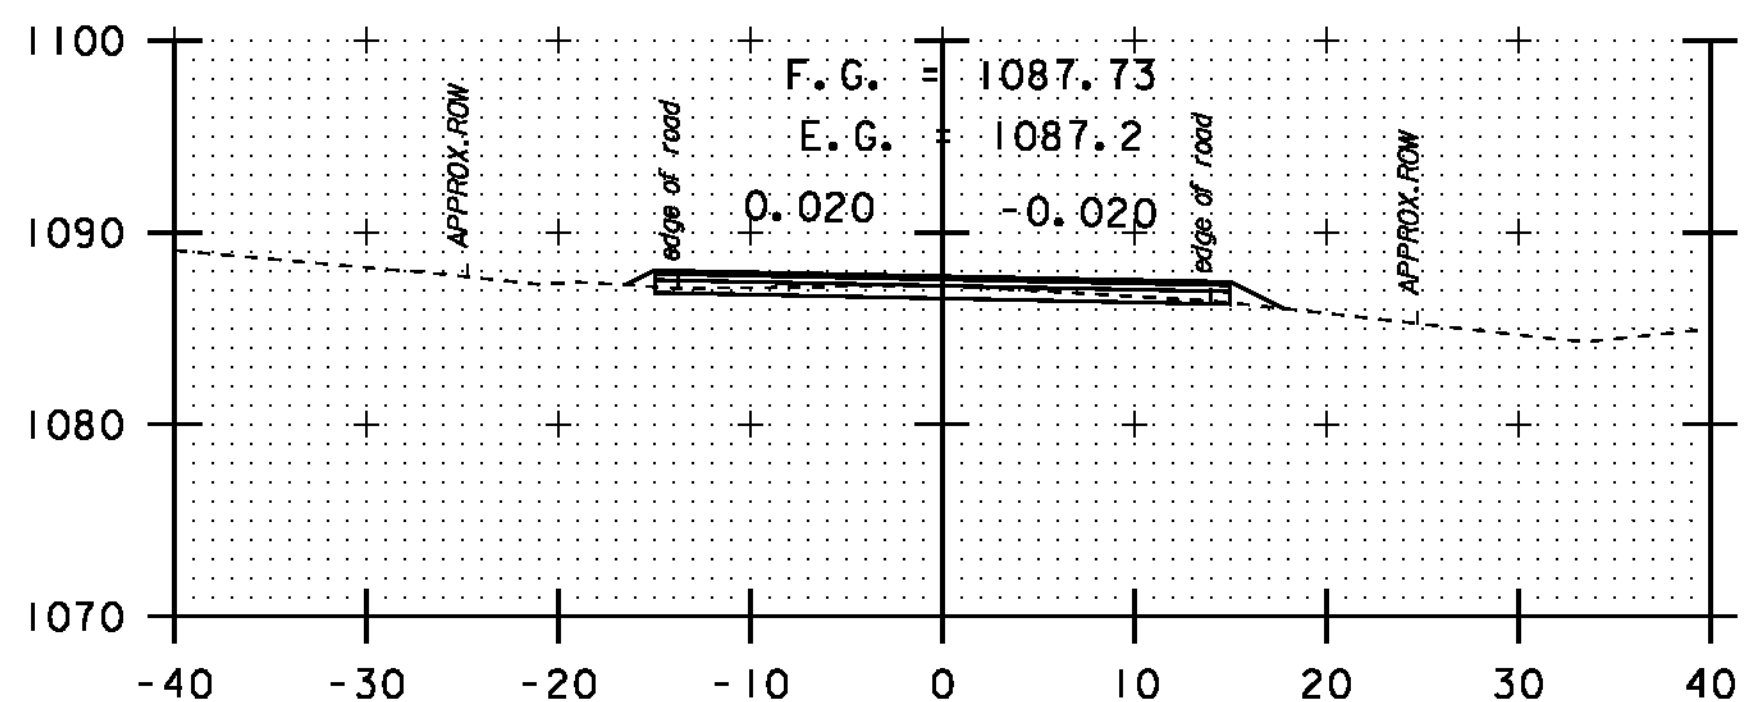

273+00

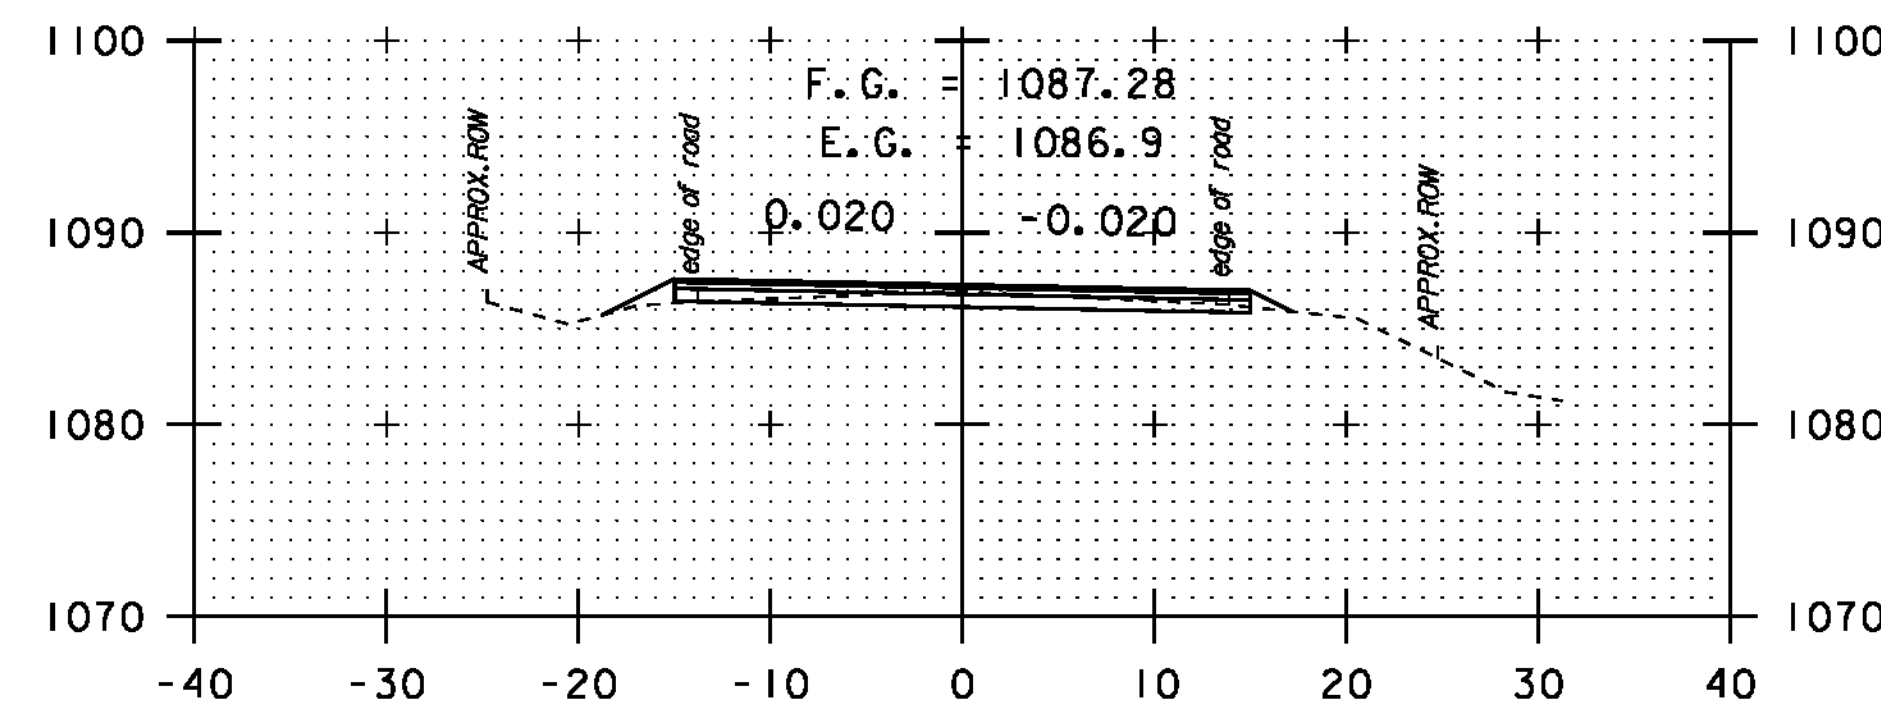

274+50

DATUM	NAVD 88
	NAD 83



**STA. 271 + 50**  
-  
**STA. 275 + 50**

**CROSS SECTION SHEET 20**

PROJECT NAME:	NEWPORT-COVENTRY-NEWPORT
PROJECT NUMBER:	STP 2802(I)
FILE NAME:	08b158.dgn
PROJECT LEADER:	CDL
DESIGNED BY:	BMB
PLOT FILE:	08b158-93.1
PLOT DATE:	8/3/2011
DRAWN BY:	BMB
CHECKED BY:	EPD
SHEET	93 OF 134