



276+66

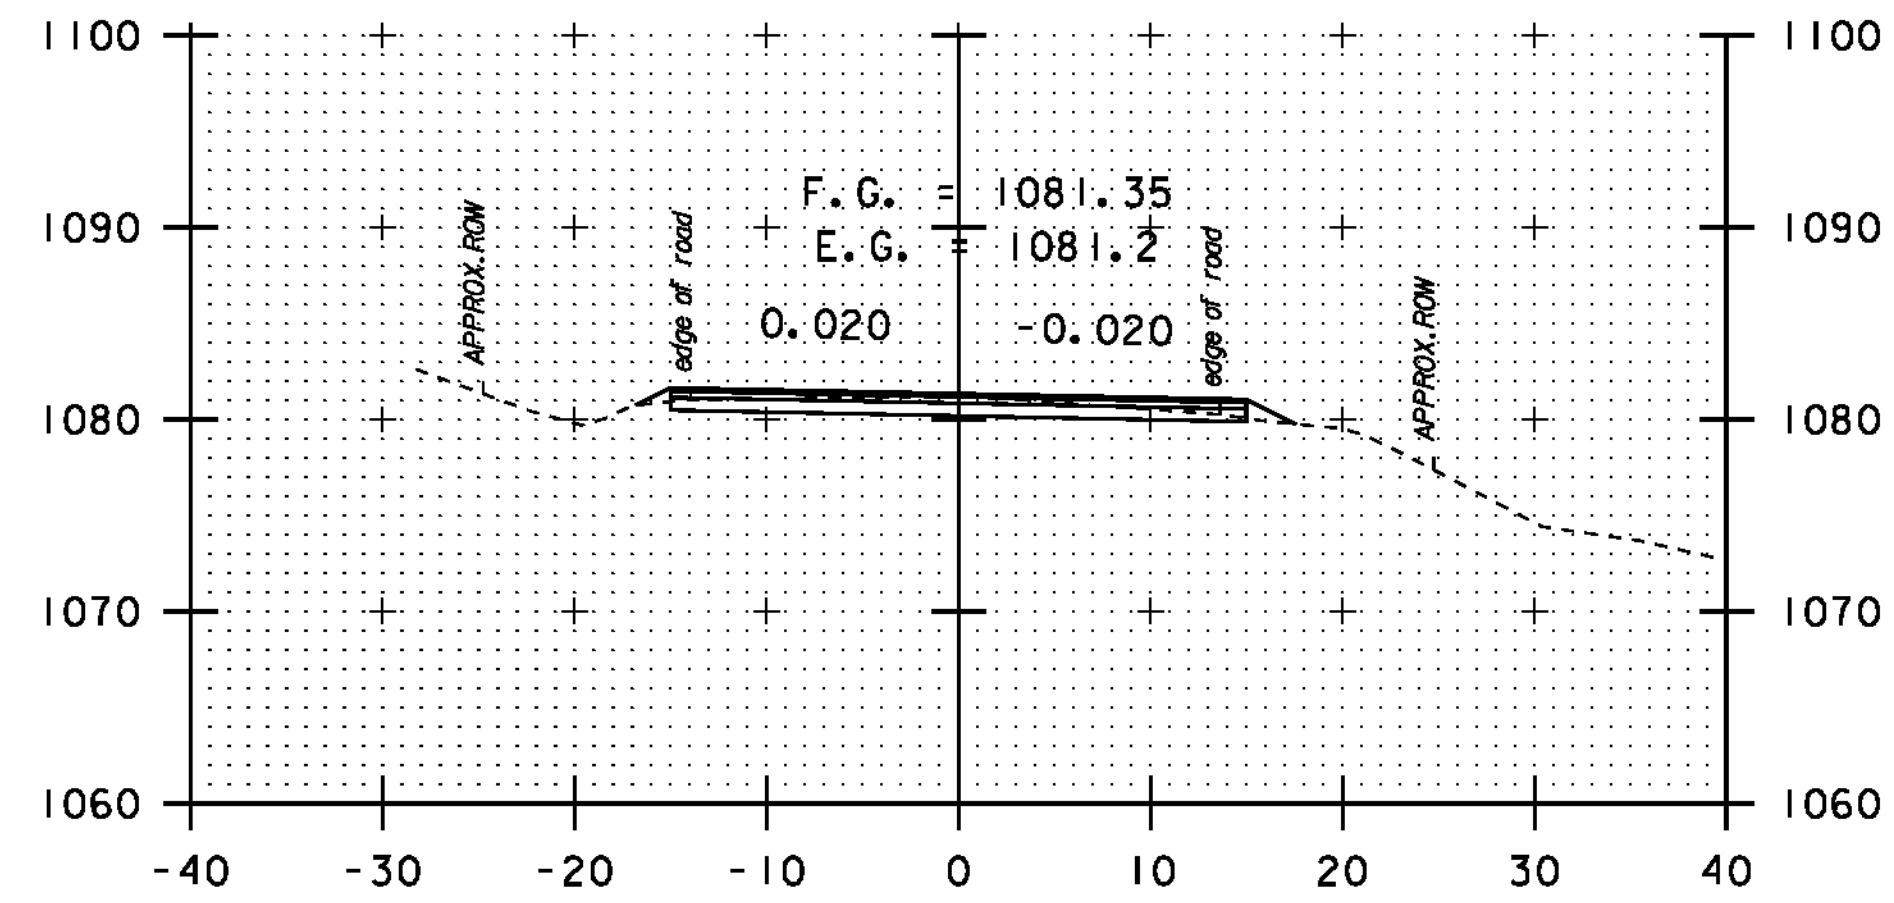

276+50

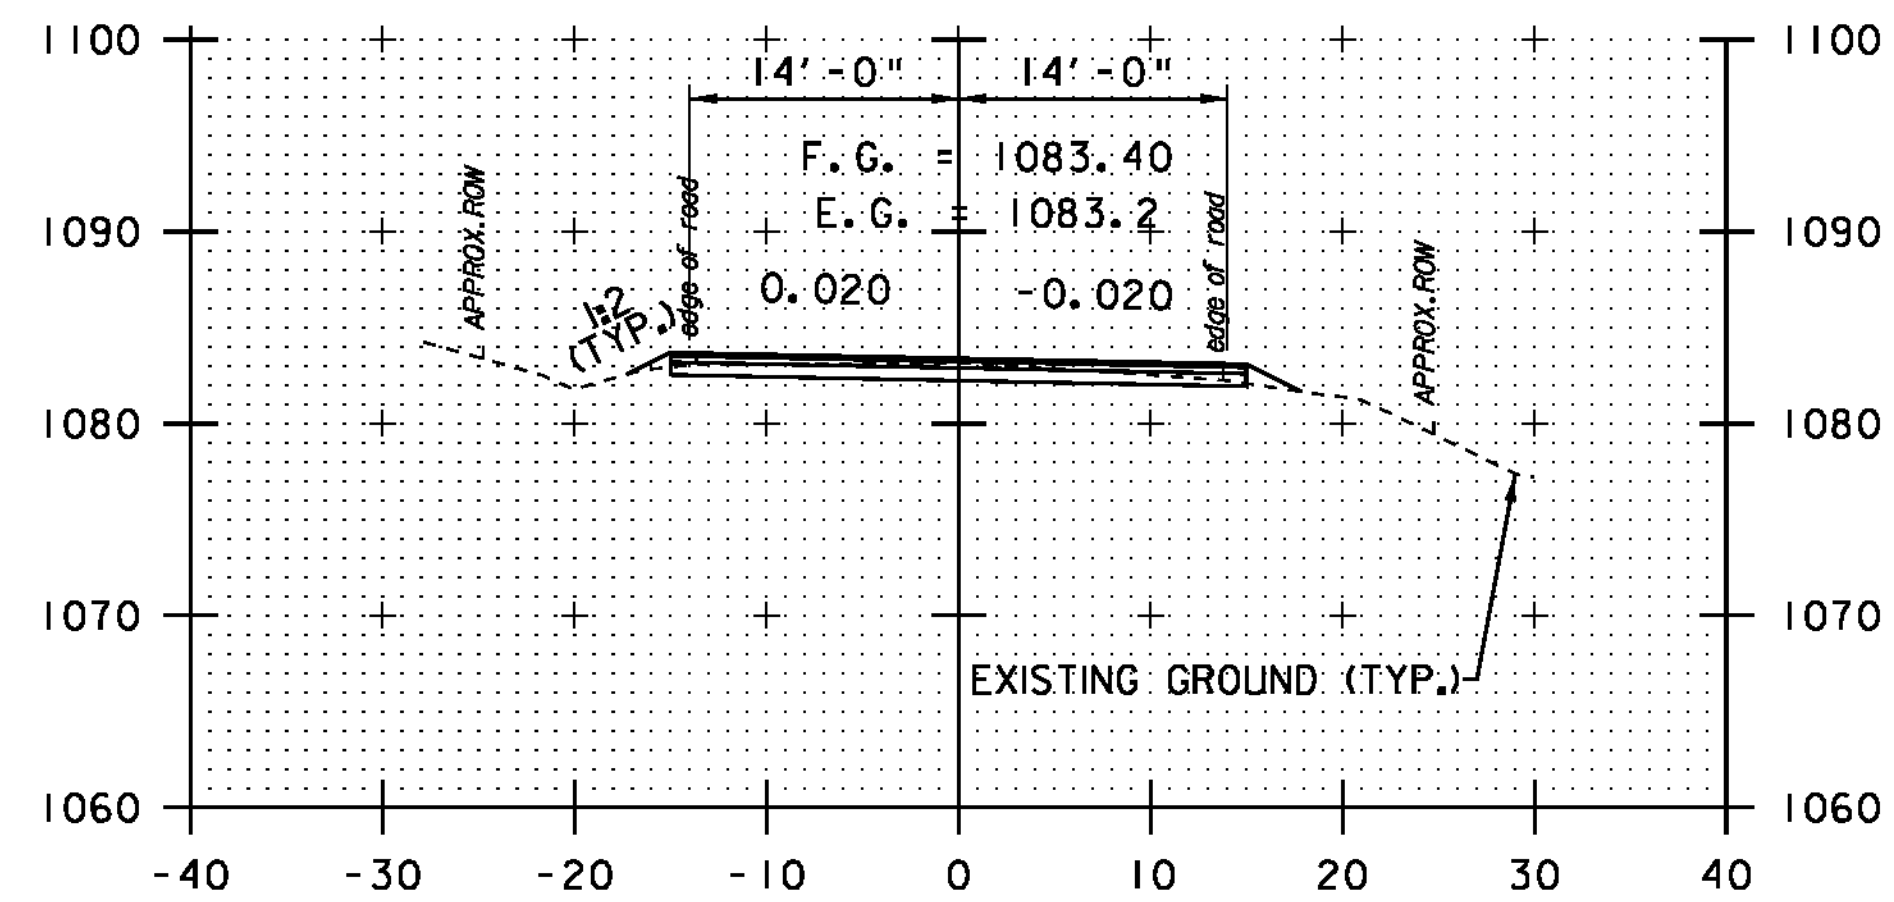

276+00

DATUM	NAVD 88
	NAD 83



**STA. 276 + 00**  
-  
**STA. 276 + 66**

**CROSS SECTION SHEET 21**

PROJECT NAME: NEWPORT-COVENTRY-NEWPORT	PLOT DATE: 8/3/2011
PROJECT NUMBER: STP 2802(I)	DRAWN BY: BMB
FILE NAME: 08b158.dgn	CHECKED BY: EPD
PROJECT LEADER: CDL	SHEET 94 OF 134
DESIGNED BY: BMB	
PLOT FILE: 08b158-94.1	