




1+00

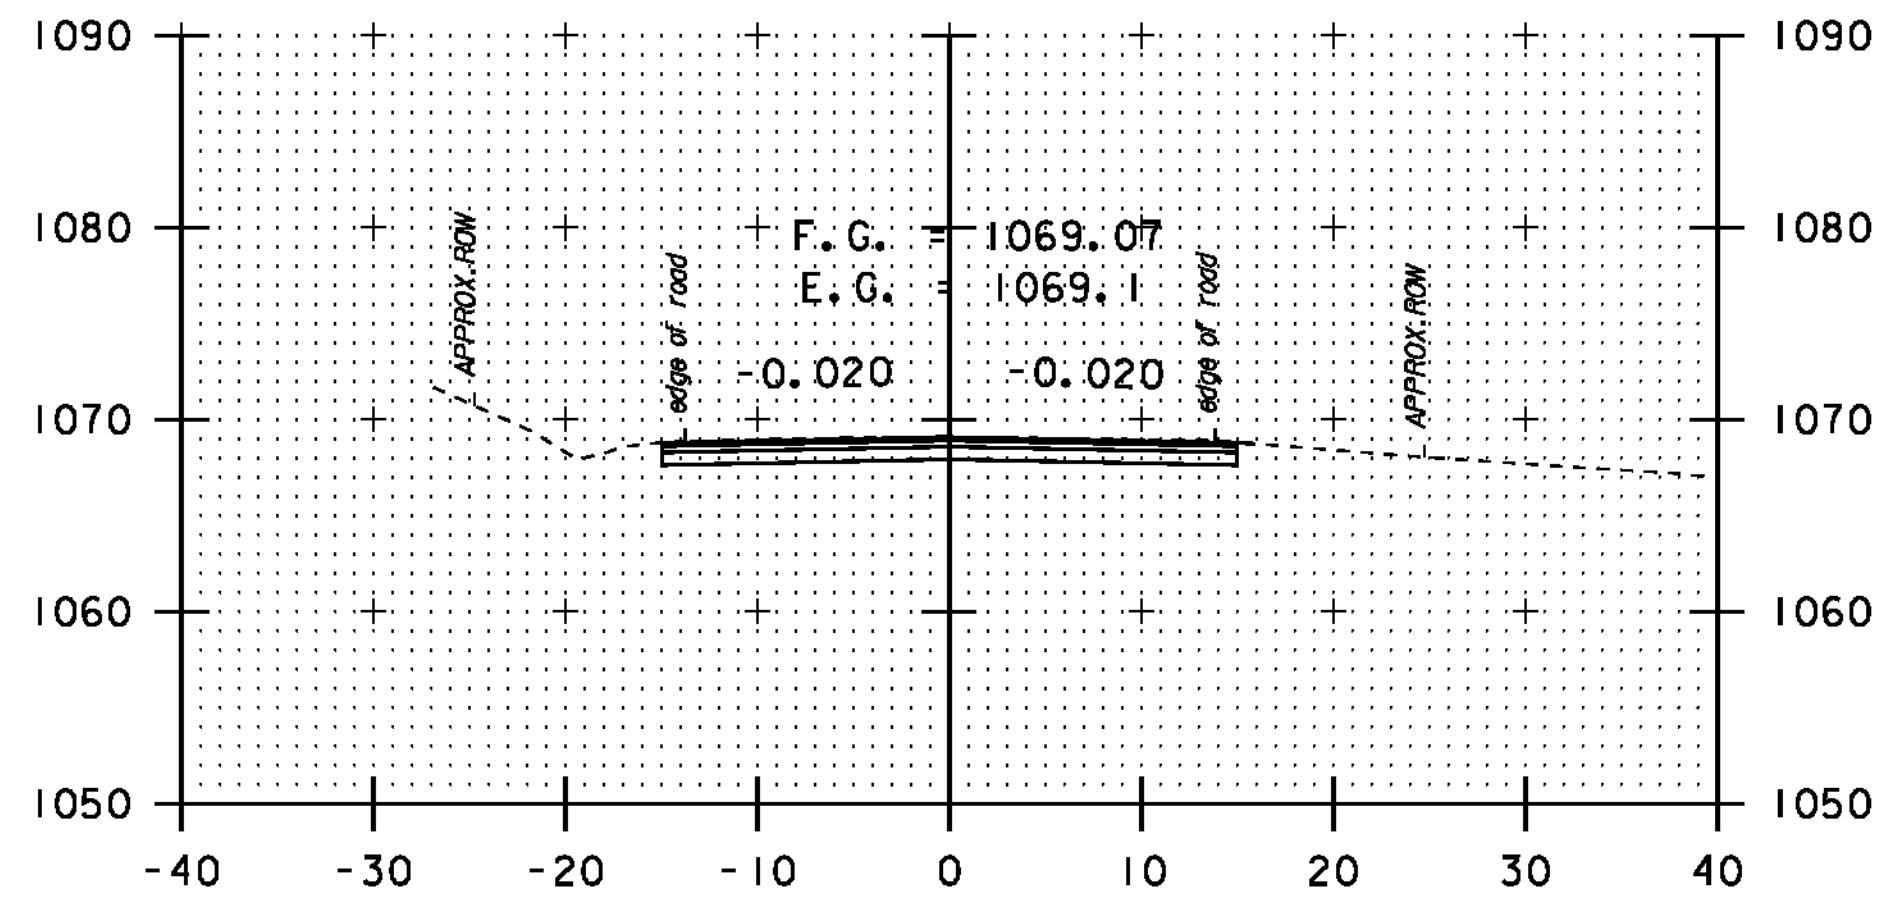


4+00

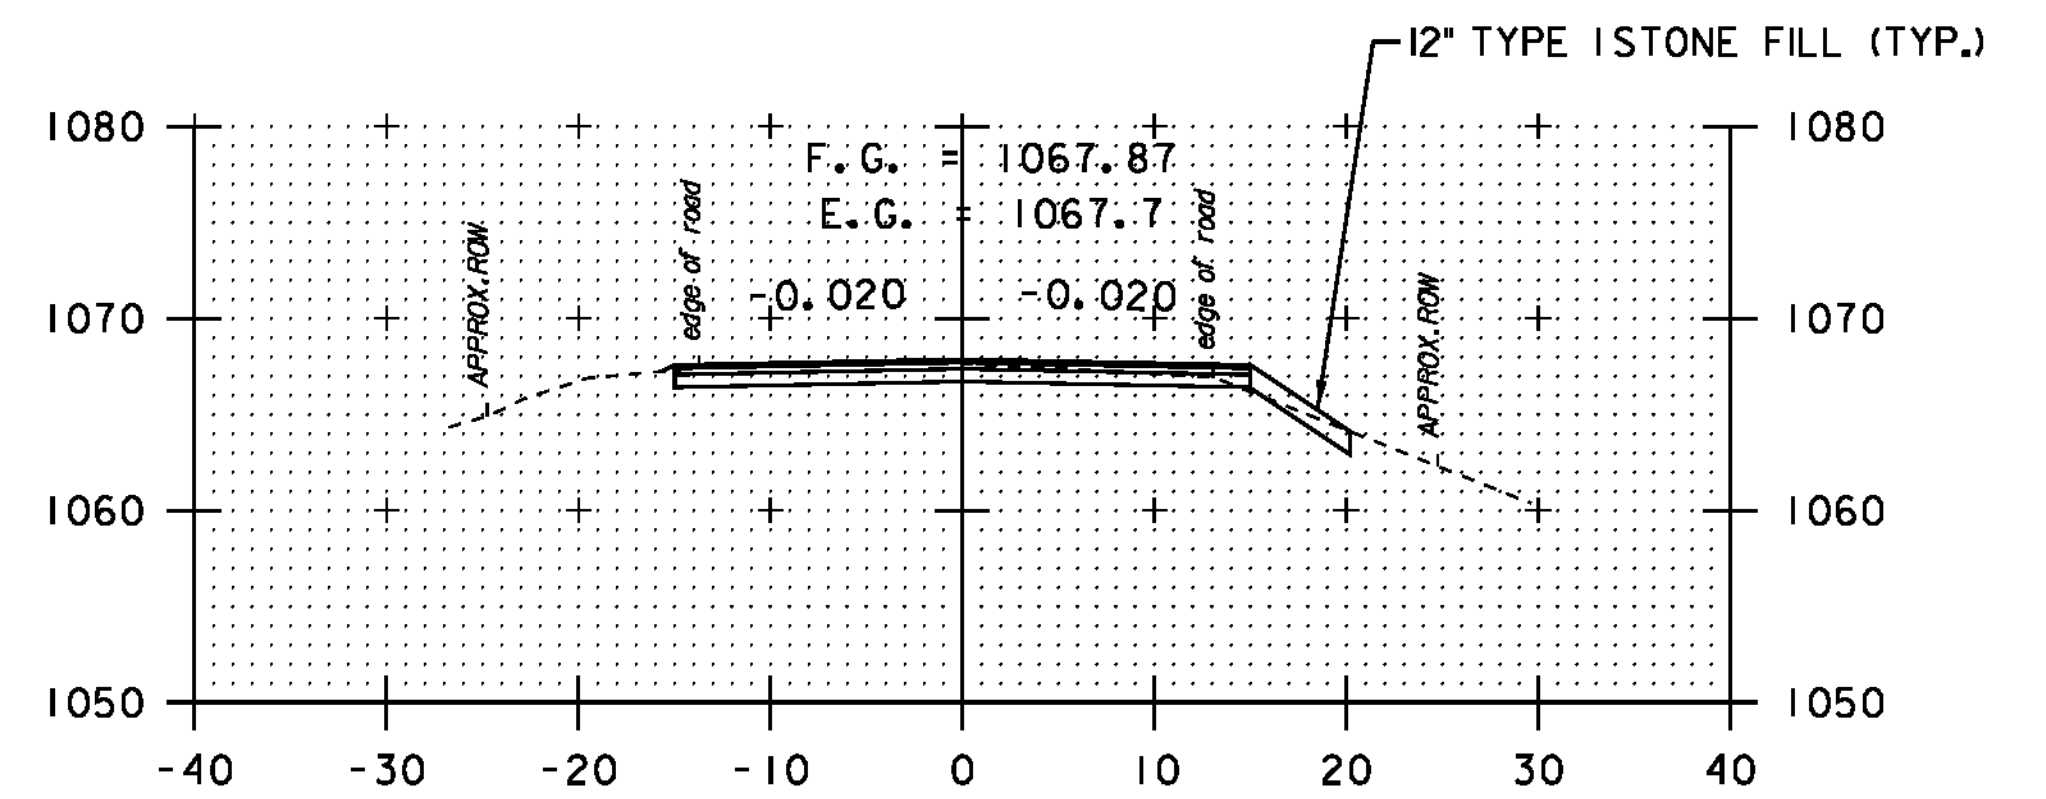


8+15

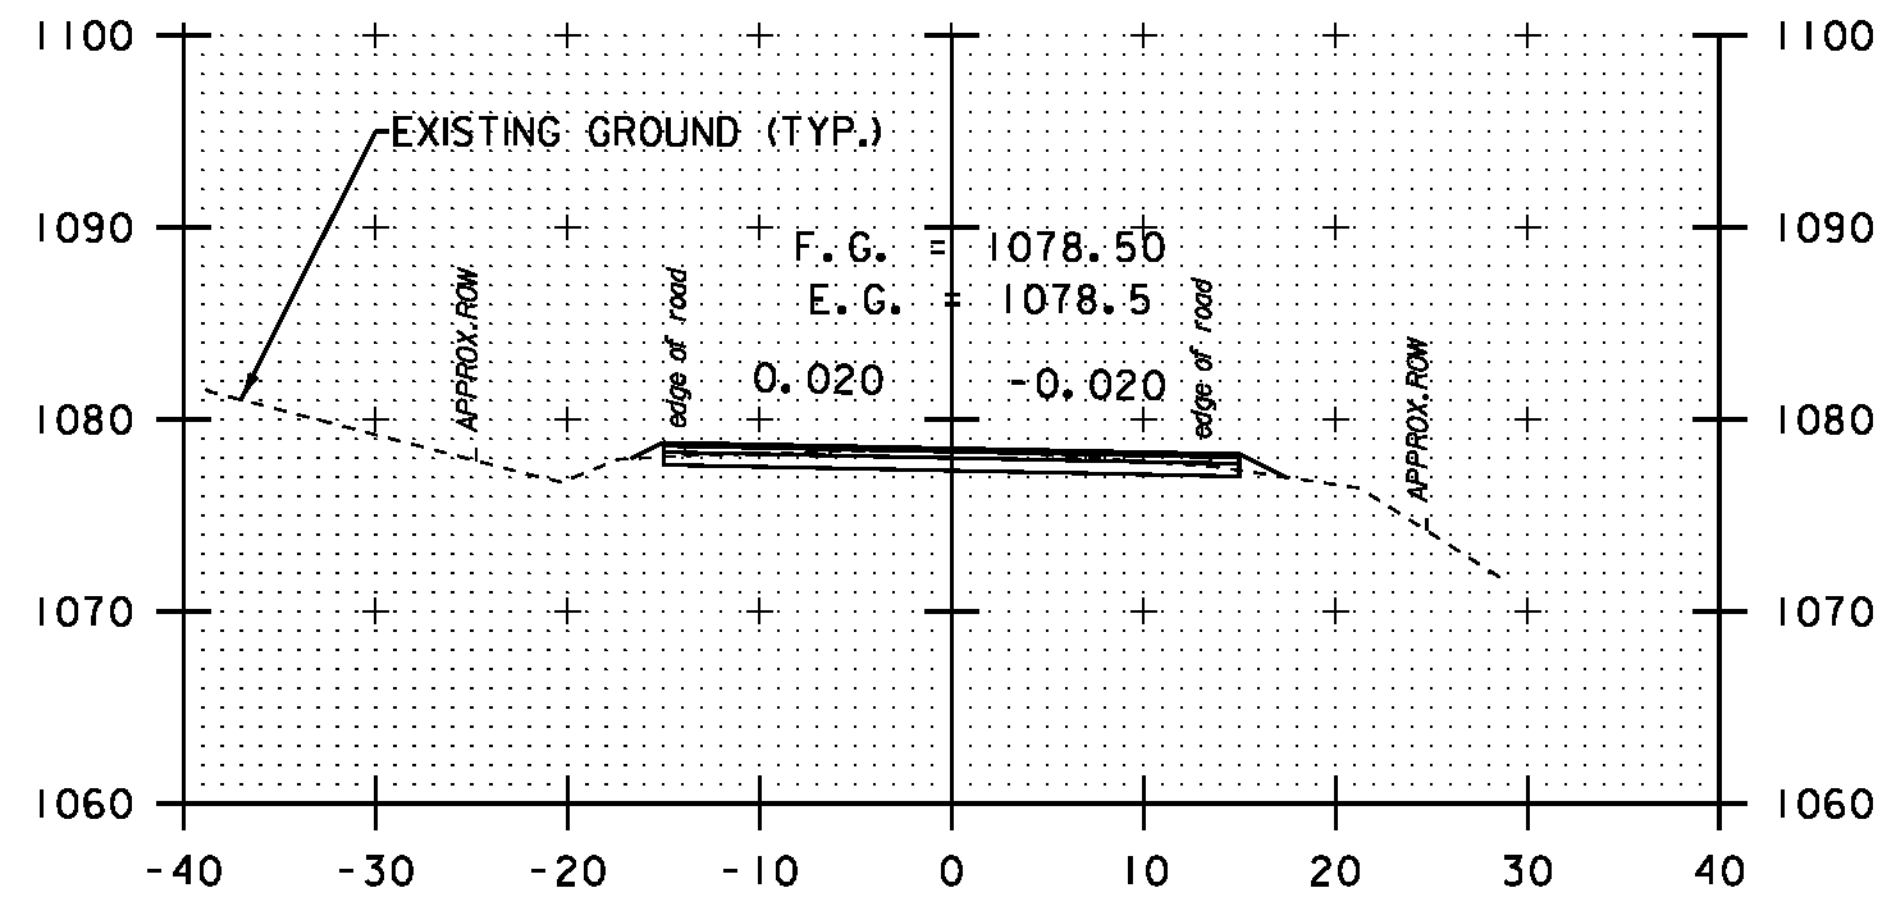


0+50

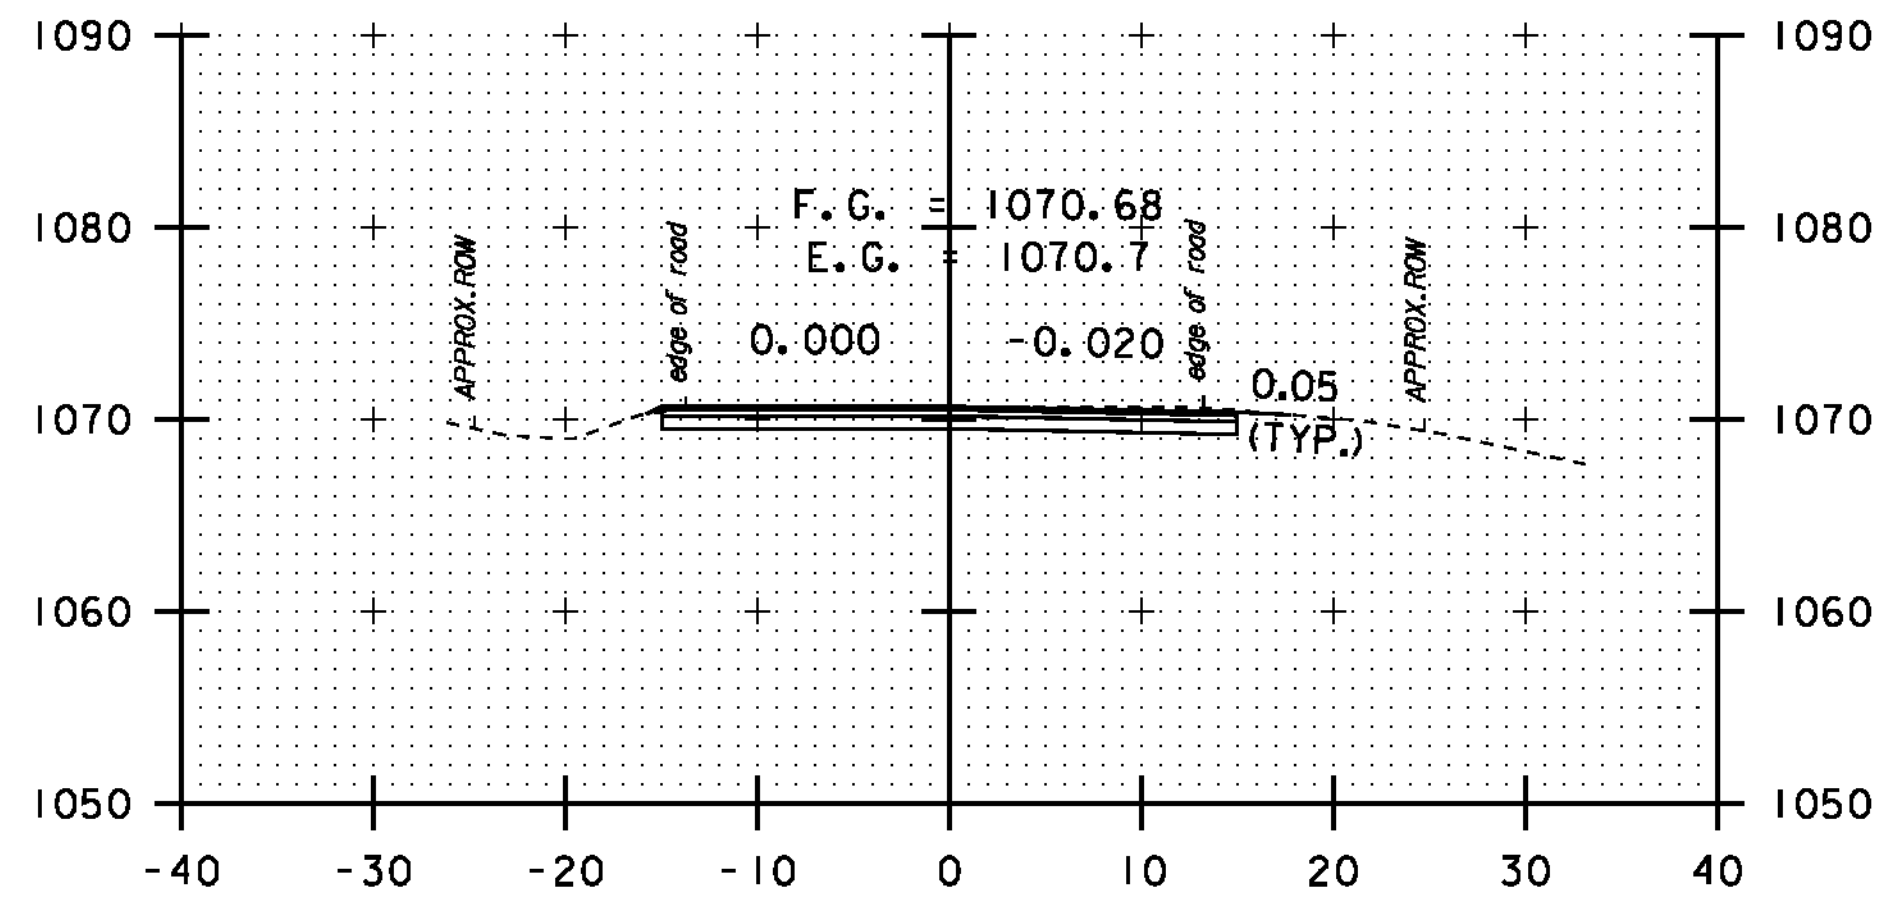


3+00

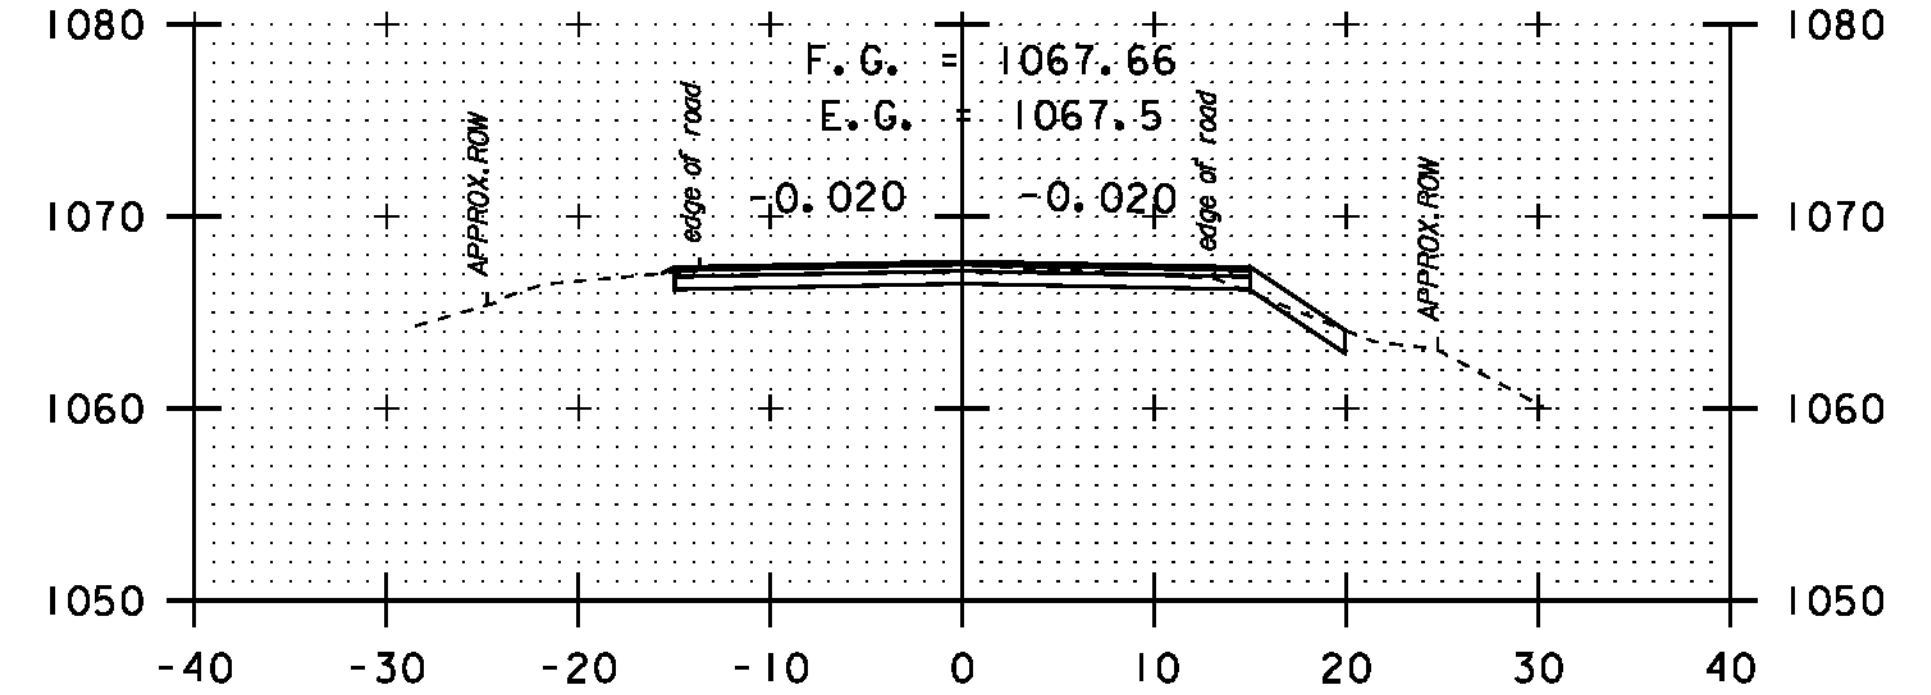


8+00

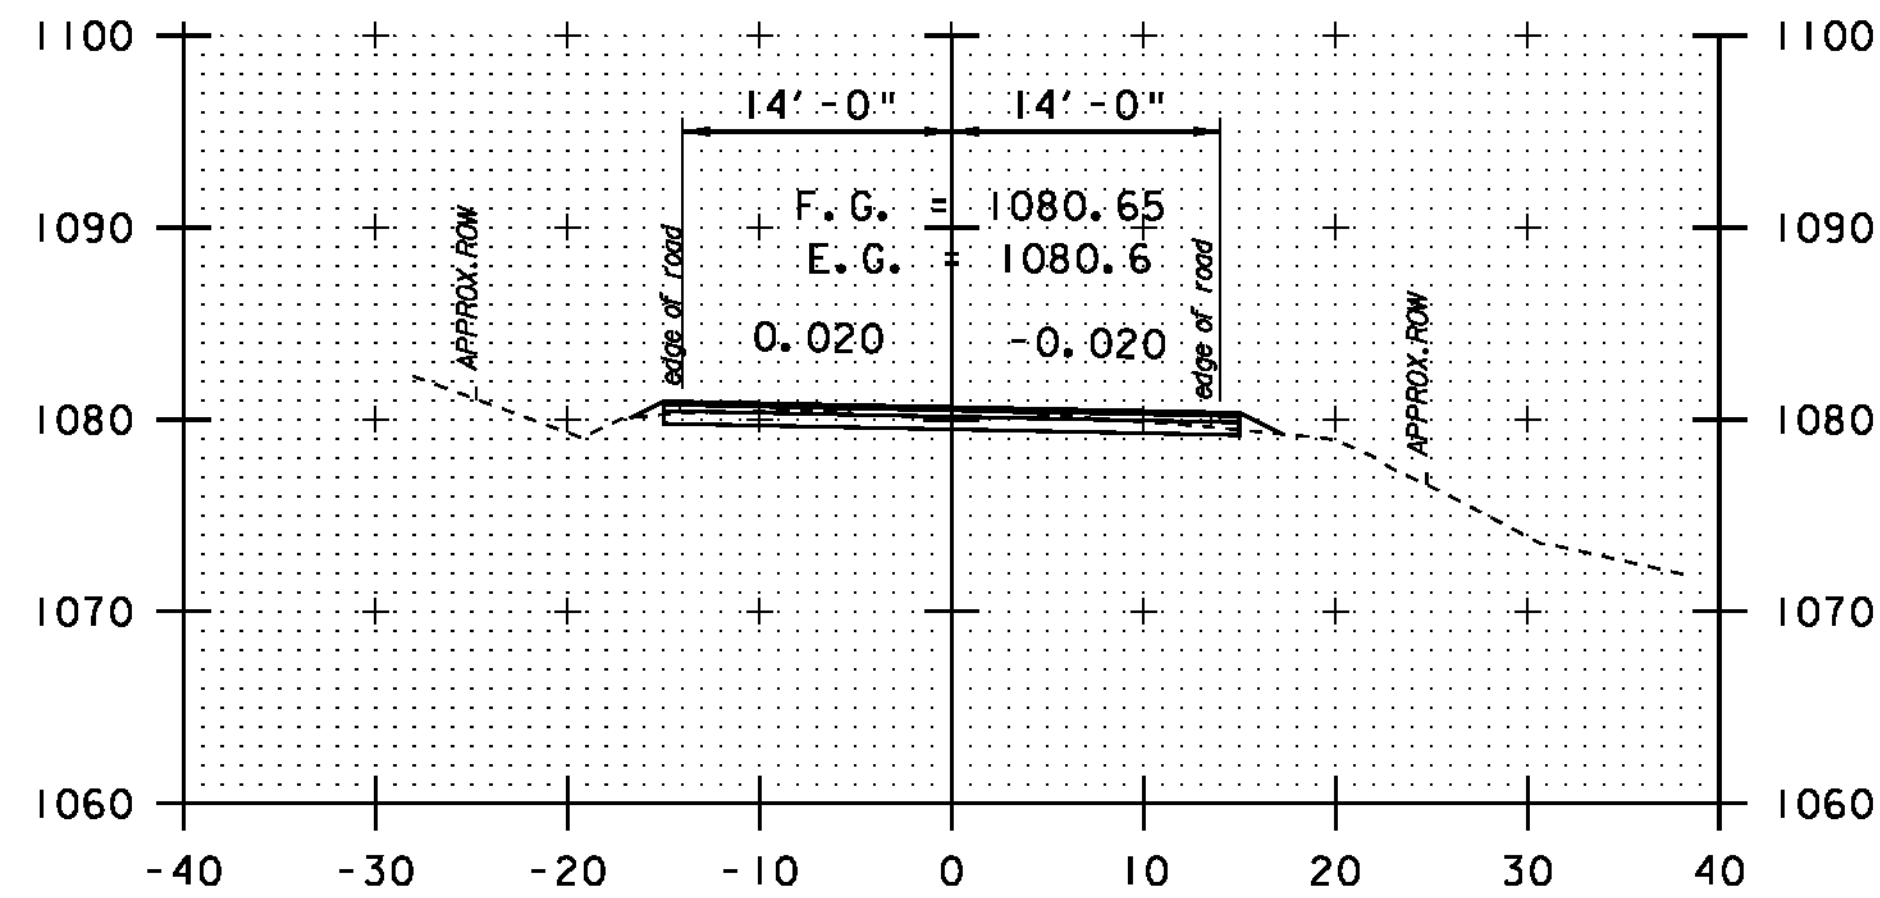

0+00

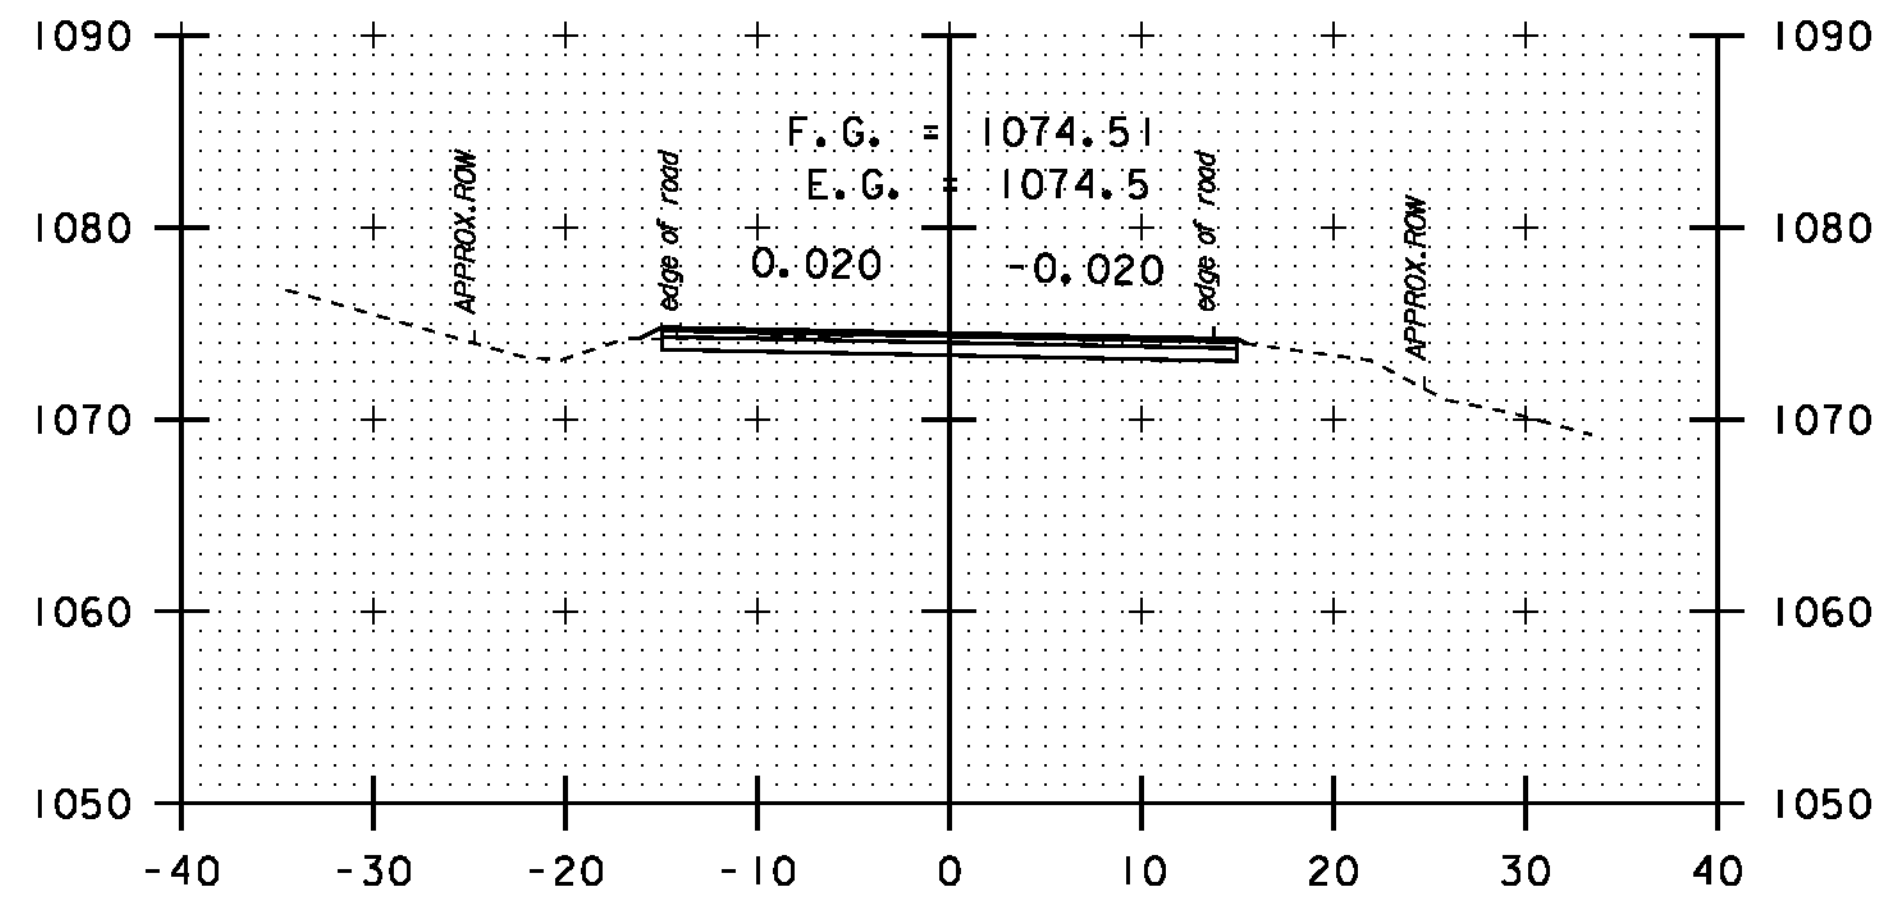

1+50

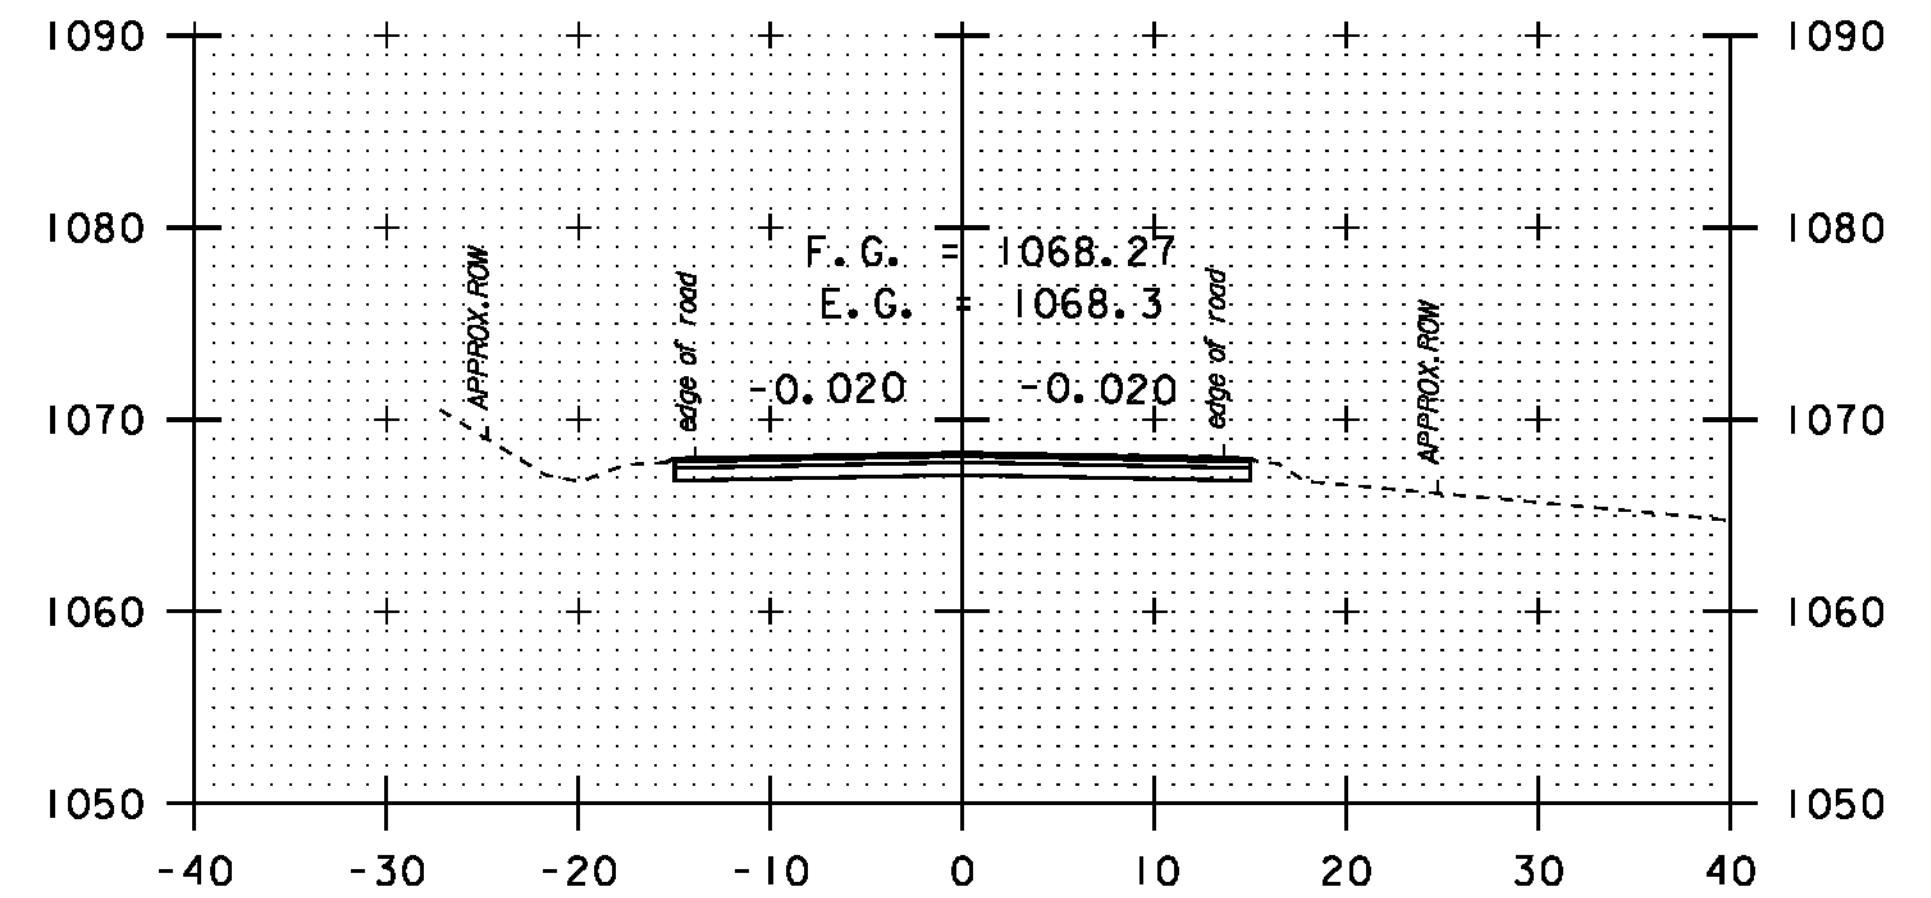

4+50

DATUM	NAVD 88
	NAD 83



<b>STA. 0+00</b> - <b>STA. 8+15</b>	<b>CROSS SECTION SHEET 22</b>	PROJECT NAME: NEWPORT-COVENTRY-NEWPORT
		PROJECT NUMBER: STP 2802 (I)
FILE NAME: 08b158.dgn	PLOT DATE: 8/3/2011	
PROJECT LEADER: CDL	DRAWN BY: BMB	
DESIGNED BY: BMB	CHECKED BY: EPD	
PLOT FILE: 08b158-95.1	SHEET 95 OF 134	