


DATUM	NAVD 88
	NAD 83

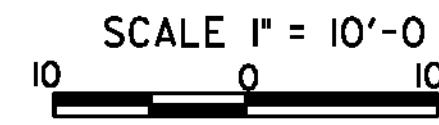

STA. 9+15 - STA. 13+50	CROSS SECTION SHEET 23	PROJECT NAME: NEWPORT-COVENTRY-NEWPORT	PLOT DATE: 8/3/2011
		PROJECT NUMBER: STP 2802 (I)	DRAWN BY: BMB
		FILE NAME: 08b158.dgn	CHECKED BY: EPD
		PROJECT LEADER: CDL	SHEET 96 OF 134
		DESIGNED BY: SJL	
		PLOT FILE: 08b158-96.1	