


DATUM	NAVD 88
	NAD 83

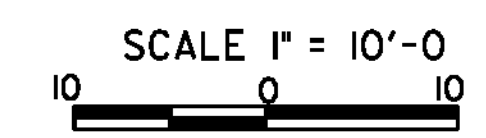

<b>STA. 19+13</b> - <b>STA. 23+50</b>	<b>CROSS SECTION SHEET 25</b>	PROJECT NAME: NEWPORT-COVENTRY-NEWPORT	PLOT DATE: 8/3/2011
		PROJECT NUMBER: STP 2802 (I)	DRAWN BY: BMB
		FILE NAME: 08b158.dgn	CHECKED BY: EPD
		PROJECT LEADER: CDL	SHEET 98 OF 134
		DESIGNED BY: BMB	
		PLOT FILE: 08b158-98.1	