




30+50

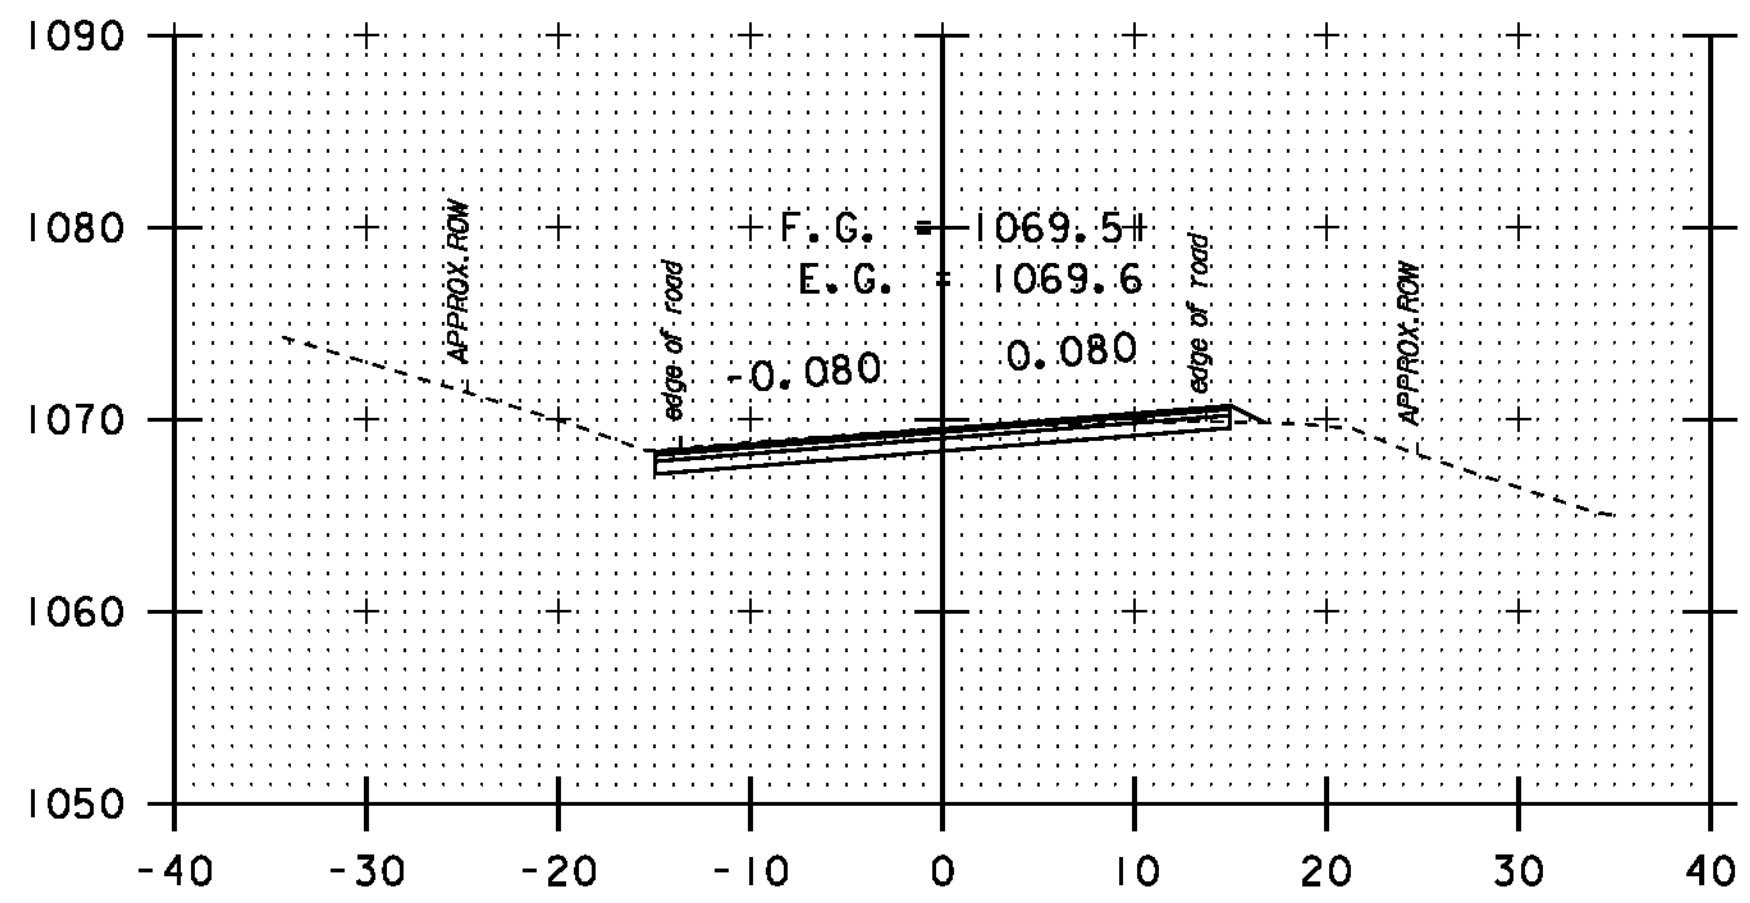


32+00

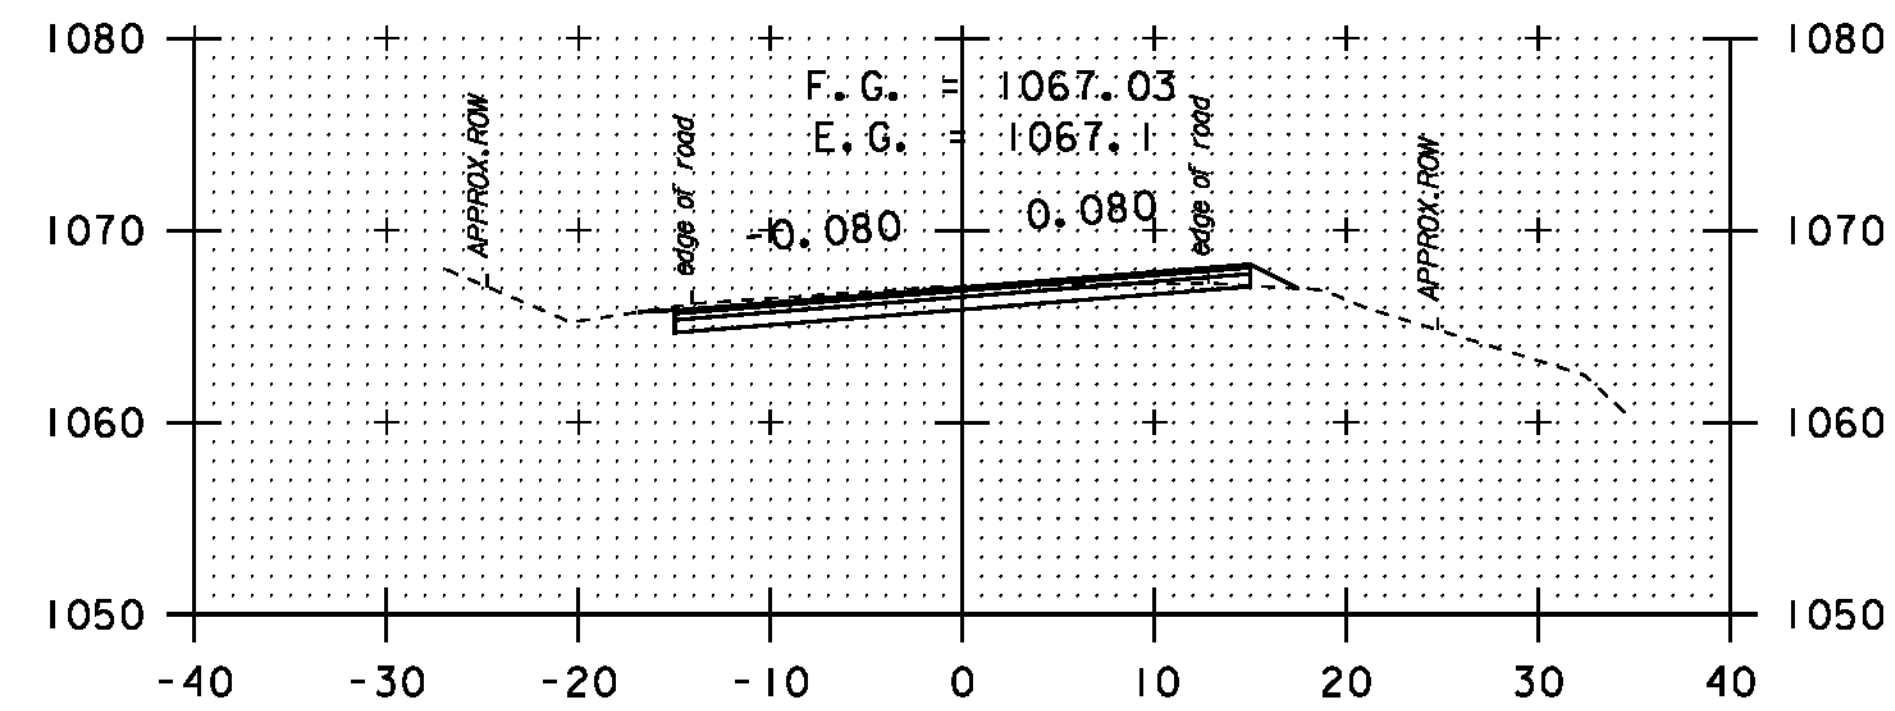


33+50

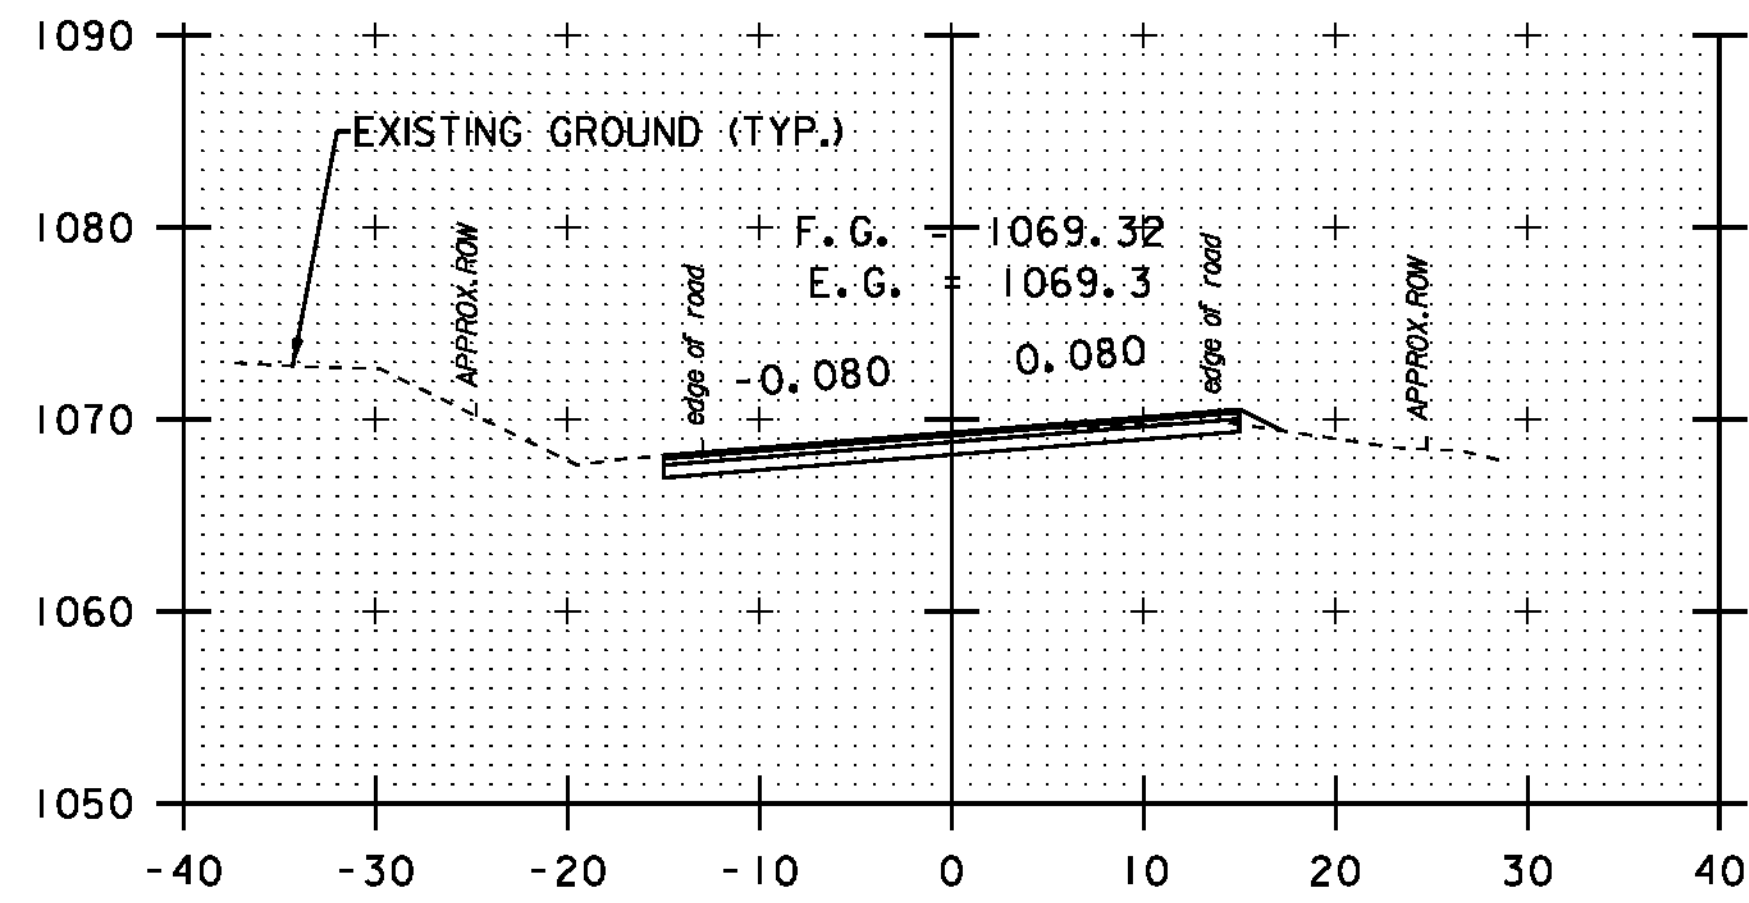


30+00

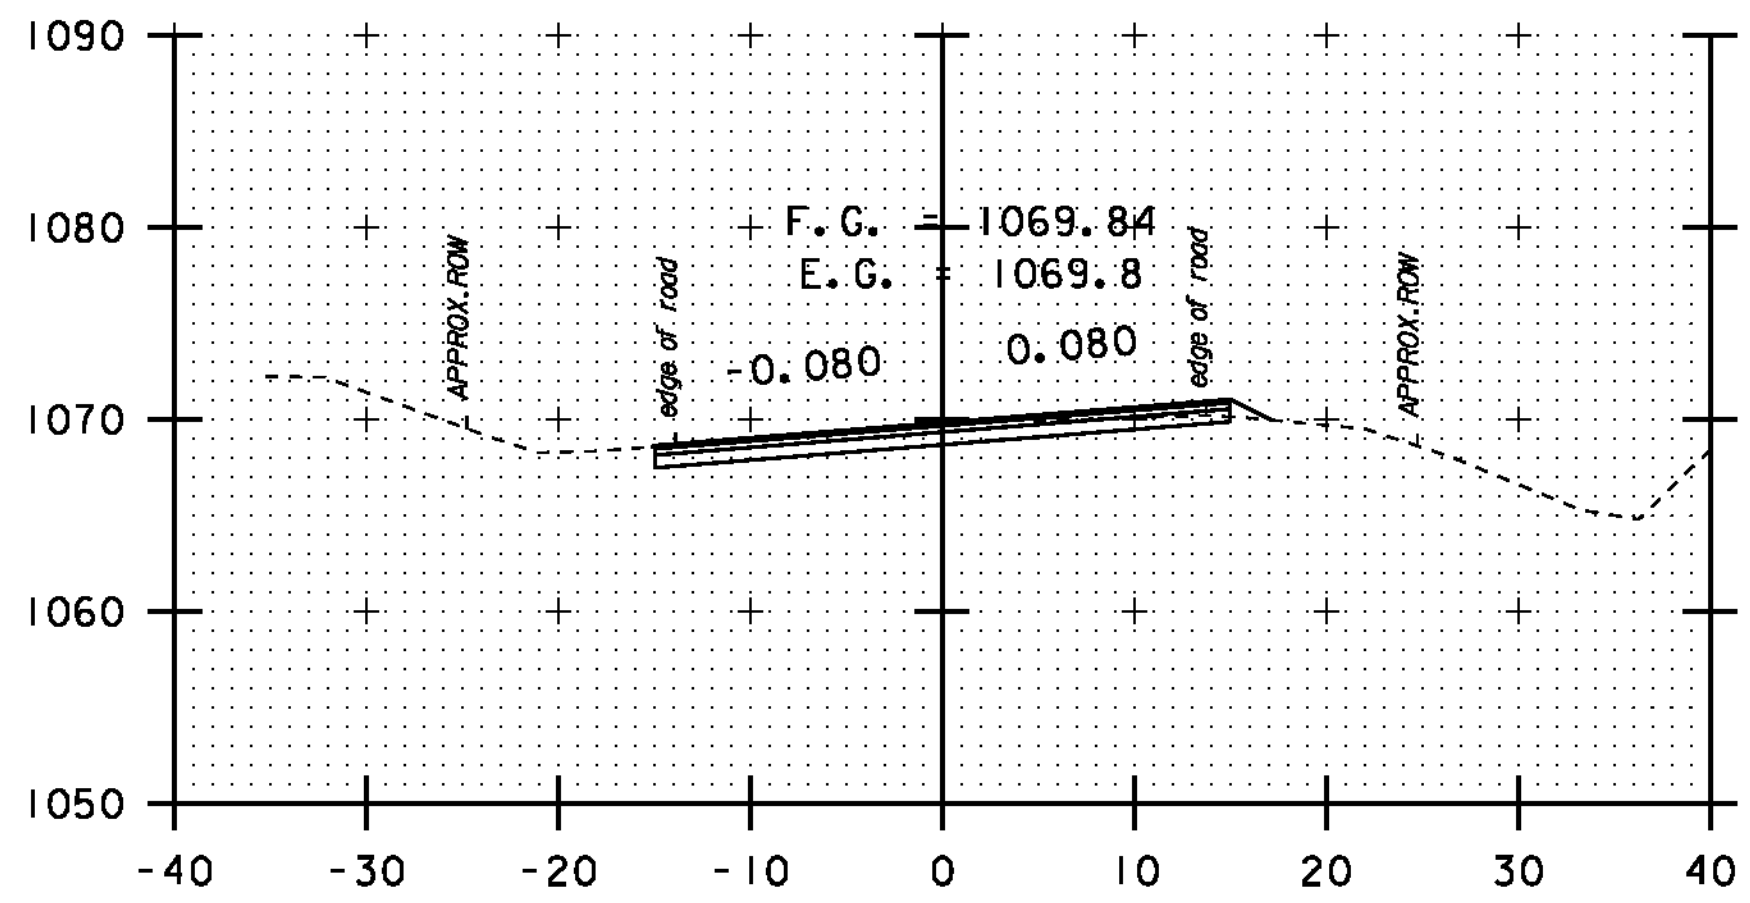


31+50

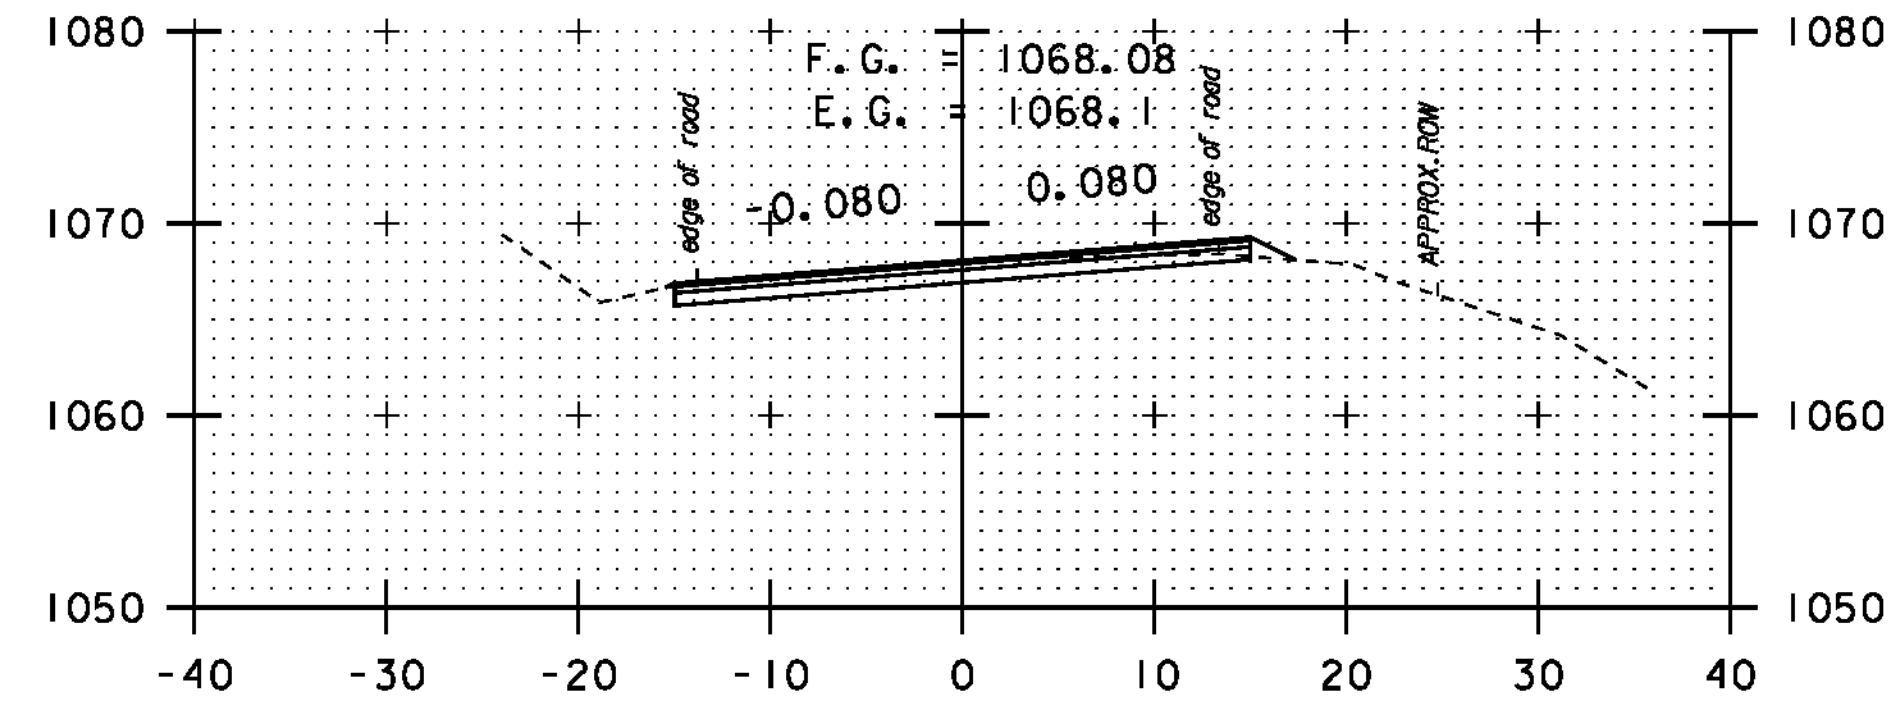


33+00

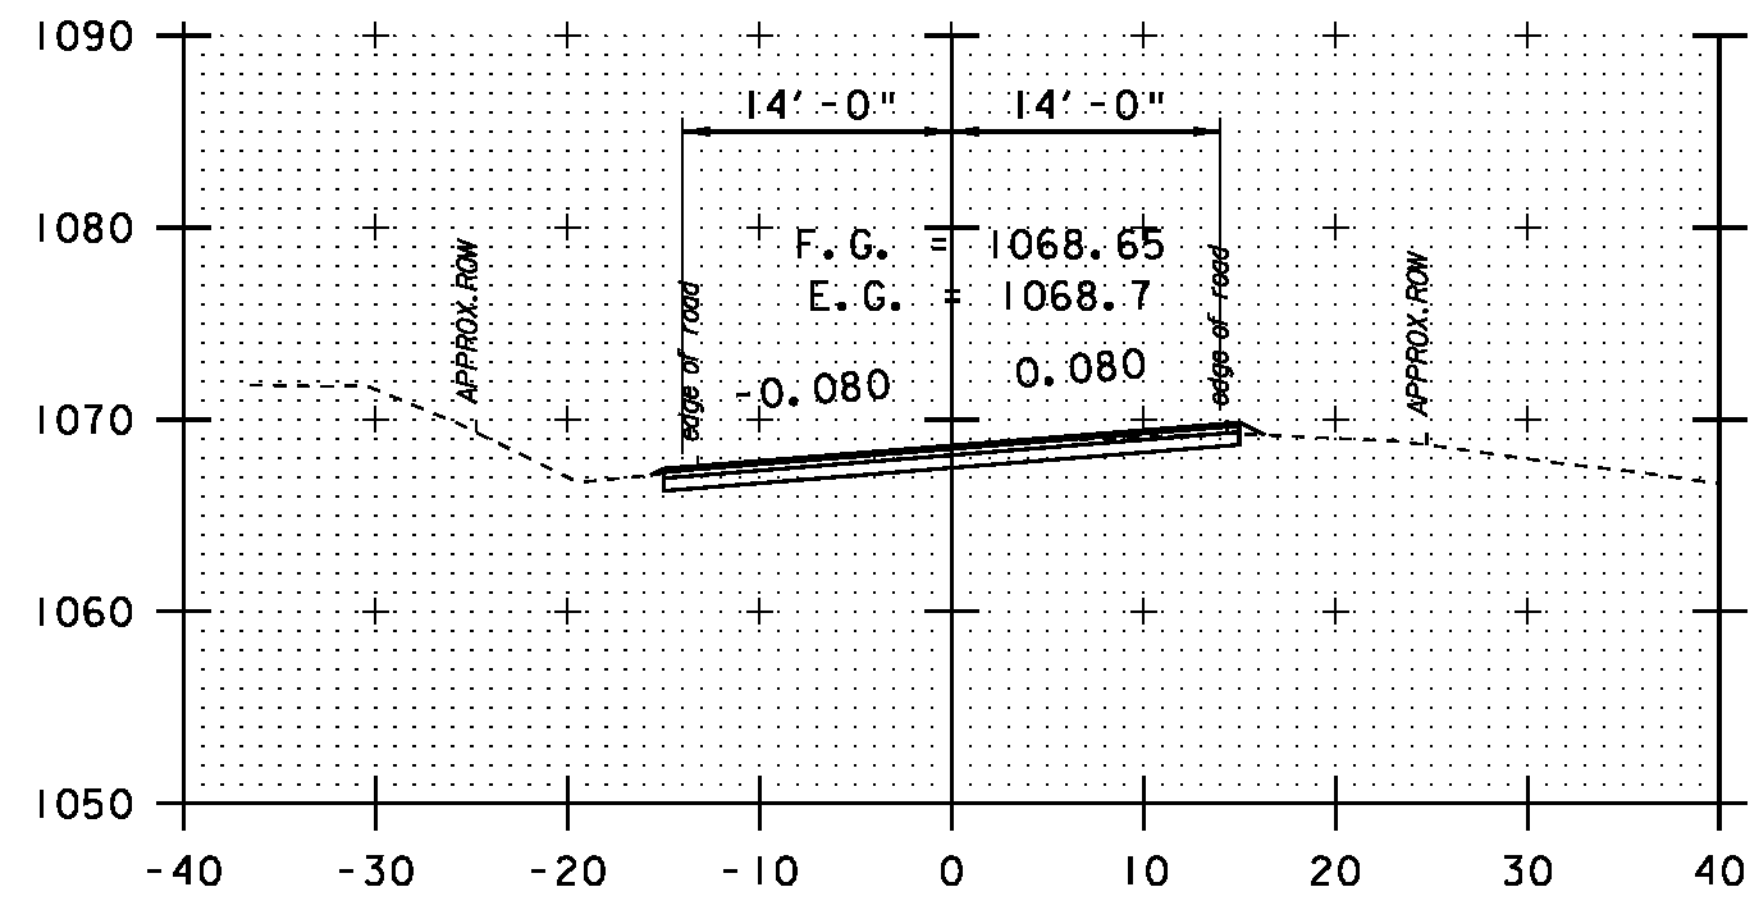

29+50

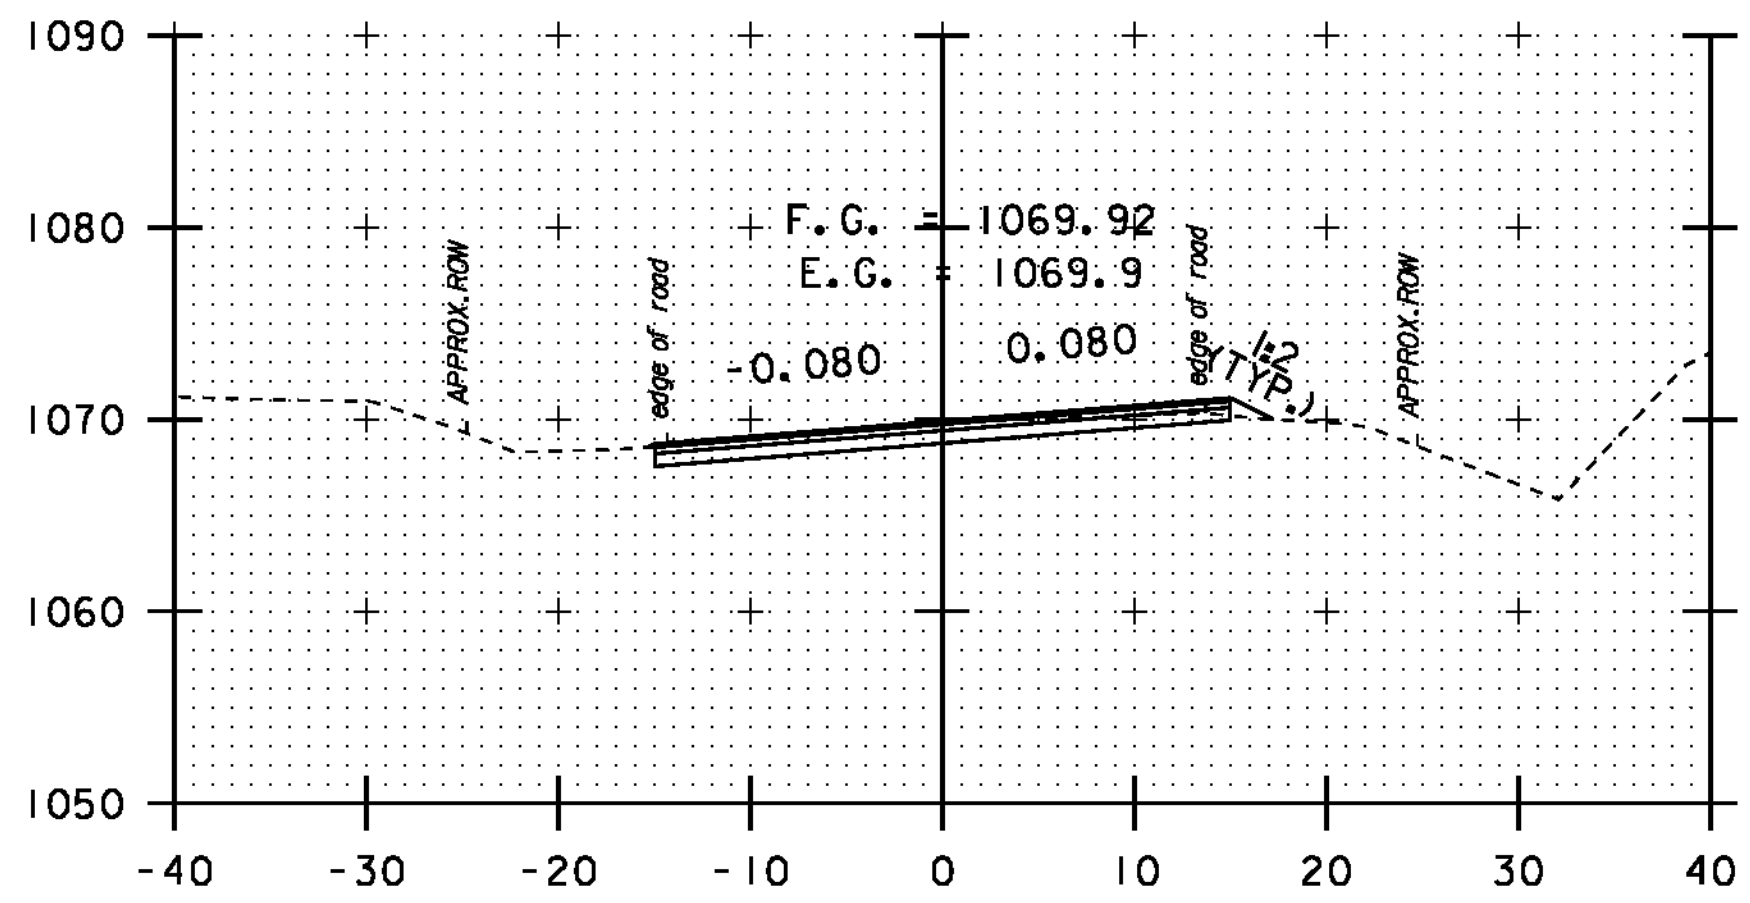

31+00

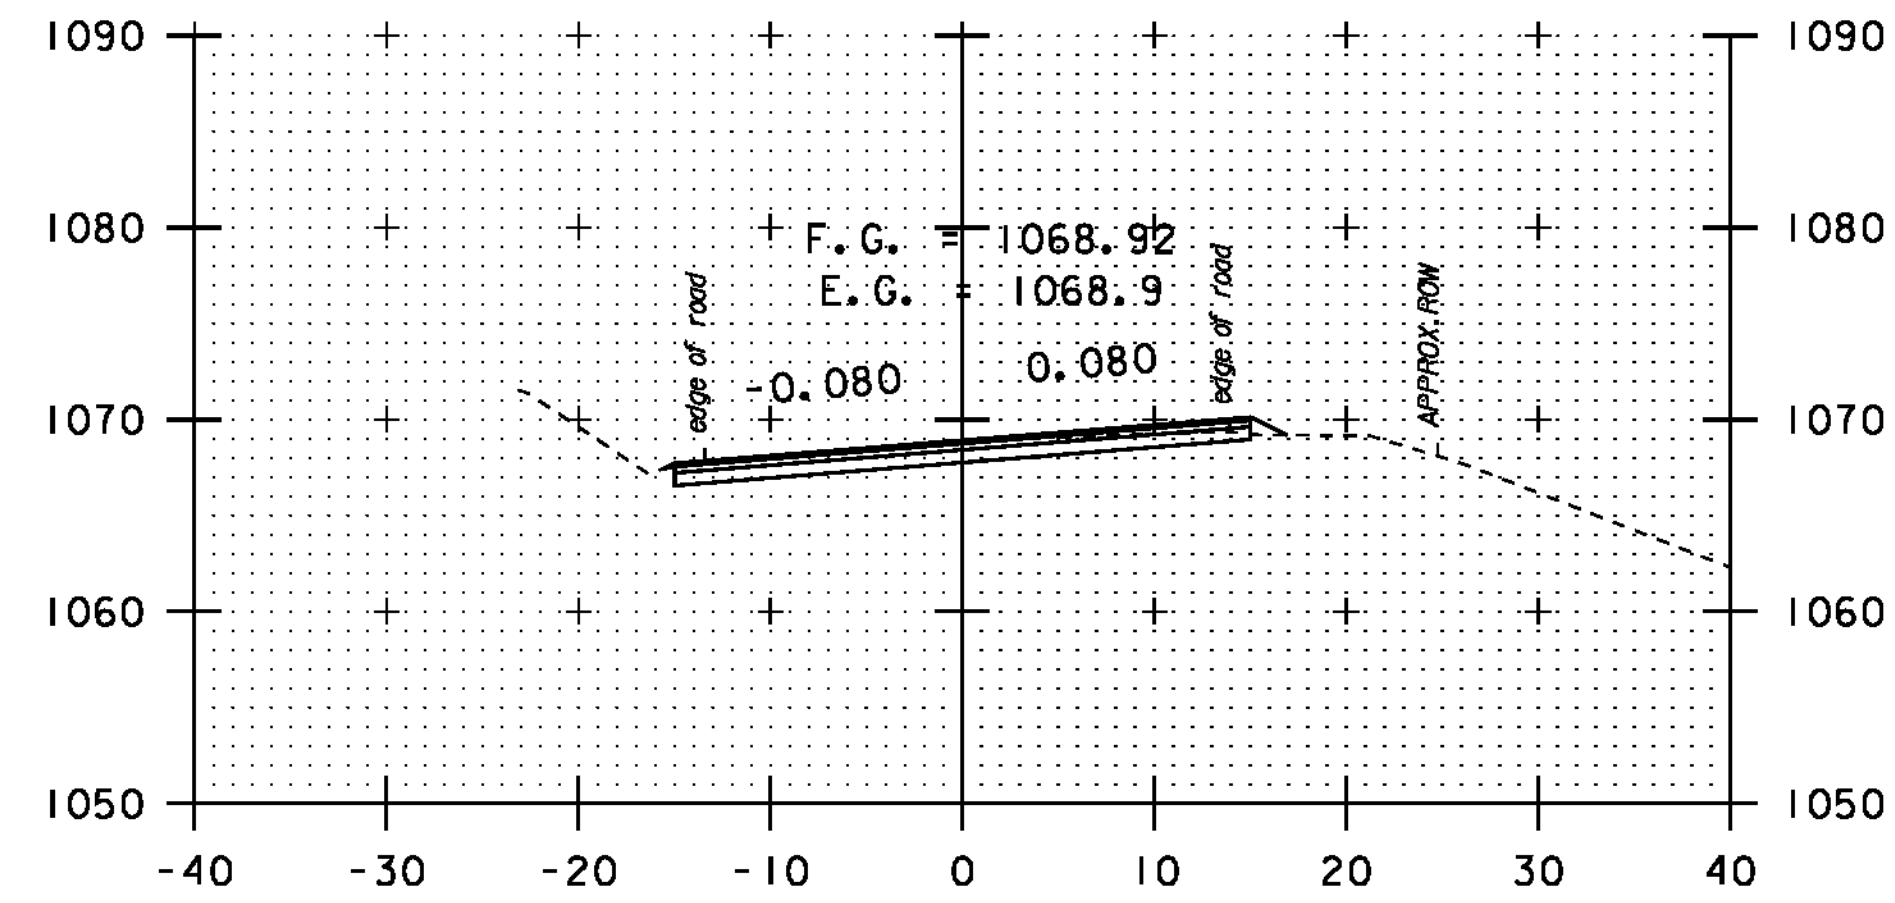

32+50

DATUM	NAVD 88
	NAD 83



**STA. 29 + 50**  
-  
**STA. 33 + 50**

**CROSS SECTION SHEET 27**

PROJECT NAME:	NEWPORT-COVENTRY-NEWPORT
PROJECT NUMBER:	STP 2802 (I)
FILE NAME:	08b158.dgn
PROJECT LEADER:	CDL
DESIGNED BY:	BMB
PLOT FILE:	08b158-100.1
PLOT DATE:	8/3/2011
DRAWN BY:	BMB
CHECKED BY:	EPD
SHEET	100 OF 134