




35+47

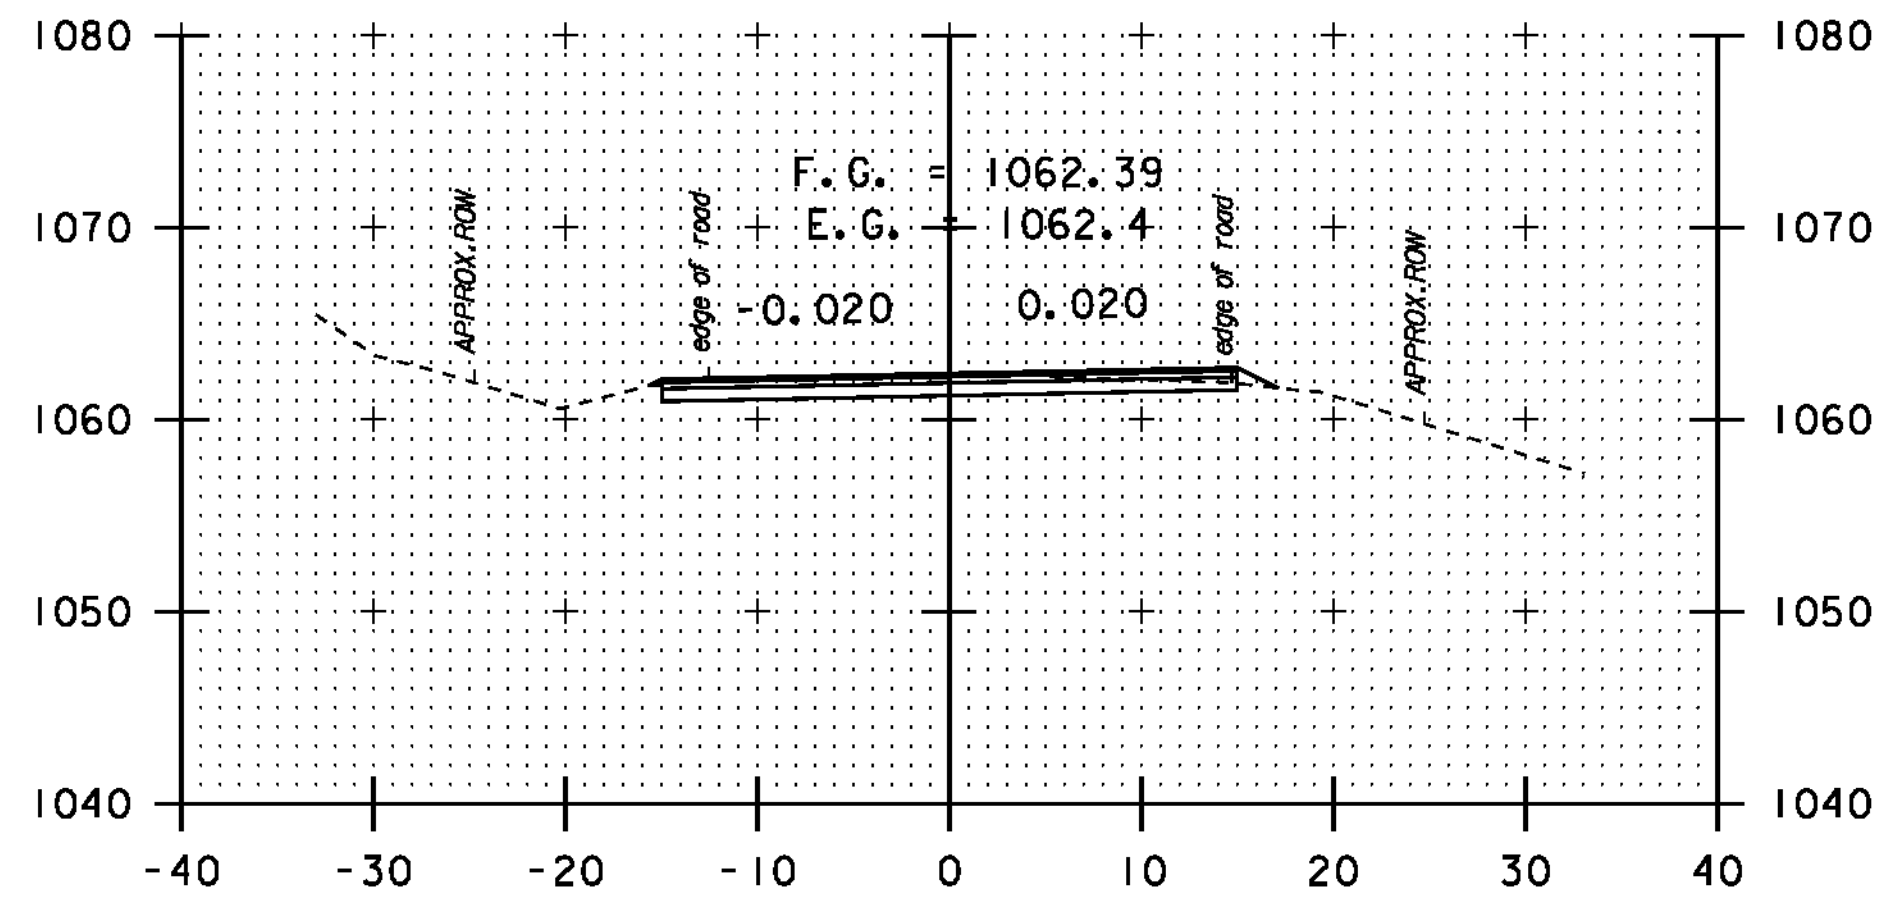


36+50

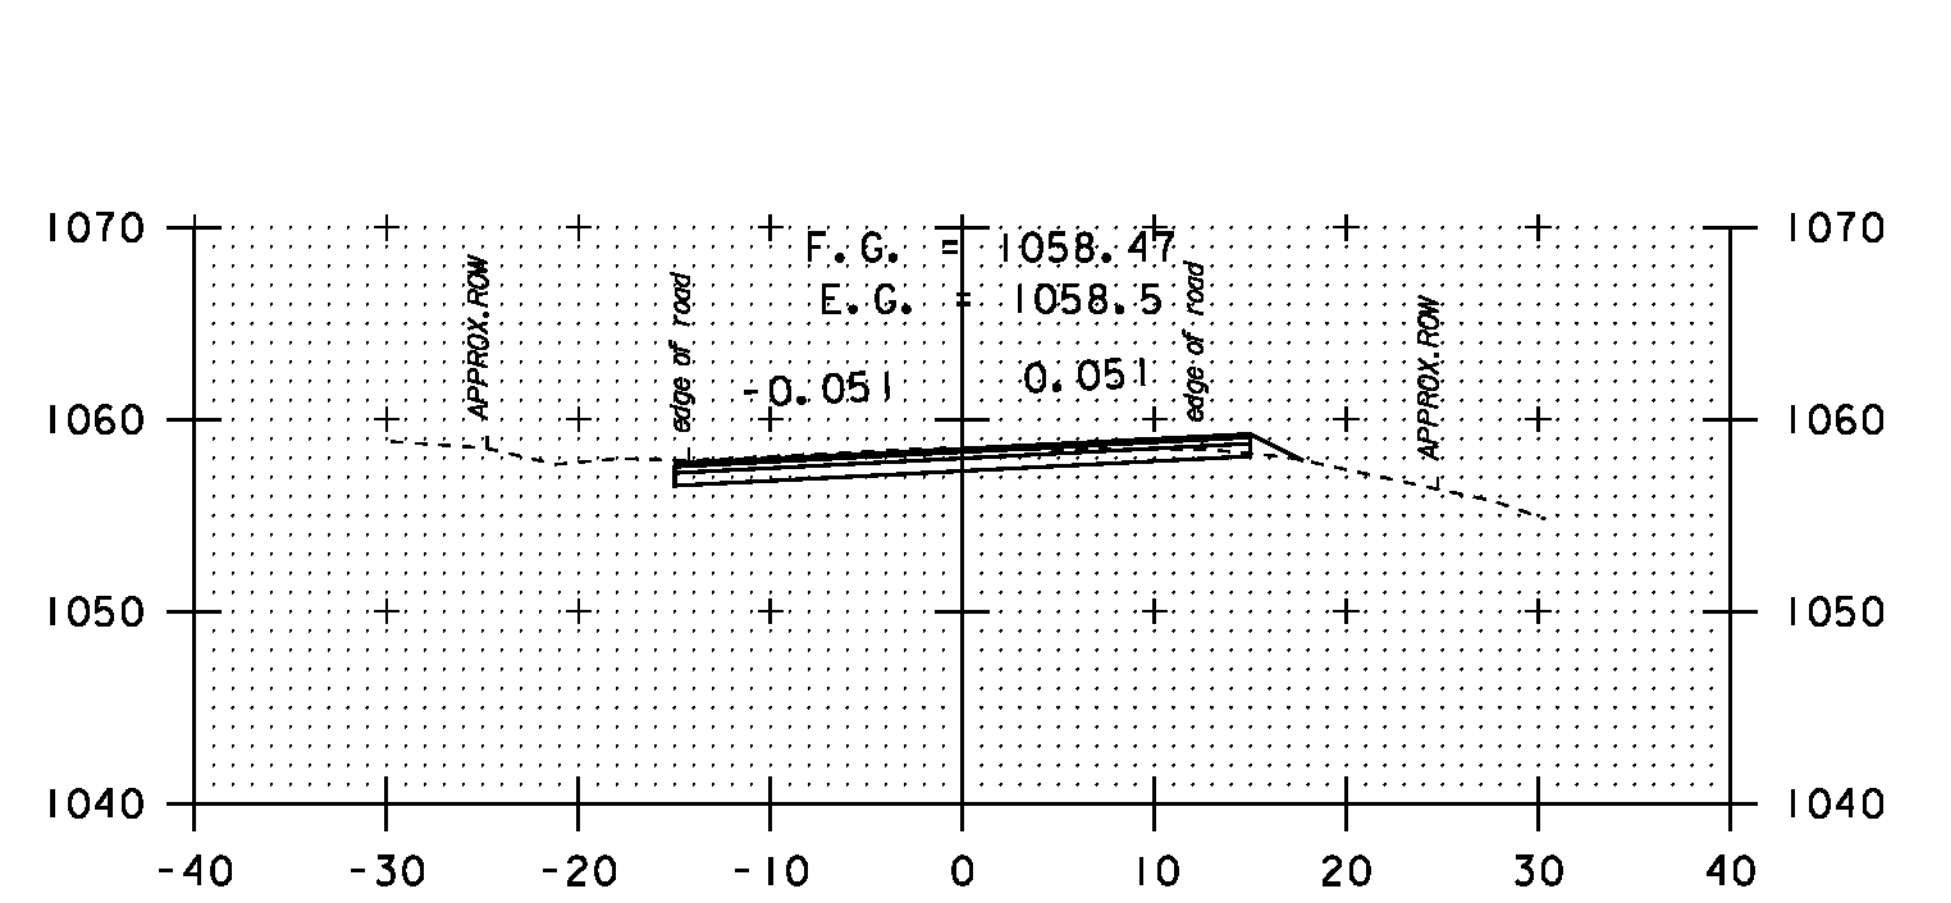


38+30

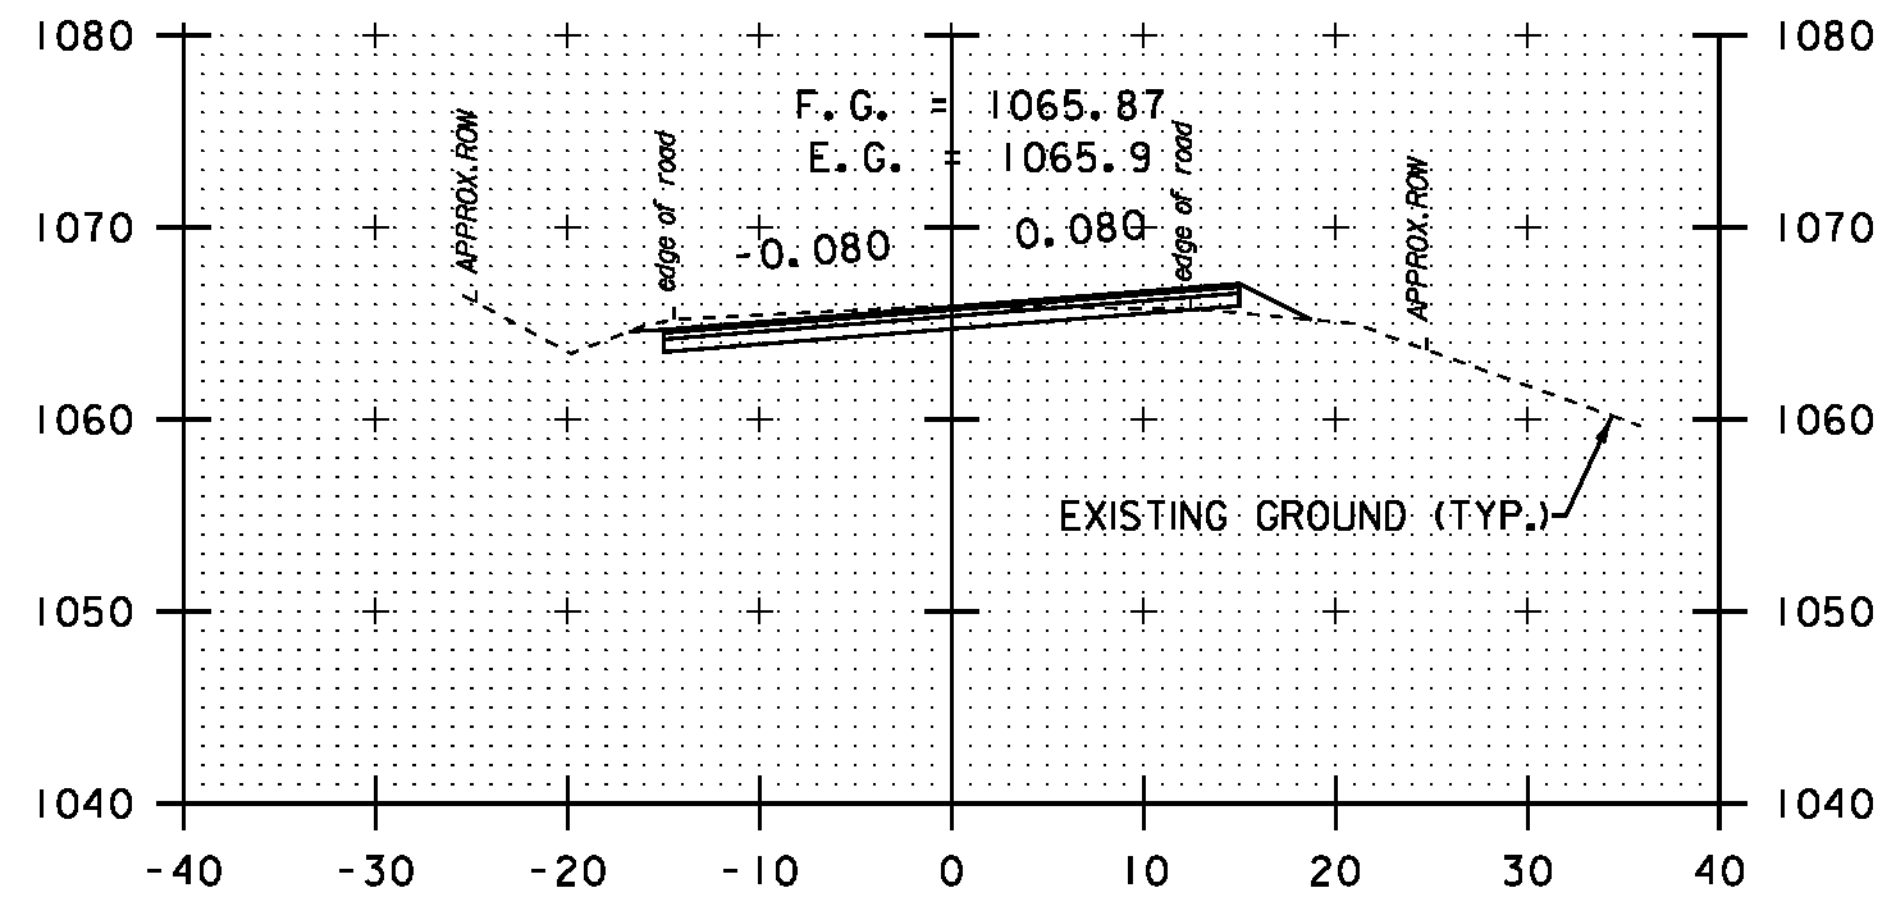


34+05

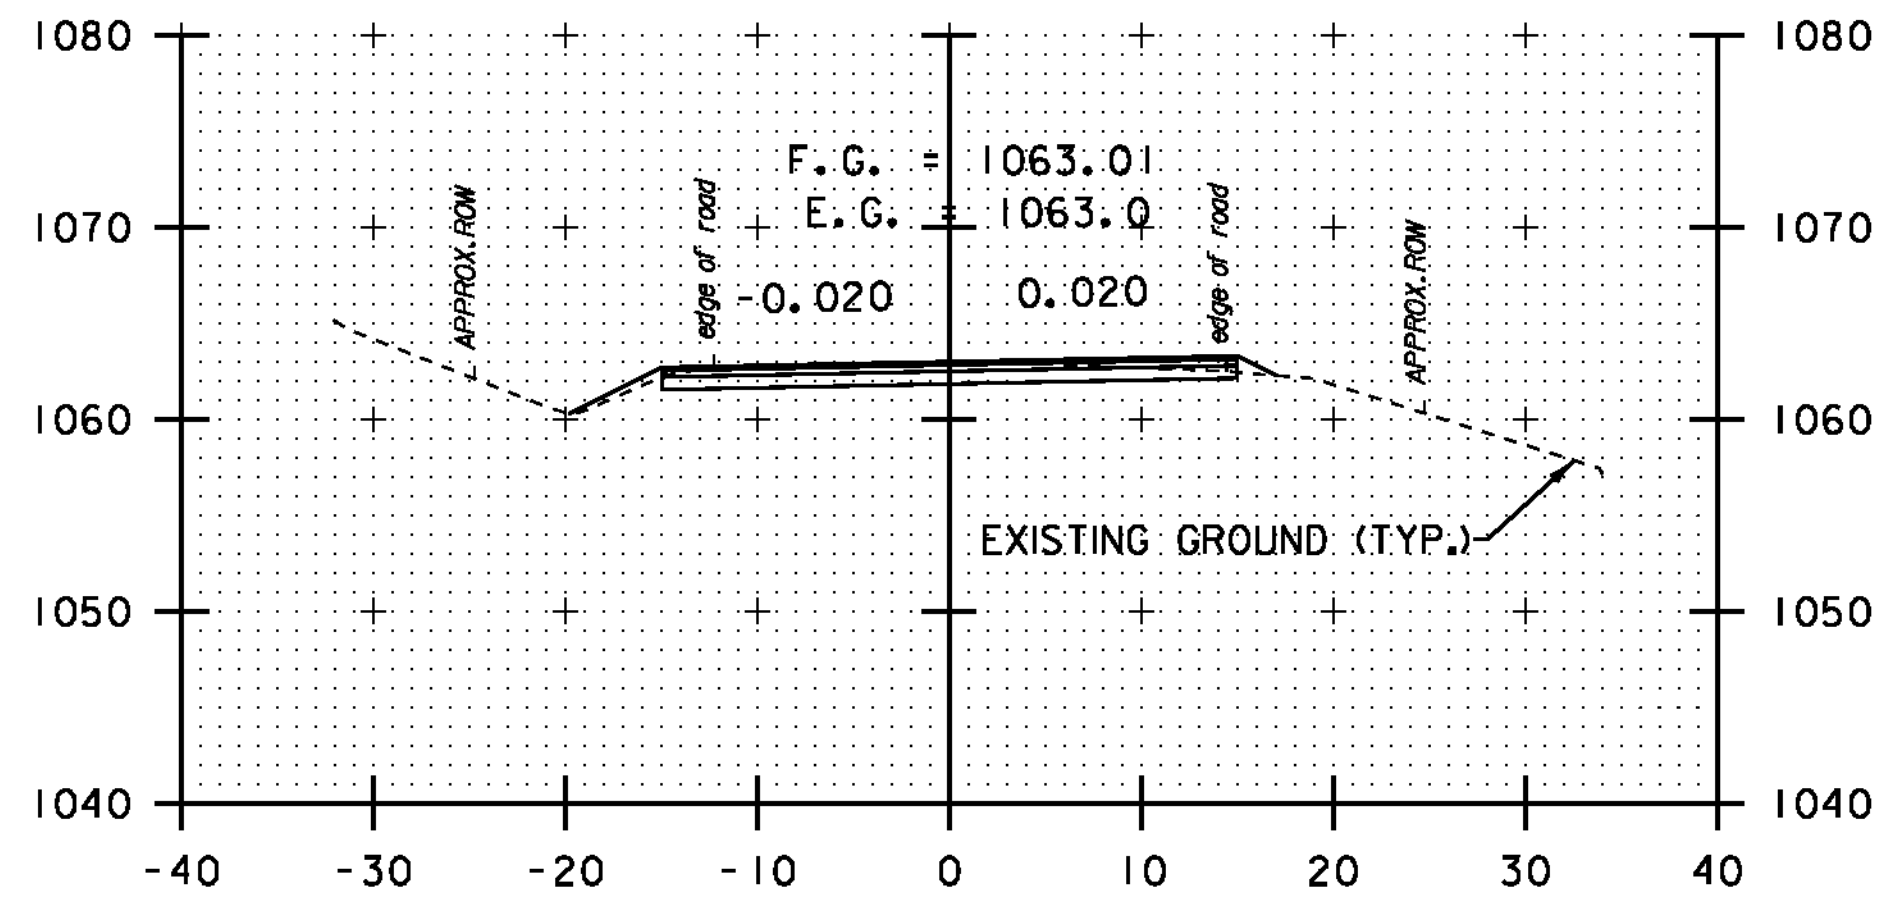


36+00

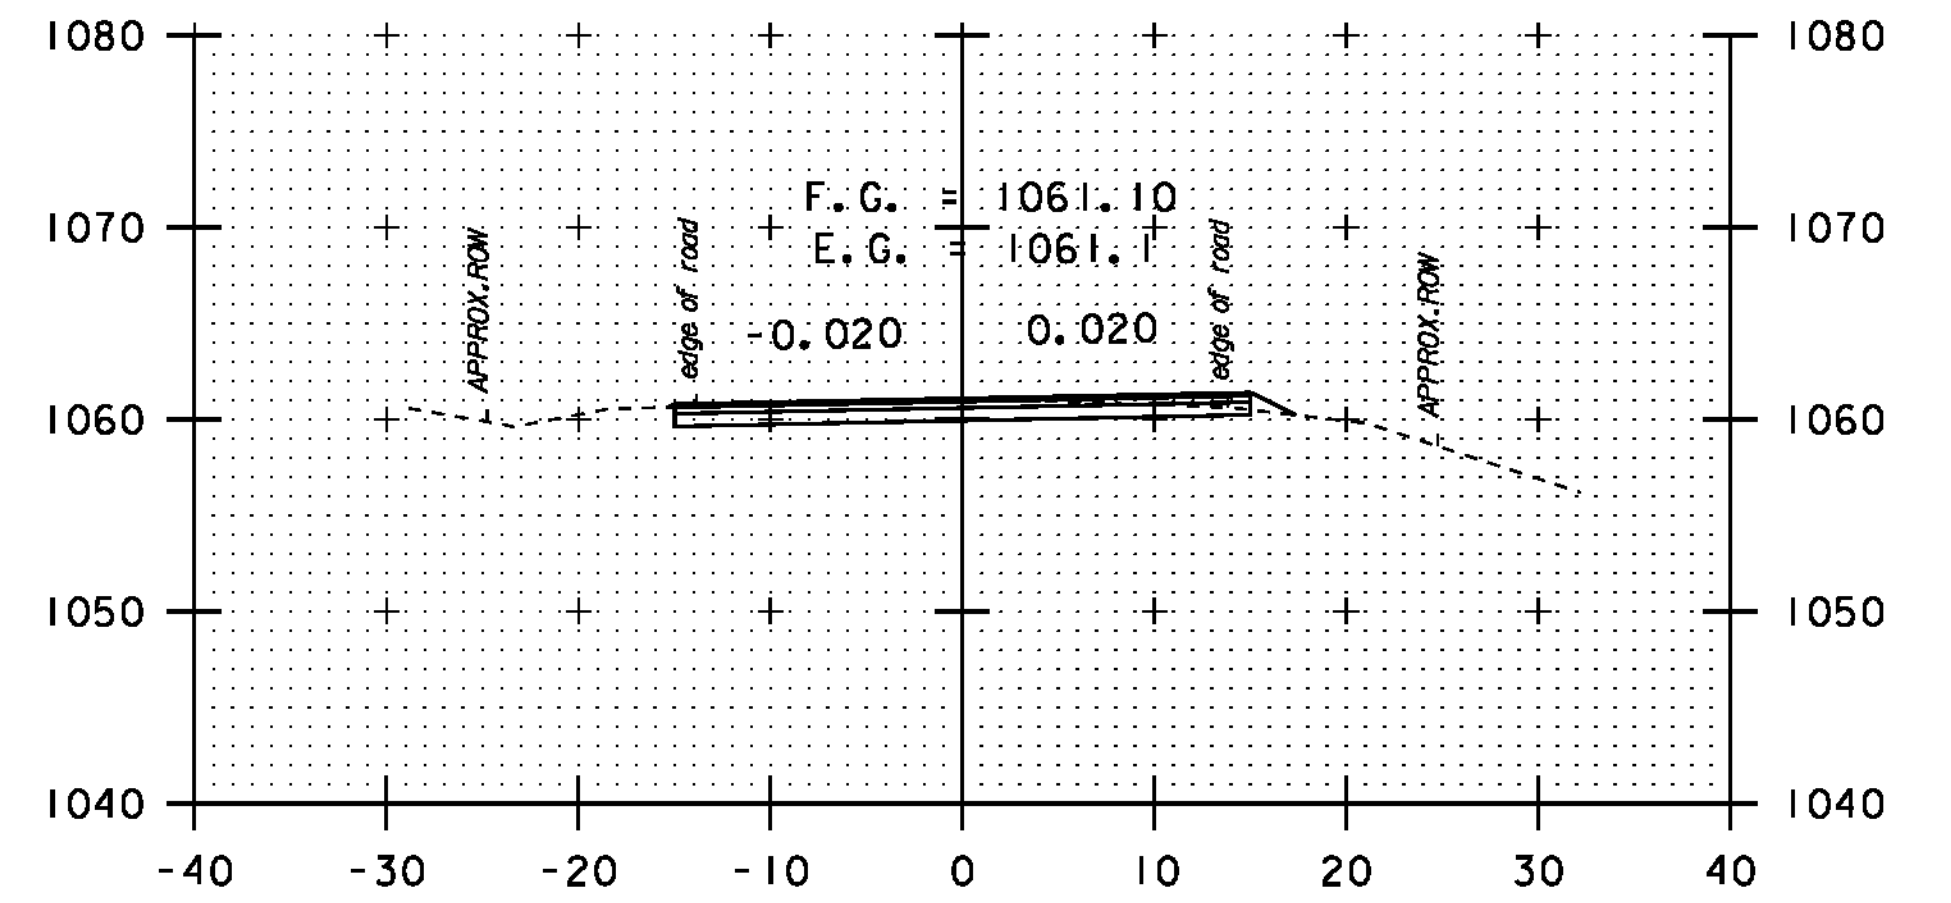


37+32

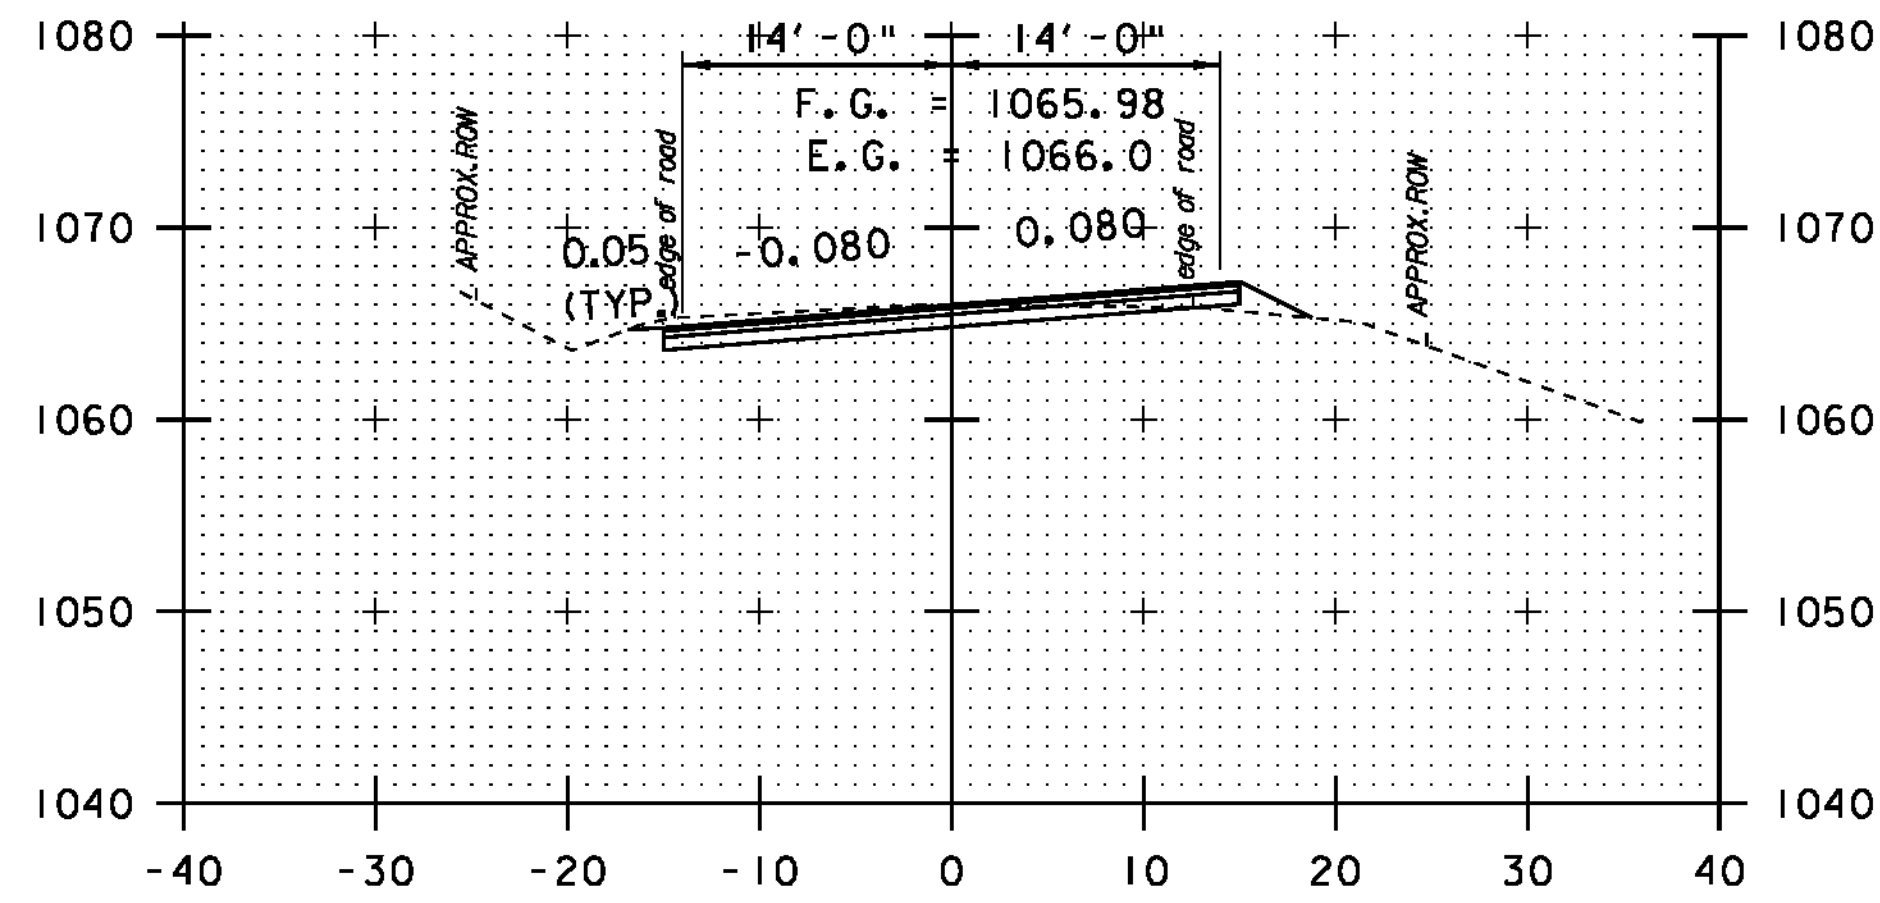

34+00

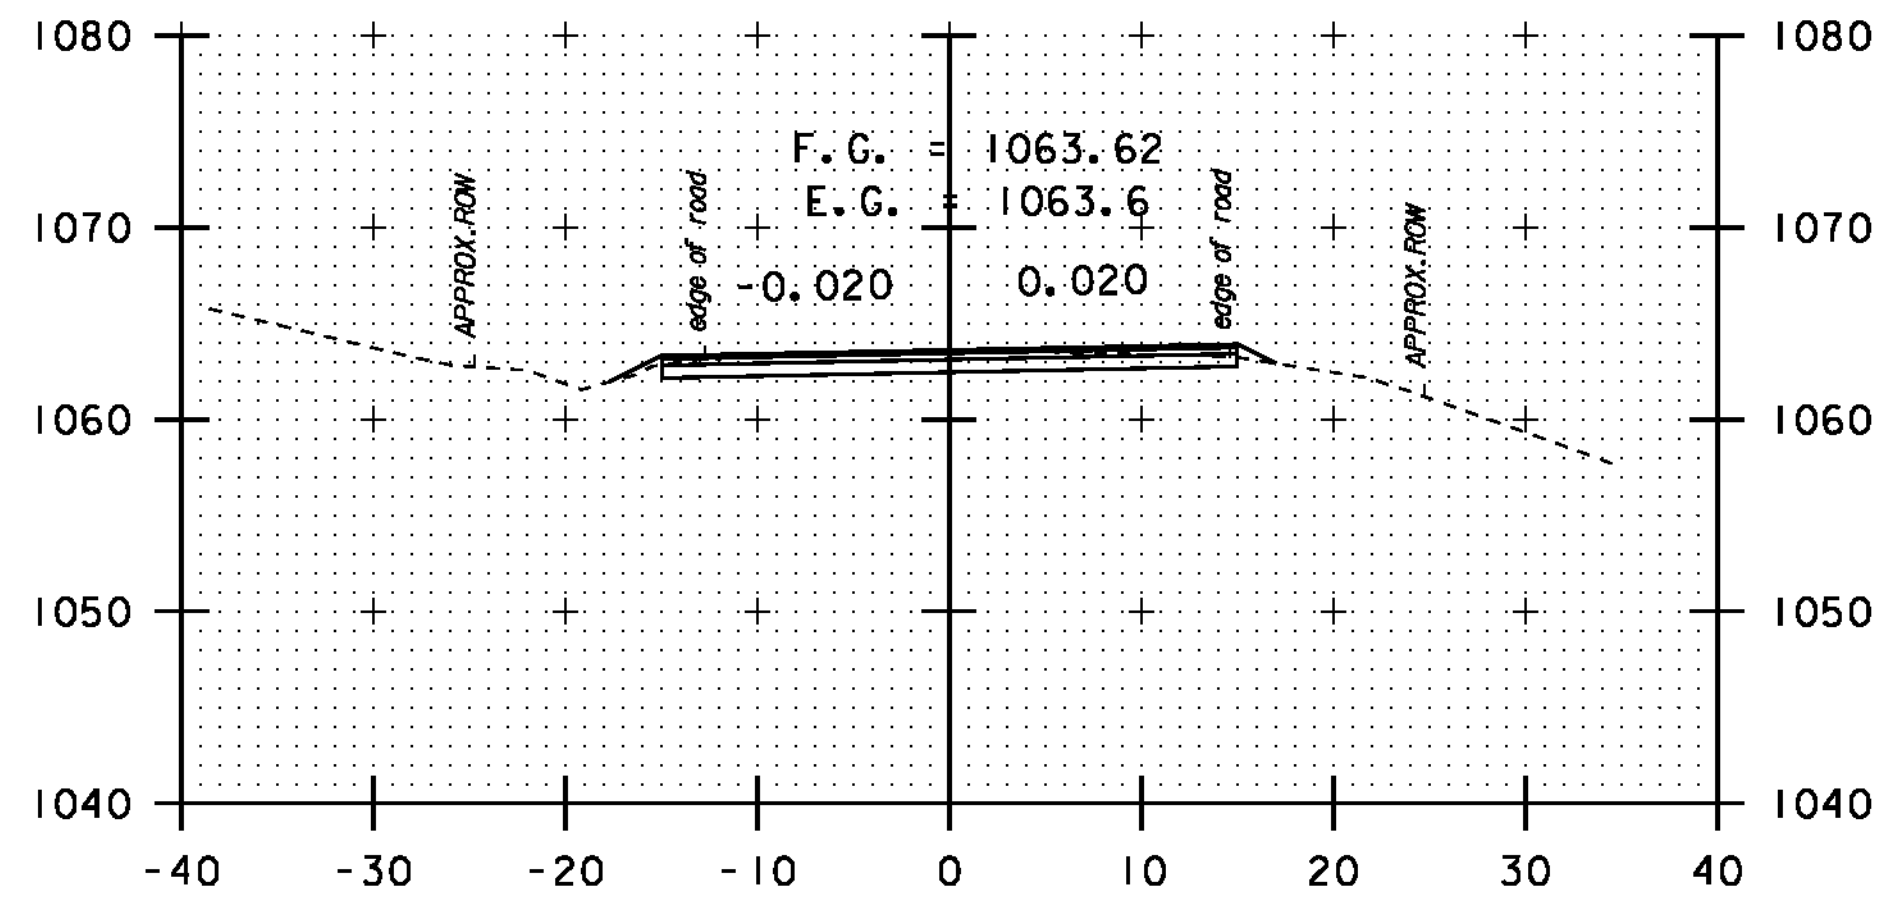


35+50

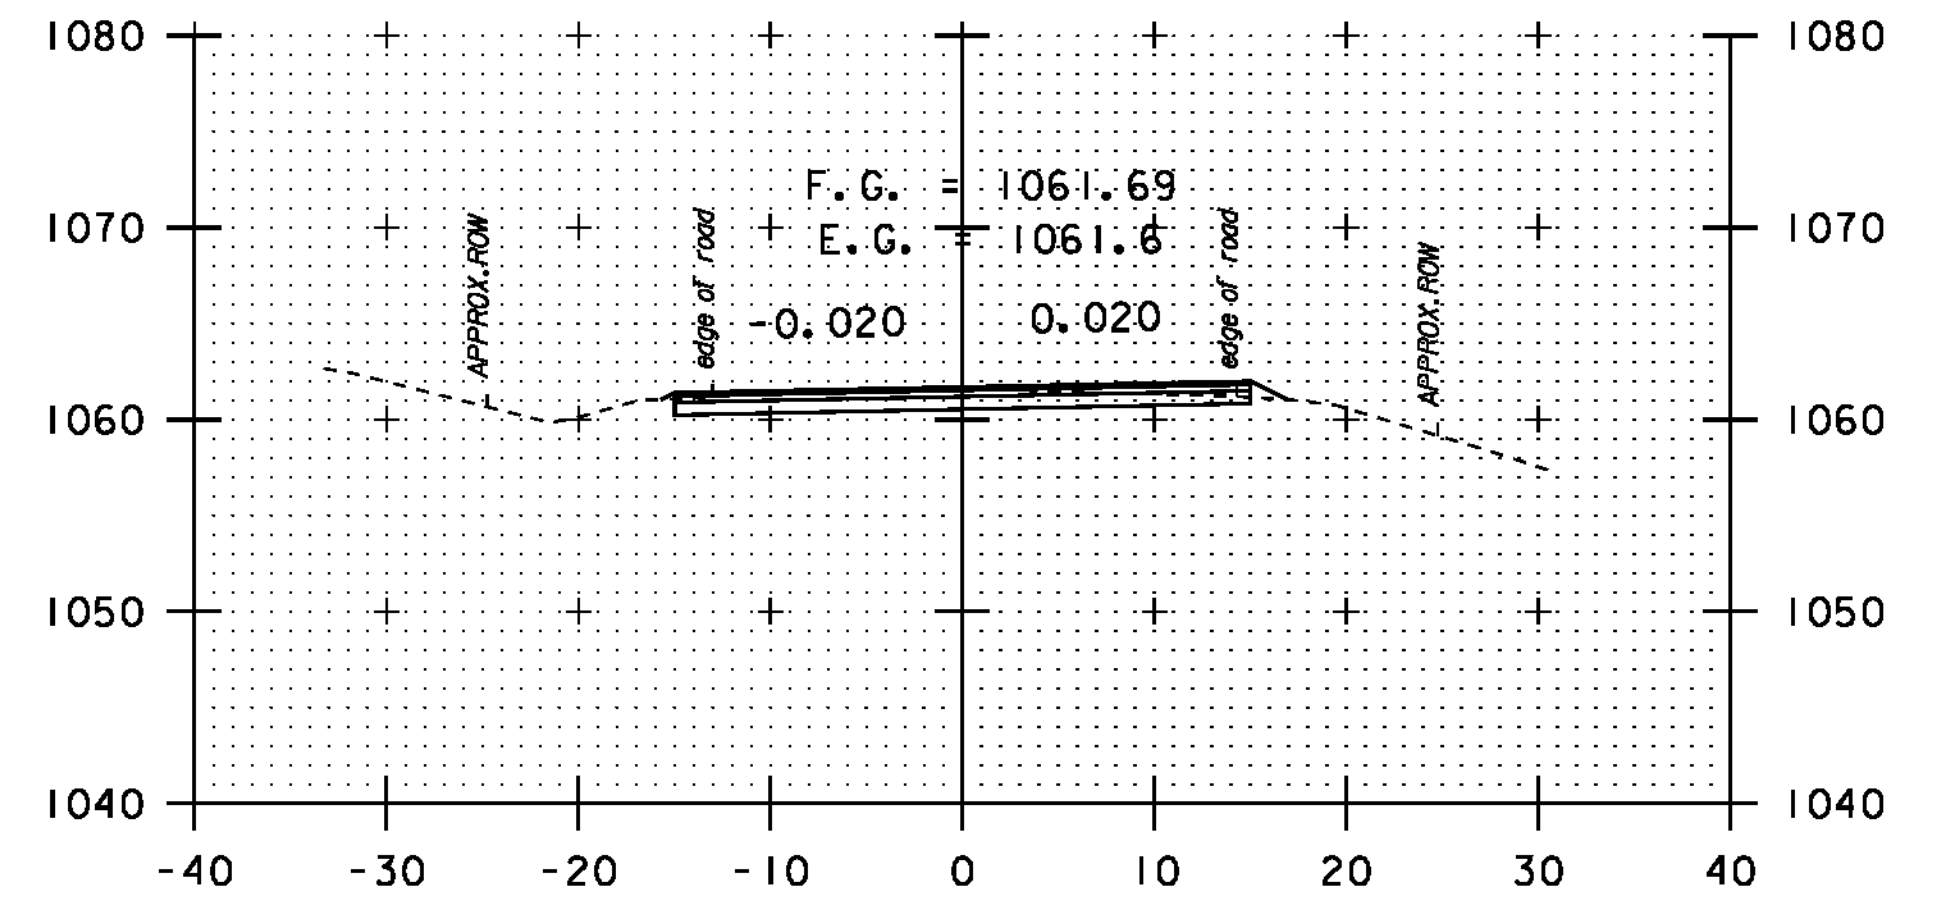

37+00

DATUM	NAVD 88
	NAD 83

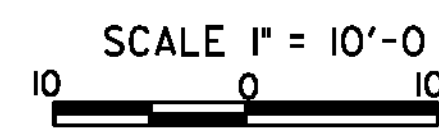

STA. 34+00
-
STA. 38+30

CROSS
SECTION
SHEET 28

PROJECT NAME:	NEWPORT-COVENTRY-NEWPORT
PROJECT NUMBER:	STP 2802 (I)
FILE NAME:	08b158.dgn
PROJECT LEADER:	CDL
DESIGNED BY:	BMB
PLOT FILE:	08b158-101.I
PLOT DATE:	8/3/2011
DRAWN BY:	BMB
CHECKED BY:	EPD
SHEET	101 OF 134