




39+50

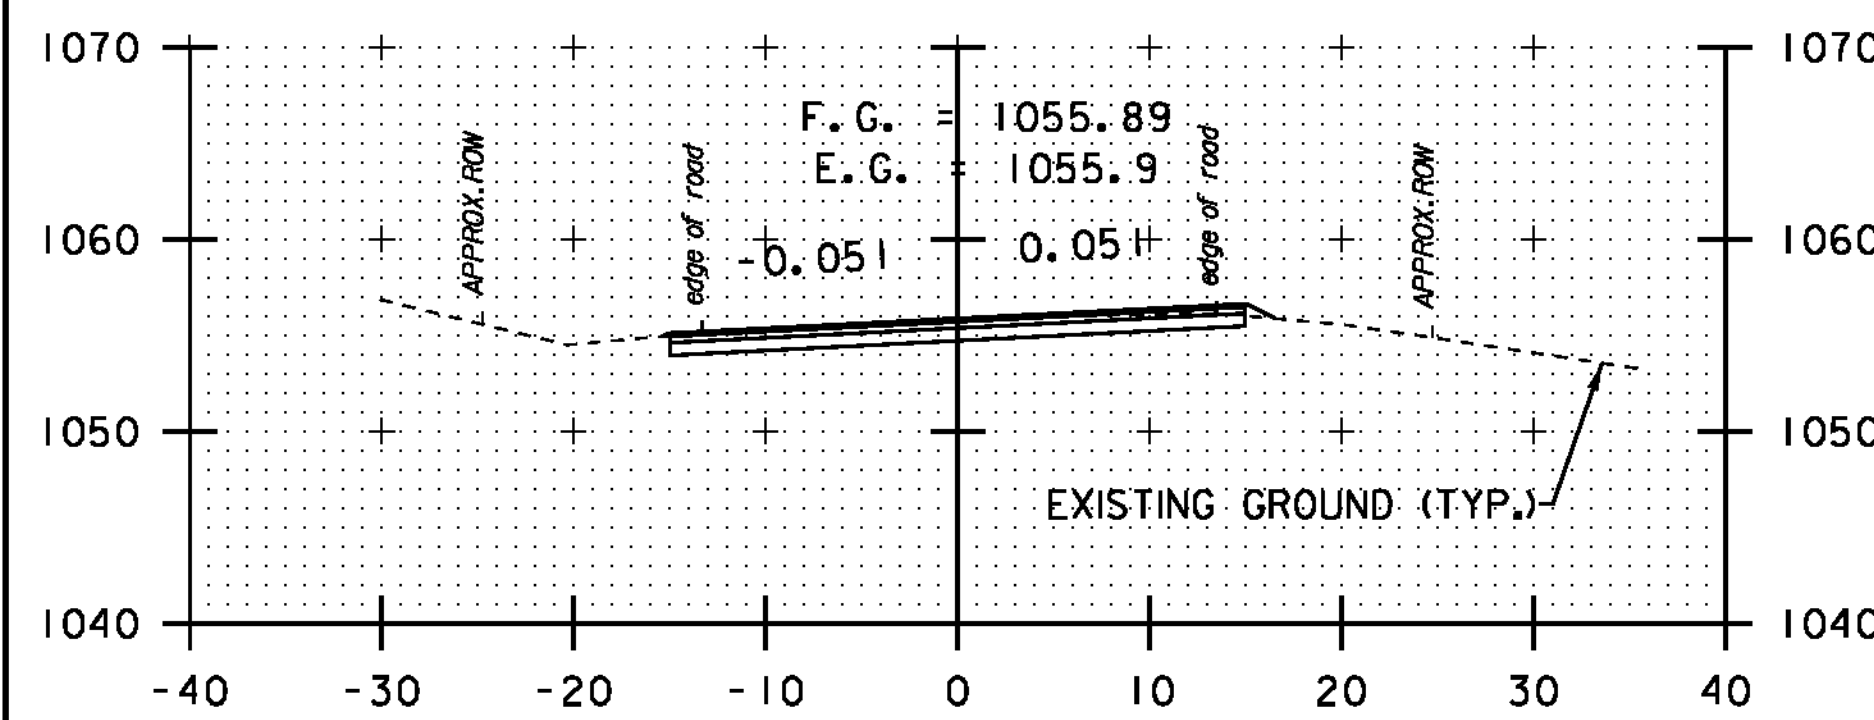


39+00

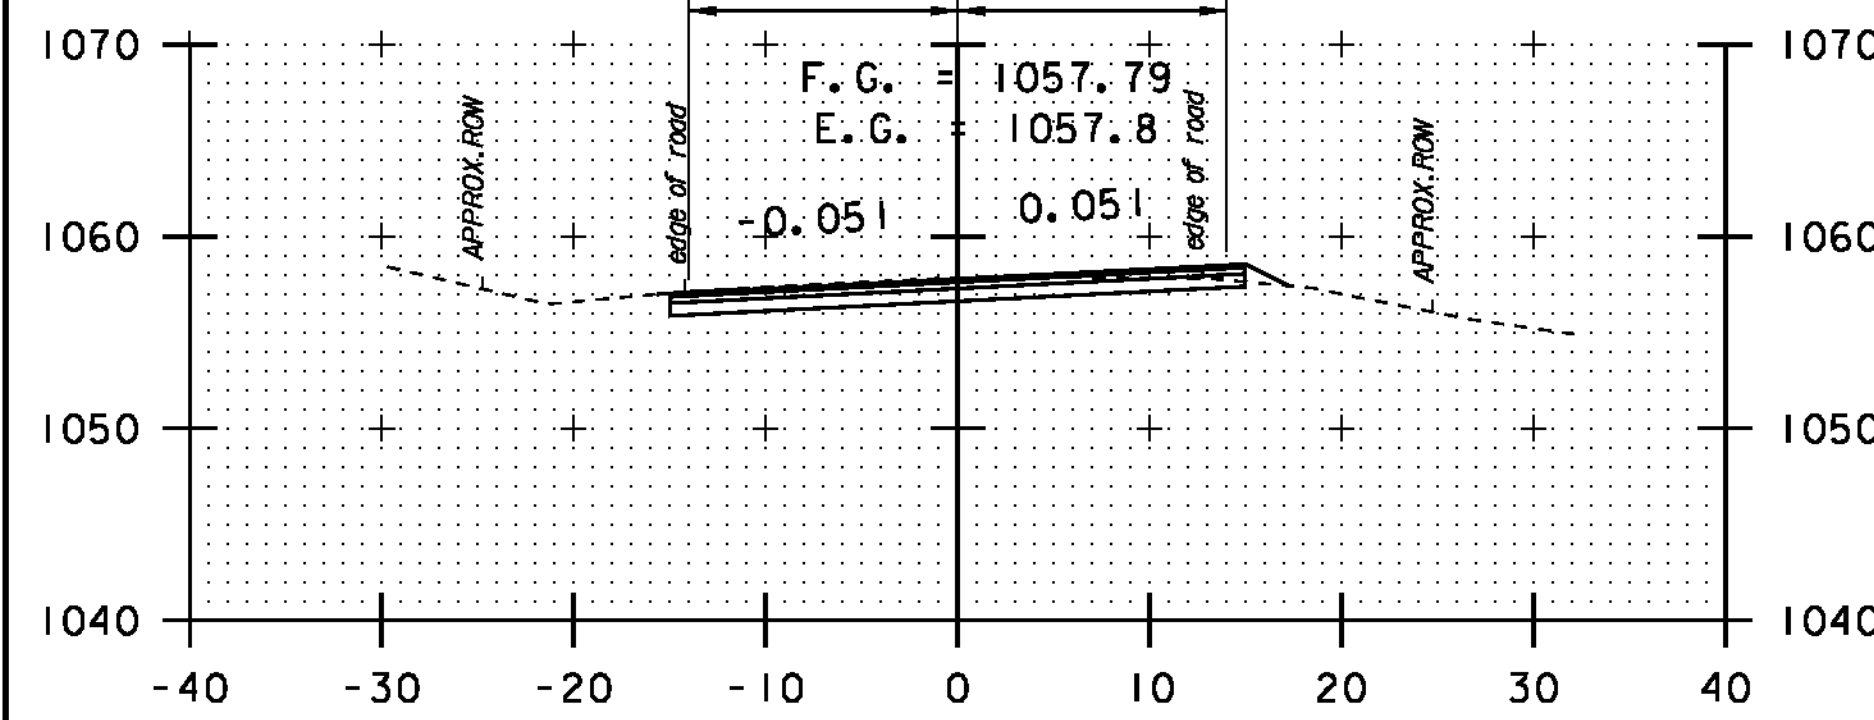


38+50

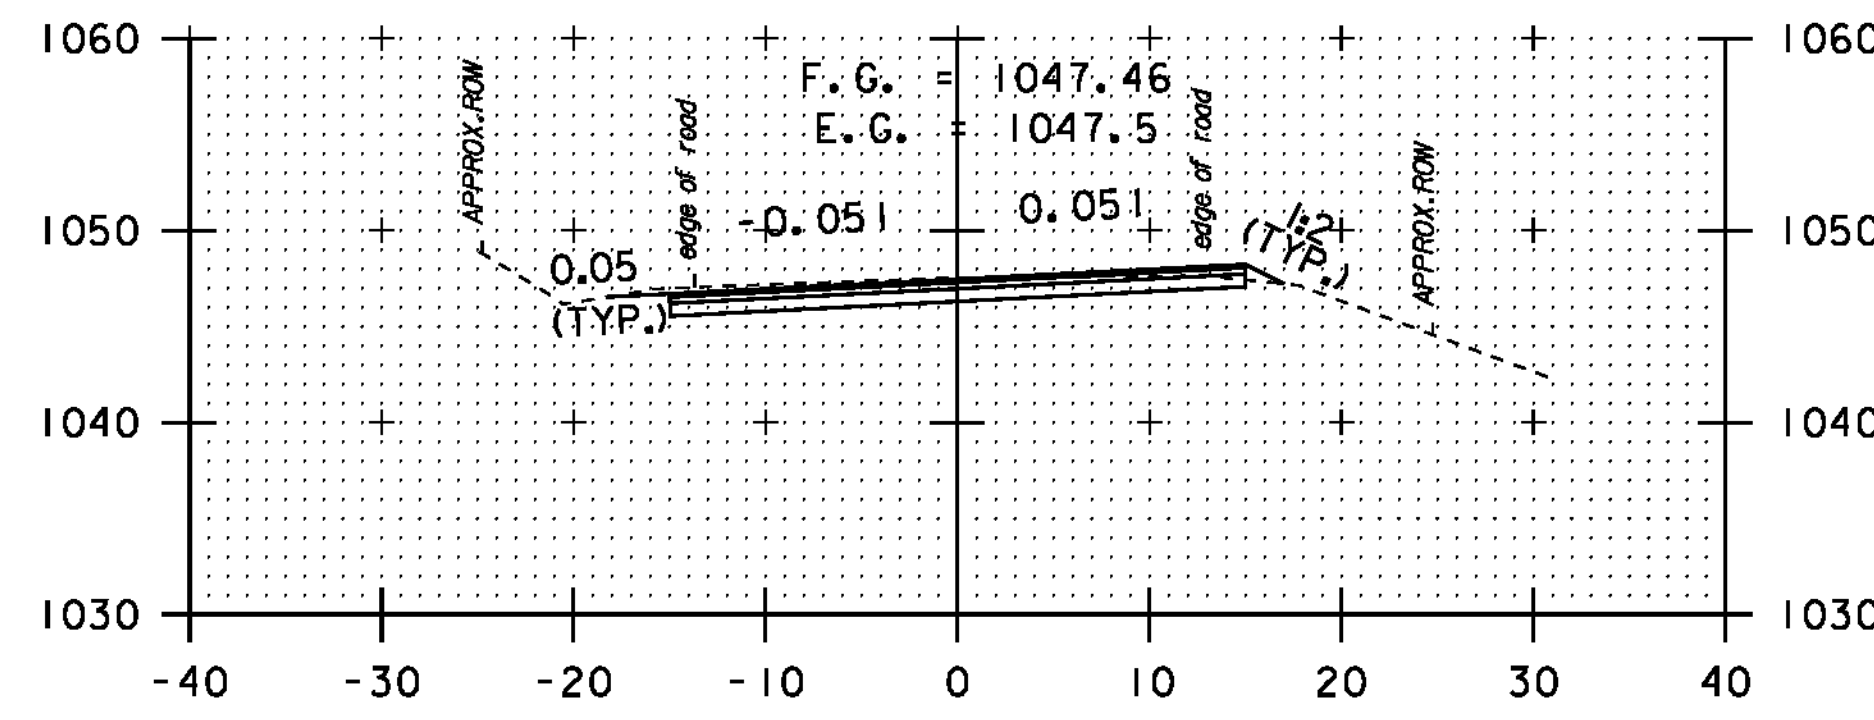


40+65

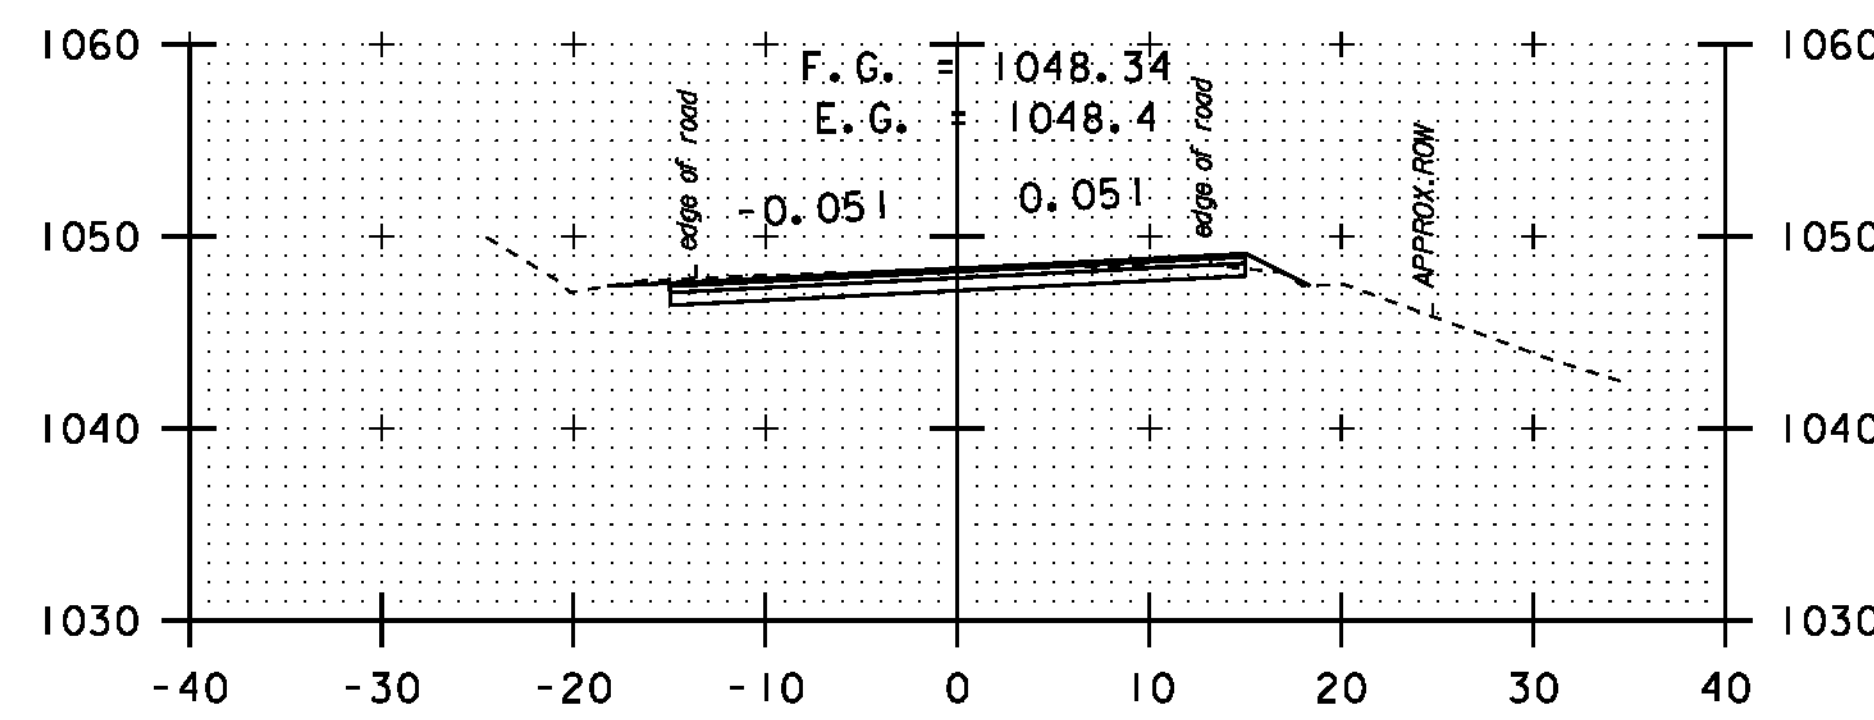


40+50

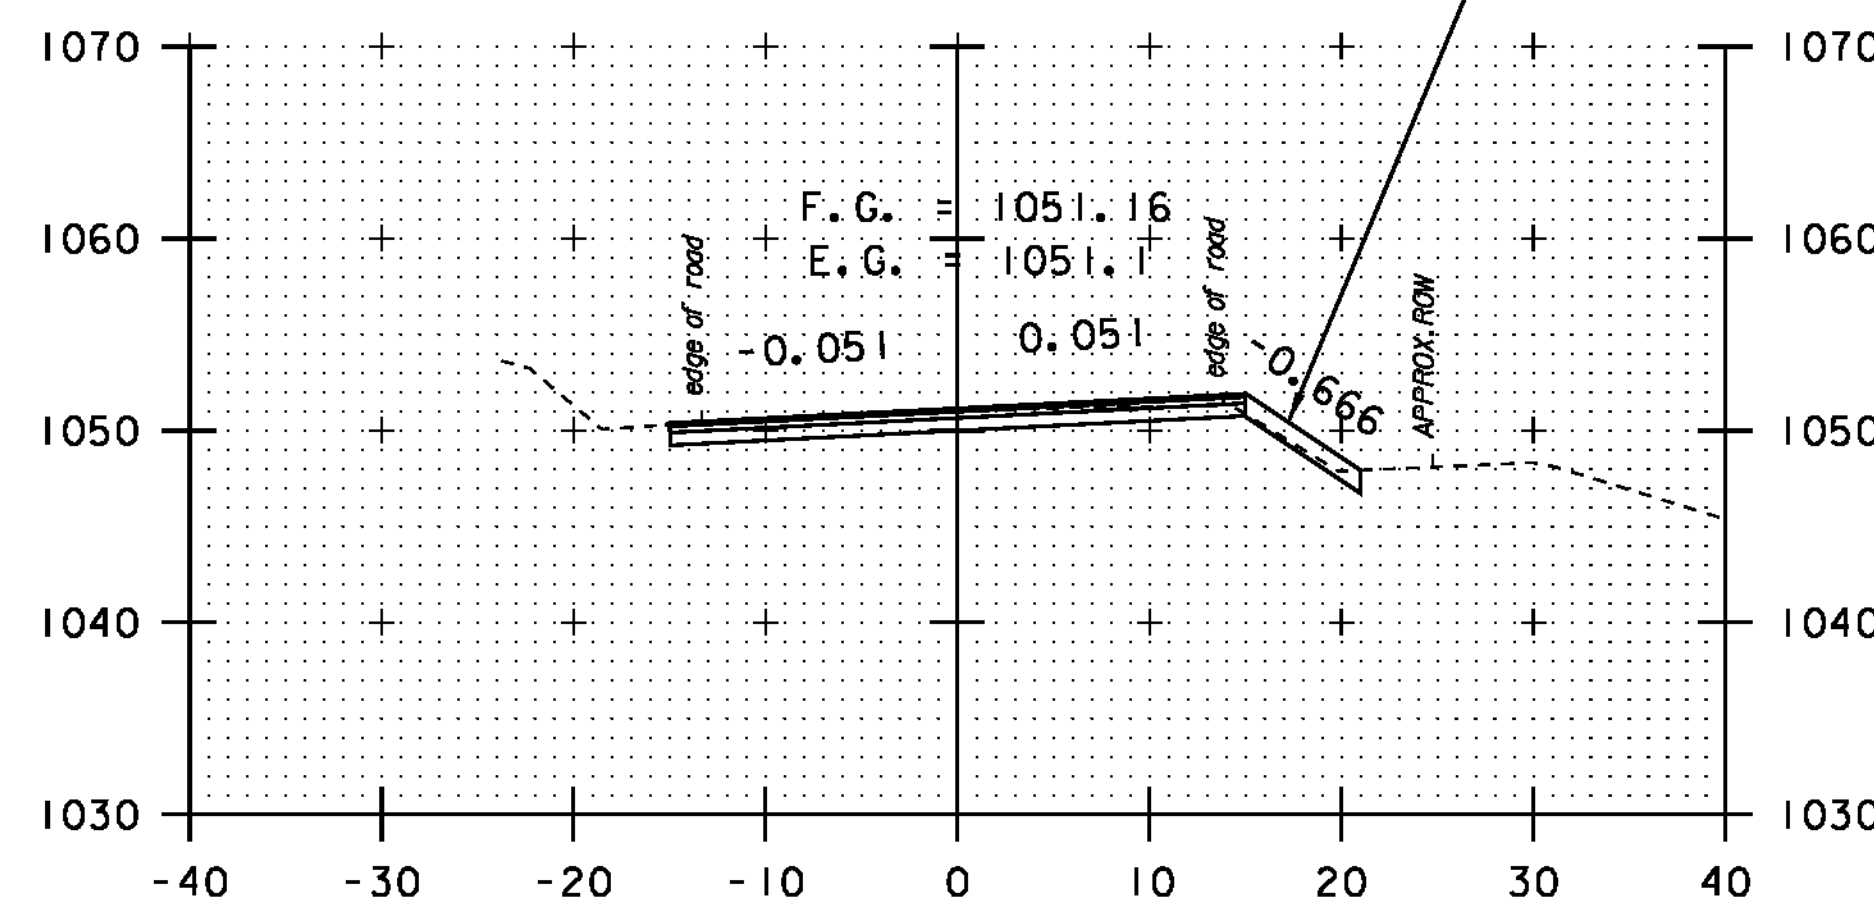


40+00

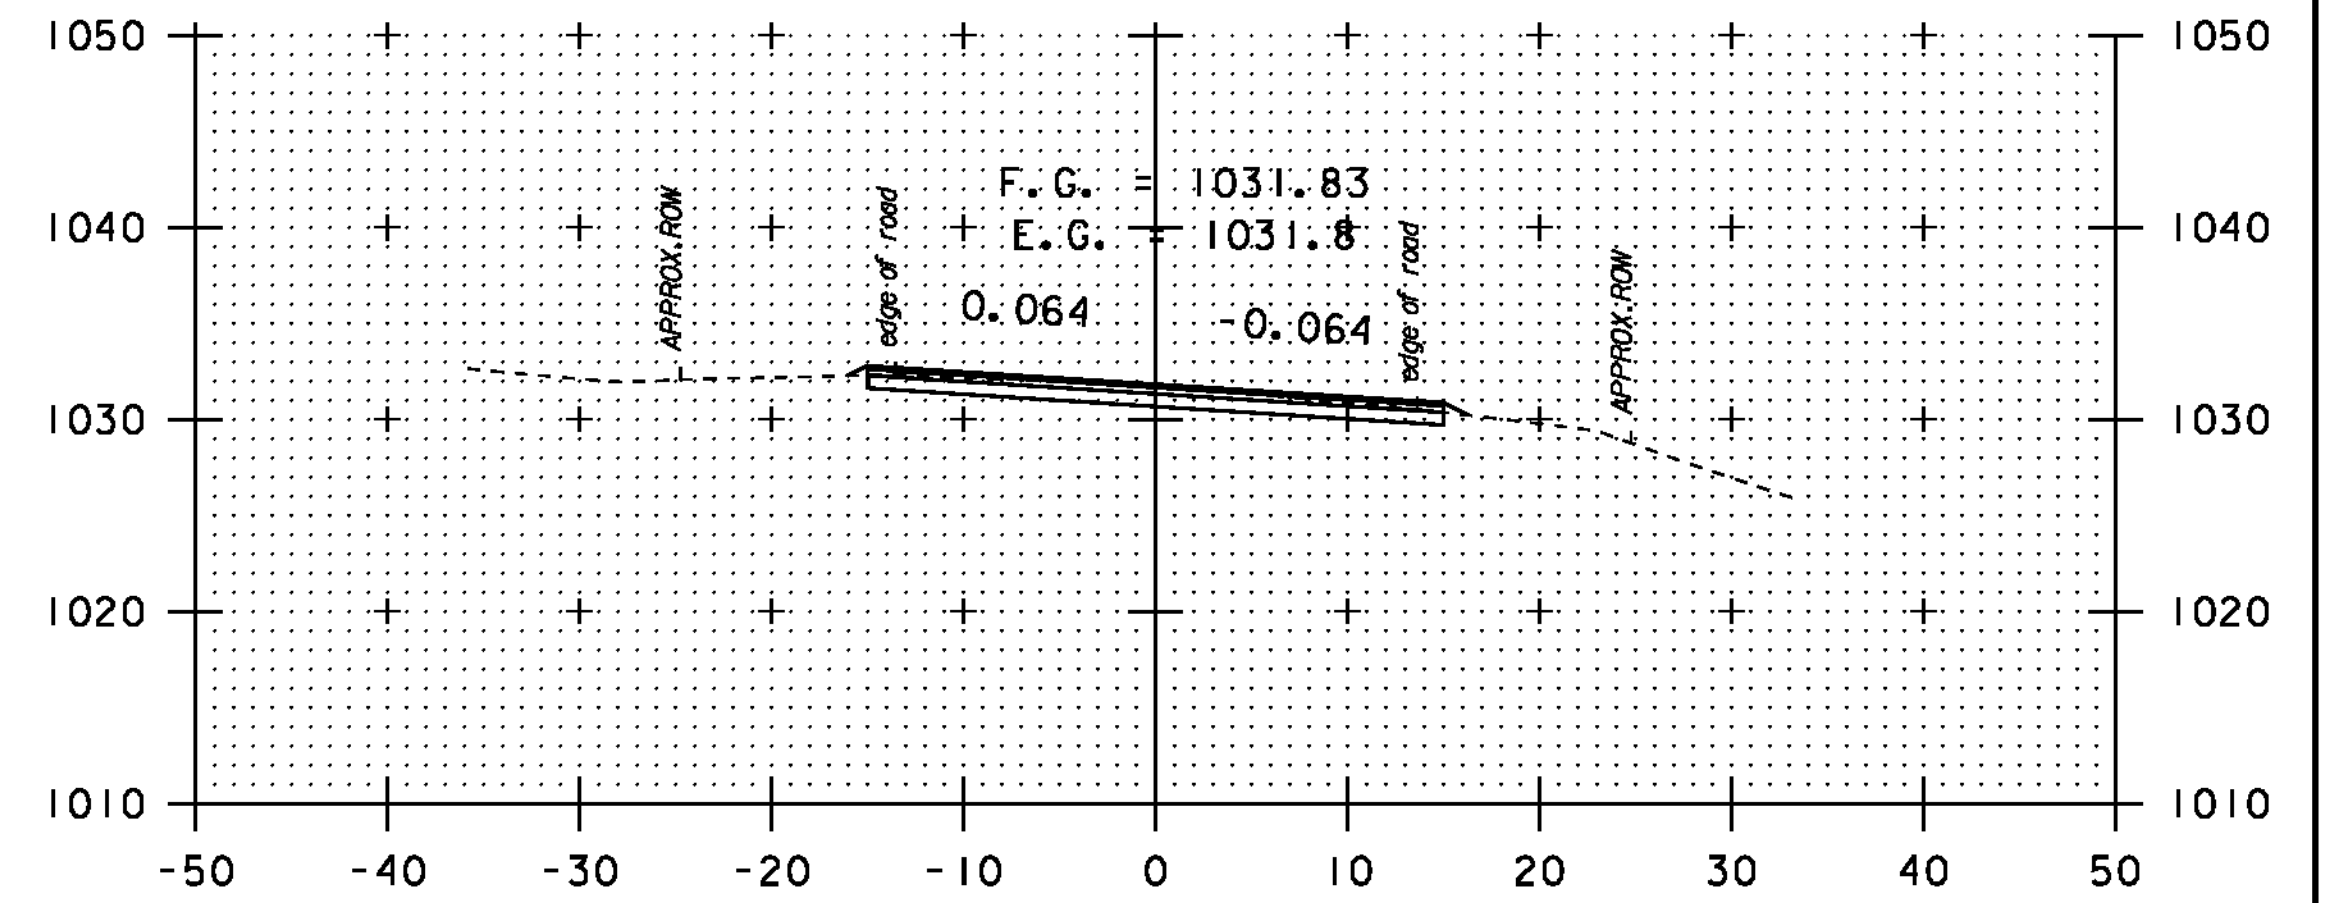

43+50

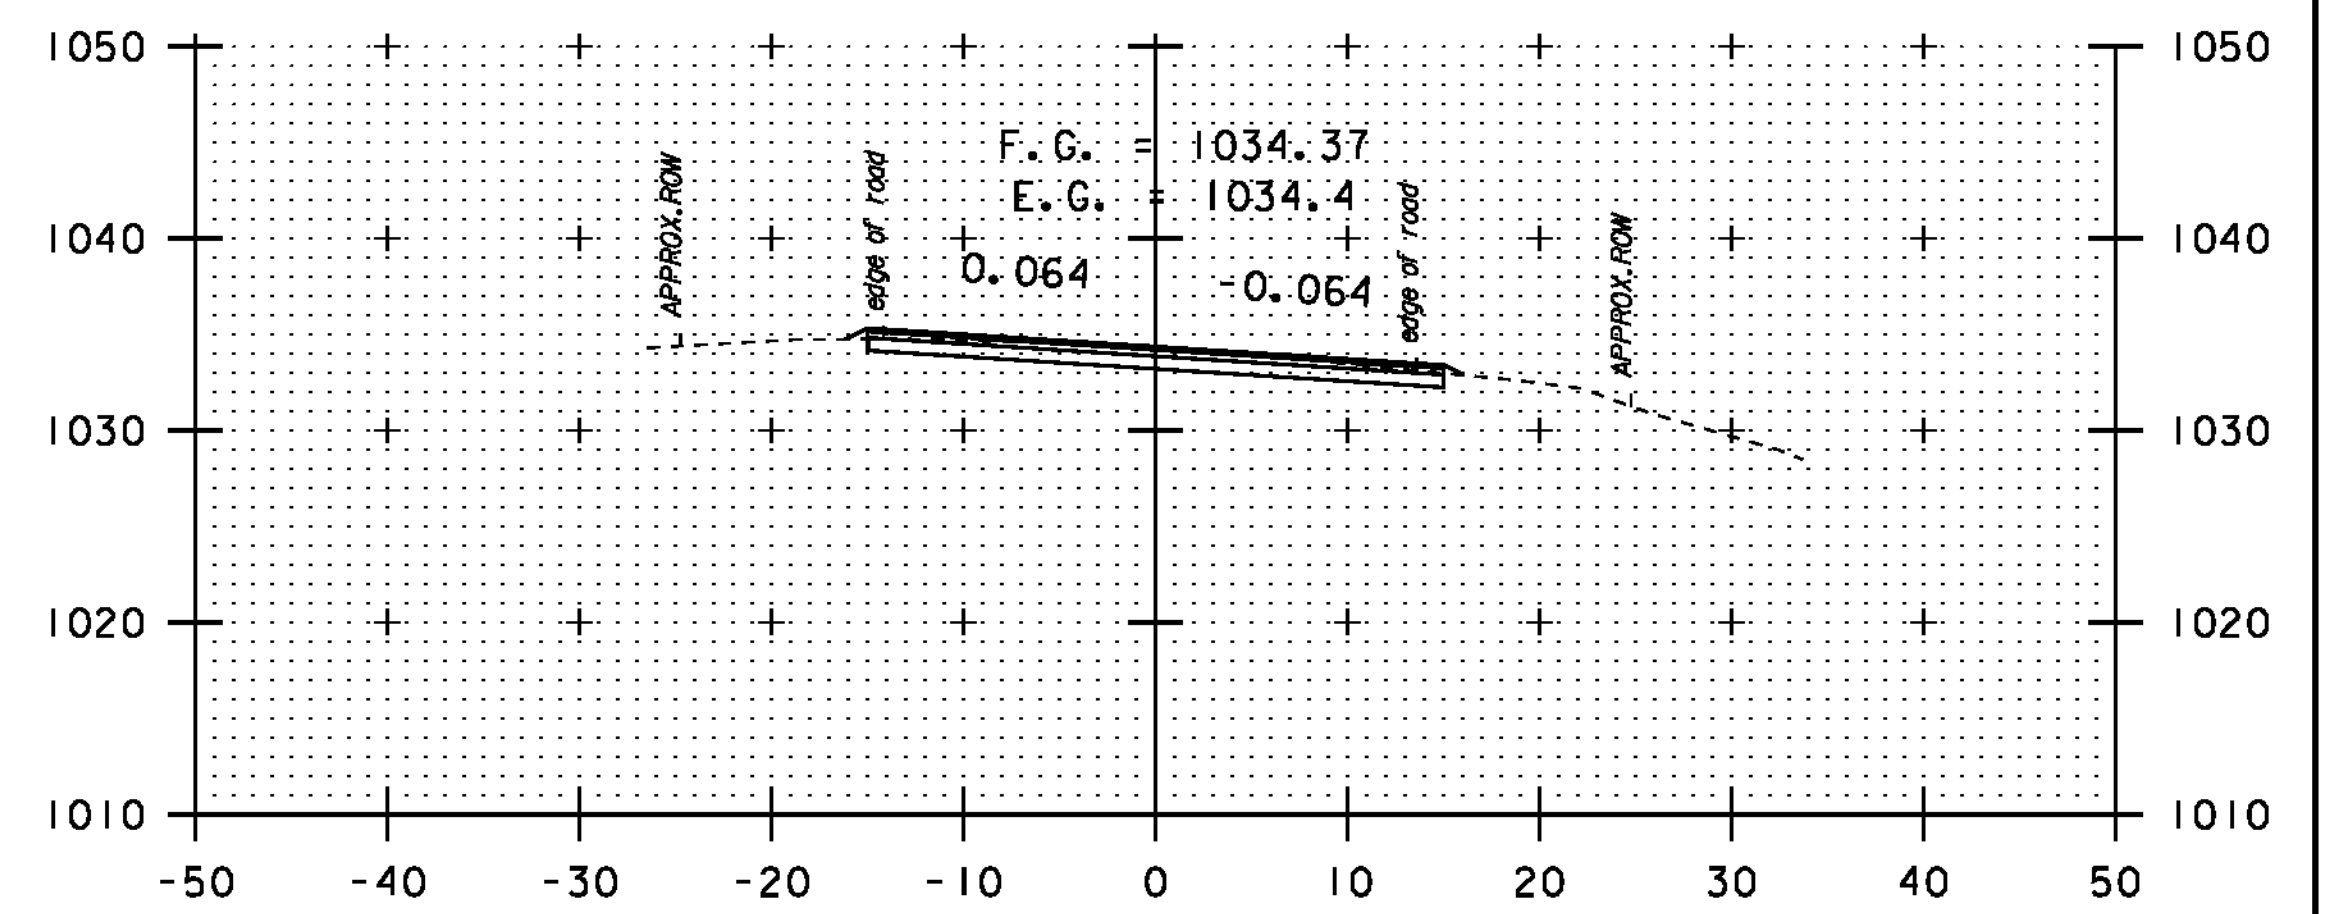

43+00

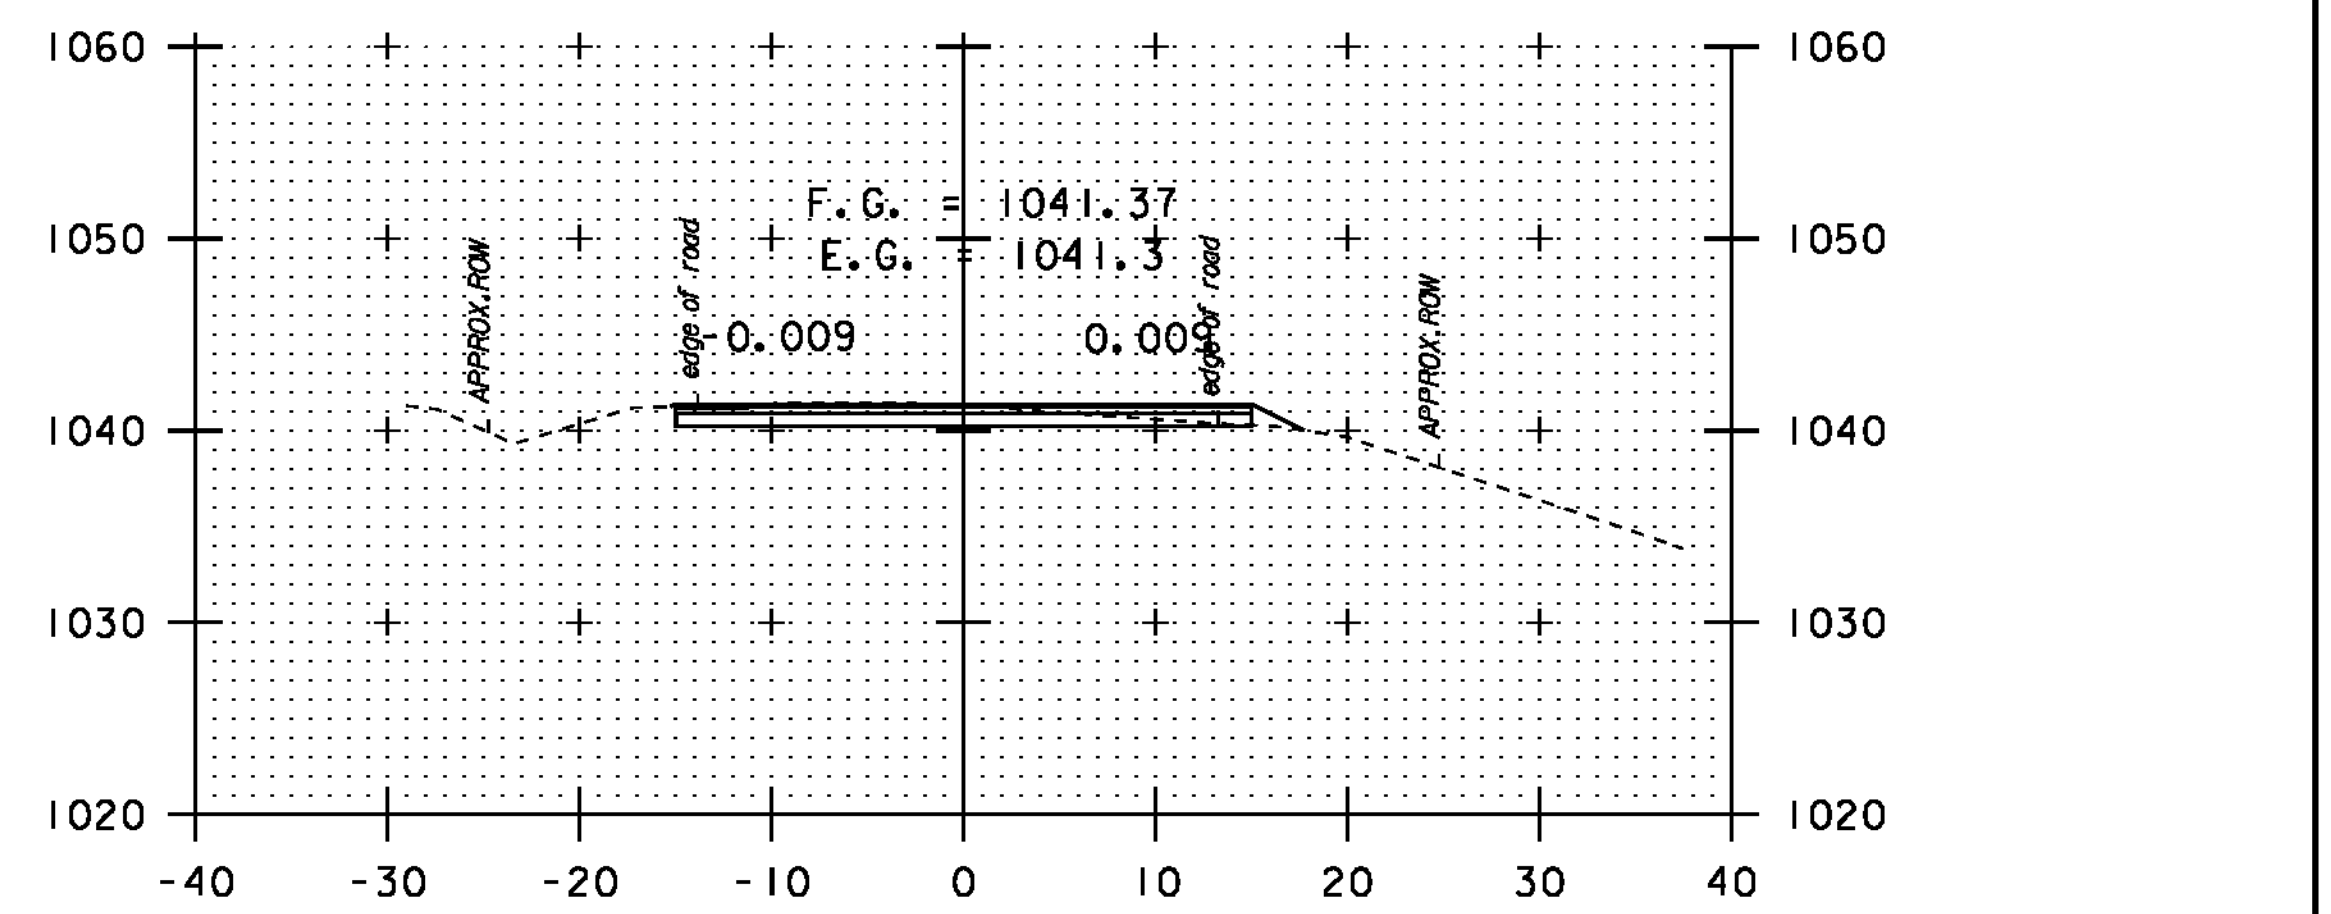

41+69

DATUM	NAVD 88
	NAD 83



STA. 38 + 50
-
STA. 43 + 50

CROSS SECTION SHEET 29

PROJECT NAME:	NEWPORT-COVENTRY-NEWPORT
PROJECT NUMBER:	STP 2802 (I)
FILE NAME:	08b158.dgn
PROJECT LEADER:	CDL
DESIGNED BY:	BMB
PLOT FILE:	08b158-102.1
PLOT DATE:	8/3/2011
DRAWN BY:	BMB
CHECKED BY:	EPD
SHEET	102 OF 134