




45+00

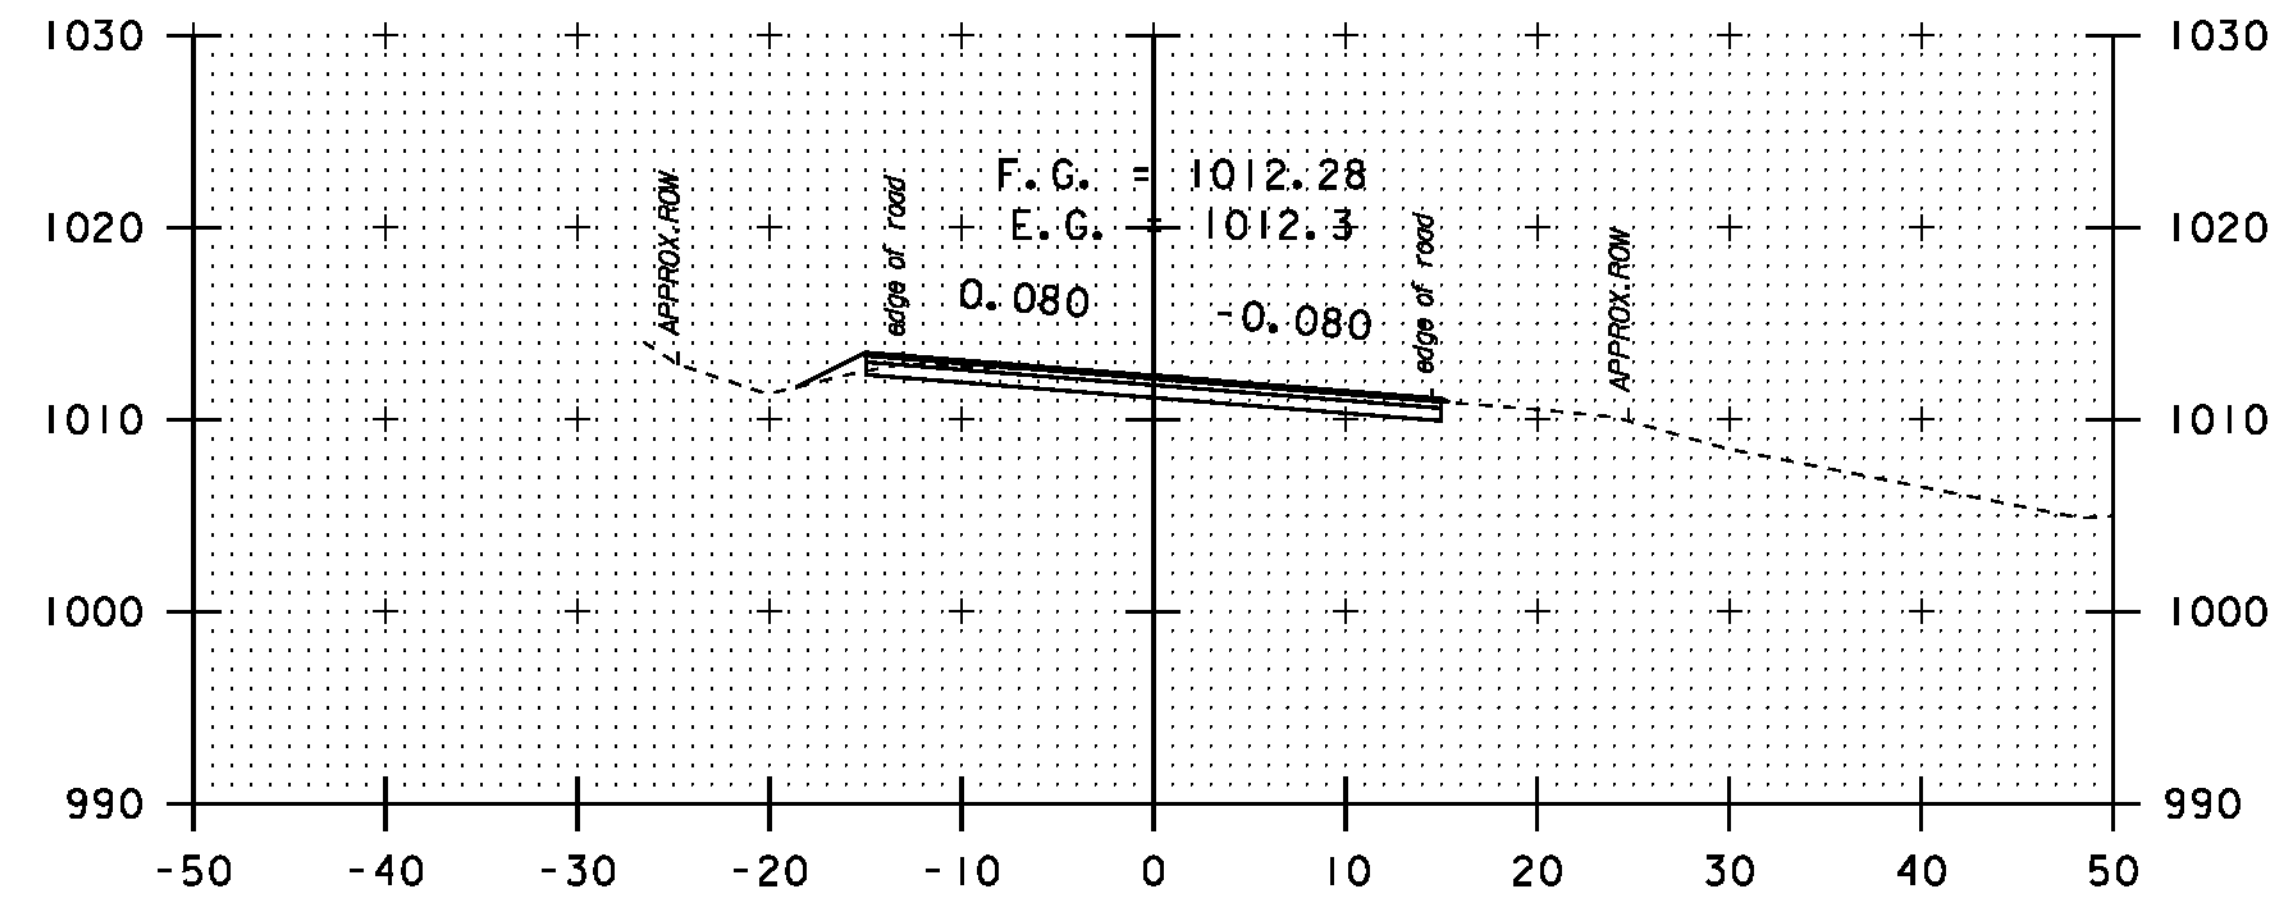


47+00

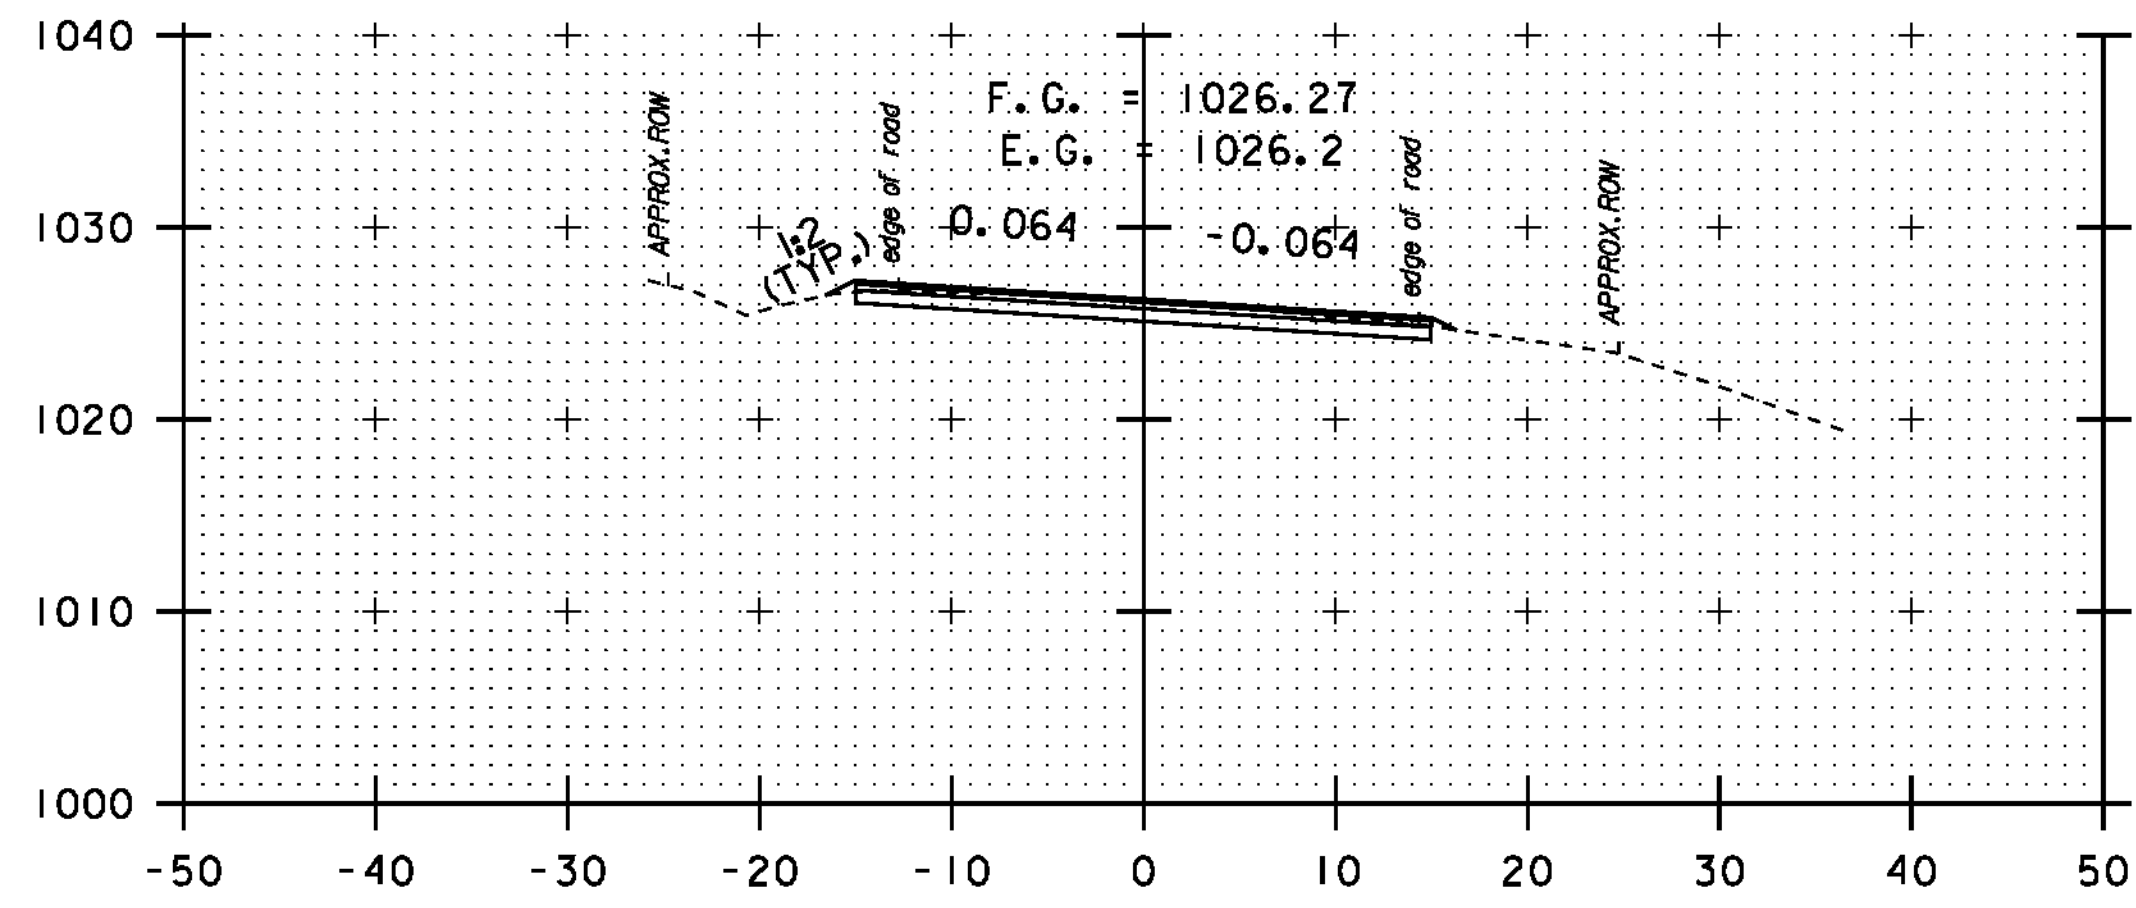


44+50

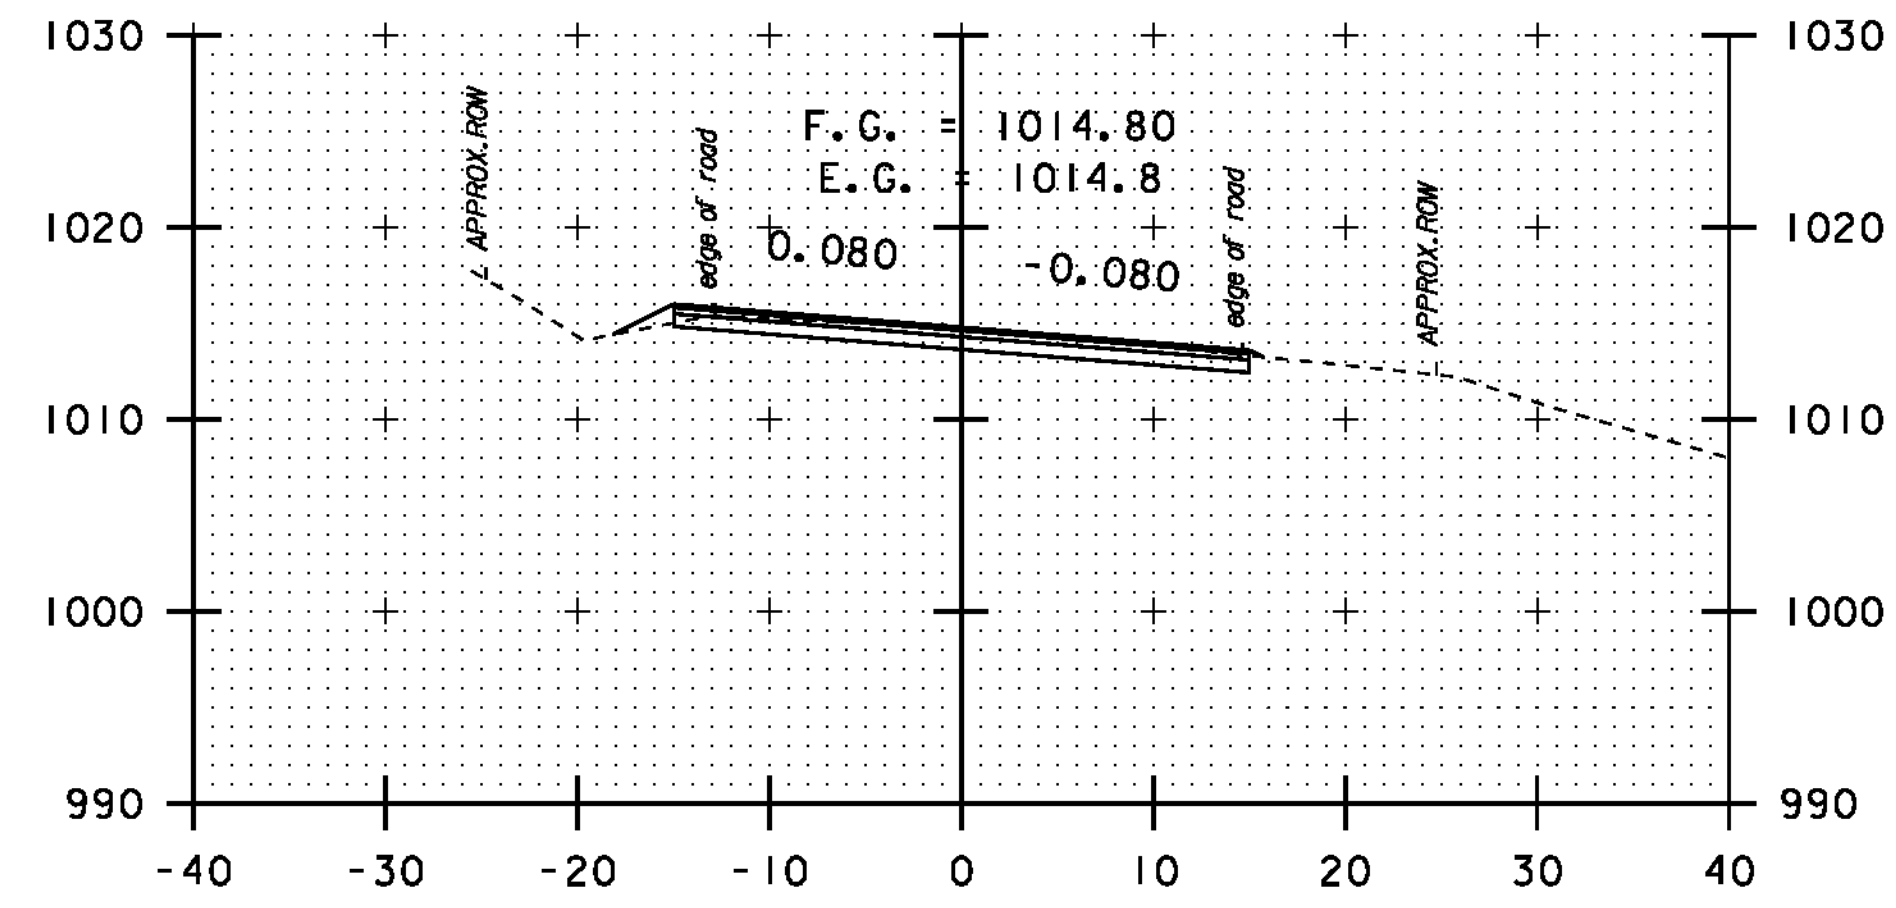

46+55

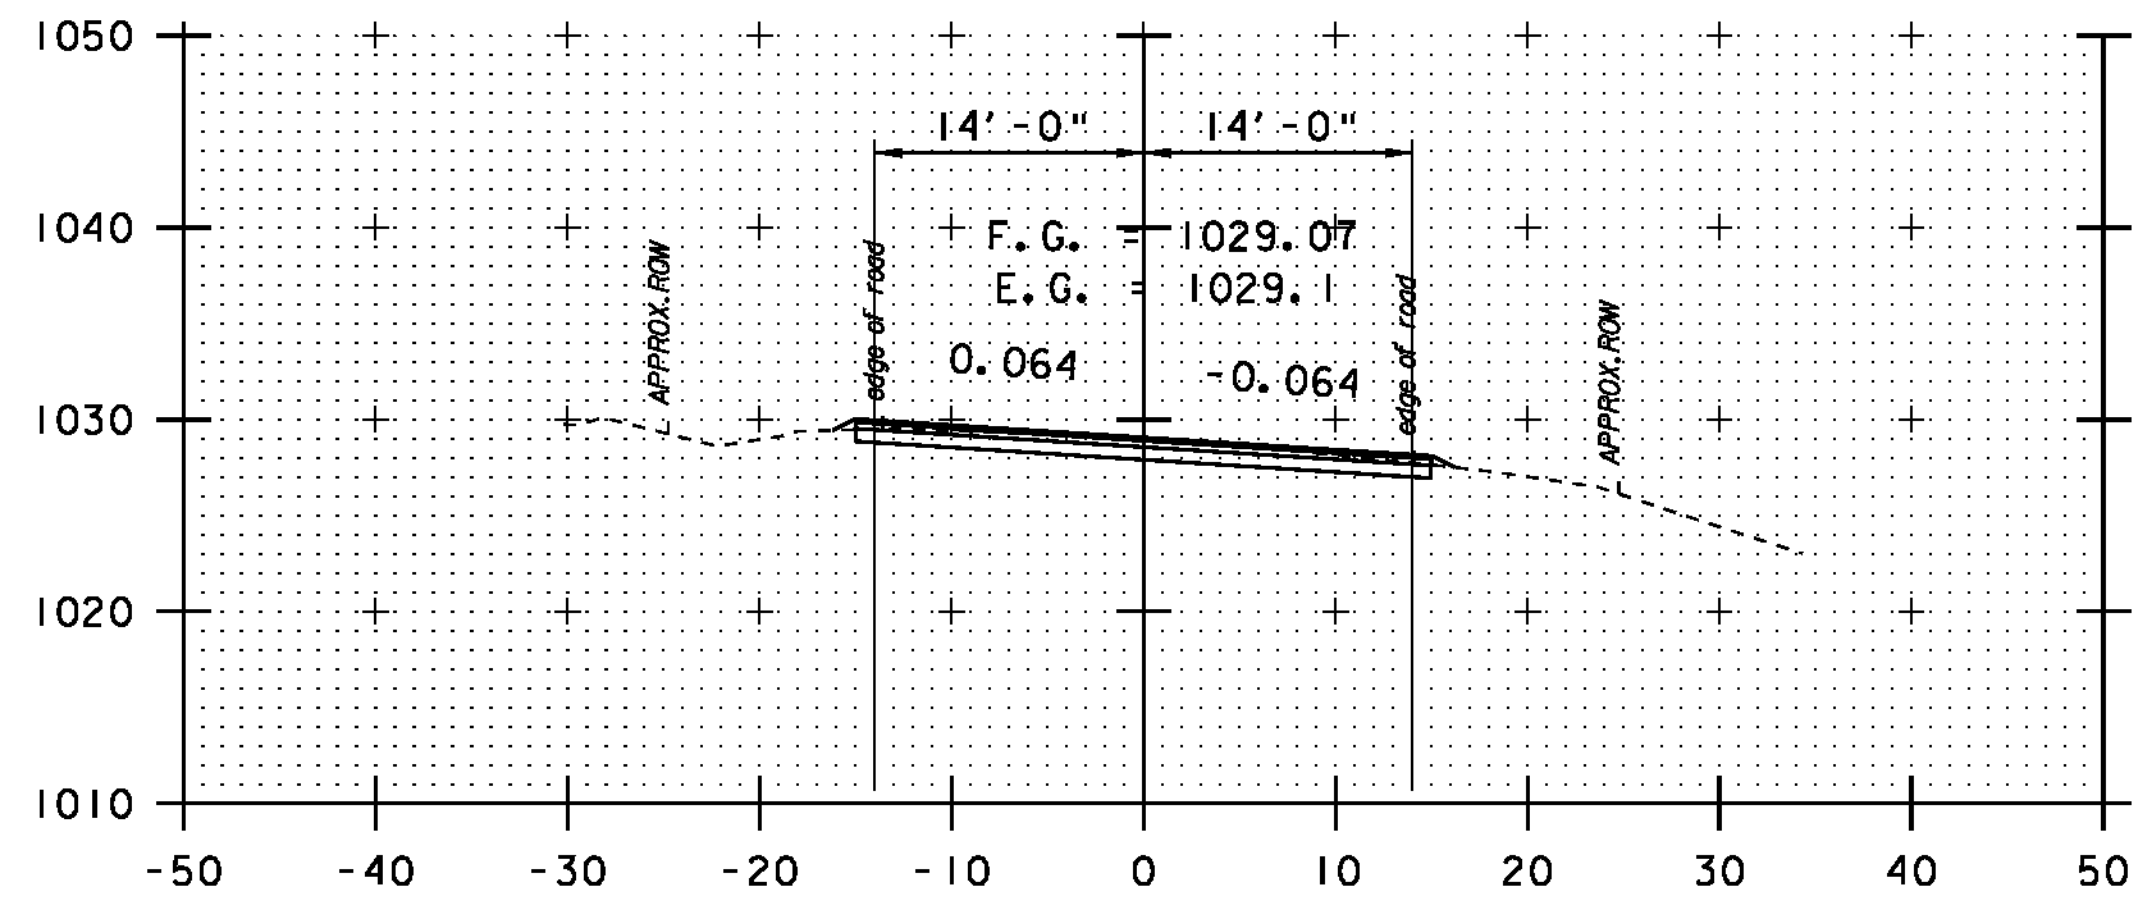

44+00

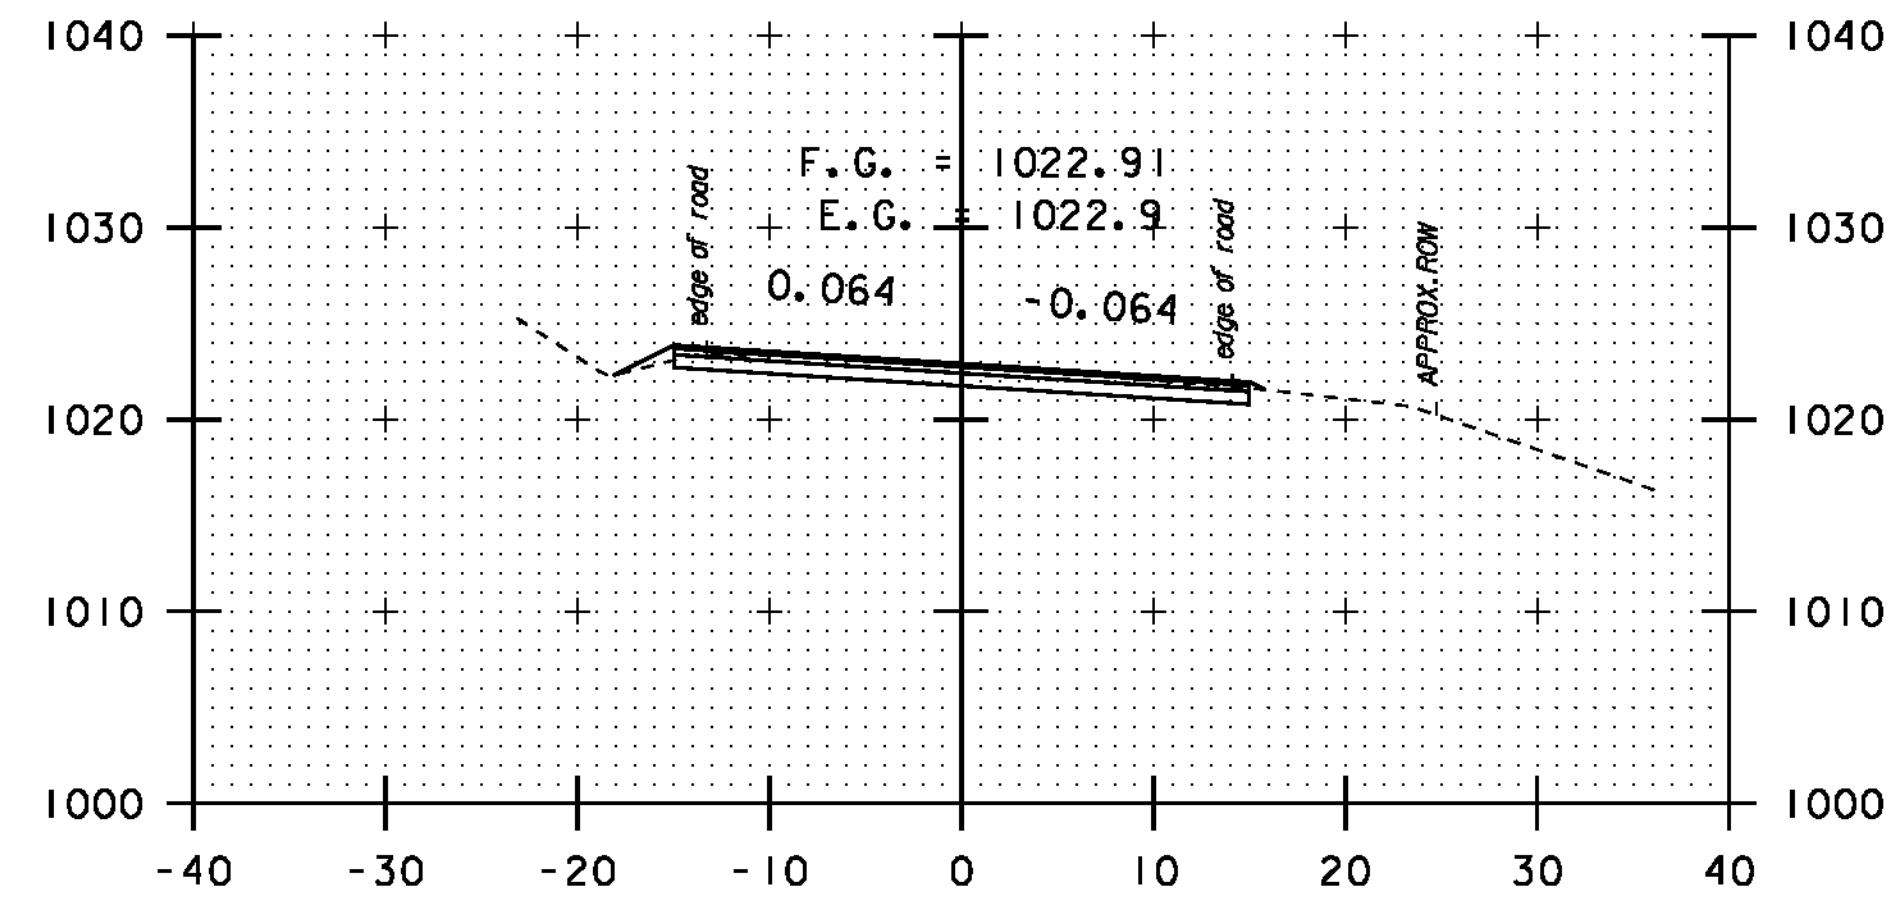

45+10

DATUM	NAVD 88
	NAD 83



**STA. 44+00**  
 -  
**STA. 47+00**

**CROSS SECTION SHEET 30**

PROJECT NAME:	NEWPORT-COVENTRY-NEWPORT
PROJECT NUMBER:	STP 2802(I)
FILE NAME:	08b158.dgn
PROJECT LEADER:	CDL
DESIGNED BY:	BMB
PLOT FILE:	08b158-103.1
PLOT DATE:	8/3/2011
DRAWN BY:	BMB
CHECKED BY:	EPD
SHEET	103 OF 134