




48+50

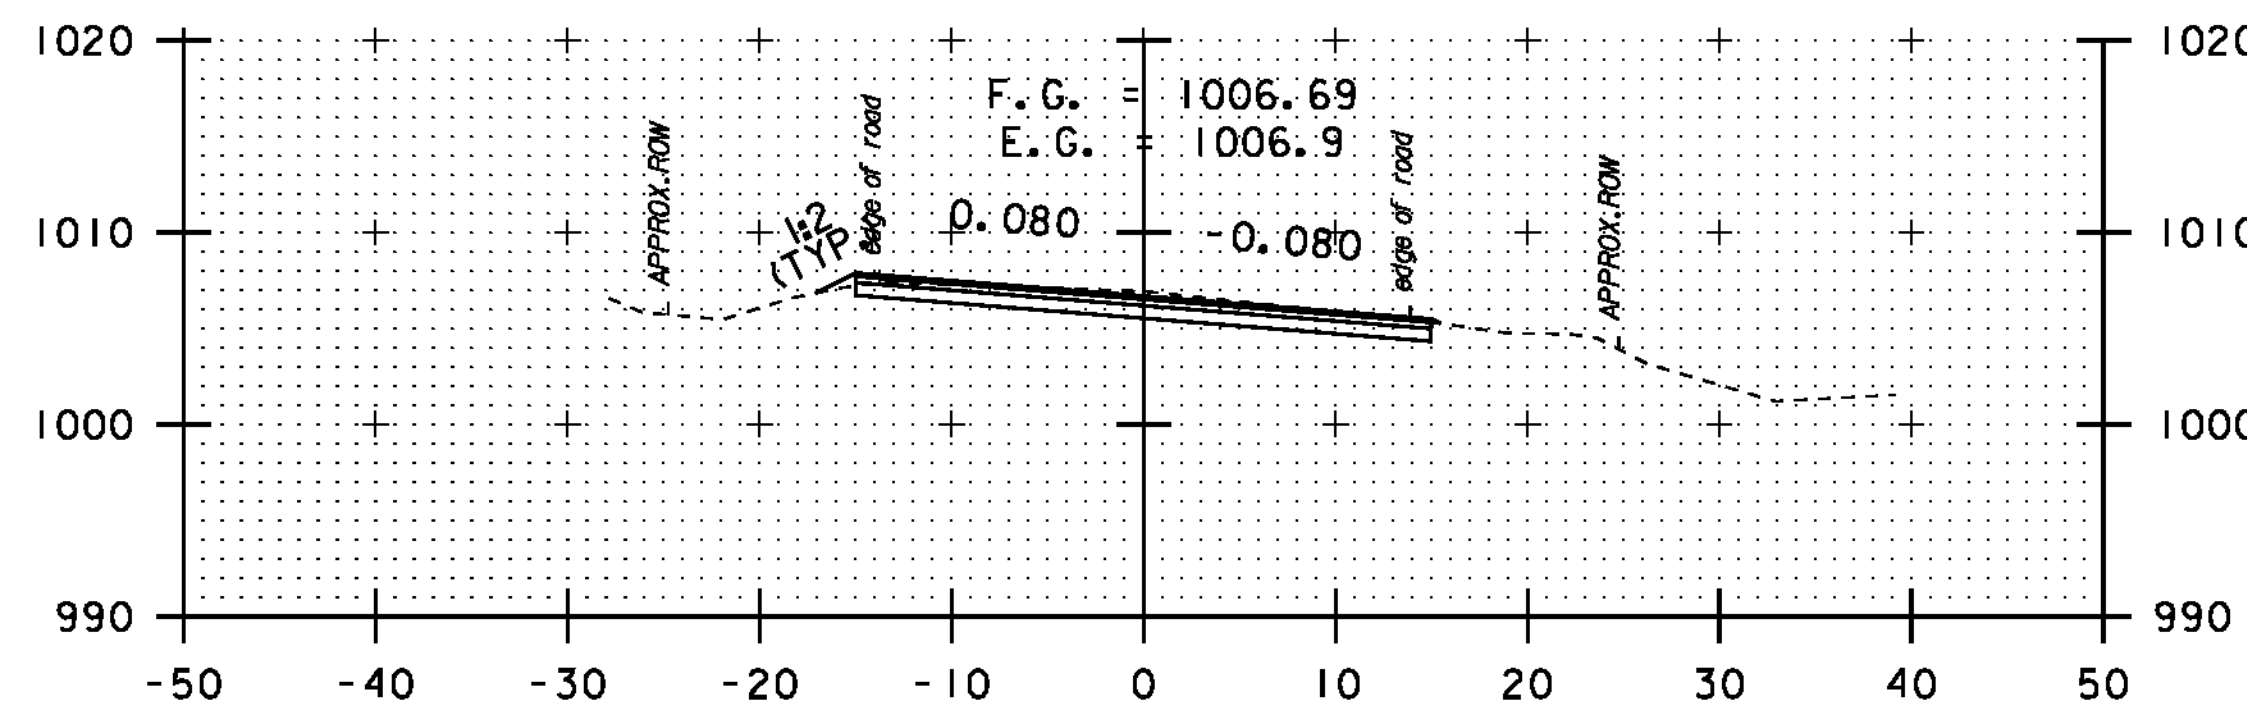


48+00

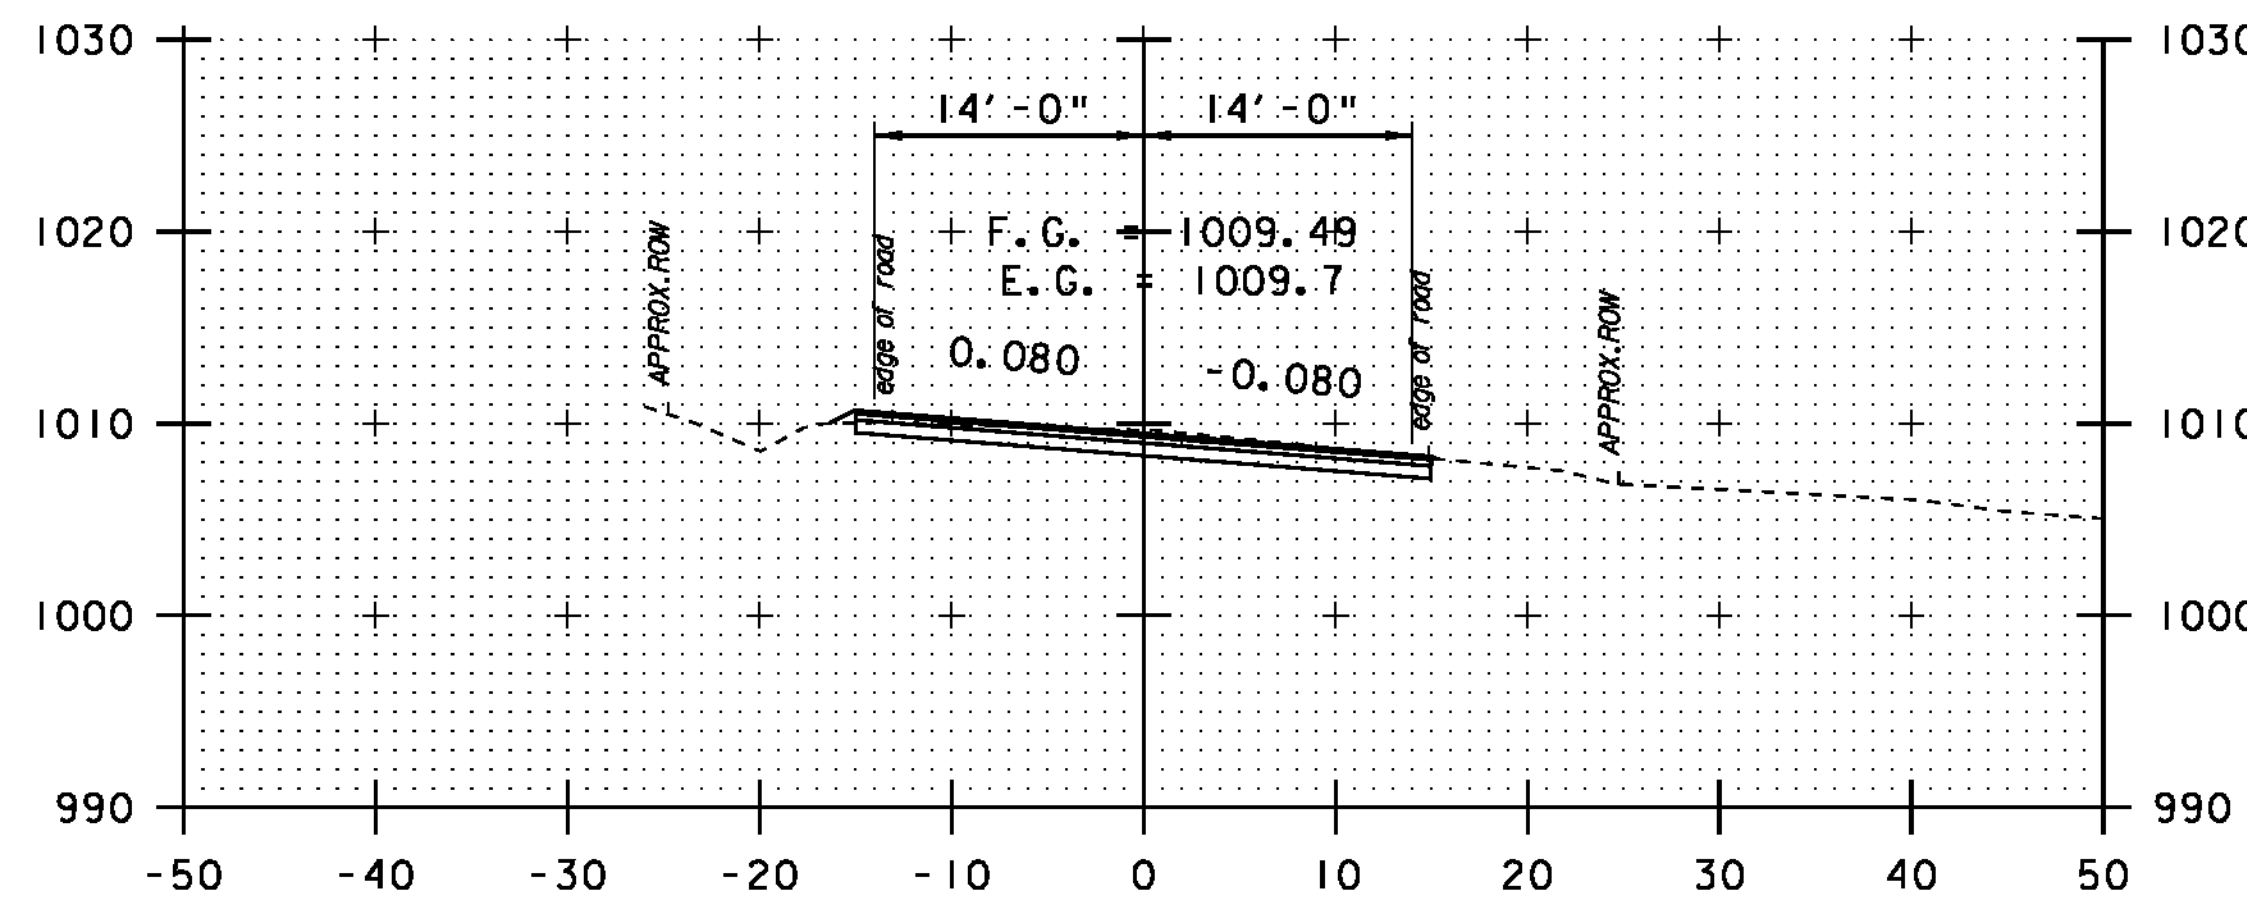


47+50

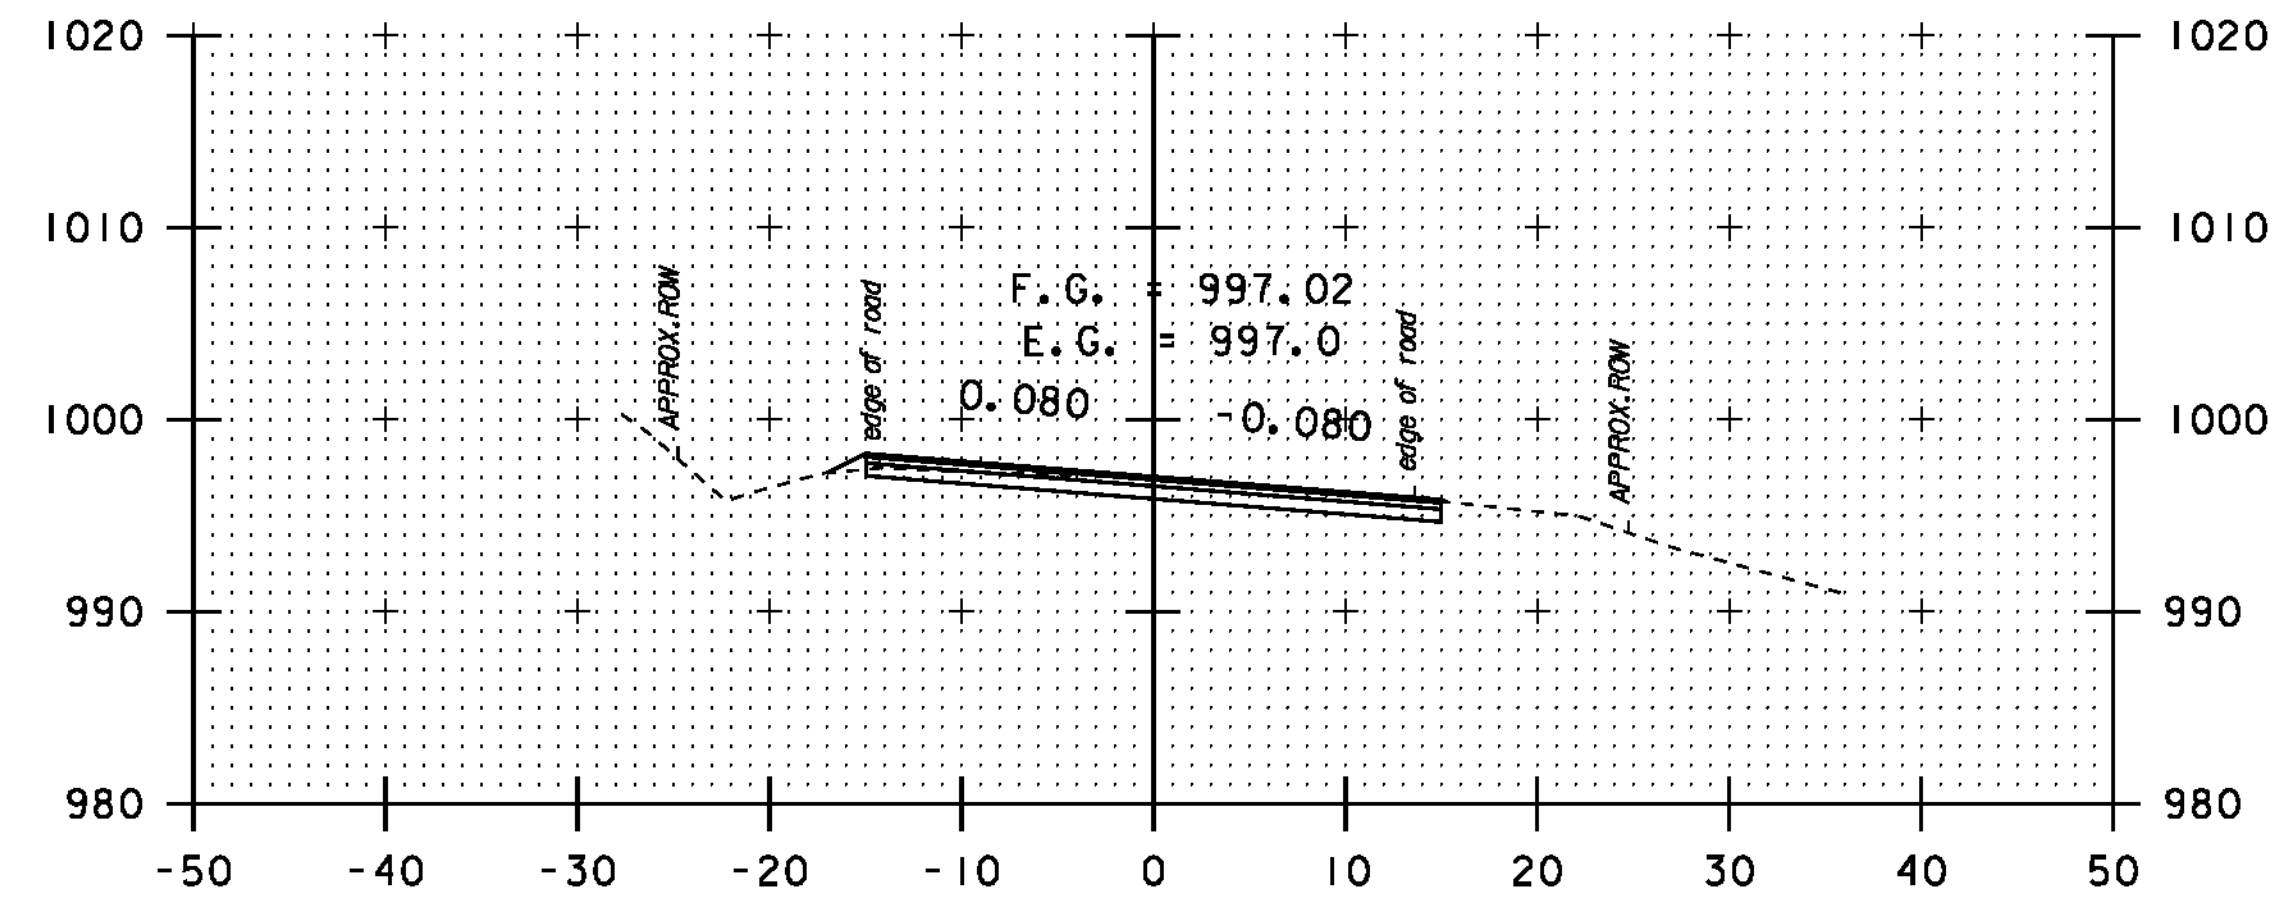

50+00

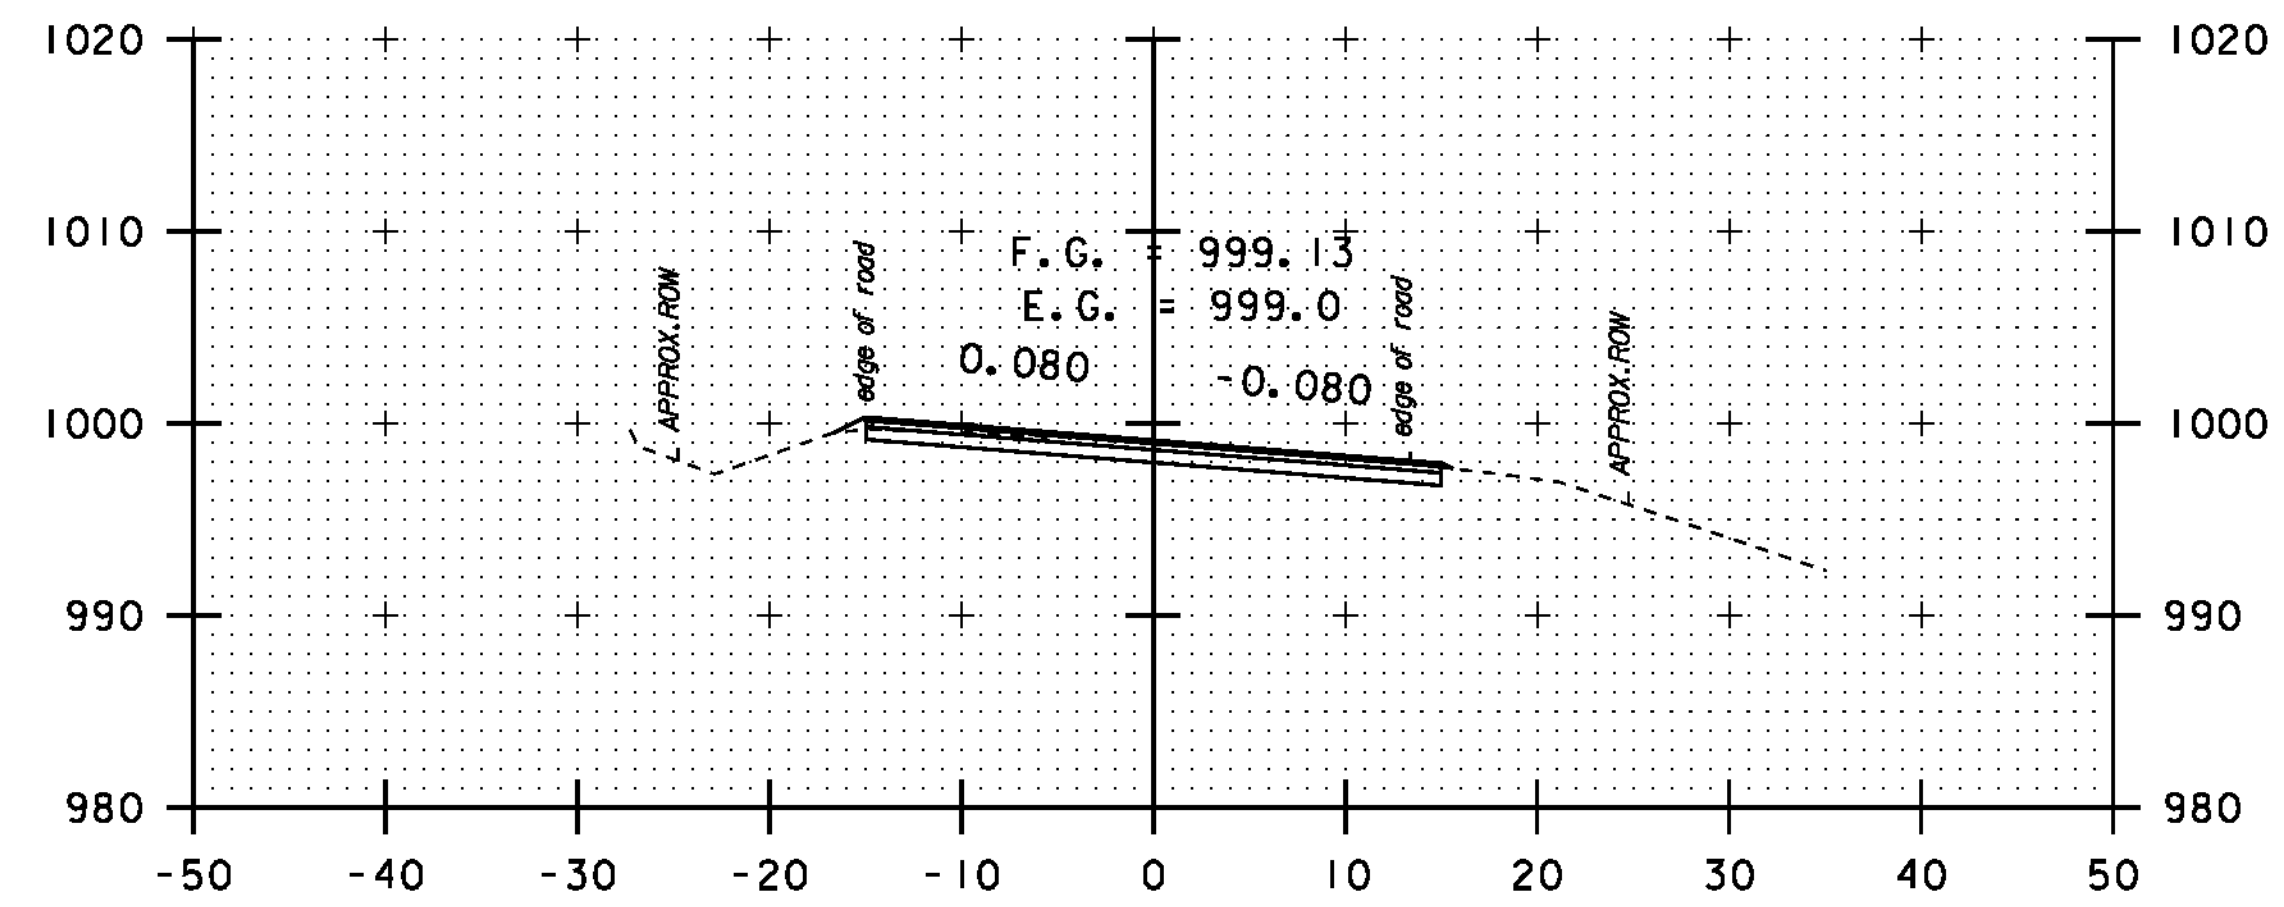

49+50

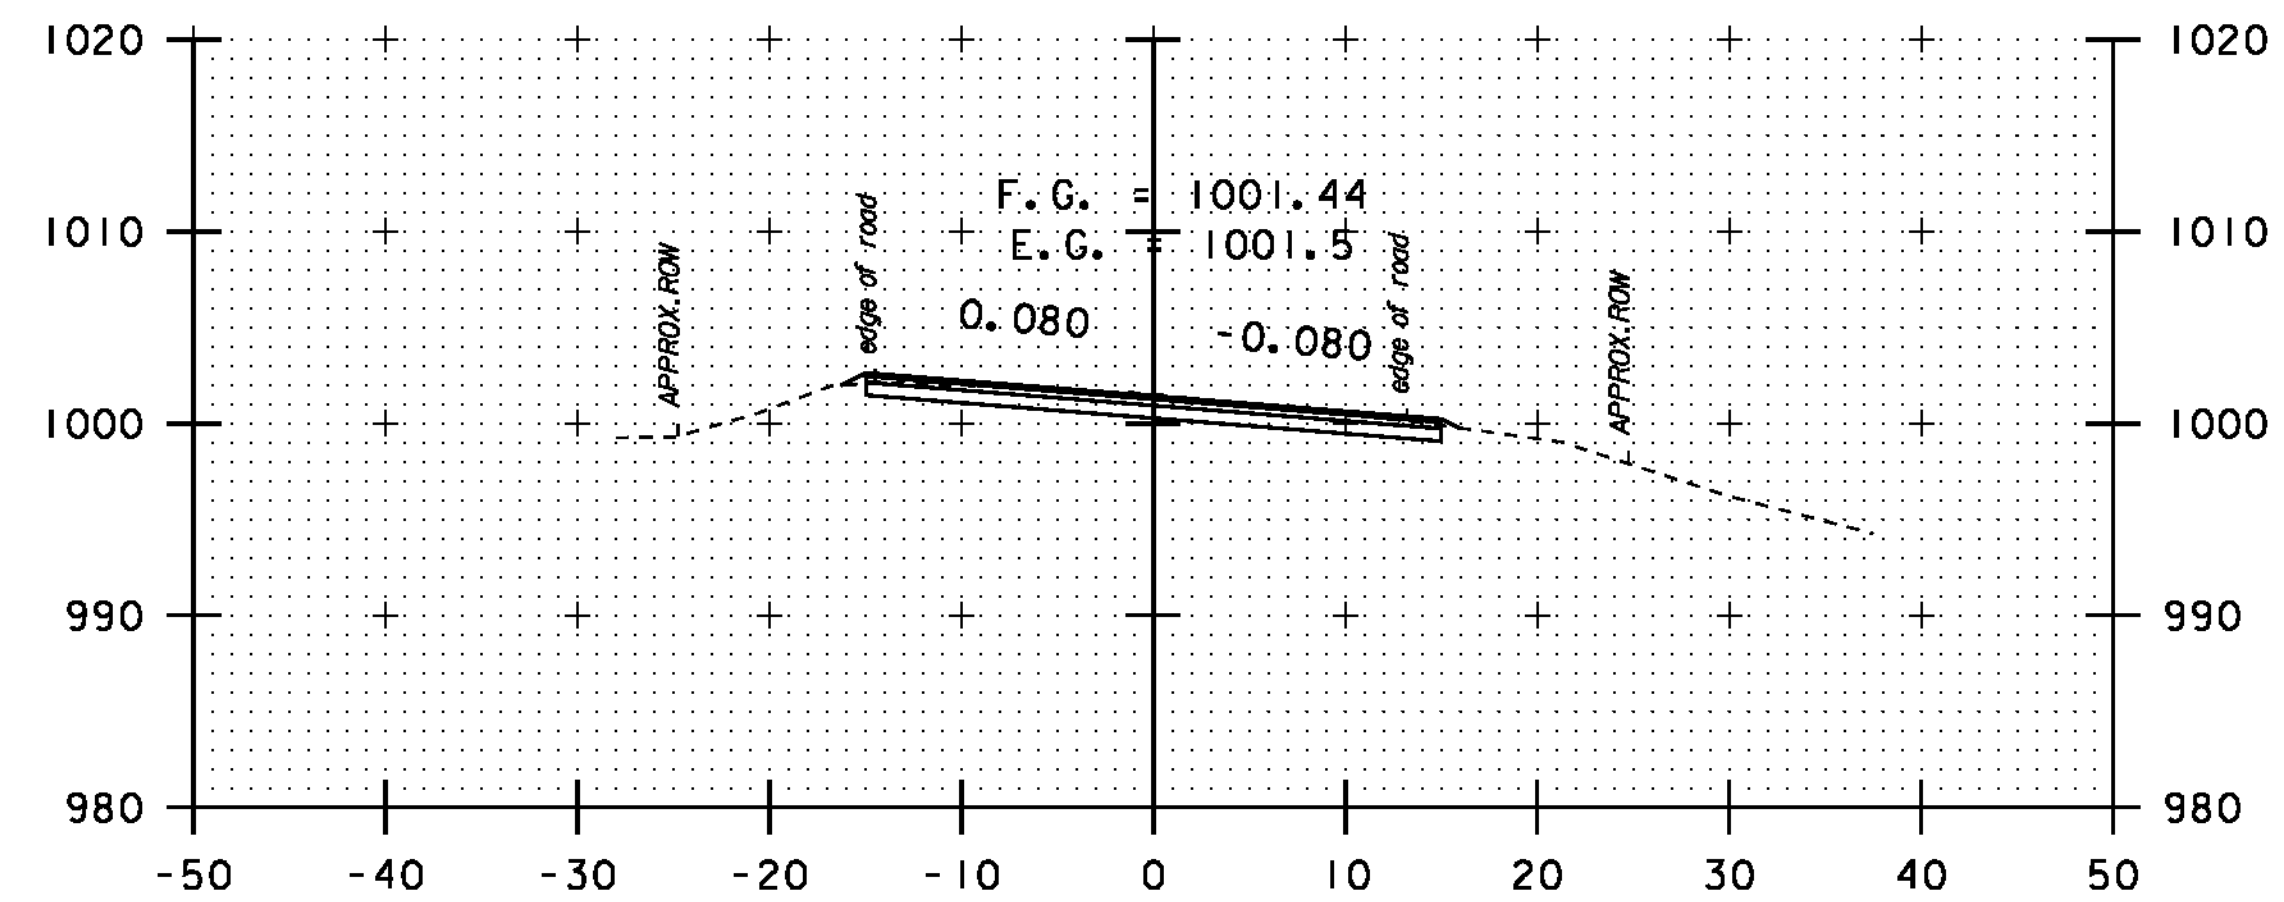

49+00

DATUM	NAVD 88
	NAD 83



**STA. 47+50**  
 -  
**STA. 50+00**

**CROSS SECTION SHEET 31**

PROJECT NAME:	NEWPORT-COVENTRY-NEWPORT
PROJECT NUMBER:	STP 2802 (I)
FILE NAME:	08b158.dgn
PROJECT LEADER:	CDL
DESIGNED BY:	BMB
PLOT FILE:	08b158-104.1
PLOT DATE:	8/3/2011
DRAWN BY:	BMB
CHECKED BY:	EPD
SHEET	104 OF 134