




51+50

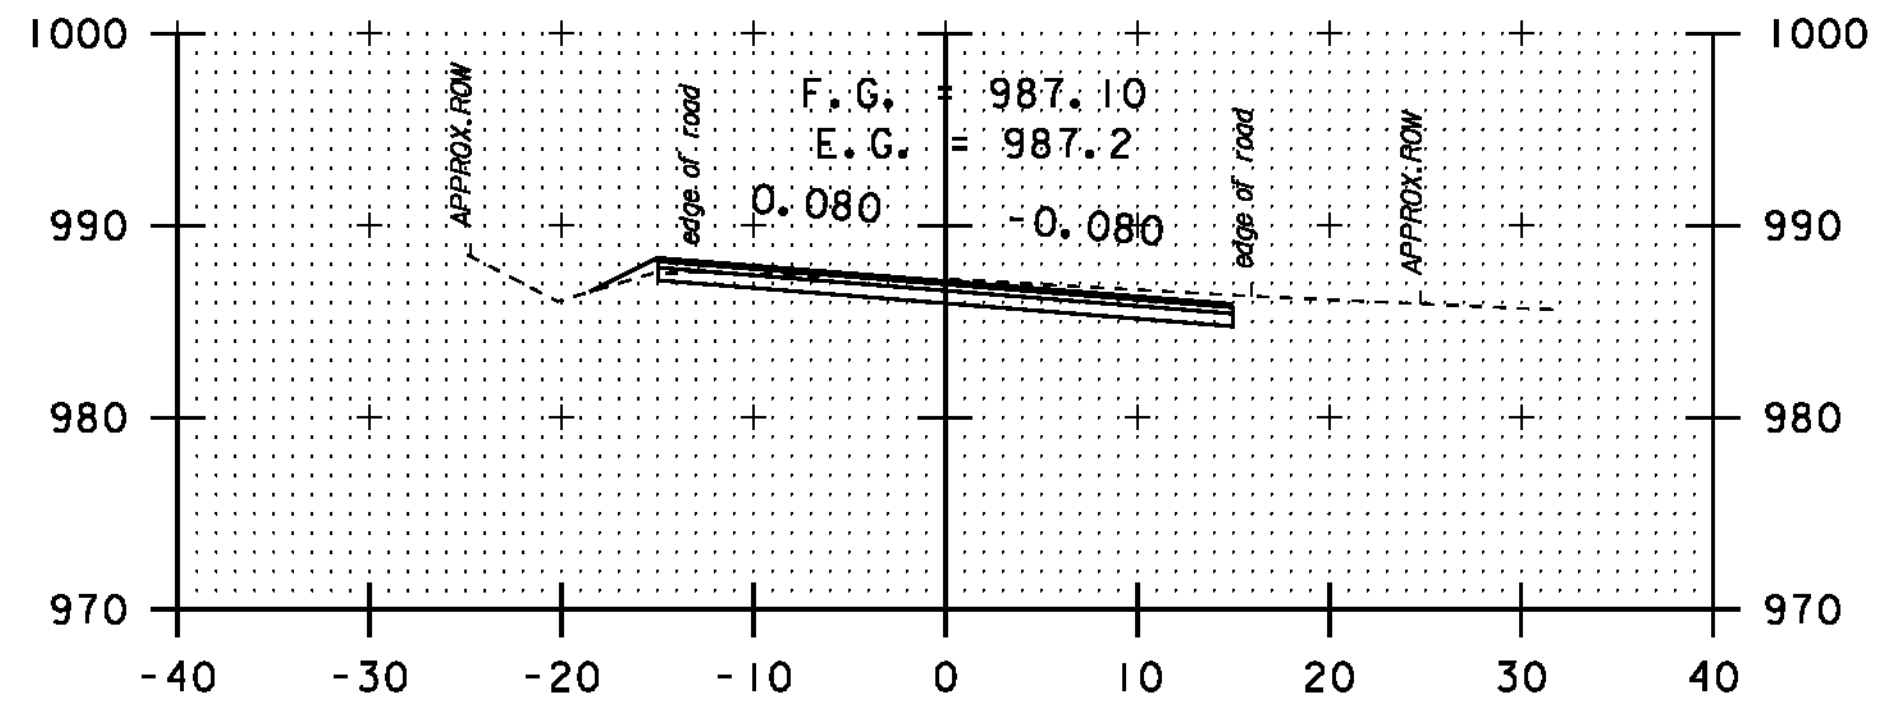


52+70

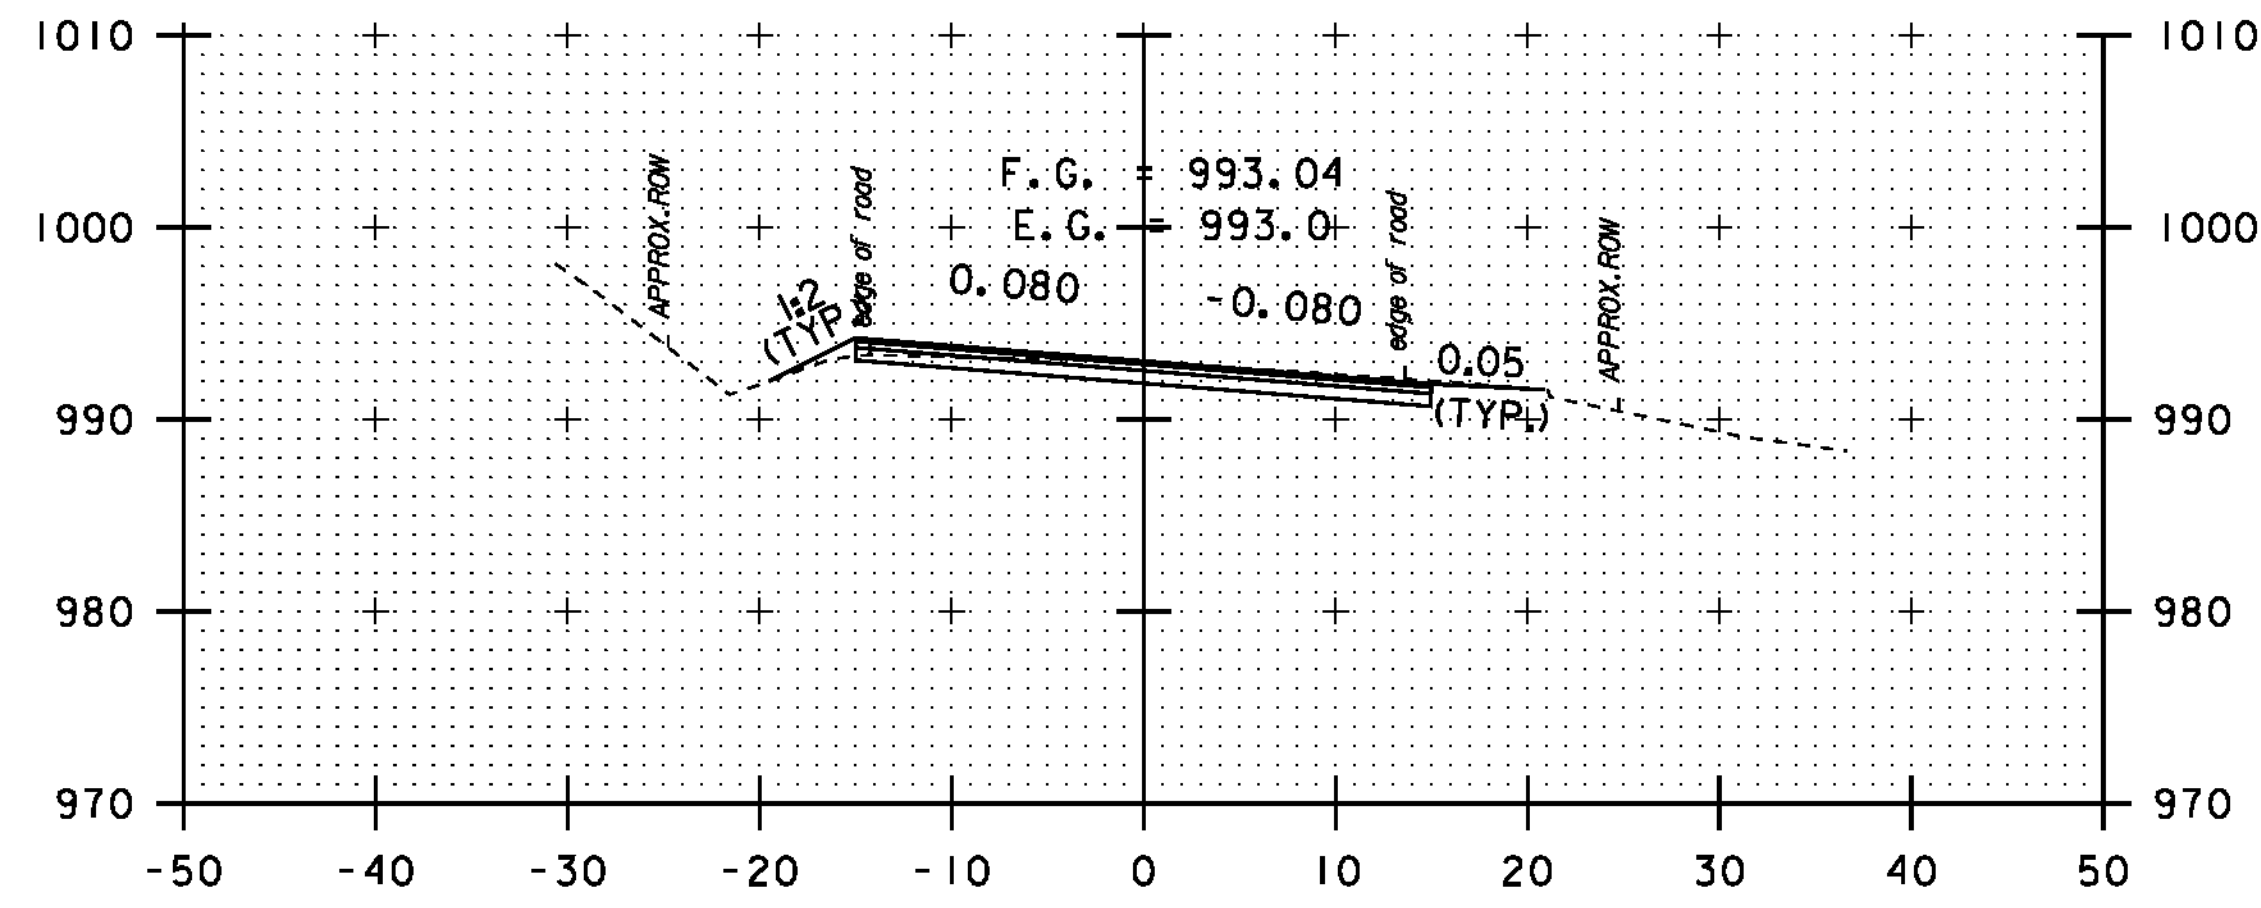


51+00

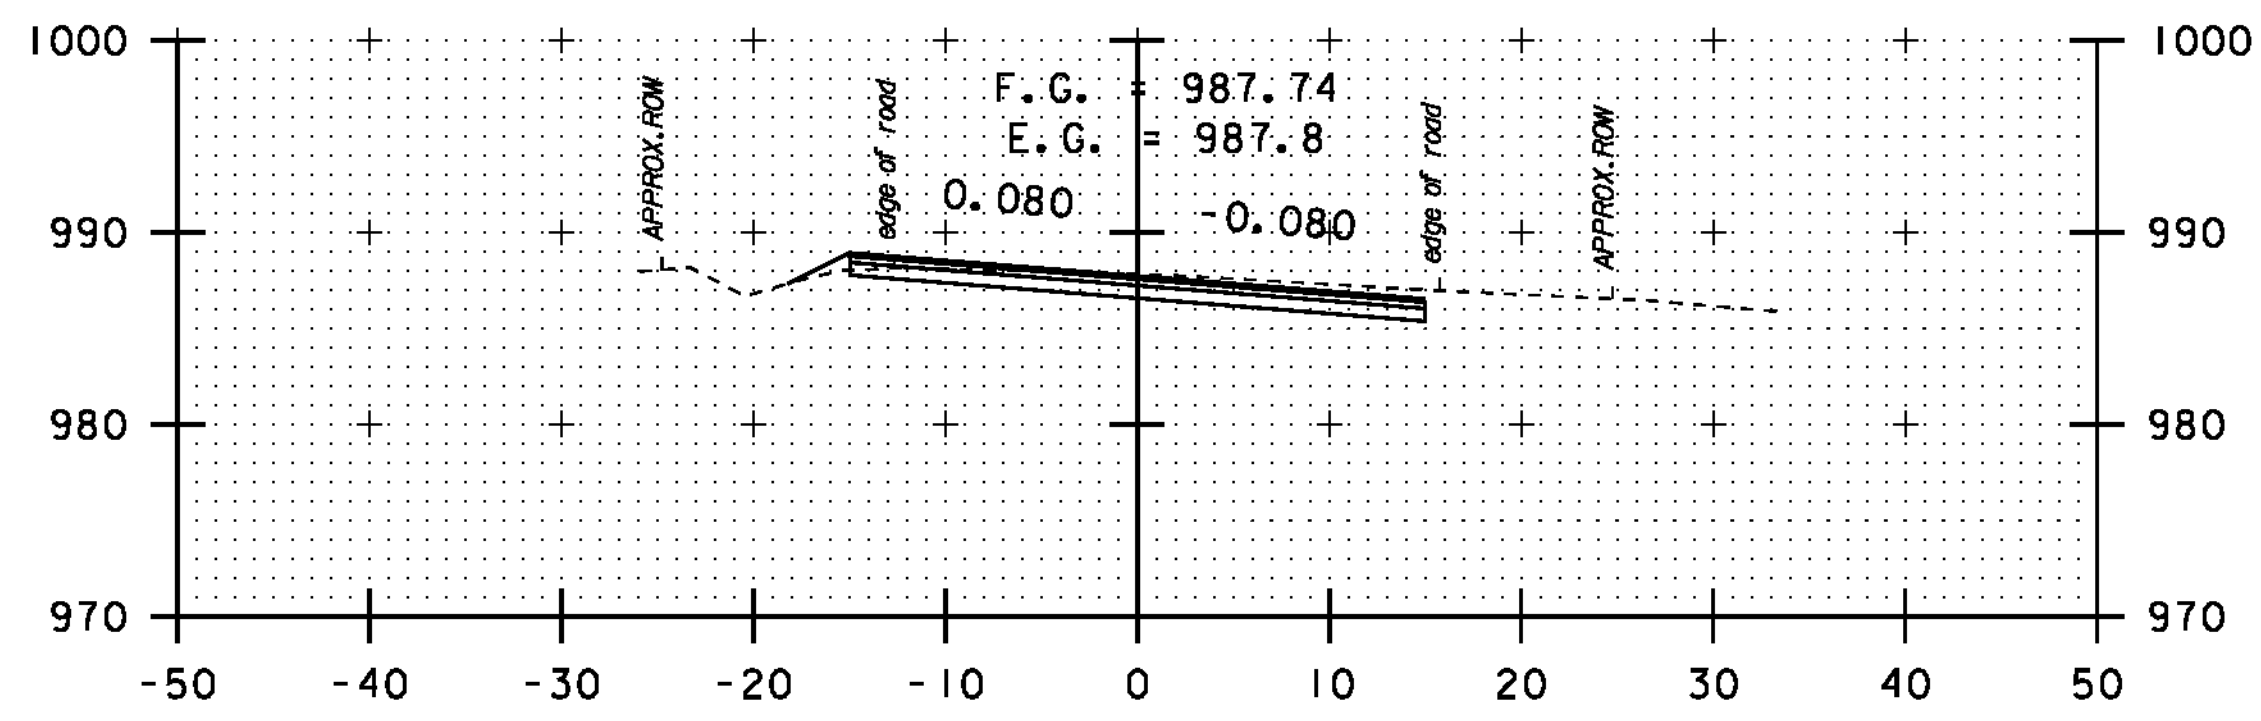

52+50

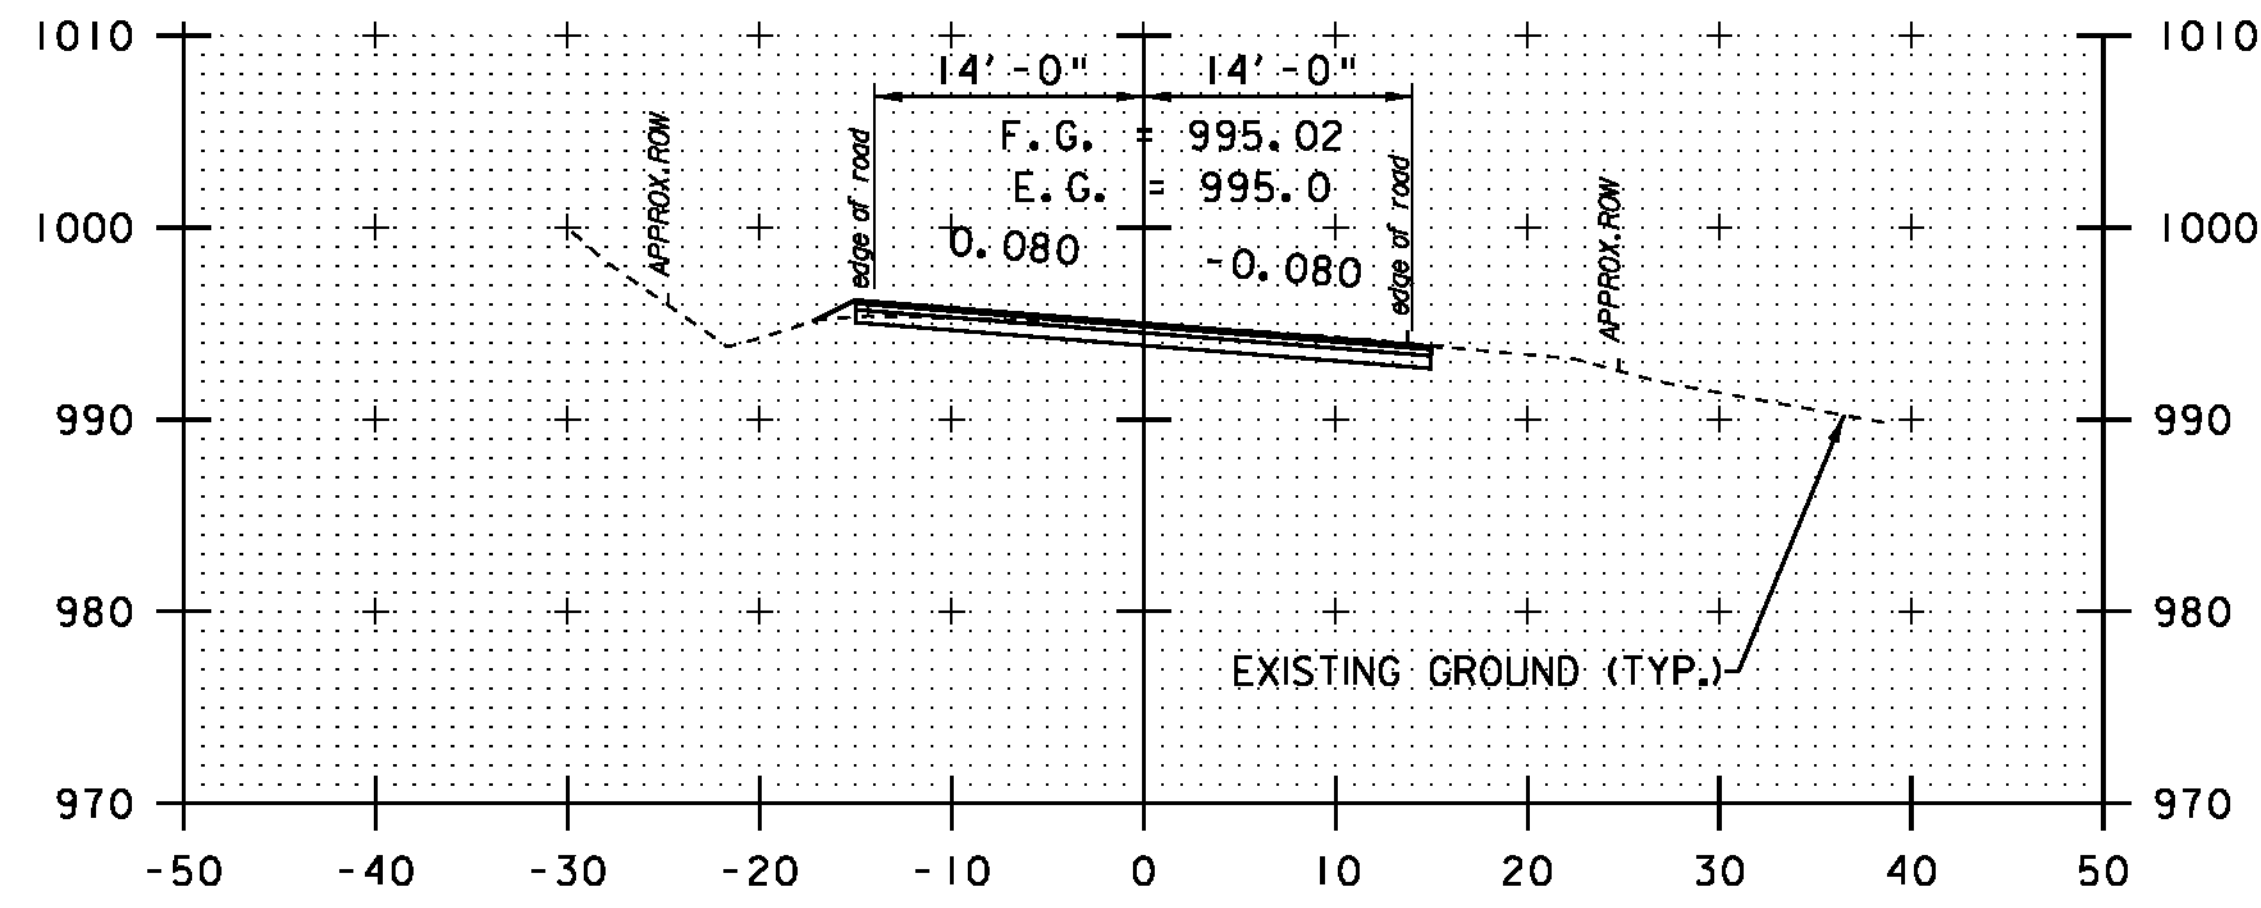

50+50

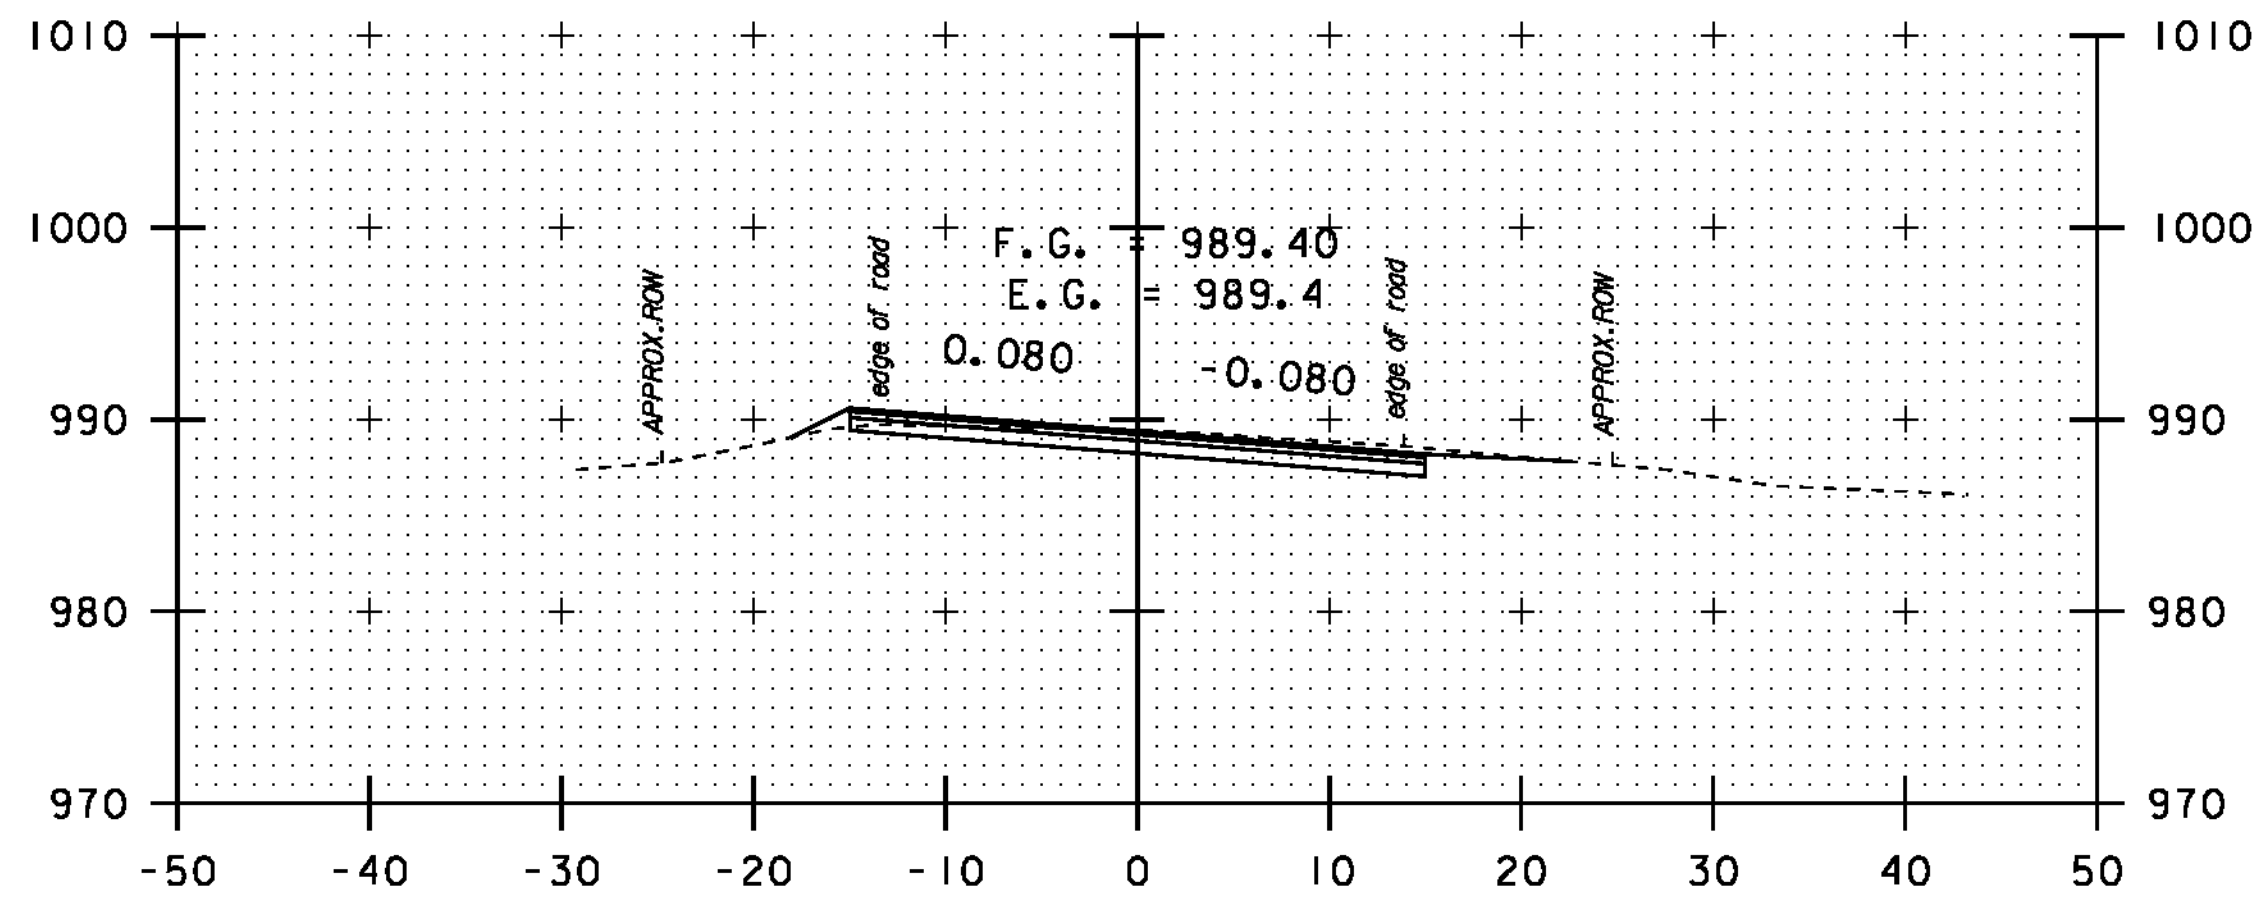

52+00

DATUM	NAVD 88
	NAD 83



STA. 50 + 50
-
STA. 52 + 70

CROSS
SECTION
SHEET 32

PROJECT NAME:	NEWPORT-COVENTRY-NEWPORT
PROJECT NUMBER:	STP 2802 (I)
FILE NAME:	08b158.dgn
PROJECT LEADER:	CDL
DESIGNED BY:	BMB
PLOT FILE:	08b158-105.1
PLOT DATE:	8/3/2011
DRAWN BY:	BMB
CHECKED BY:	EPD
SHEET	105 OF 134