




55+60

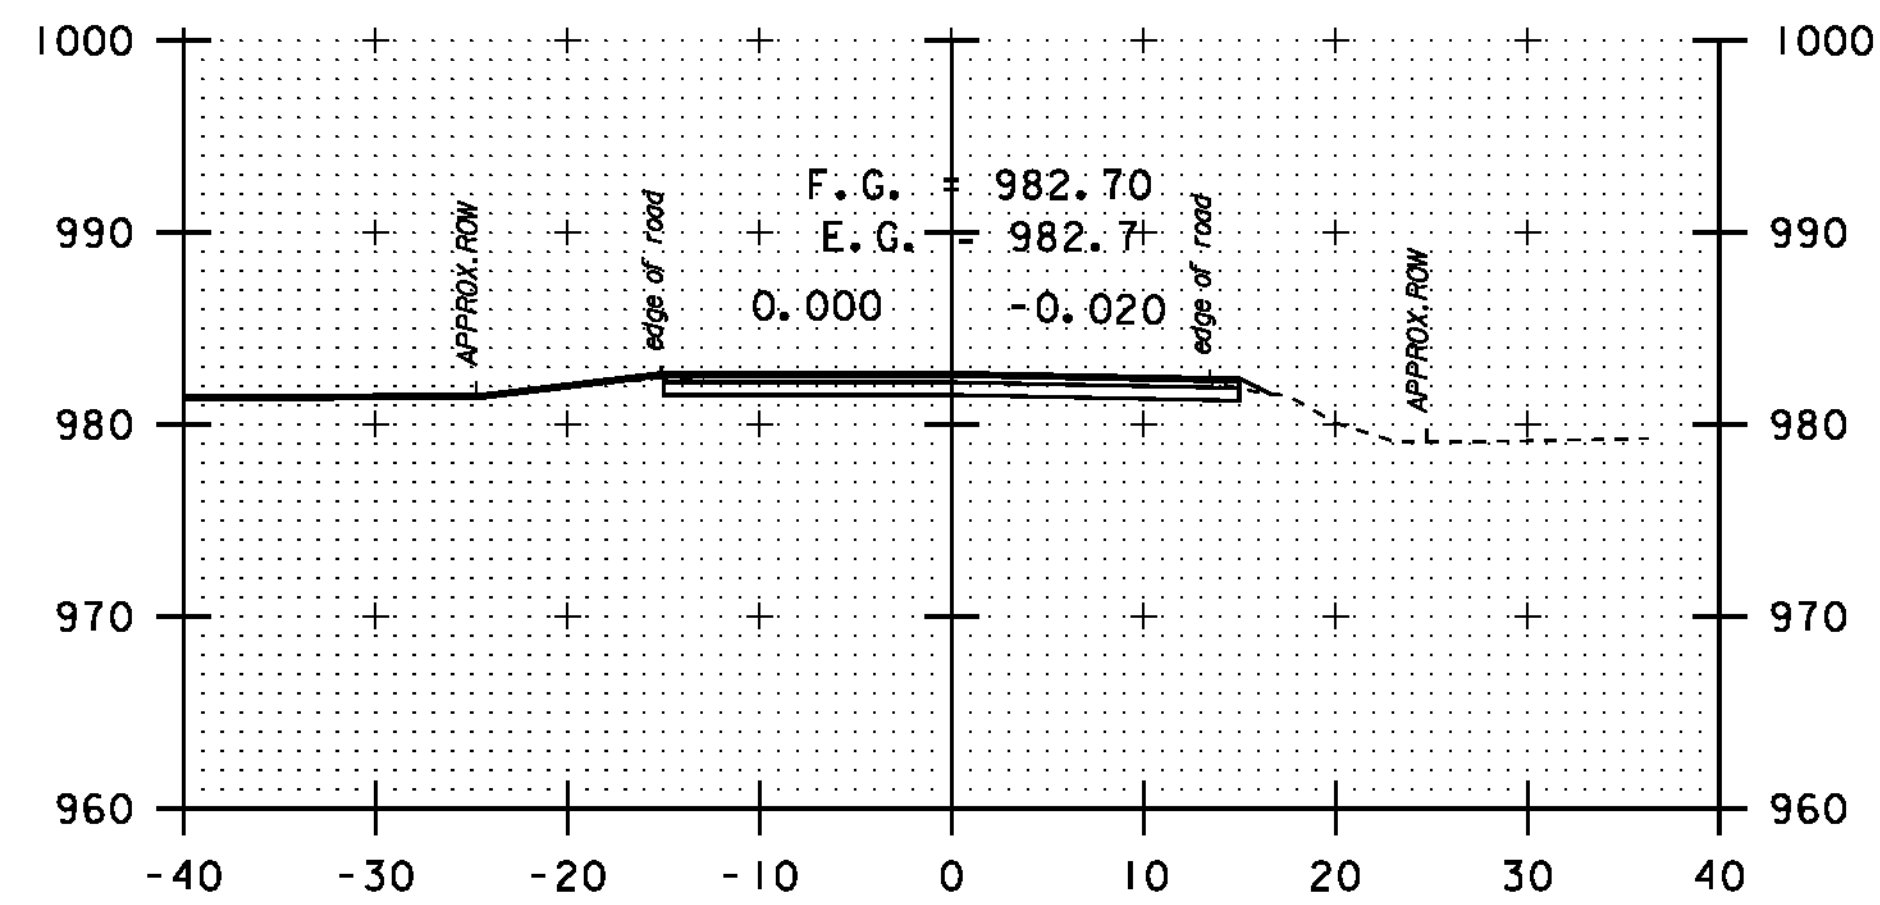


54+60

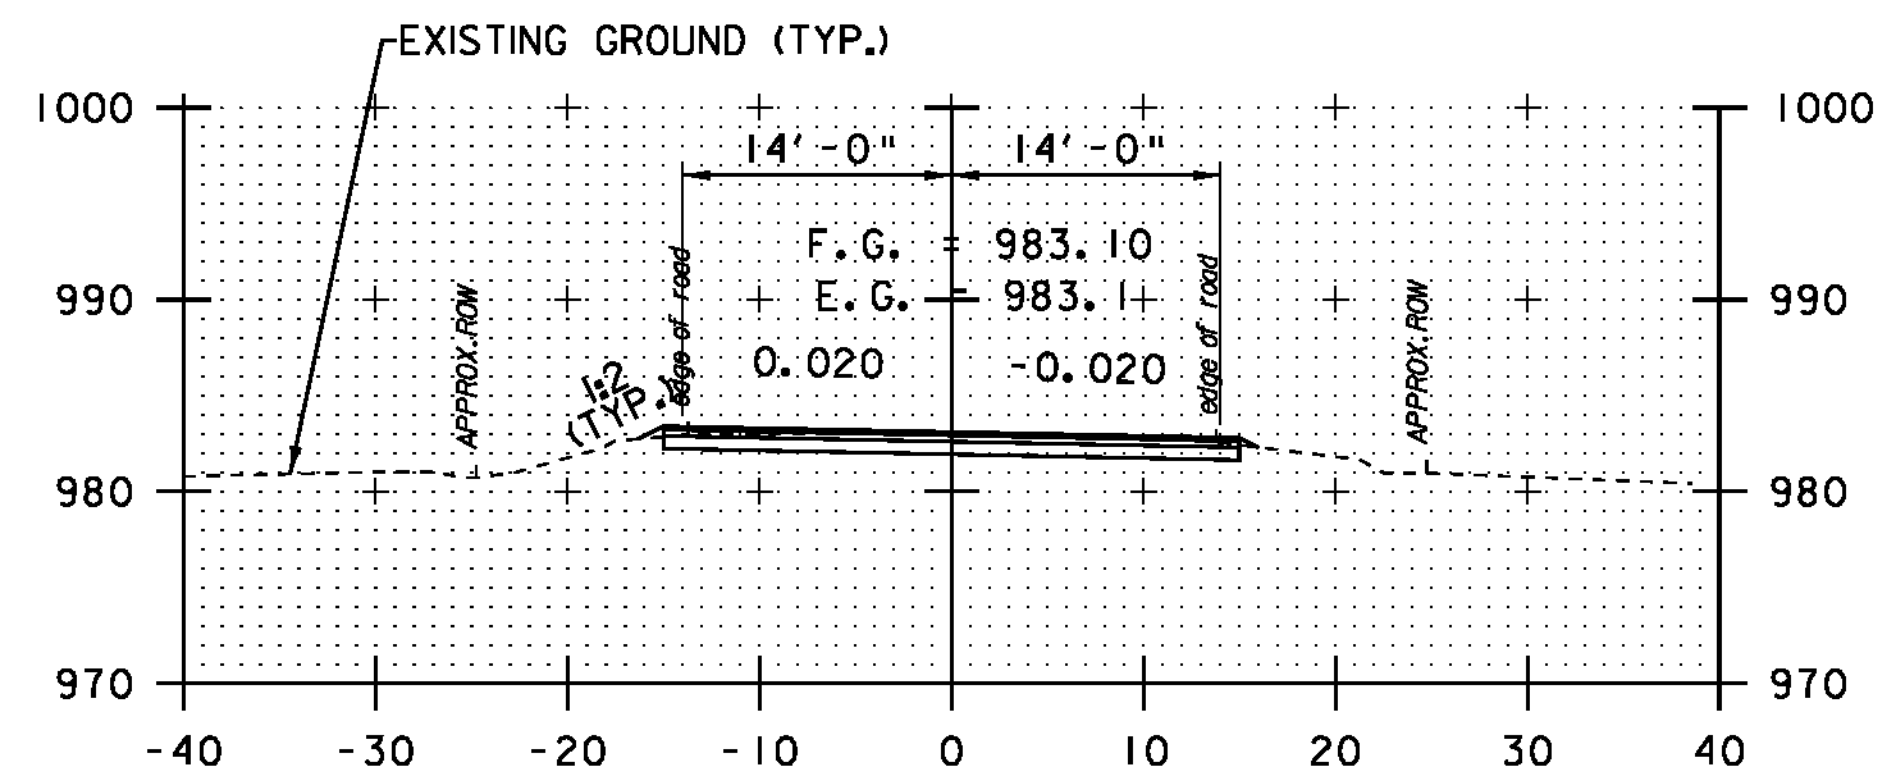

54+13

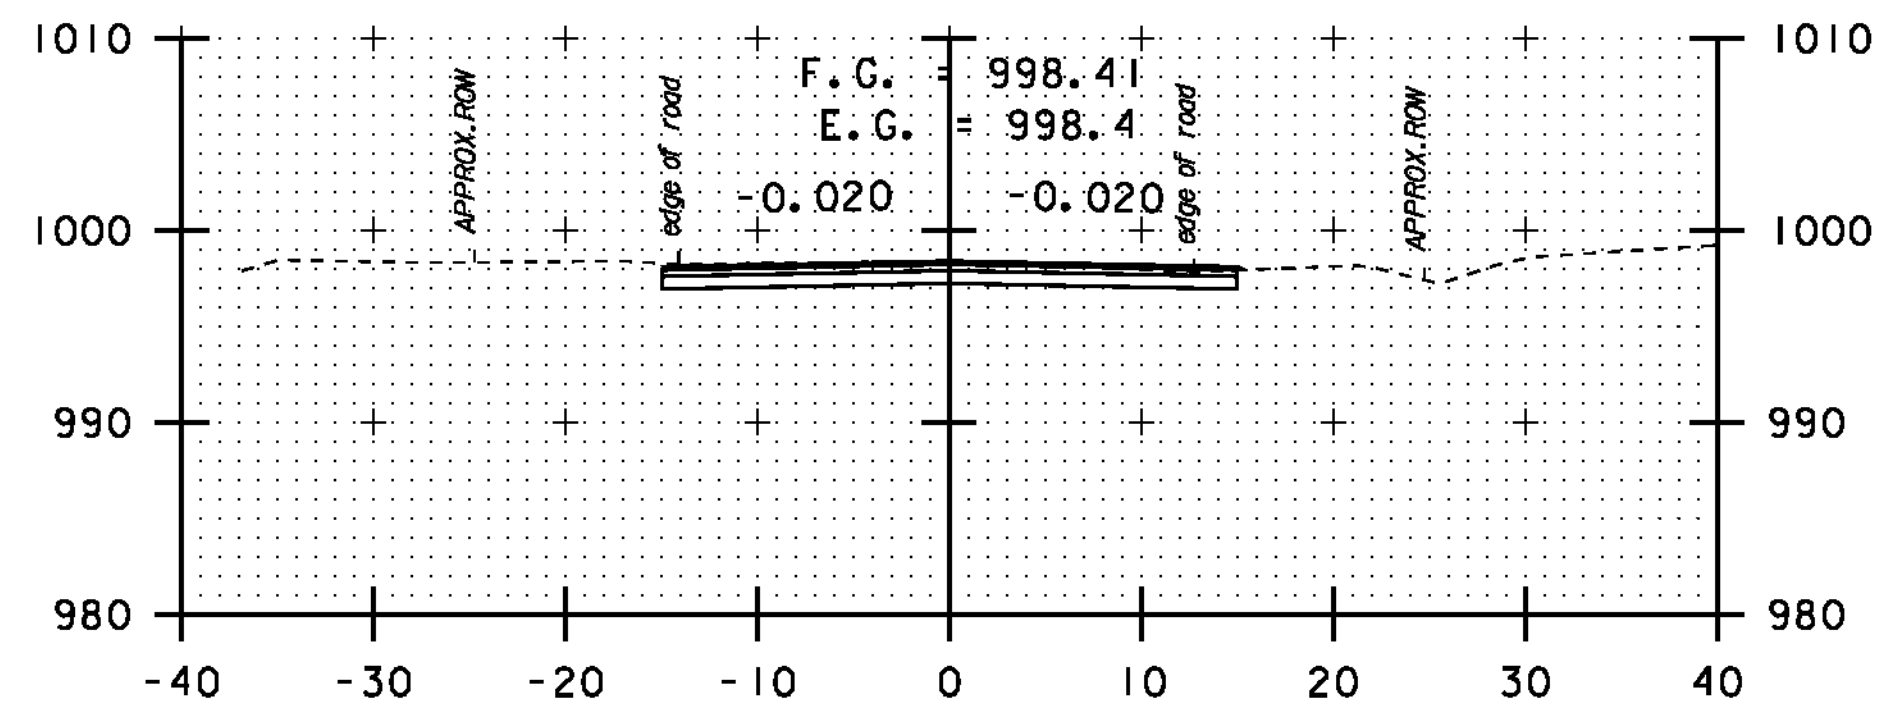

59+30

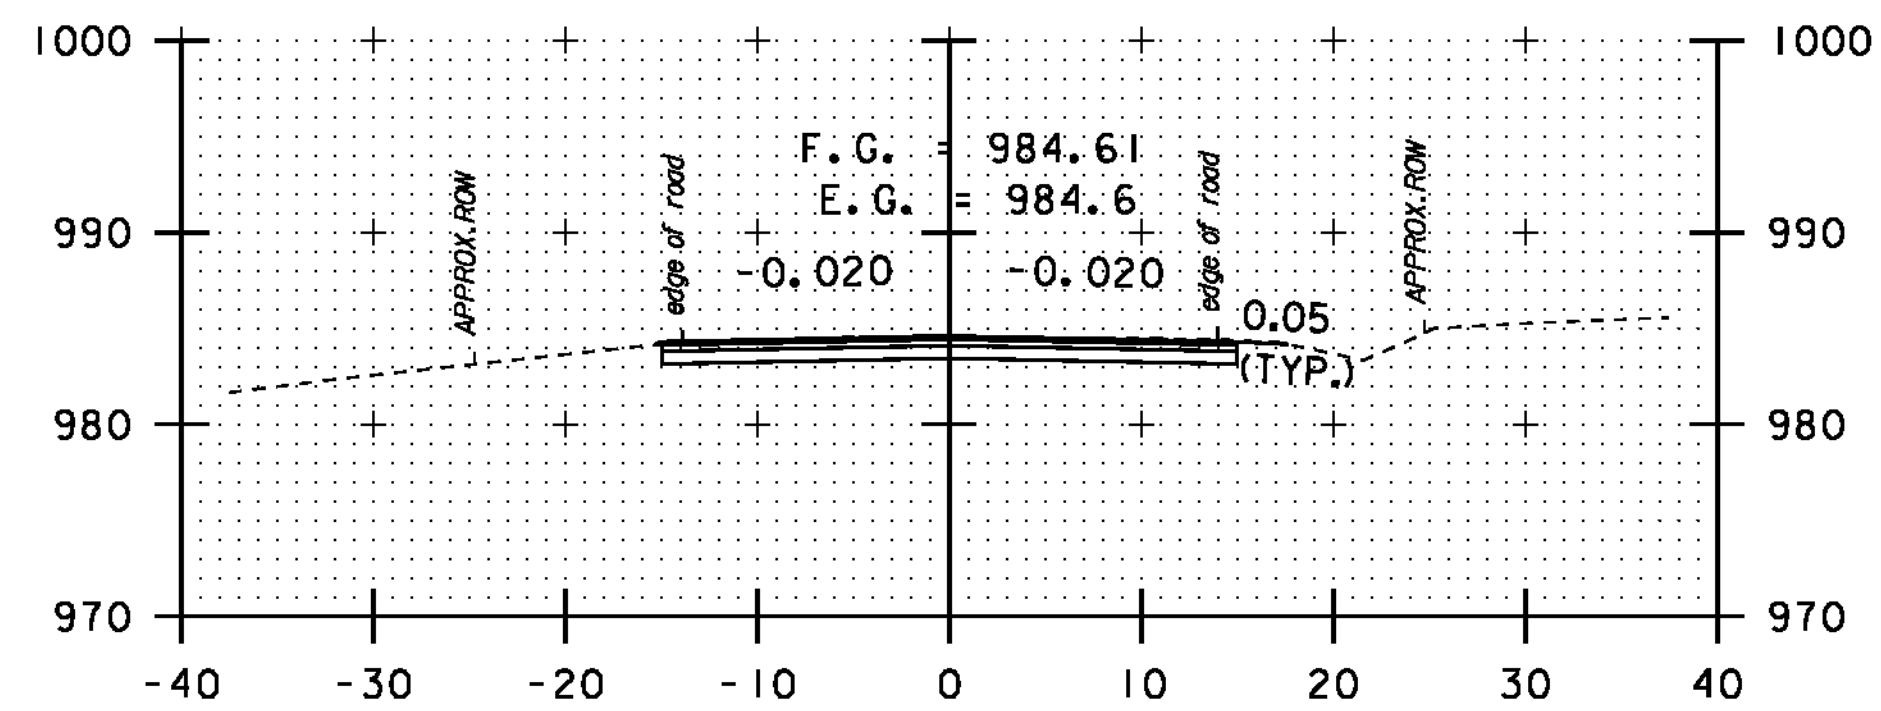

56+00

DATUM	NAVD 88
	NAD 83



STA. 54+13  
-  
STA. 59+30

CROSS  
SECTION  
SHEET 33

PROJECT NAME:	NEWPORT-COVENTRY-NEWPORT
PROJECT NUMBER:	STP 2802 (I)
FILE NAME:	08bi58.dgn
PROJECT LEADER:	CDL
DESIGNED BY:	BMB
PLOT FILE:	08bi58-106.1
PLOT DATE:	8/3/2011
DRAWN BY:	BMB
CHECKED BY:	EPD
SHEET	106 OF 134