




278+40

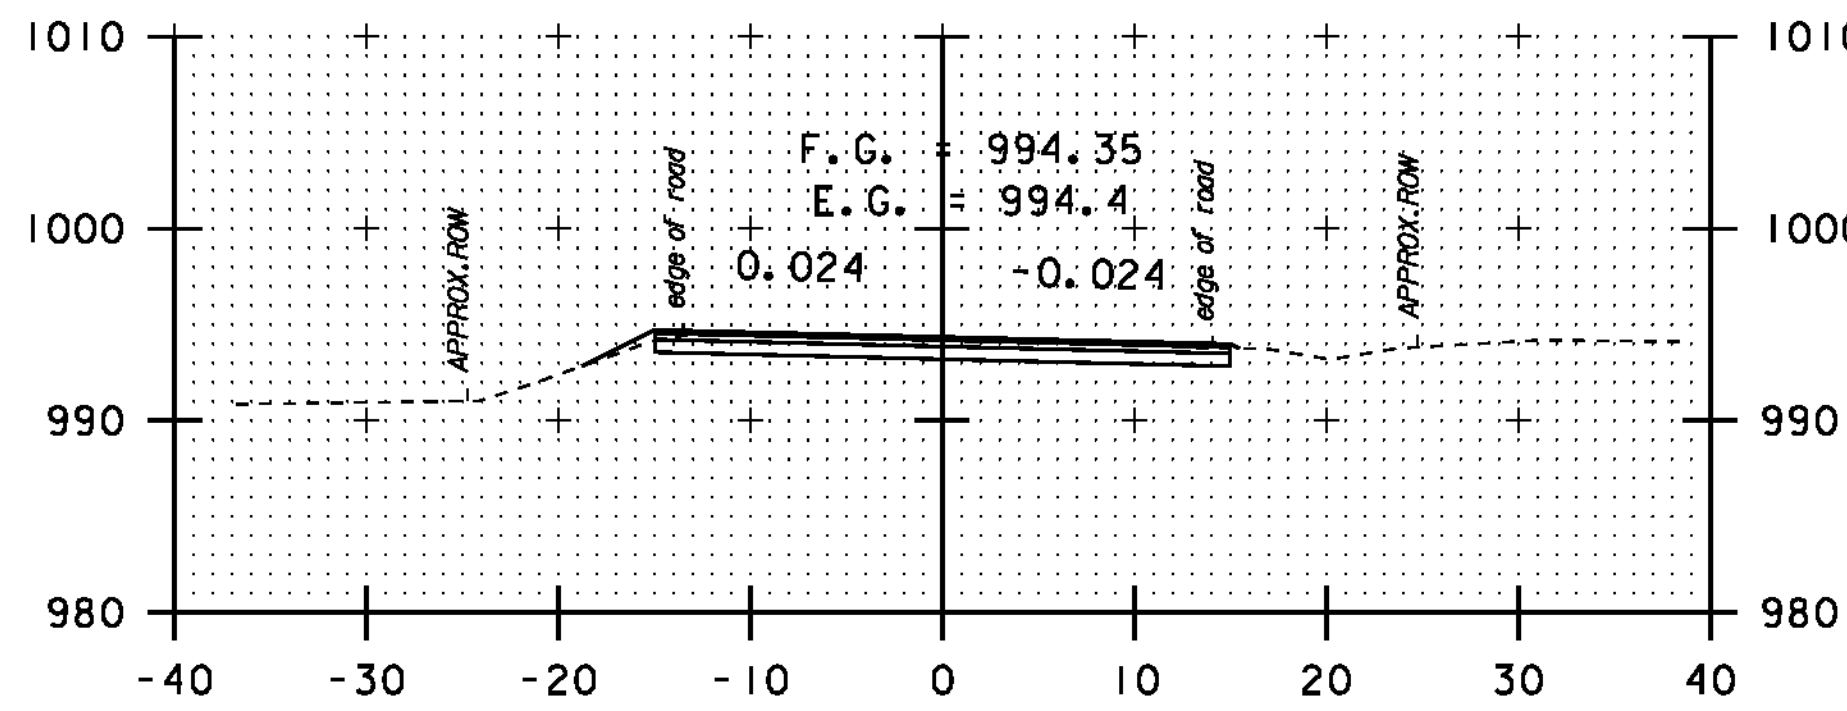


280+90

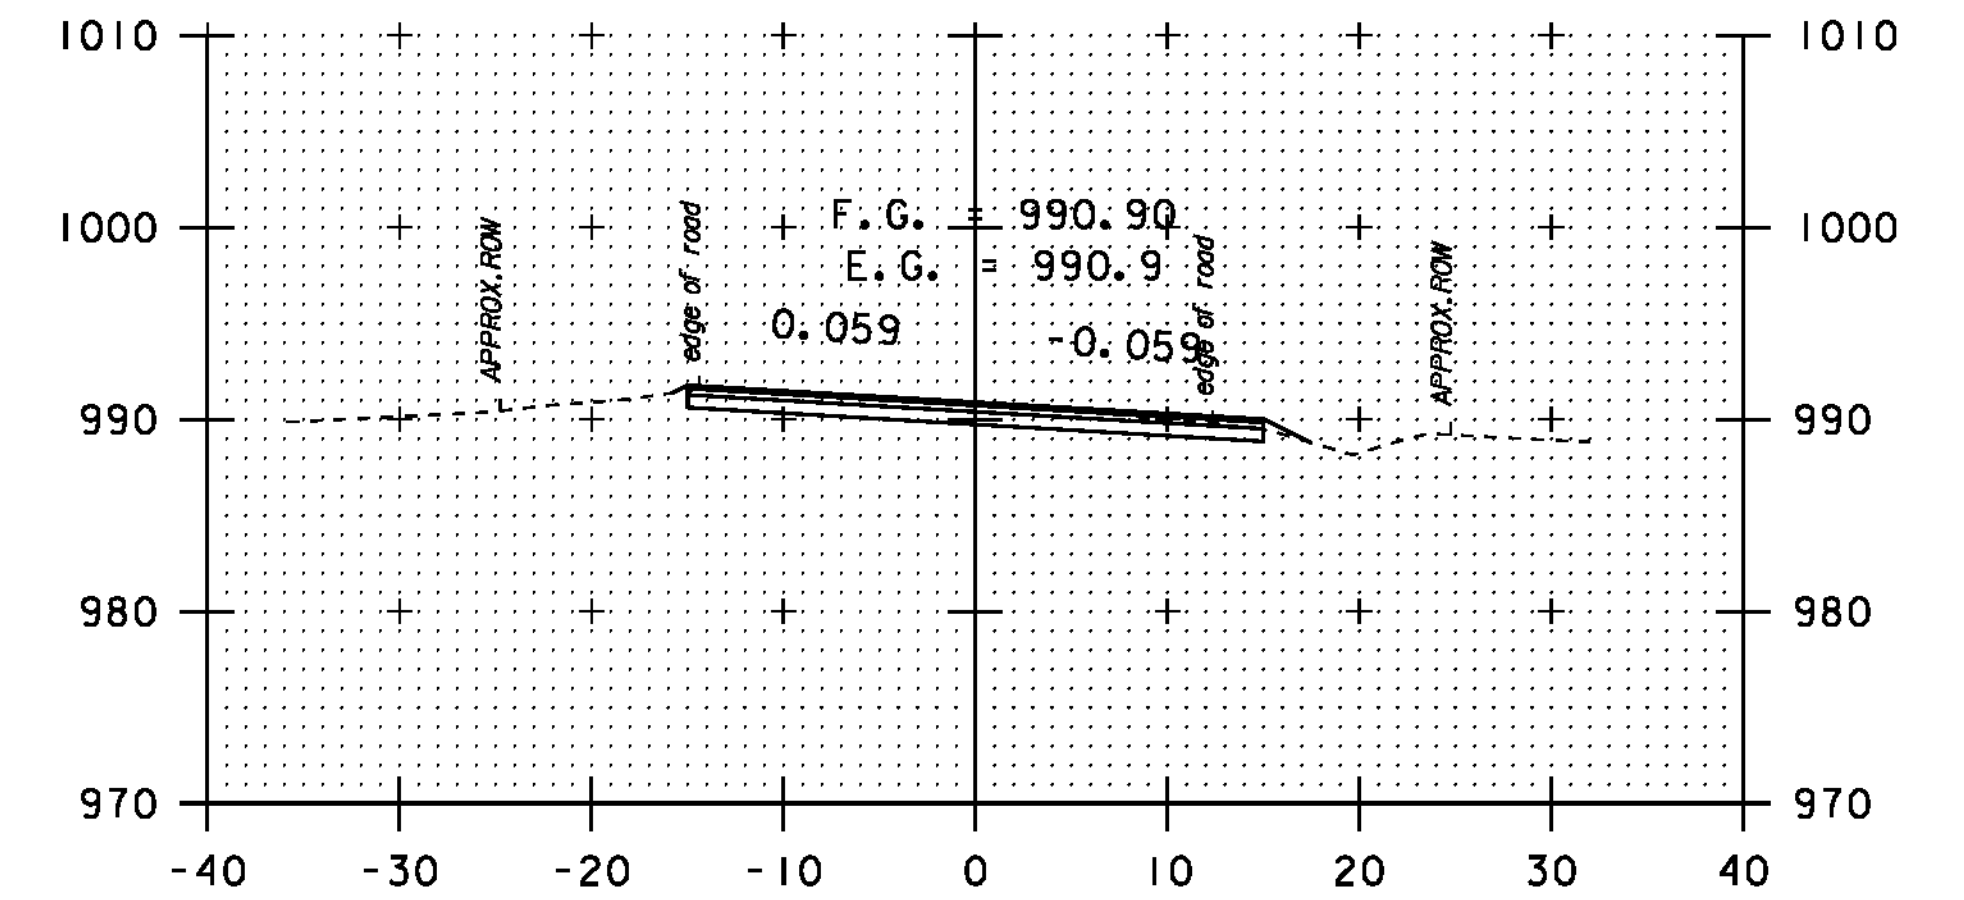


282+70

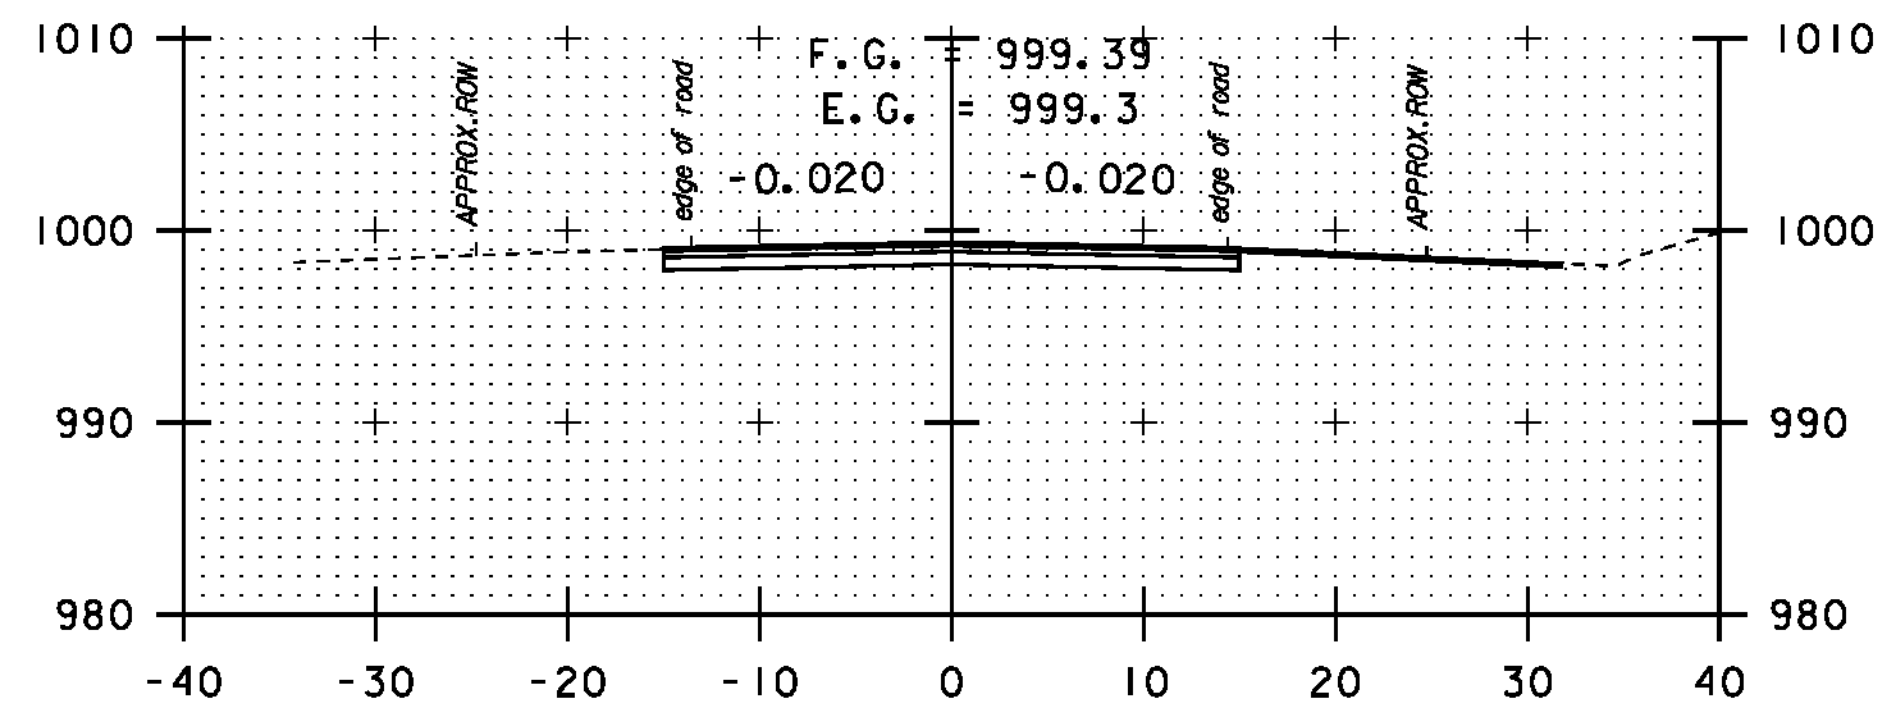


278+00

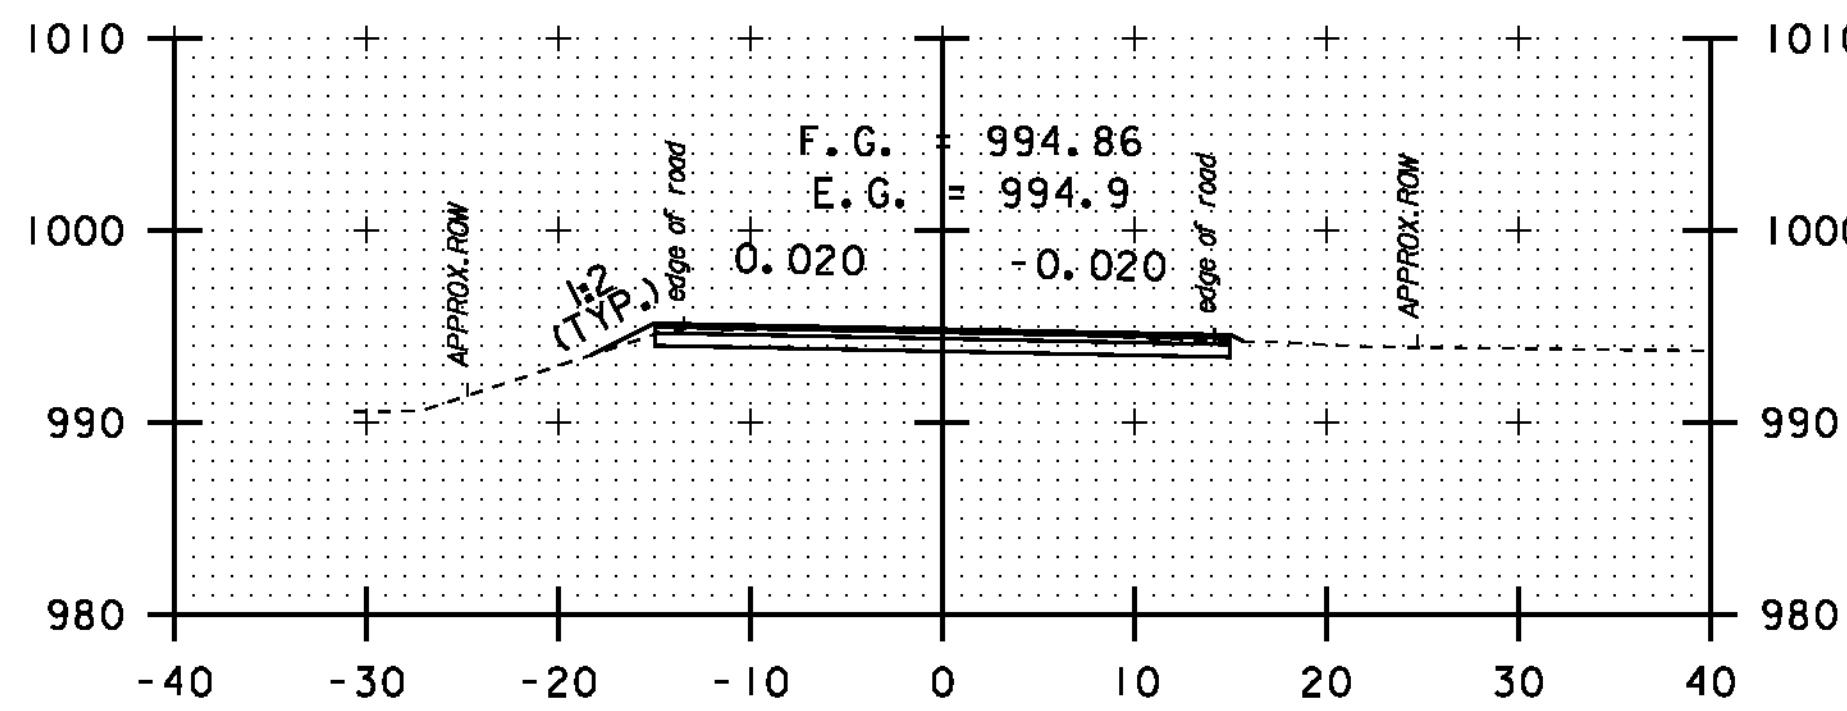


280+63

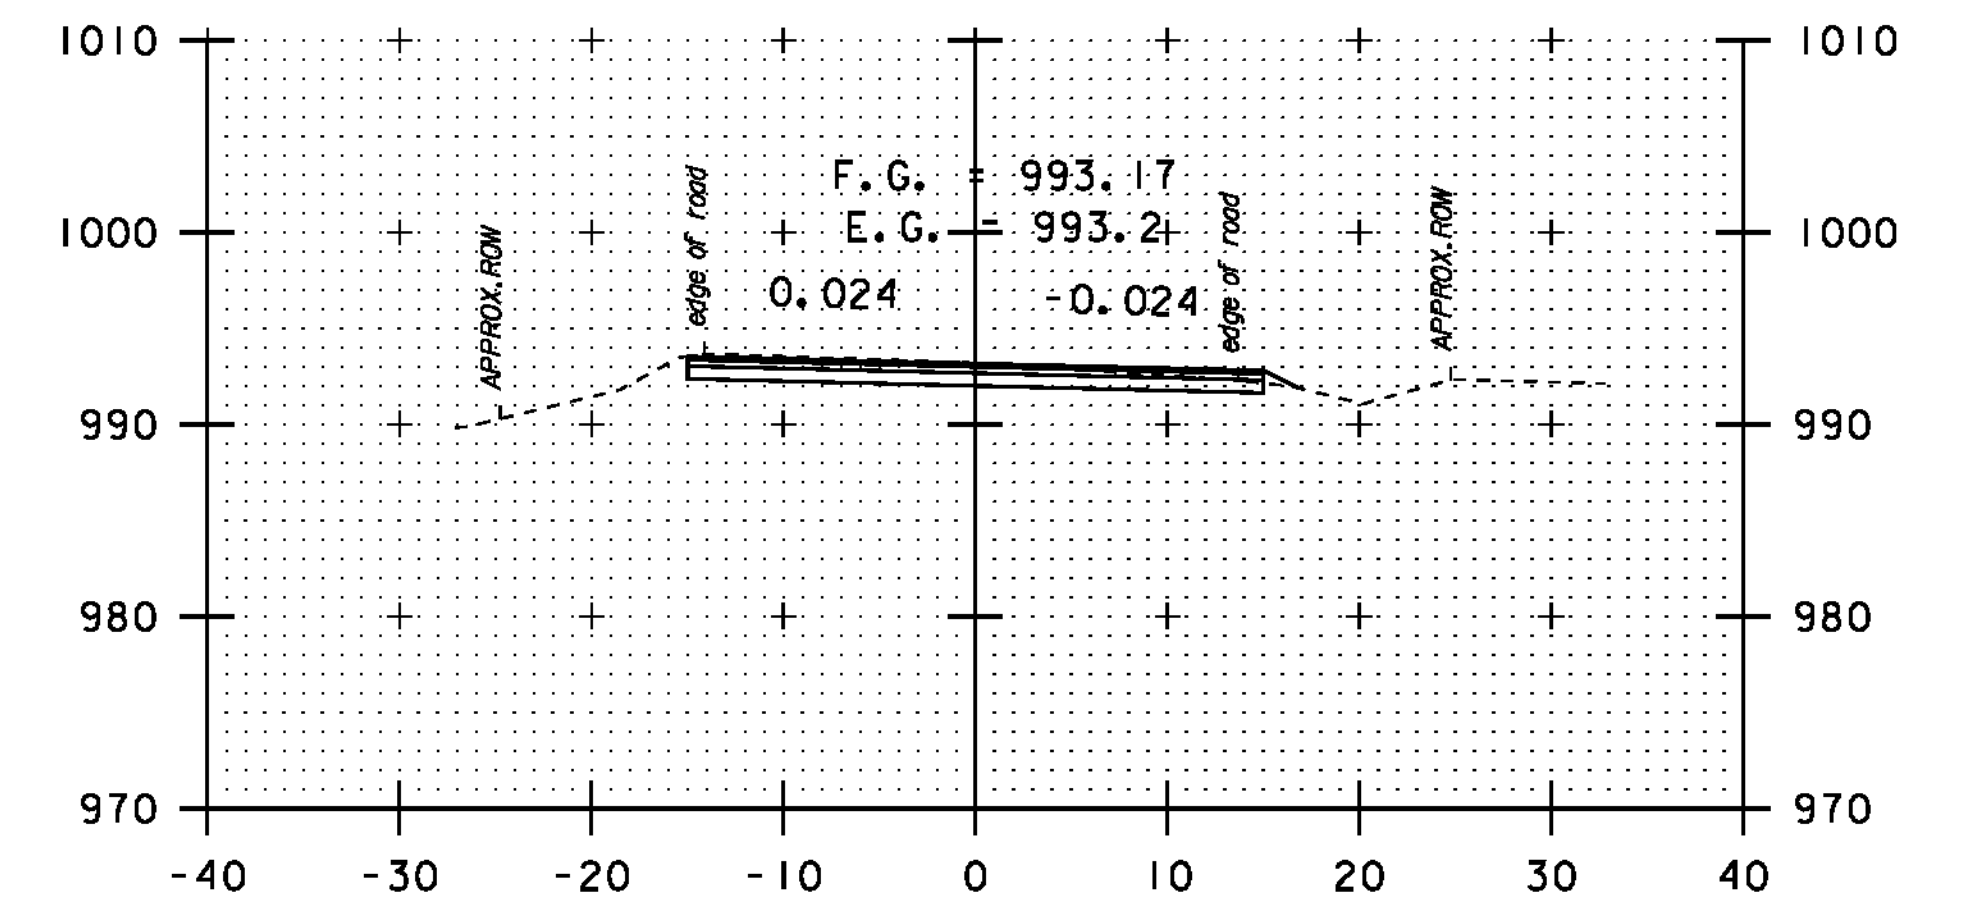


281+50

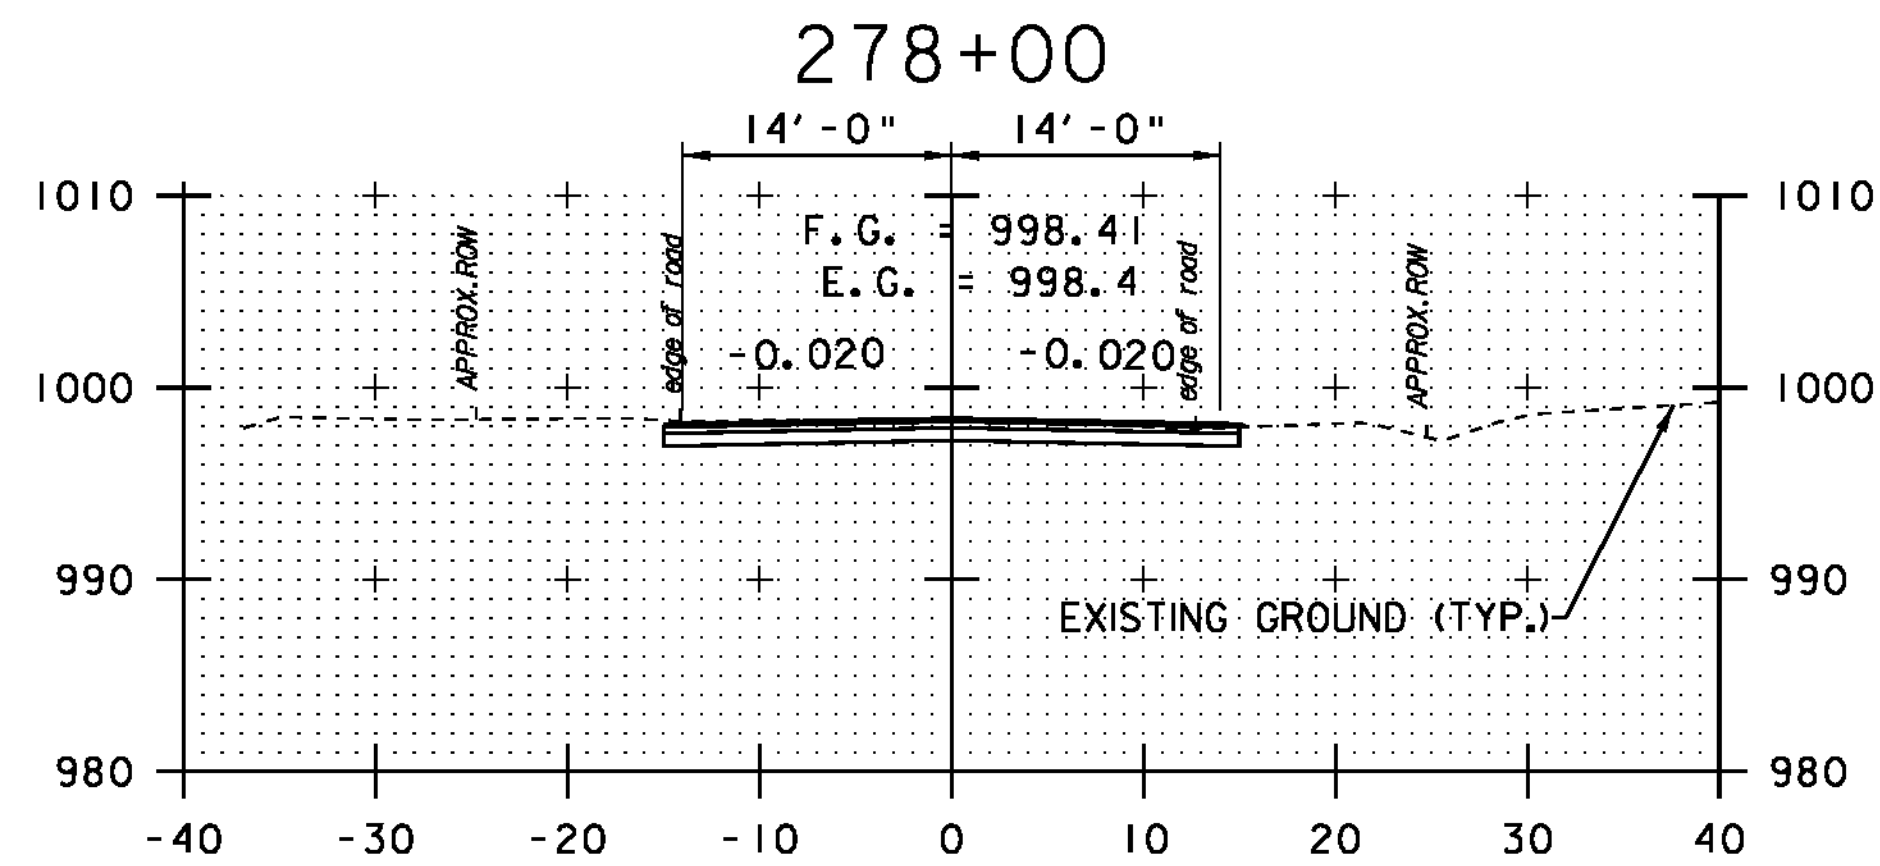

276+66

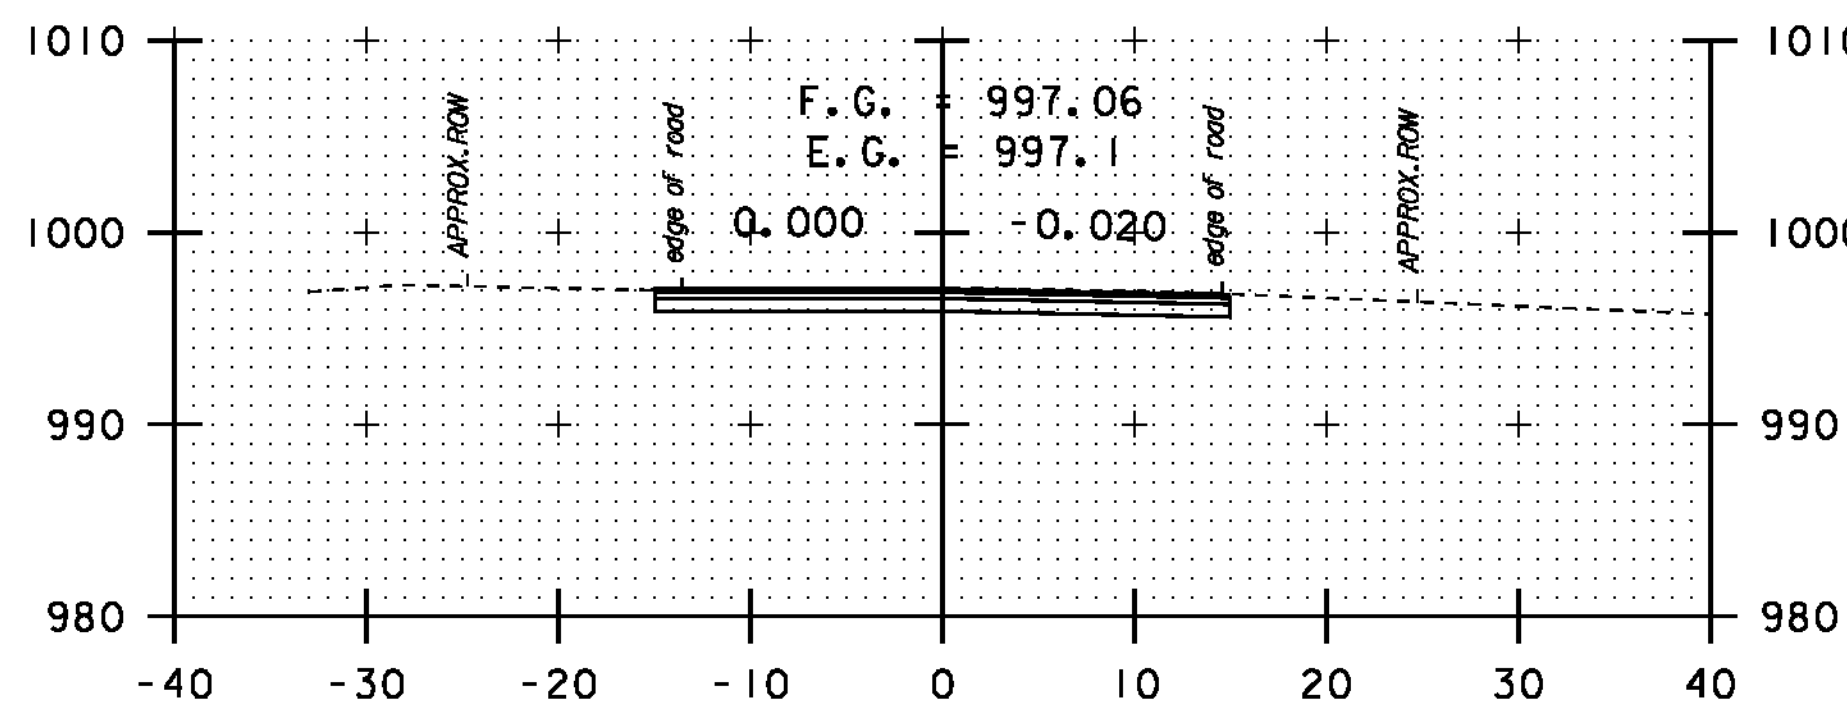

279+40

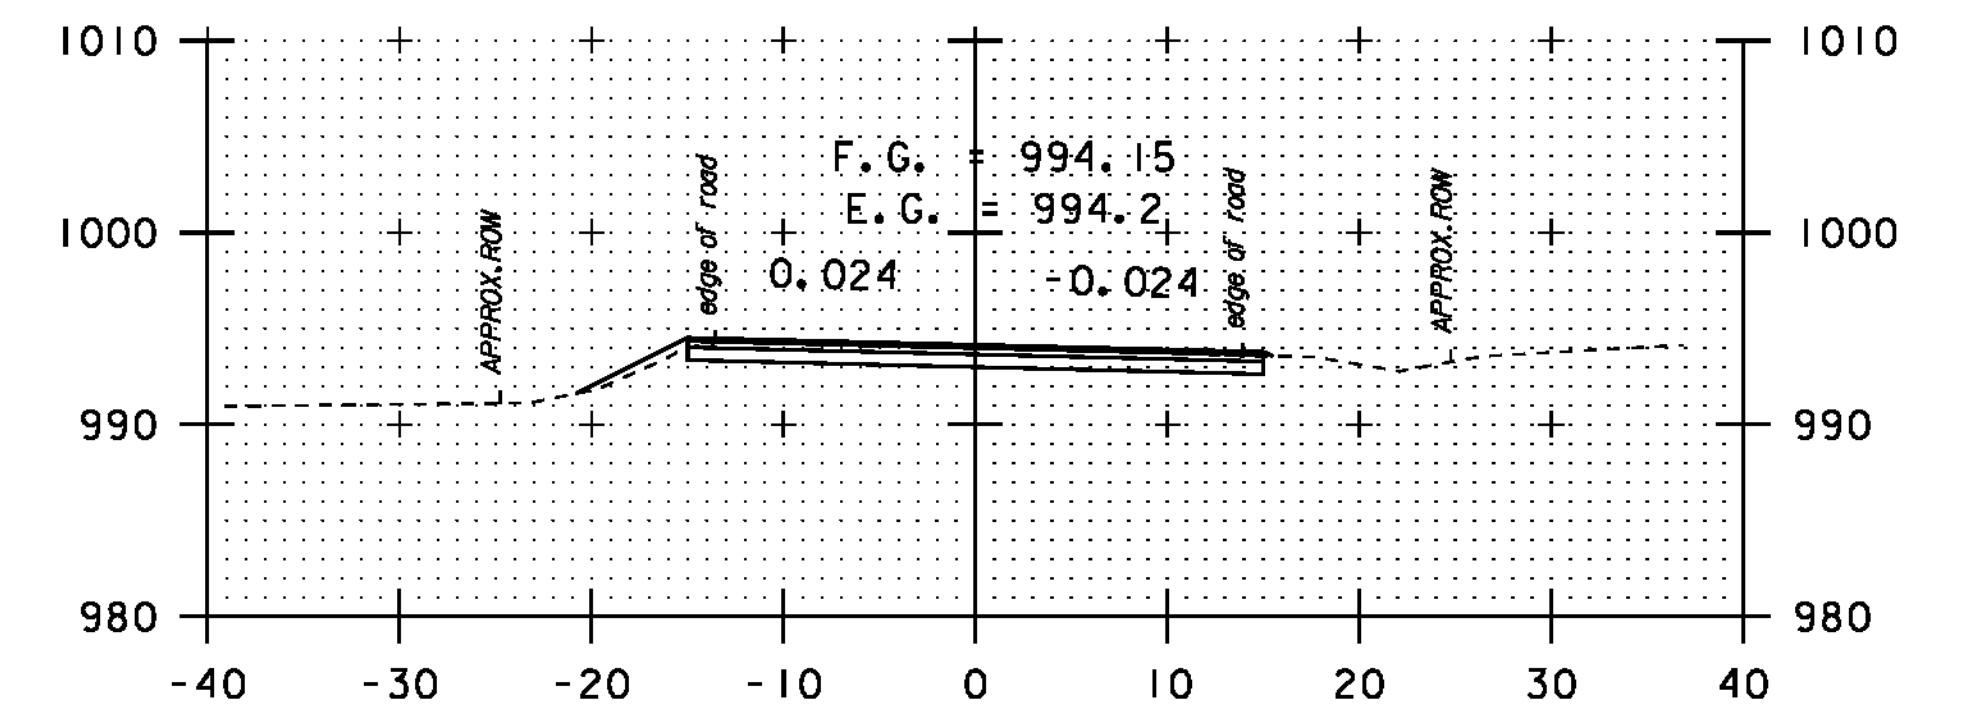

281+00

DATUM	NAVD 88
	NAD 83



**STA. 276+66**  
-  
**STA. 282+70**

**CROSS SECTION SHEET 34**

PROJECT NAME:	NEWPORT-COVENTRY-NEWPORT
PROJECT NUMBER:	STP 2802 (I)
FILE NAME:	08b158.dgn
PROJECT LEADER:	CDL
DESIGNED BY:	BMB
PLOT FILE:	08b158-107.1
PLOT DATE:	8/3/2011
DRAWN BY:	BMB
CHECKED BY:	EPD
SHEET	107 OF 134