




284+00

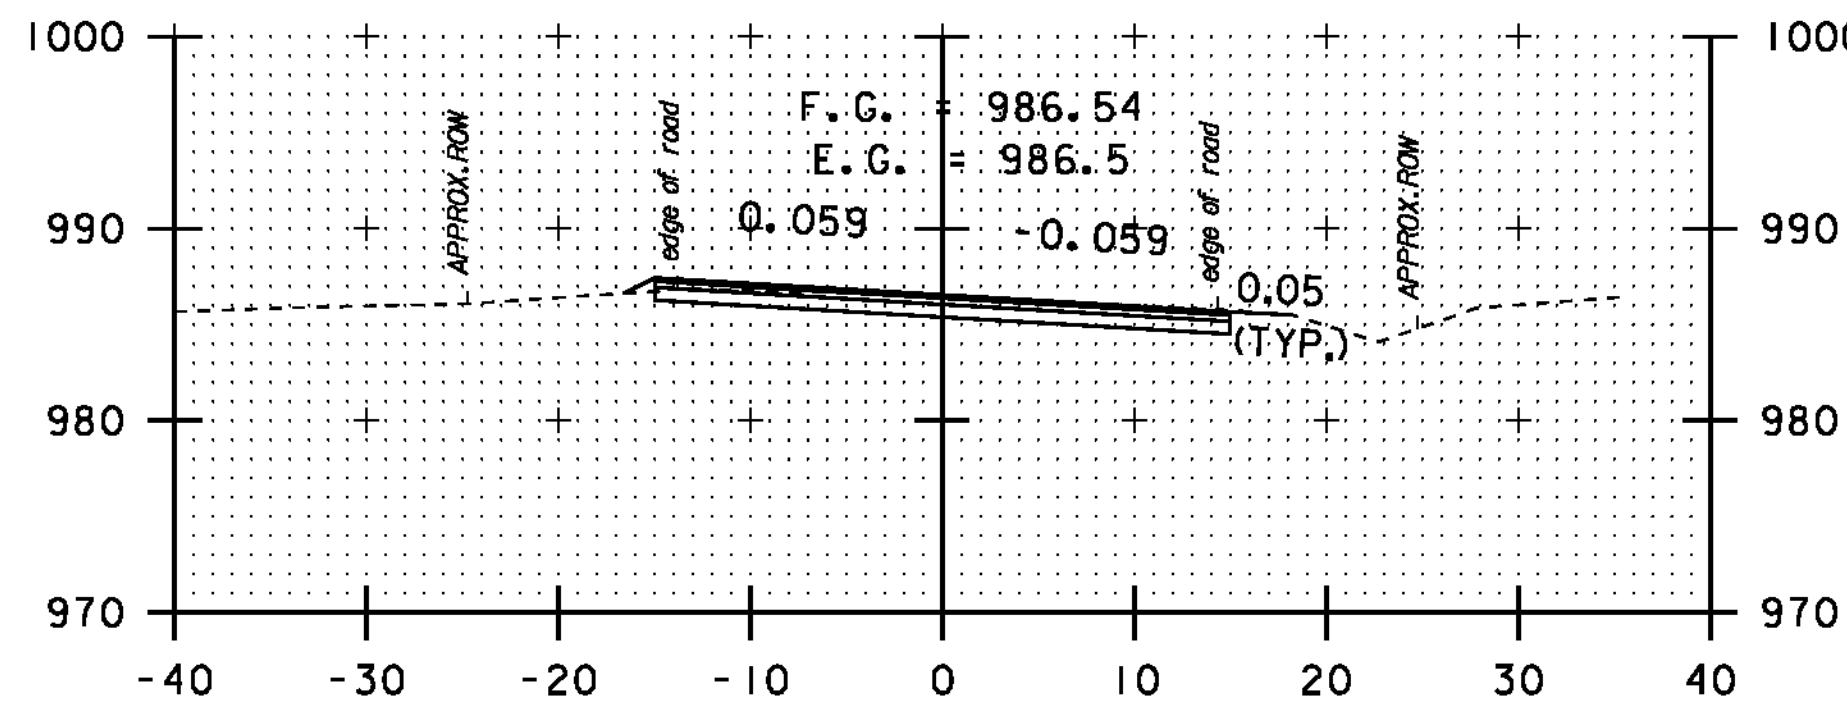


285+50

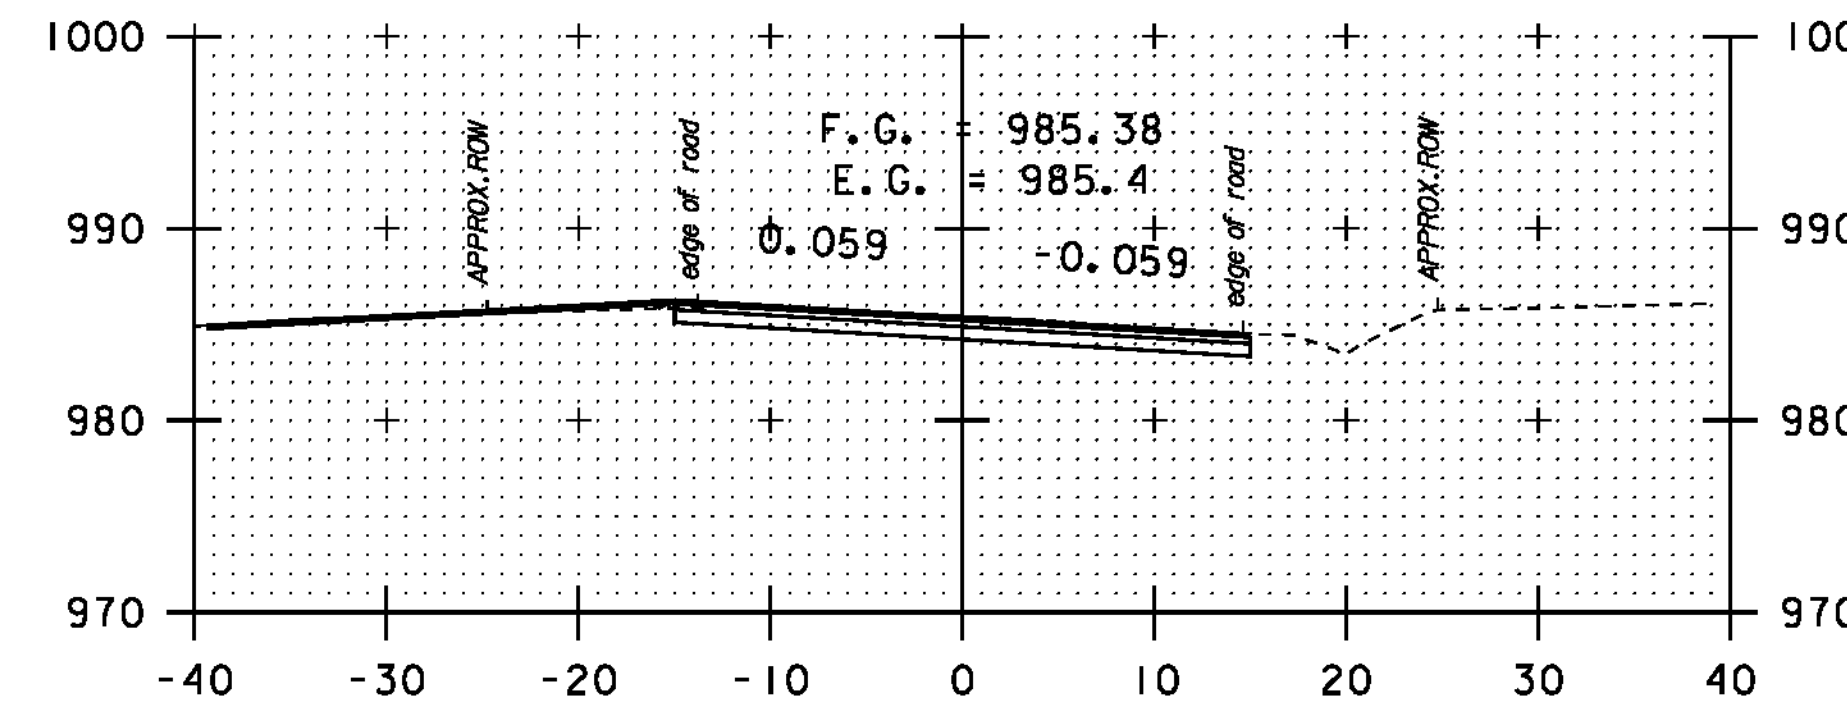


287+00

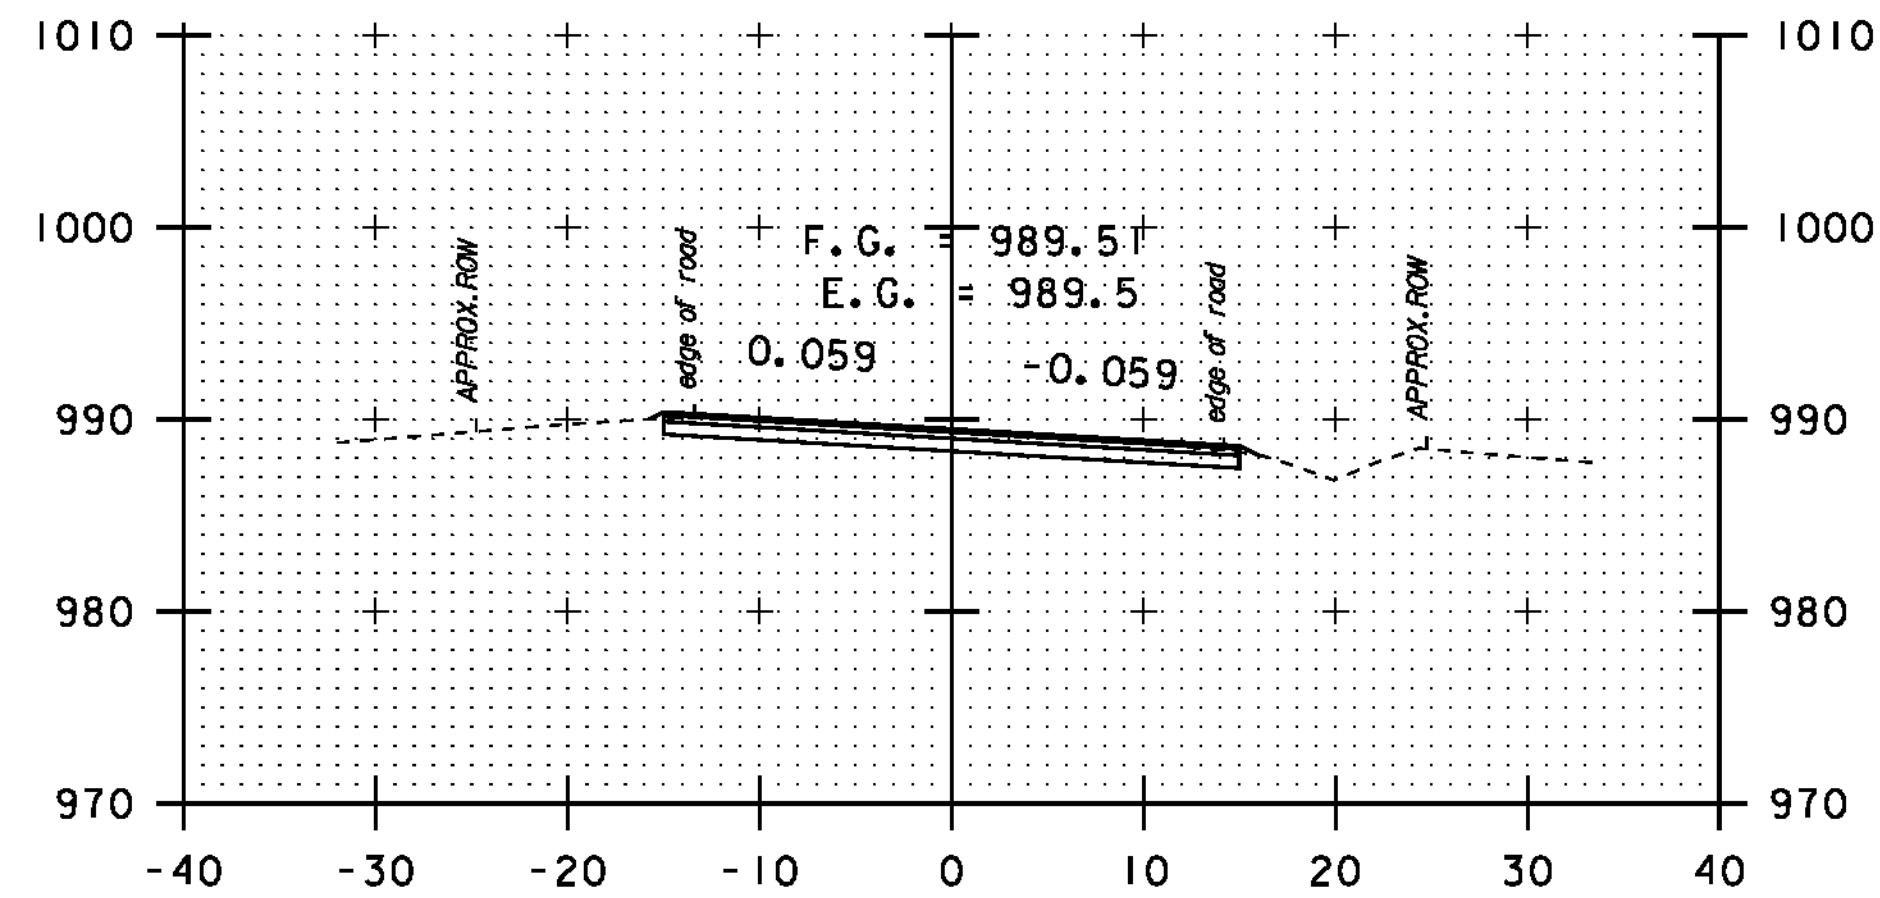


283+50

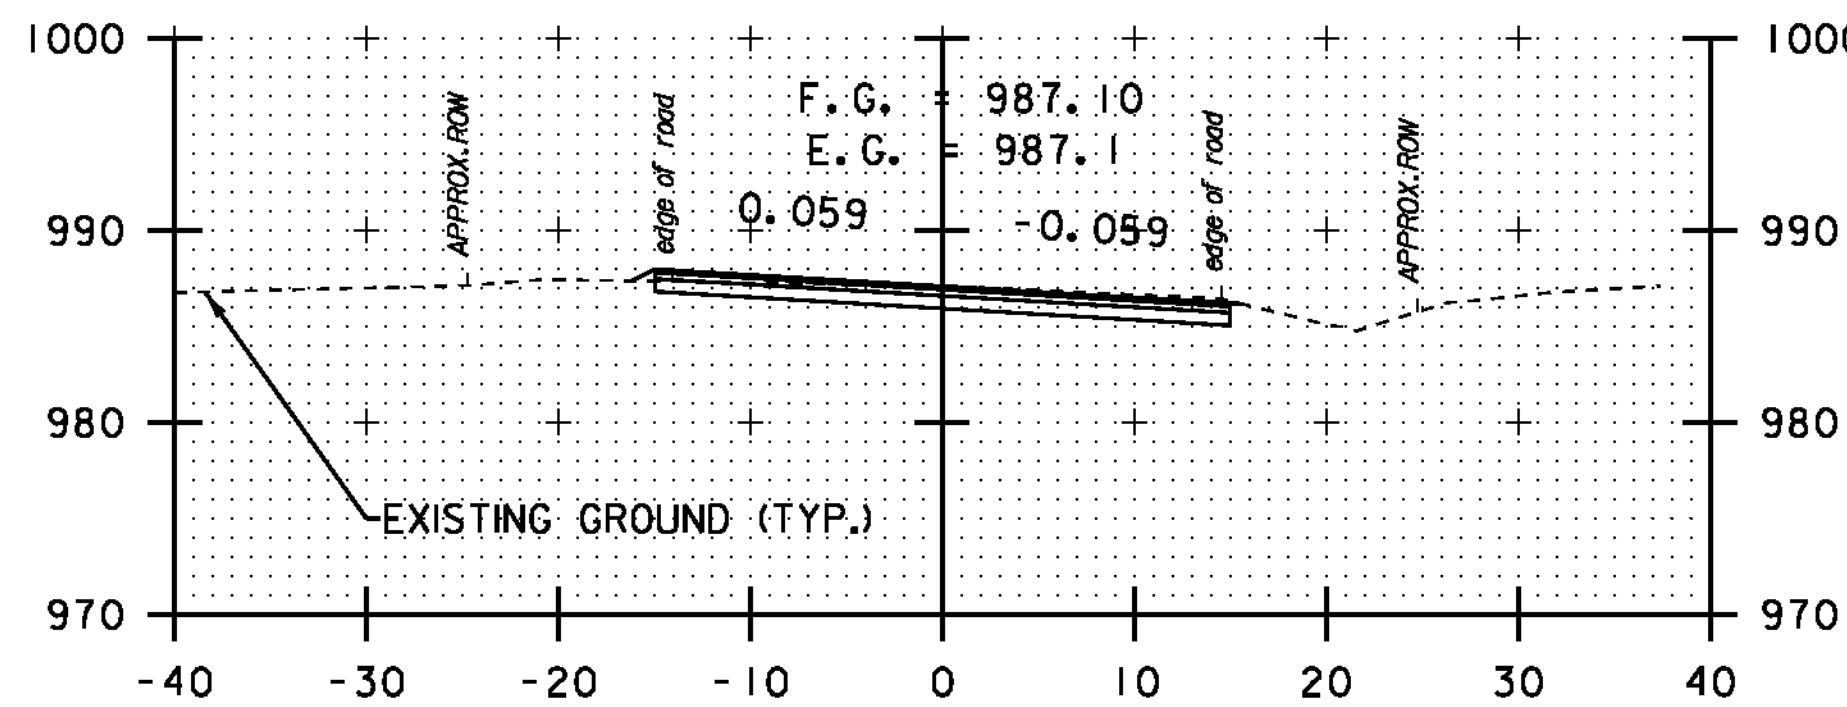


285+00

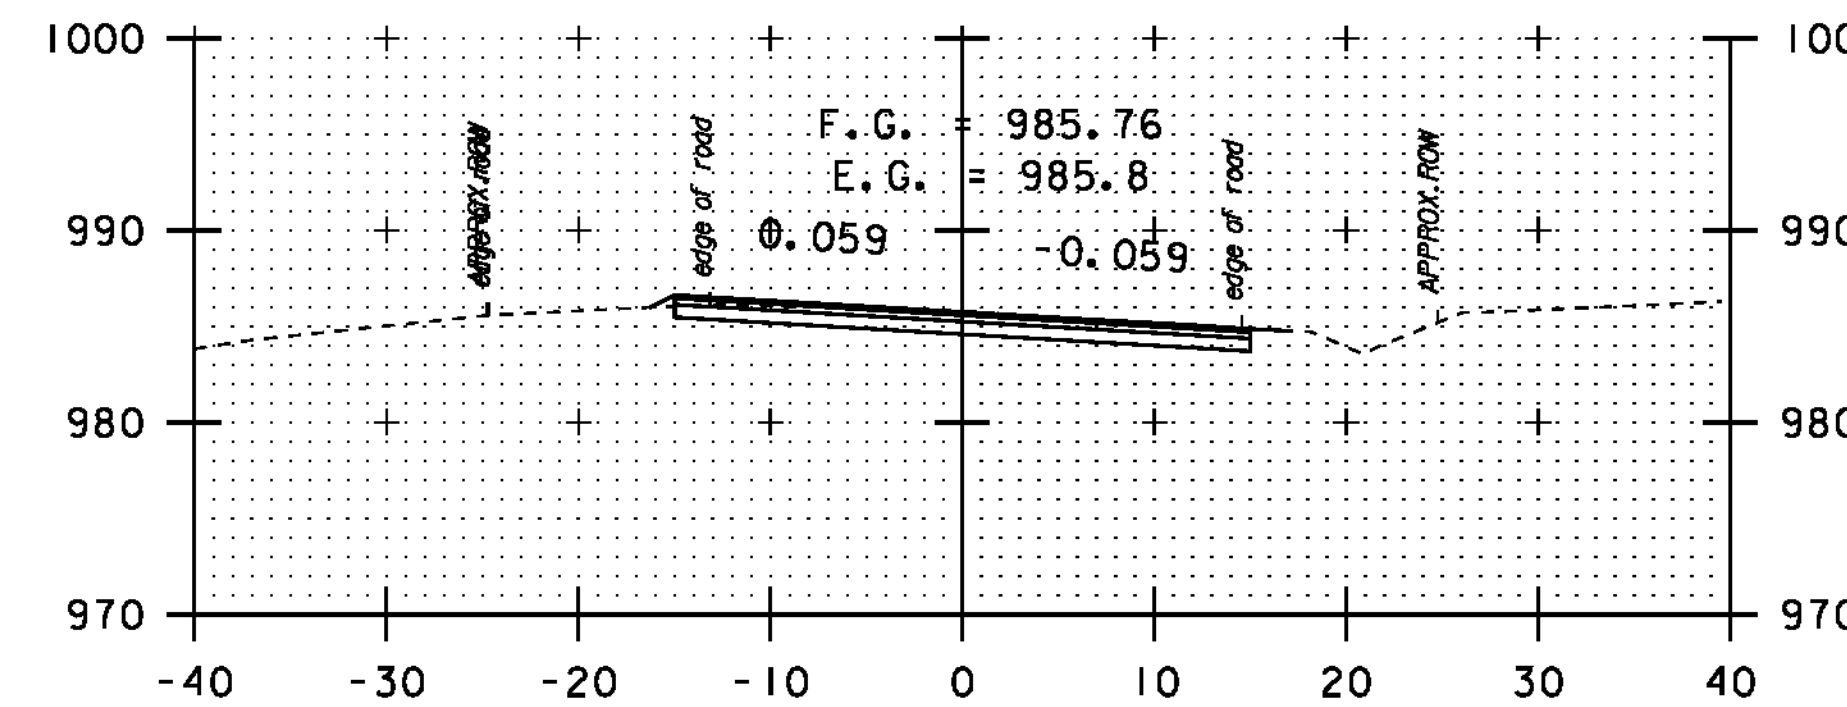


286+50

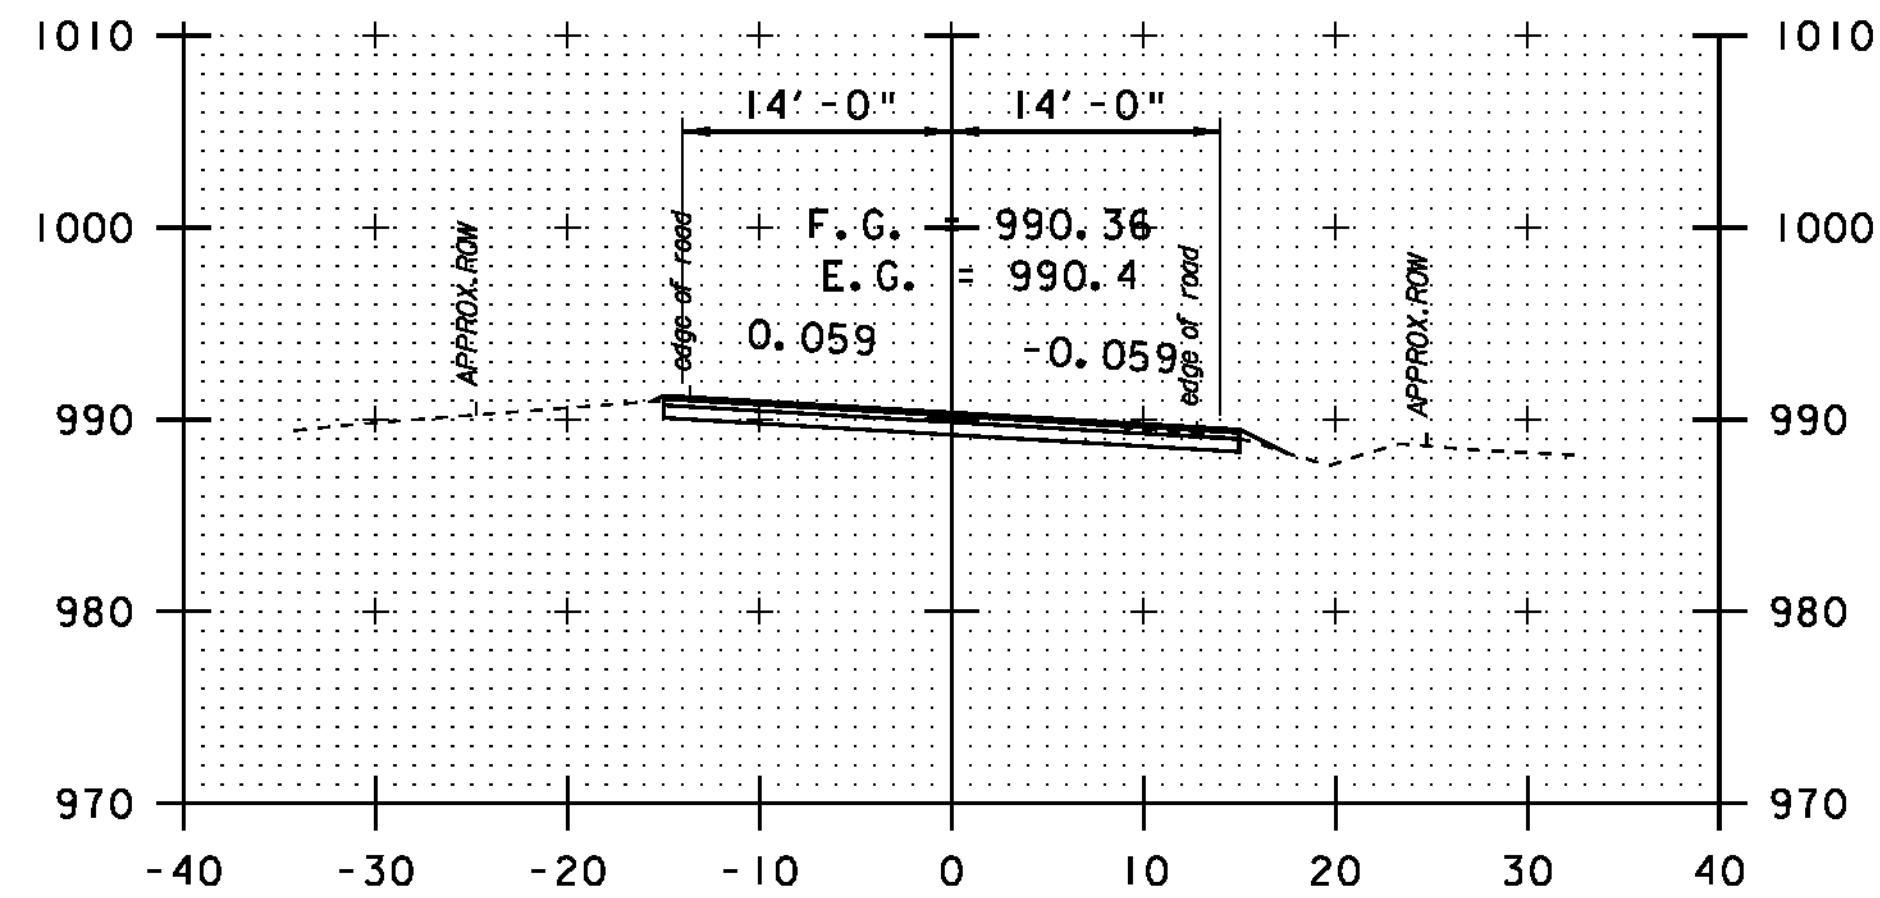

283+00

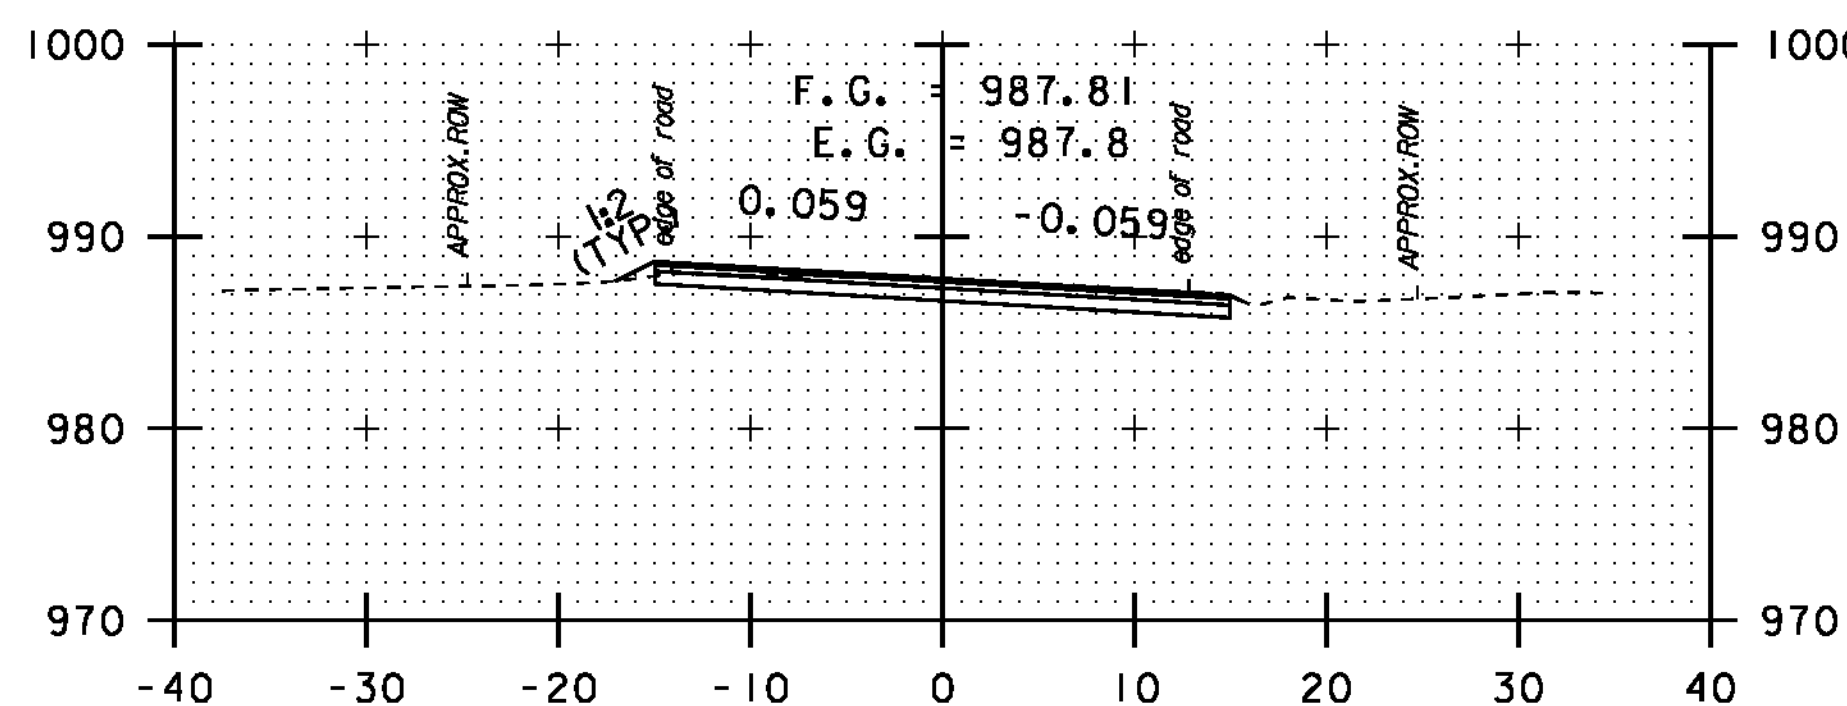

284+50

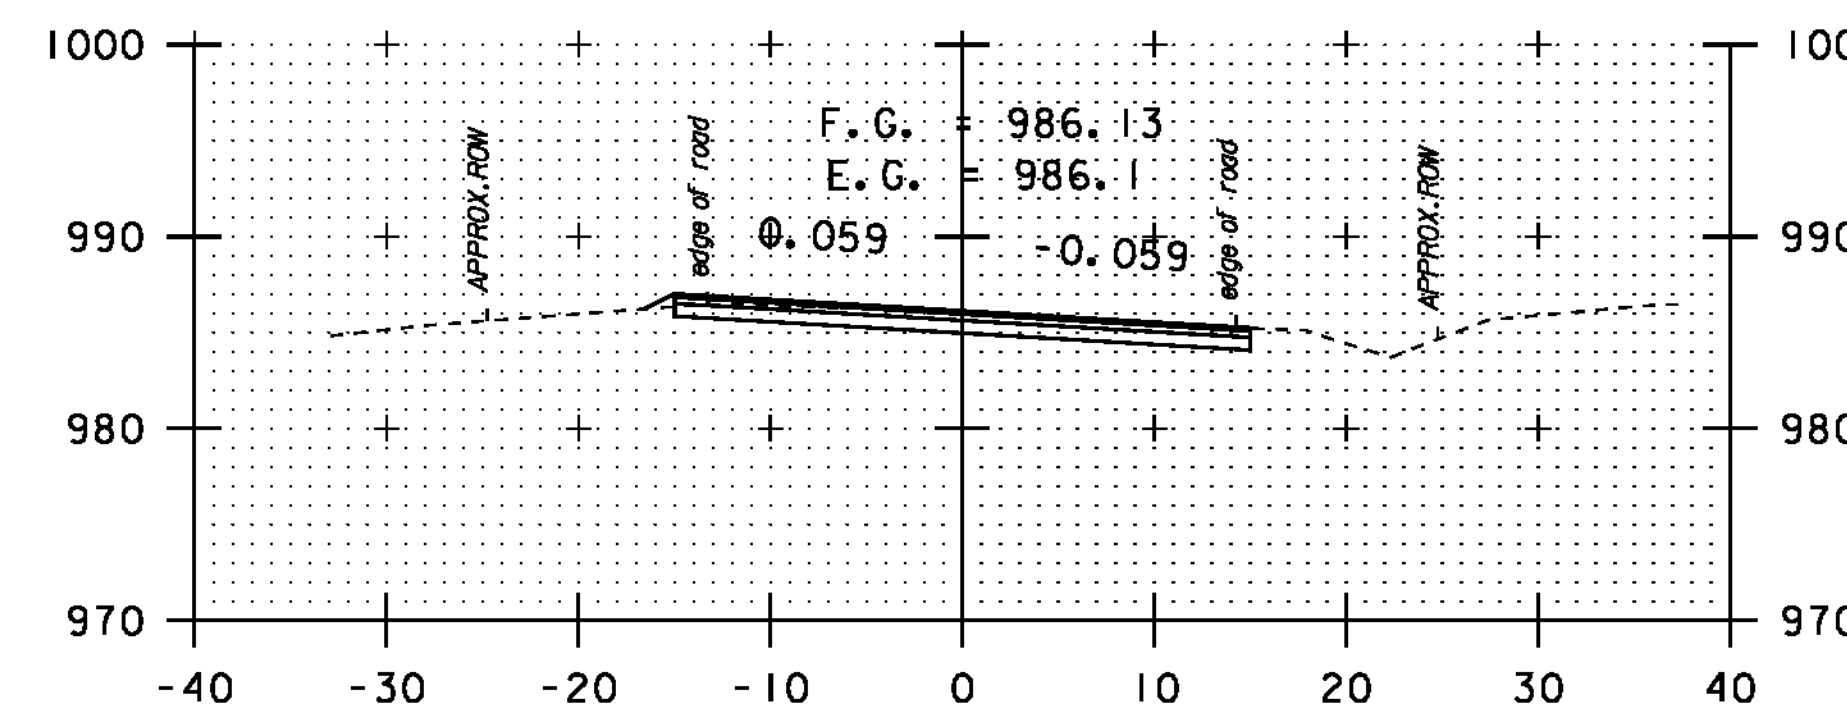

286+00

|       |         |
|-------|---------|
| DATUM | NAVD 88 |
|       | NAD 83  |



**STA. 283+00**  
-  
**STA. 287+00**

**CROSS SECTION SHEET 35**

|                 |                          |
|-----------------|--------------------------|
| PROJECT NAME:   | NEWPORT-COVENTRY-NEWPORT |
| PROJECT NUMBER: | STP 2802 (I)             |
| FILE NAME:      | 08b158.dgn               |
| PROJECT LEADER: | CDL                      |
| DESIGNED BY:    | BMB                      |
| PLOT FILE:      | 08b158-108.1             |
| PLOT DATE:      | 8/3/2011                 |
| DRAWN BY:       | BMB                      |
| CHECKED BY:     | EPD                      |
| SHEET           | 108 OF 134               |