

INDEX OF SHEETS

- 1 TITLE SHEET
- 2-3 PROJECT NOTES
- 4 TYPICAL SECTIONS AND DETAILS
- 5-6 QUANTITY SHEETS
- 7 LAYOUT
- 8 CULVERT PROFILE
- 9 EPSC NARRATIVE
- 10 EPSC EXISTING CONDITIONS SITE PLAN
- 11 EPSC CONSTRUCTION SITE PLAN
- 12 EPSC FINAL CONDITIONS SITE PLAN
- 13-14 EPSC DETAIL SHEETS
- 15 TRAFFIC CONTROL SHEET
- 16 ROCK WEIR DETAILS
- 17-18 CRADLE WALL DETAILS
- 19 REINFORCING STEEL SCHEDULE
- 20-21 CHANNEL CROSS SECTIONS

VAOT STANDARDS FOR CONSTRUCTION

| | |
|--------|----------|
| E-100 | 01/02/04 |
| E-100A | 01/02/04 |
| E-101 | 05/30/03 |
| E-102 | 06/30/03 |
| E-102A | 05/01/04 |
| E-106 | 03/01/04 |
| E-107 | 06/30/03 |
| E-107A | 06/08/09 |
| E-110 | 08/08/95 |
| E-120 | 08/08/95 |
| E-121 | 08/08/95 |
| E-140 | 08/30/96 |
| E-171A | 08/09/95 |
| E-172 | 08/09/95 |
| E-191 | 02/01/99 |
| G-1 | 01/03/00 |
| G-17A | 09/27/02 |
| G-17B | 09/27/02 |

TRAFFIC DATA


2008 AADT: 2600

STATE OF VERMONT
AGENCY OF TRANSPORTATION




PROPOSED IMPROVEMENT
CULVERT REHABILITATION PROJECT
TOWN OF WINHALL
COUNTY OF BENNINGTON
VERMONT ROUTE 30 (MINOR ARTERIAL)

PROJECT LOCATION: WORK TO BE PERFORMED ON VERMONT ROUTE 30, 5.4 MILES SOUTH OF JUNCTION WITH VERMONT ROUTE II.
PROJECT DESCRIPTION: THIS PROJECT INCLUDES CONCRETE INVERT REPAIR, INSTALLATION OF CRADLE WALLS AND CHANNEL AND EMBANKMENT STABILIZATION.

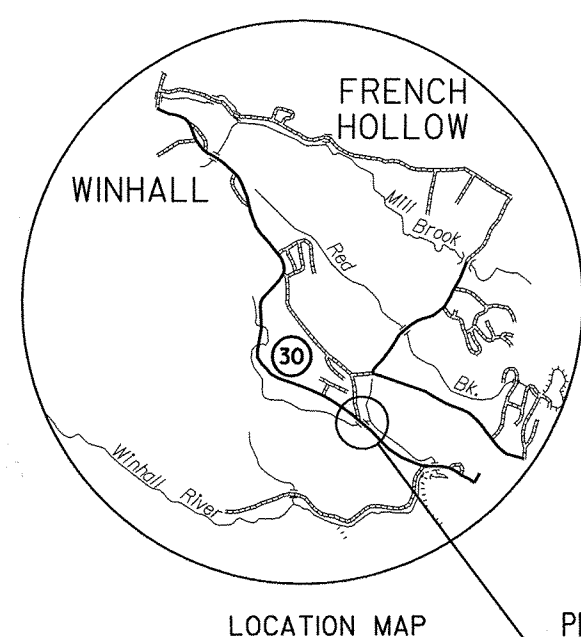

LOCATION MAP
NOT TO SCALE

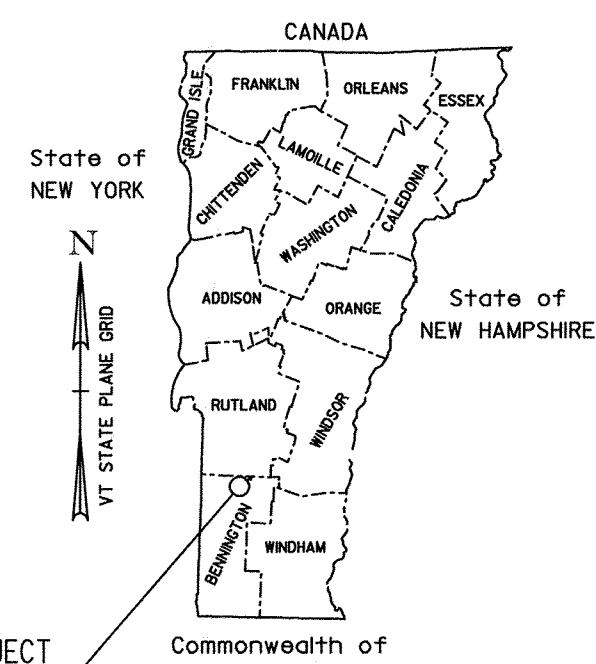

PROJECT
WINHALL
STP CULV (22)

RECORD PLANS

CONTRACTOR: BRAZIN BROTHERS TRUCKING, INC. - WESTMINSTER, VT.
RESIDENT ENGINEER: JUDY GILMORE
CONSTRUCTION BEGAN: JULY 20, 2011
CONSTRUCTION COMPLETE: AUGUST 13, 2012
RECORD PLANS BY: JUDY GILMORE & CRAIG PIERCE
I HEREBY CERTIFY THAT ALL THE CONSTRUCTION REQUIRED BY THIS SET OF DRAWINGS HAS BEEN ACCOMPLISHED AS INDICATED HEREIN.
BY *Judy Gilmore* RESIDENT ENGINEER
DATE: 21 March 2013

NOTE: Any further information concerning final quantities, amounts or other details relative to this project may be found at Central Files in the electronic archives.


QUALITY ASSURANCE PROGRAM: LEVEL 2

CONVENTIONAL SYMBOLS

| | |
|--------------------|-----------------|
| COUNTY LINE | — — — — — |
| TOWN LINE | — — — — — |
| LIMITS OF ACCESS | — — — — — |
| POINT OF ACCESS | X |
| FENCE LINE | X — X — X — X — |
| STONE WALL | — — — — — |
| TRAVELED WAY | — — — — — |
| GUARD RAIL | — — — — — |
| RAILROAD | — — — — — |
| SURVEY LINE | — — — — — |
| CULVERT | — — — — — |
| POWER POLE | ⊕ |
| TELEPHONE POLE | ⊕ |
| TREES | ⊕ |
| CONTROL OF ACCESS | — — — — — |
| PROPERTY LINE | — — — — — |
| R.O.W. TAKING LINE | — — — — — |
| SLOPE RIGHTS | — — — — — |
| TOP OF CUT | — — — — — |
| TOE OF SLOPE | — — — — — |

SURVEYED BY: VHB
SURVEYED DATE: DECEMBER 2008

DATUM
VERTICAL ASSUMED
HORIZONTAL ASSUMED

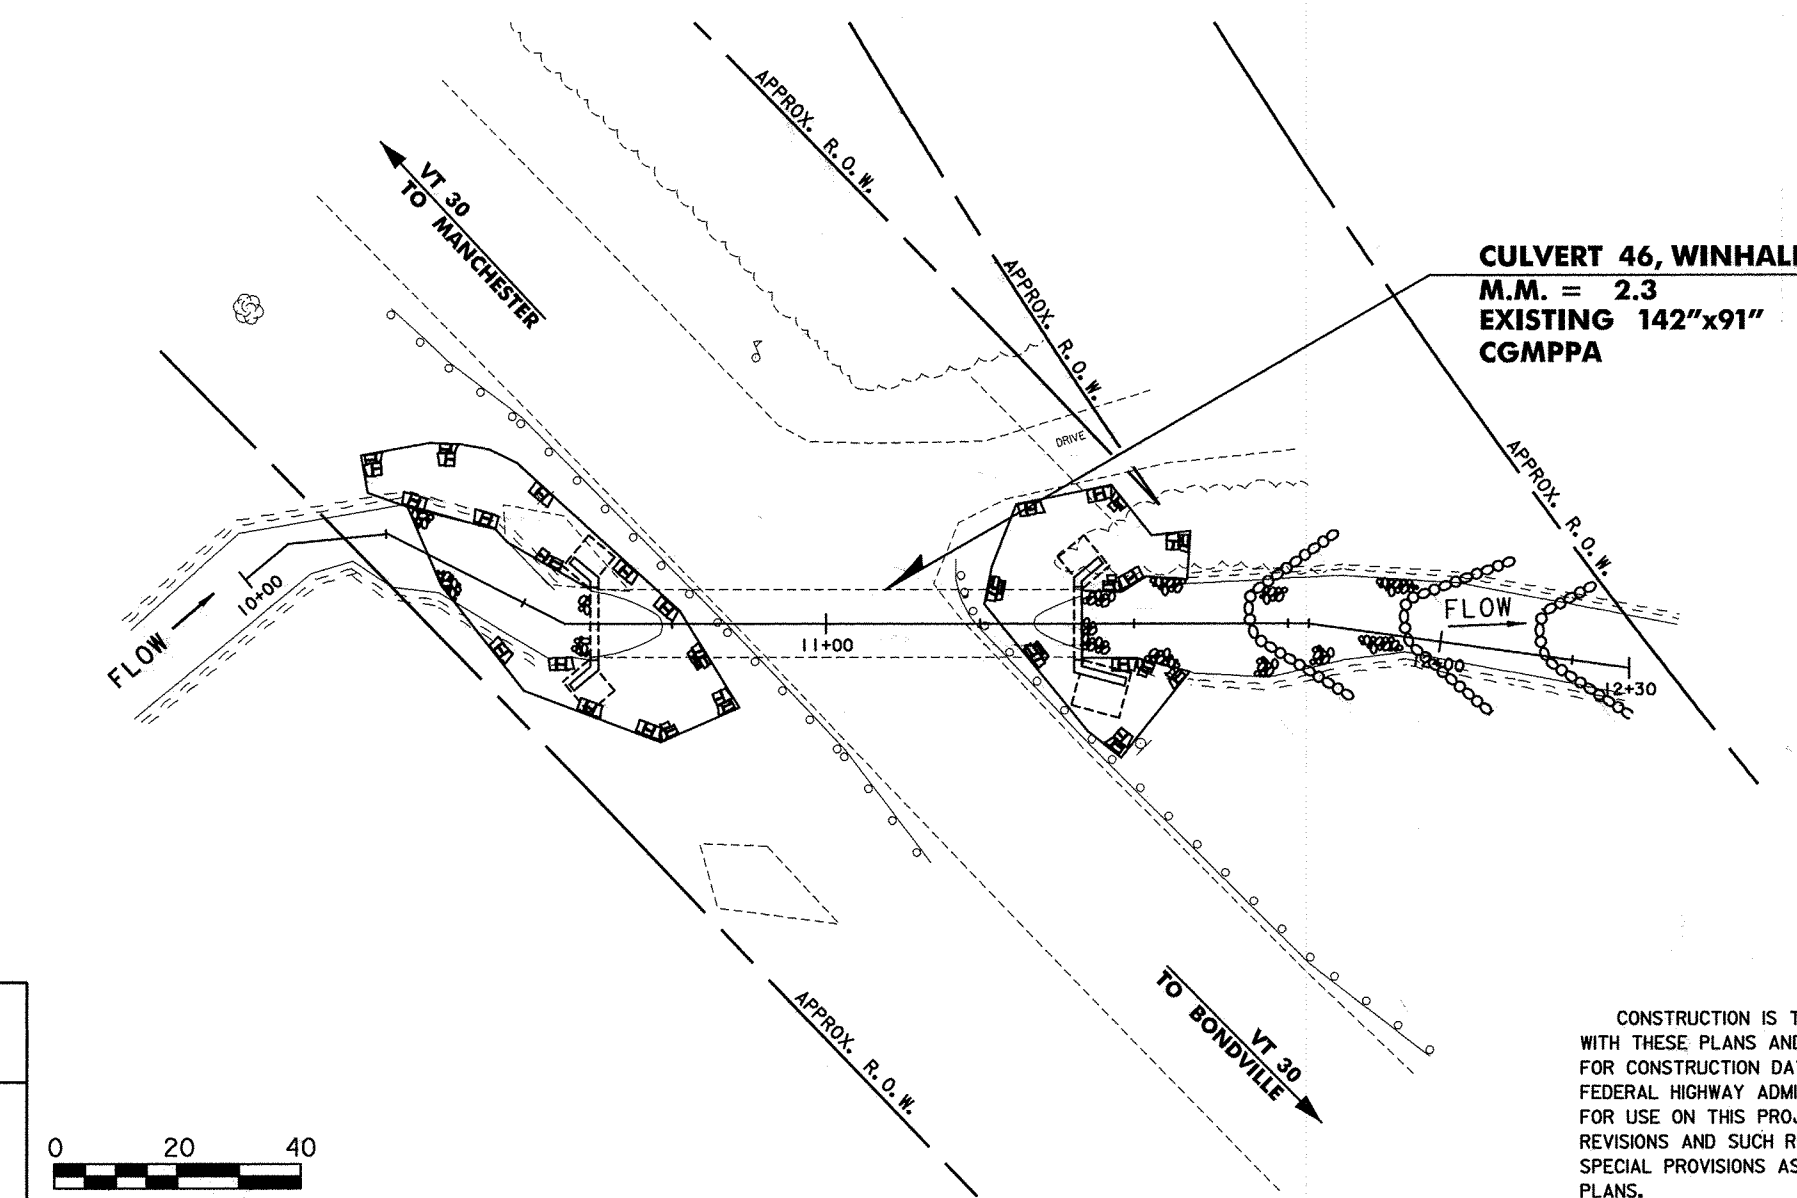

CULVERT 46, WINHALL
M.M. = 2.3
EXISTING 142"x91"
CGMPPA

FINAL PLANS
JULY 2, 2010



DIRECTOR OF PROGRAM DEVELOPMENT
APPROVED: *Mark Sargent* DATE: 9-17-10
PROJECT MANAGER: MARK SARGENT
PROJECT NAME: WINHALL
PROJECT NUMBER: STP CULV (22)
SHEET 1 OF 21 SHEETS

CONSTRUCTION IS TO BE CARRIED ON IN ACCORDANCE WITH THESE PLANS AND THE STANDARD SPECIFICATIONS FOR CONSTRUCTION DATED 2006, AS APPROVED BY THE FEDERAL HIGHWAY ADMINISTRATION ON JUNE 15, 2006 FOR USE ON THIS PROJECT, INCLUDING ALL SUBSEQUENT REVISIONS AND SUCH REVISED SPECIFICATIONS AND SPECIAL PROVISIONS AS ARE INCORPORATED IN THESE PLANS.