
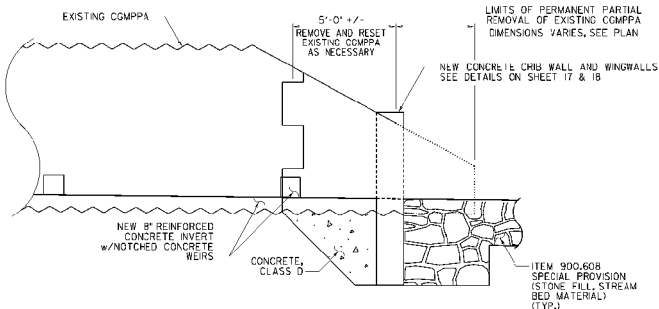


CULVERT PROFILE

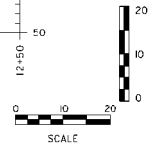

**DETAIL A
PARTIAL REMOVAL OF END SECTION**
NOT TO SCALE

NOTE:

1. WINGWALL FOOTING NOT SHOWN.
2. DOWNSTREAM END SHOWN, UPSTREAM END SIMILAR.

PROJECT NAME: WINHALL
PROJECT NUMBER: STP_CULV(22)

FILE NAME: \\narrowing\20809\9prof.dgn PLOT DATE: 1/5/2011
PROJECT LEADER: C. BOUJE DRAWN BY: J. SOTER
DESIGNED BY: T. KNIGHT CHECKED BY: M. CHENETTE
CULVERT PROFILE SHEET 9 OF 21

