


 
 

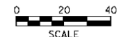


 TEMP. EROSION MATTING, SEED, FERT., LOG

LEGEND

-  LIMITS OF SOIL DISTURBANCE
-  DISTURBED AREAS REQUIRING RE-VEGETATION
-  PERMANENT EROSION MATTING
-  ITEM 800.608 SPECIAL PROVISION (STONE FILL, STREAM BED MATERIAL)
-  3'-0" STONE FILL, TYPE II
-  RIPARIAN BUFFER ZONE



EPSC FINAL CONDITIONS SITE PLAN

PROJECT NAME:	WINHALL	PLOT DATE:	1/5/2011
PROJECT NUMBER:	STP_CULV(22)	DRAWN BY:	E. ALLING
FILE NAME:	\\pcw\ing\2080\9860.dgn	CHECKED BY:	M. CHENETTE
PROJECT LEADER:	G. BOGUE	SHEET	12
DESIGNED BY:	T. KNIGHT	OF	21

EPSC FINAL CONDITIONS SITE PLAN