


NOTES

1. STONES USED FOR THE ROCK WEIRS SHALL BE TYPE IV STONE.
2. DUE TO VARIATIONS IN THE STREAM GRADE, EXACT LOCATION OF THE ROCK WEIRS SHALL BE DETERMINED IN THE FIELD. THE INTENTION IS TO PROVIDE A MAXIMUM OF 6" GRADE CHANGE EACH ROCK WEIR.
3. ROCK WEIRS SHALL BE PAID FOR AS ITEM 900.620, SPECIAL PROVISION (ROCK WEIR).


ROCK WEIR DETAIL

NOT TO SCALE

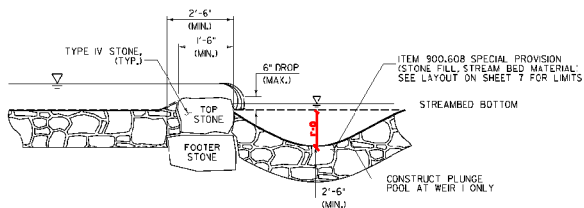

SECTION A-A

NOT TO SCALE

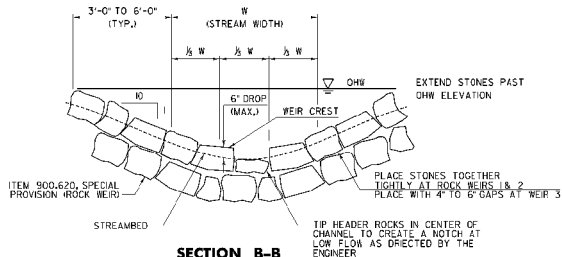

SECTION B-B

NOT TO SCALE

PROJECT NAME: WINHALL
PROJECT NUMBER: STP_CULV(22)

FILE NAME: ...arowing208098r\dwg\stc.dgn PLOT DATE: 1/5/2011
PROJECT LEADER: C. BOJUE DRAWN BY: J. SOTER
DESIGNED BY: T. KNIGHT CHECKED BY: M. CHENETTE
ROCK WEIR DETAILS SHEET 16 OF 21

