



DUE TO LIMITED SURVEY, CROSS-SECTION AT 12+25 IS APPROXIMATE ONLY.

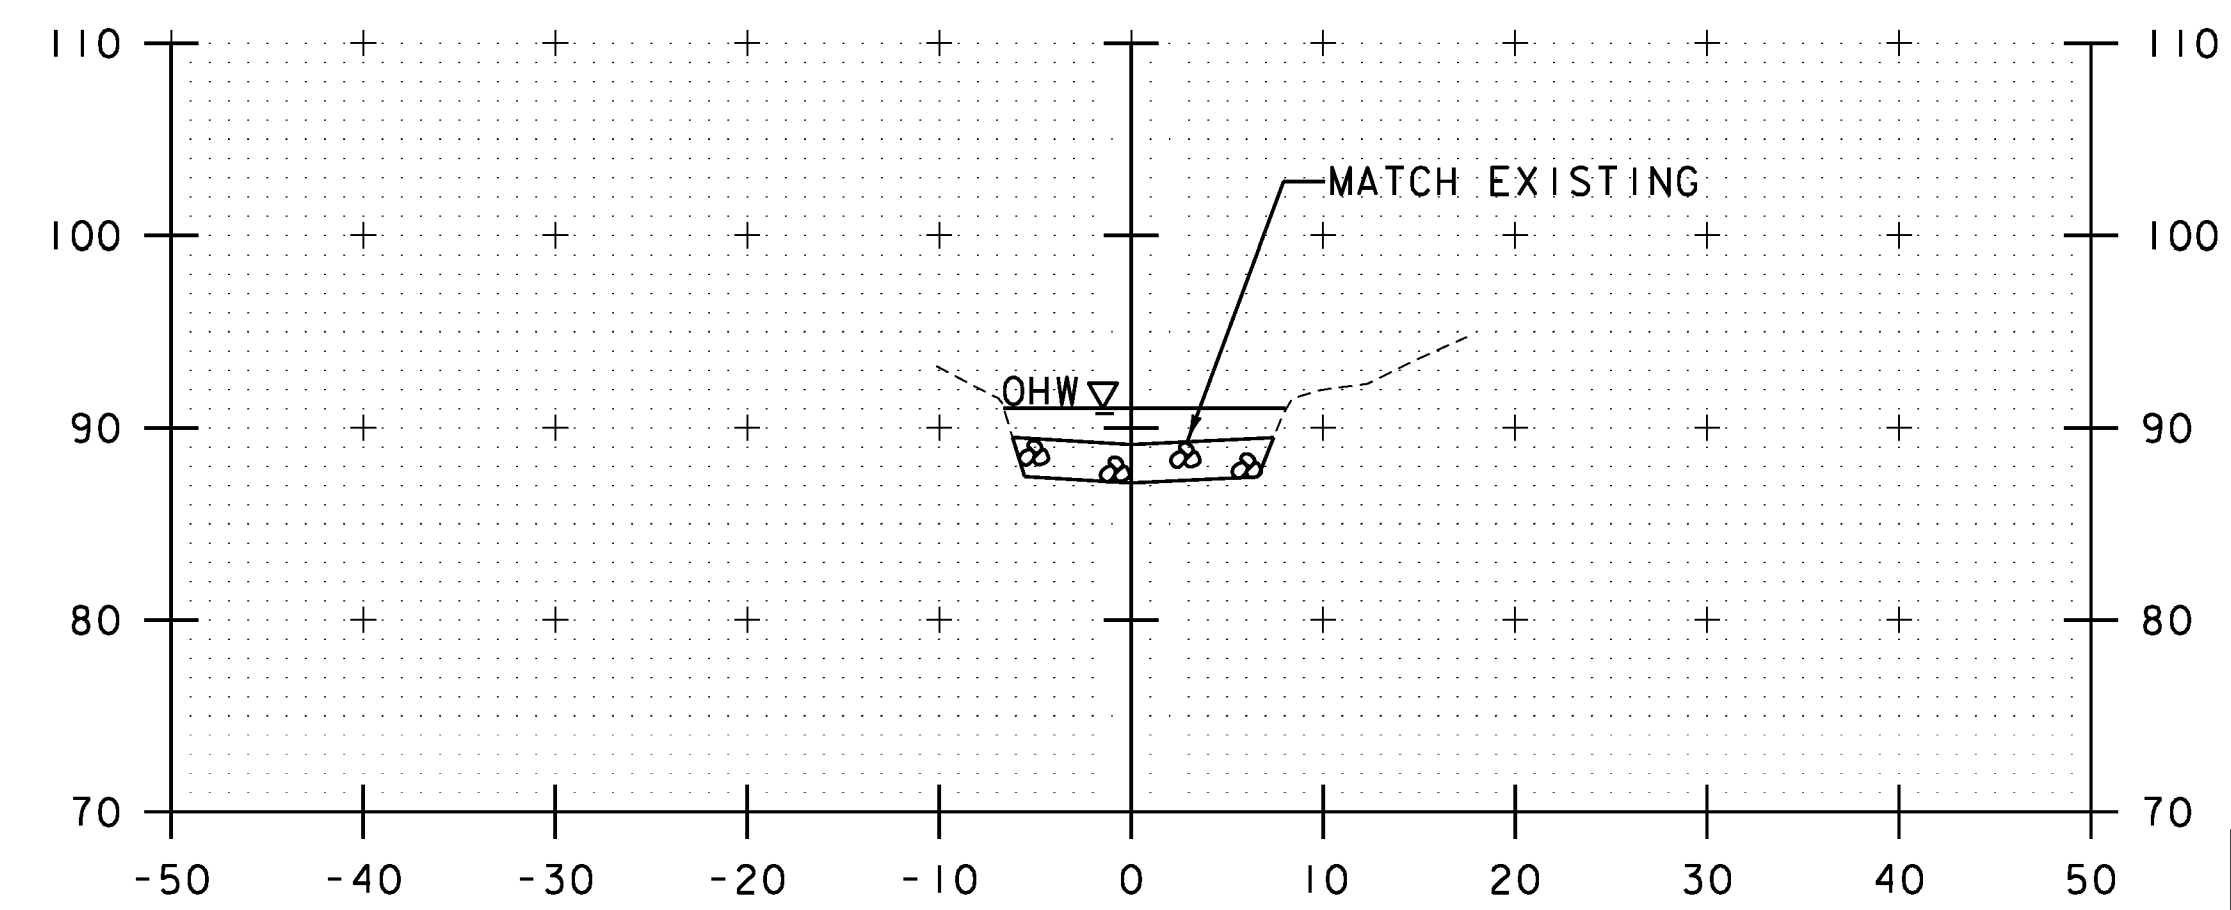

LEGEND

	3'-0" STONE FILL, TYPE III
	ITEM 900.608 SPECIAL PROVISION (STONE FILL, STREAM BED MATERIAL)

NOTE: ROCK WEIRS NOT SHOWN FOR CLARITY.

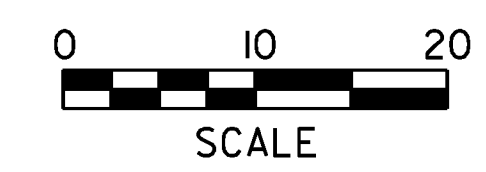

PROJECT NAME: WINHALL
 PROJECT NUMBER: STP CULV(22)
 FILE NAME: ...drawing\z08bl98xs.dgn PLOT DATE: 1/5/2011
 PROJECT LEADER: G. BOGUE DRAWN BY: J. SOTER
 DESIGNED BY: T. KNIGHT CHECKED BY: M. CHENETTE
CHANNEL CROSS SECTIONS 2 SHEET 21 OF 21



STA. 11+41 TO STA. 11+90 +/-