

STATE OF VERMONT
AGENCY OF TRANSPORTATION




PROPOSED IMPROVEMENT
TOWNS OF SUDBURY, WHITING,
CORNWALL AND MIDDLEBURY
COUNTIES OF RUTLAND AND ADDISON
VT ROUTE 30

BEGINNING AT THE HUBBARDTON-SUDBURY TOWN LINE ON
VT ROUTE 30 AT MILE MARKER 0.000 AND EXTENDING NORTHERLY ALONG VT ROUTE 30 FOR A DISTANCE OF APPROXIMATELY
18.246 MILES TO MIDDLEBURY CLASS I ROAD AT MILE MARKER 0.550.

LENGTH OF ROADWAY = 18.246 MILES
LENGTH OF PROJECT = 18.246 MILES

WORK TO BE PERFORMED UNDER THIS PROJECT INCLUDES THE REMOVAL OF EXISTING SIGNS AND SIGN POSTS
AND THE INSTALLATION OF NEW SIGNS AND SIGN POSTS AND INCIDENTAL ITEMS.

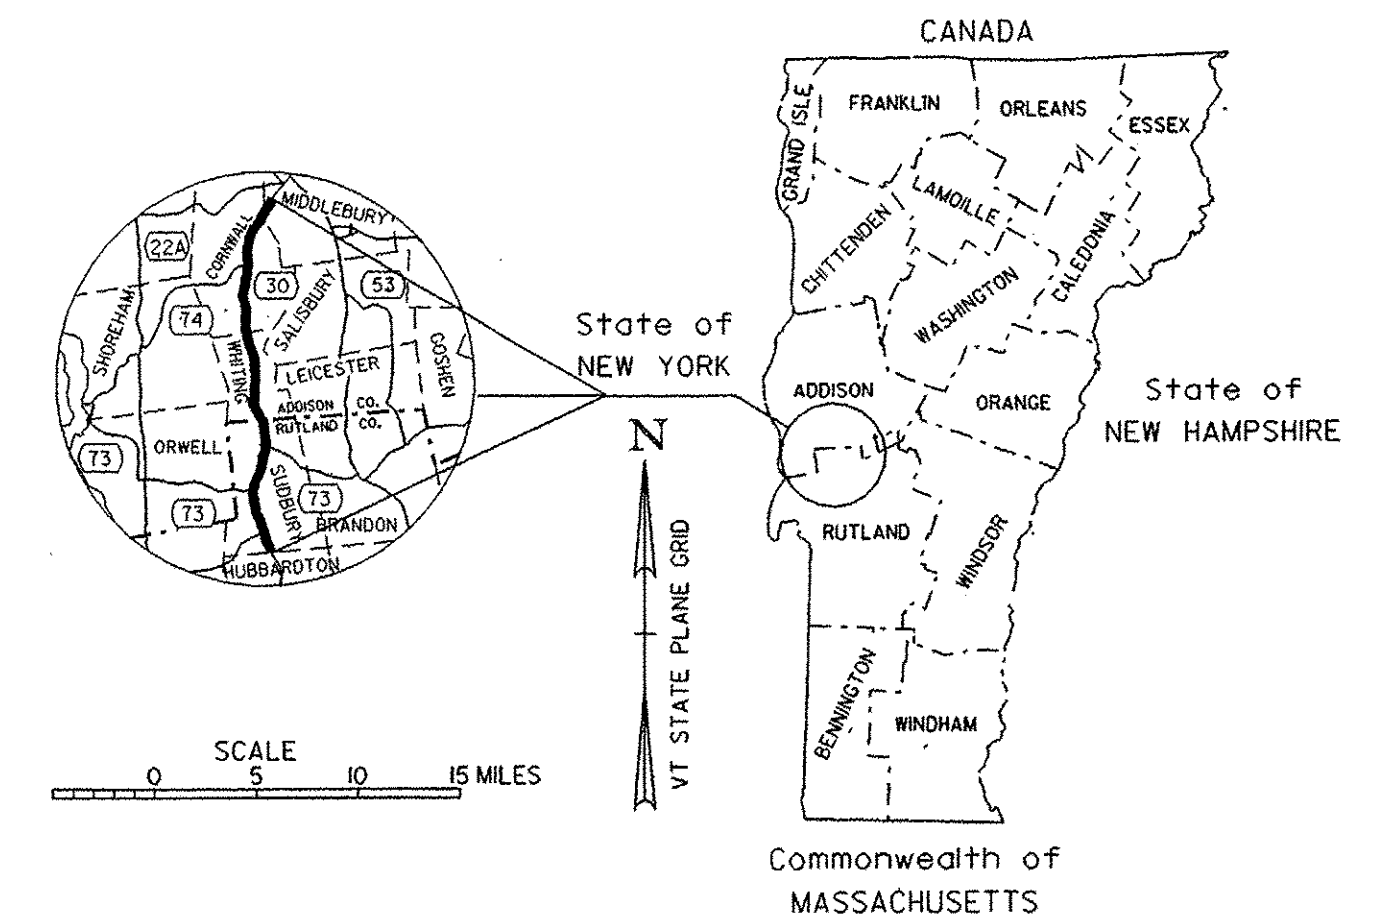

INDEX OF SHEETS

1	TITLE SHEET
2	QUANTITY SHEET
3	GENERAL NOTES
4-21	SIGNING PLAN SHEETS
22-23	SIGN DETAILS
24-43	TRAFFIC SIGN SUMMARY SHEETS
44-45	TRAFFIC CONTROL SHEETS

STANDARDS

E-121	STANDARD SIGN PLACEMENT - CONVENTIONAL ROAD	08/08/95
E-123	GUIDE SIGN PLACEMENT - MISCELLANEOUS DETAILS	03/06/04
E-124	TOWN LINE SIGNS	08/08/95
E-127	ROUTE MARKINGS AT RURAL INTERSECTIONS	08/08/95
E-128A	DETAILING VILLAGE SIGNS (A-M)	08/08/95
E-128B	DETAILING VILLAGE SIGNS (N-W)	08/08/95
E-136B	STATE ROUTE MARKER SIGN DETAILS	08/08/95
E-136C	STATE NUMBERED TOWN HIGHWAY SIGN DETAILS	08/08/95
E-138	MILEMARKER DETAILS - STATE & TOWN HIGHWAYS	05/30/03
E-141	REGULATORY SIGN DETAILS	09/20/95
E-142	REGULATORY SIGN DETAILS	09/20/95
E-143	REGULATORY SIGN DETAILS	06/15/04
E-150	WARNING SIGN DETAILS	05/01/04
E-151	WARNING SIGN DETAILS	05/01/04
E-152	WARNING SIGN DETAILS	05/01/04
E-153	WARNING SIGN DETAILS	05/01/04
E-154	WARNING SIGN DETAILS	05/01/04
E-155	WARNING SIGN DETAILS	05/01/04
E-164	SQUARE STEEL SIGN POSTS	05/20/99

RECORD PLANS

CONTRACTOR: L&D SAFETY MARKINGS CORP.

RESIDENT ENGINEER: TRACY HARRINGTON

CONSTRUCTION BEGAN: APRIL 27, 2009

CONSTRUCTION COMPLETE: JUNE 1, 2009

RECORD PLANS BY: TRACY HARRINGTON & C. PIERCE

I HEREBY CERTIFY THAT ALL THE CONSTRUCTION REQUIRED BY THIS SET OF DRAWINGS HAS BEEN ACCOMPLISHED AS INDICATED HEREIN.

BY *Tracy Harrington* RESIDENT ENGINEER

DATE *Dec 30, 2011*

NOTE: Any further information concerning final quantities, amounts or other details relative to this project may be found at Central Files in the electronic archives.

CONVENTIONAL SYMBOLS

COUNTY LINE		COUNTY LINE
TOWN LINE		TOWN LINE
LIMITS OF ACCESS		LIMITS OF ACCESS
POINT OF ACCESS		POINT OF ACCESS
FENCE LINE		FENCE LINE
STONE WALL		STONE WALL
TRAVELED WAY		TRAVELED WAY
RAILROAD		RAILROAD
SURVEY LINE		SURVEY LINE
CULVERT		CULVERT
POWER POLE		POWER POLE
TELEPHONE POLE		TELEPHONE POLE
TREES		TREES
CONTROL OF ACCESS		CONTROL OF ACCESS
PROPERTY LINE		PROPERTY LINE
R.O.W. TAKING LINE		R.O.W. TAKING LINE
SLOPE RIGHTS		SLOPE RIGHTS
TOP OF CUT		TOP OF CUT
TOE OF SLOPE		TOE OF SLOPE


SURVEYED BY : N/A

SURVEYED DATE : N/A

DATUM

VERTICAL : N/A

HORIZONTAL : N/A

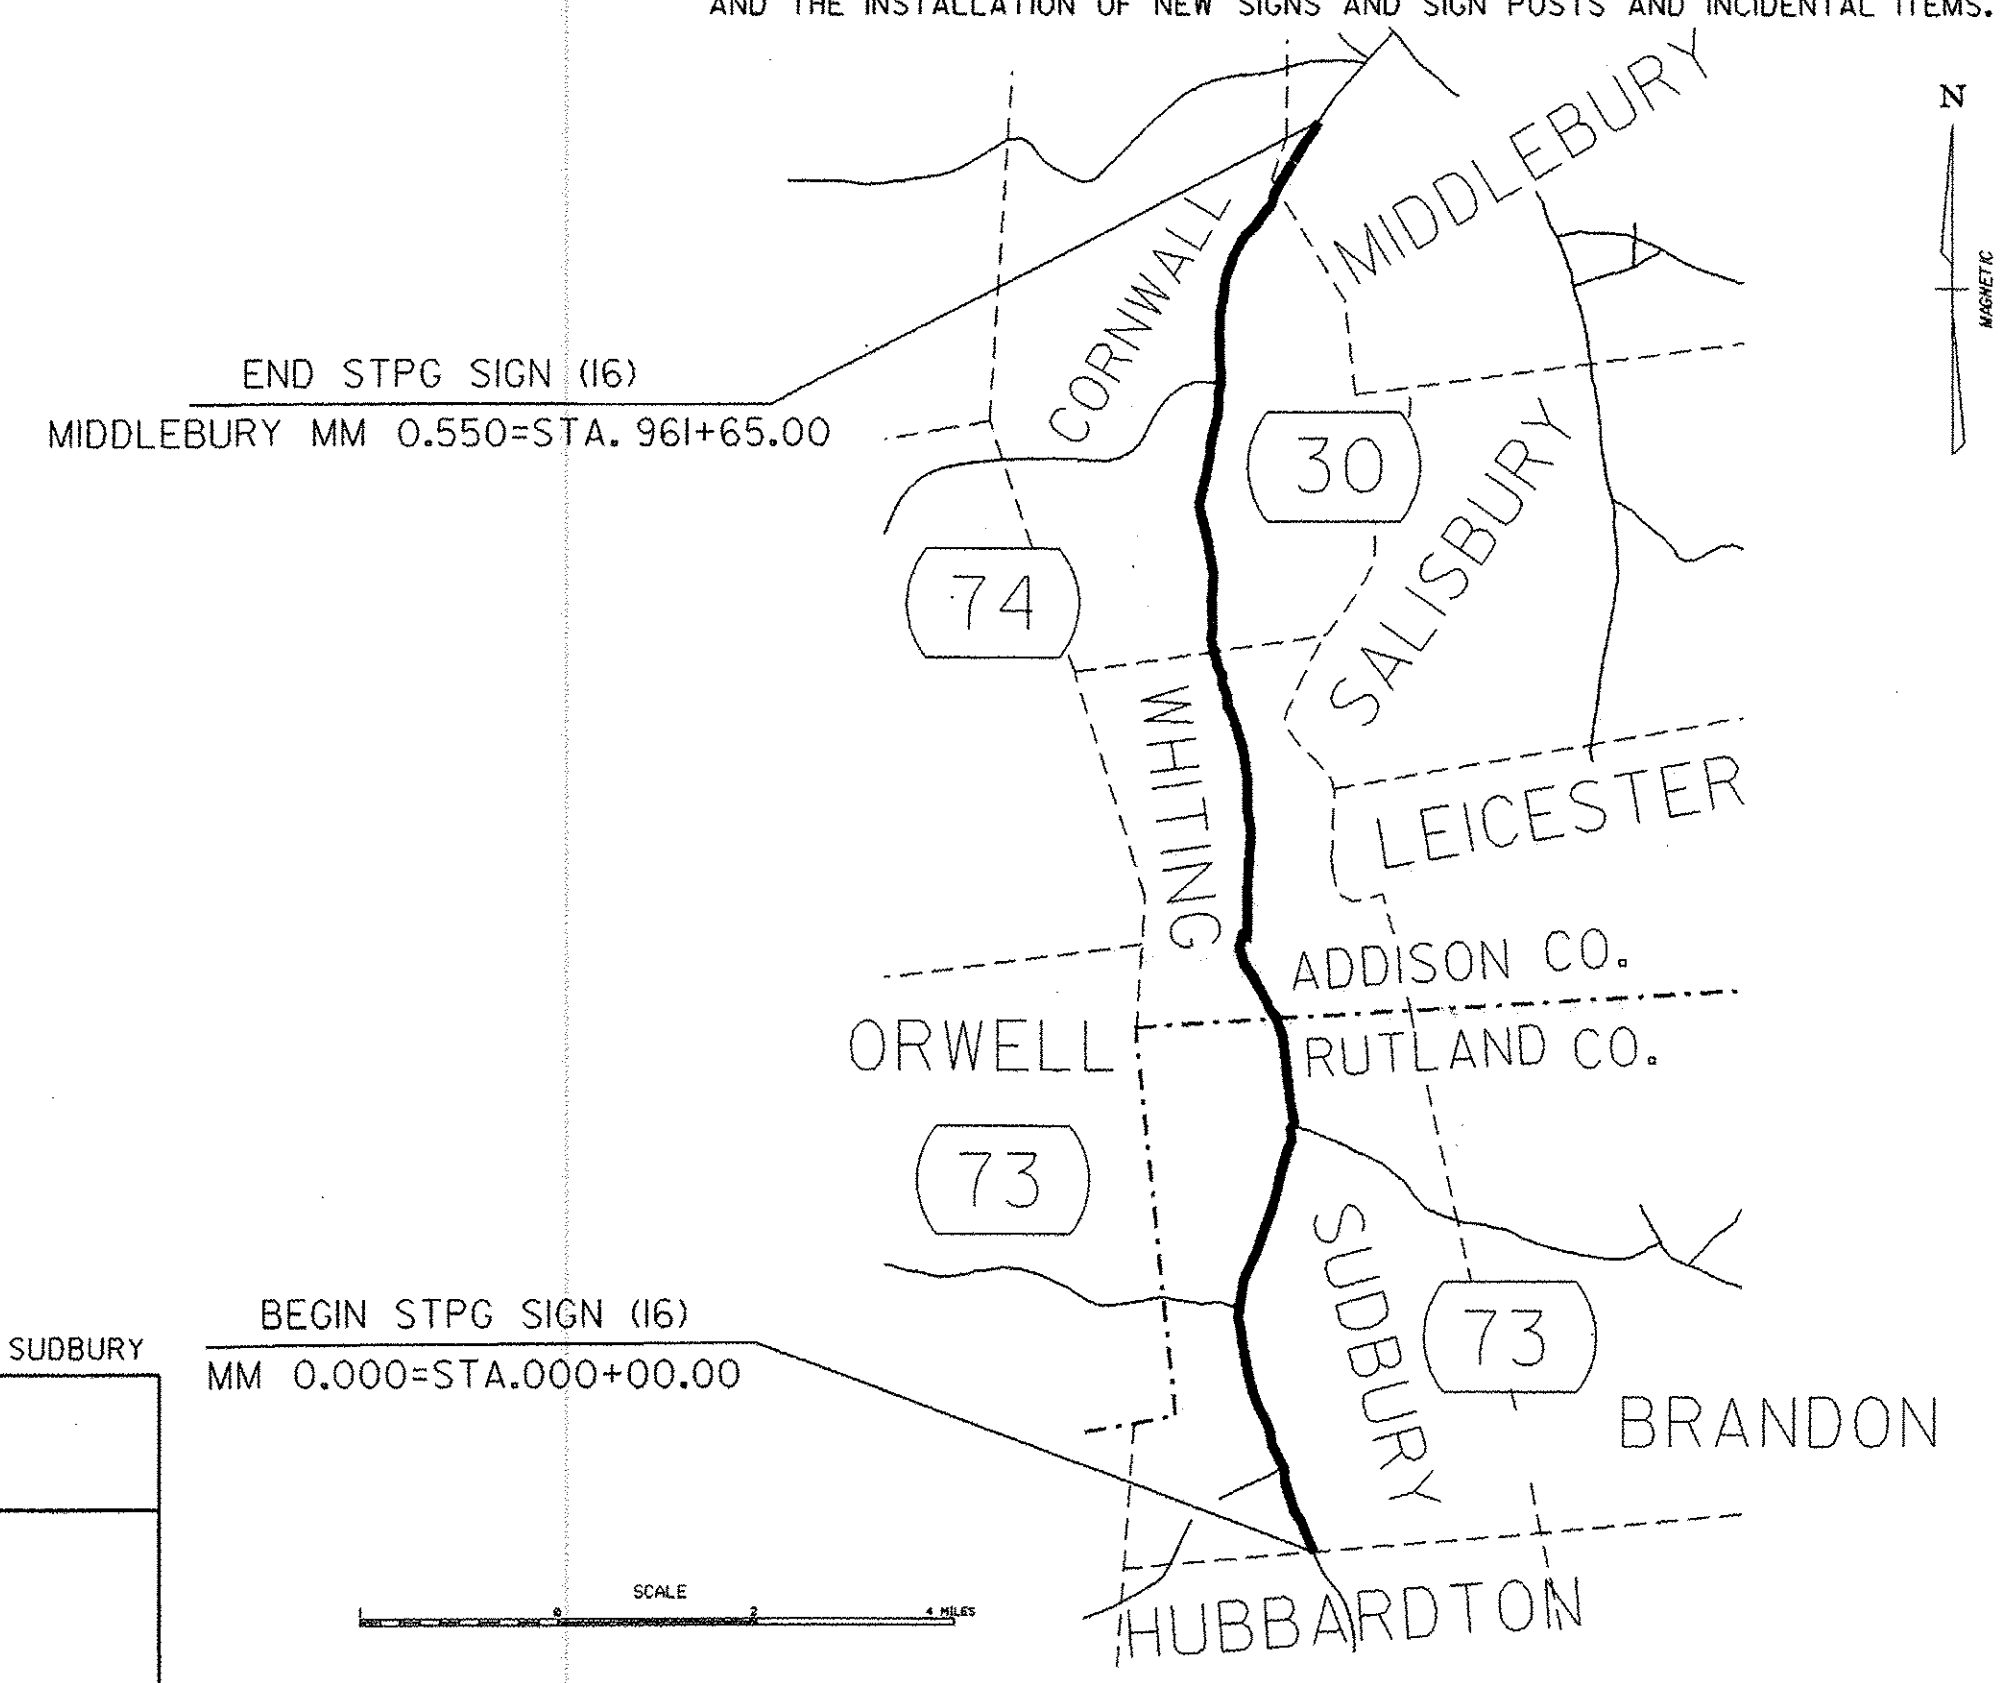

THESE PLANS ARE SUBJECT TO SUCH ENGINEERING CHANGES AS MAY BE REQUIRED BY THE FEDERAL HIGHWAY ADMINISTRATION OR THE DIRECTOR OF PROGRAM DEVELOPMENT.

CONSTRUCTION IS TO BE CARRIED ON IN ACCORDANCE WITH THESE PLANS AND THE STANDARD SPECIFICATIONS FOR CONSTRUCTION DATED 2006, AS APPROVED BY THE FEDERAL HIGHWAY ADMINISTRATION ON JUNE 15, 2006 FOR USE ON THIS PROJECT, INCLUDING ALL SUBSEQUENT REVISIONS AND SUCH REVISED SPECIFICATIONS AND SPECIAL PROVISIONS AS ARE INCORPORATED IN THESE PLANS.

UNLESS OTHERWISE NOTED, ALL DRAWINGS AND DETAILS OF THE PROJECT PLANS ARE NOT TO SCALE.

DIRECTOR OF PROGRAM DEVELOPMENT

APPROVED *Randa J. Roberts* DATE *1-27-09*

PROJECT MANAGER : NANCY AVERY

PROJECT NAME : SUDBURY-MIDDLEBURY

PROJECT NUMBER : STPG SIGN (16)

SHEET 1 OF 45 SHEETS