


675.20 TRAFFIC SIGN, TYPE A  
AS SHOWN - 31  
675.50 REMOVING SIGNS  
AS SHOWN - 26  
675.60 ERECTING SALVAGED SIGNS  
AS SHOWN - 1

VT. ROUTE 30  
MM 0.000 = STA. 0+0.00  
BEGIN STPG SIGN(16)

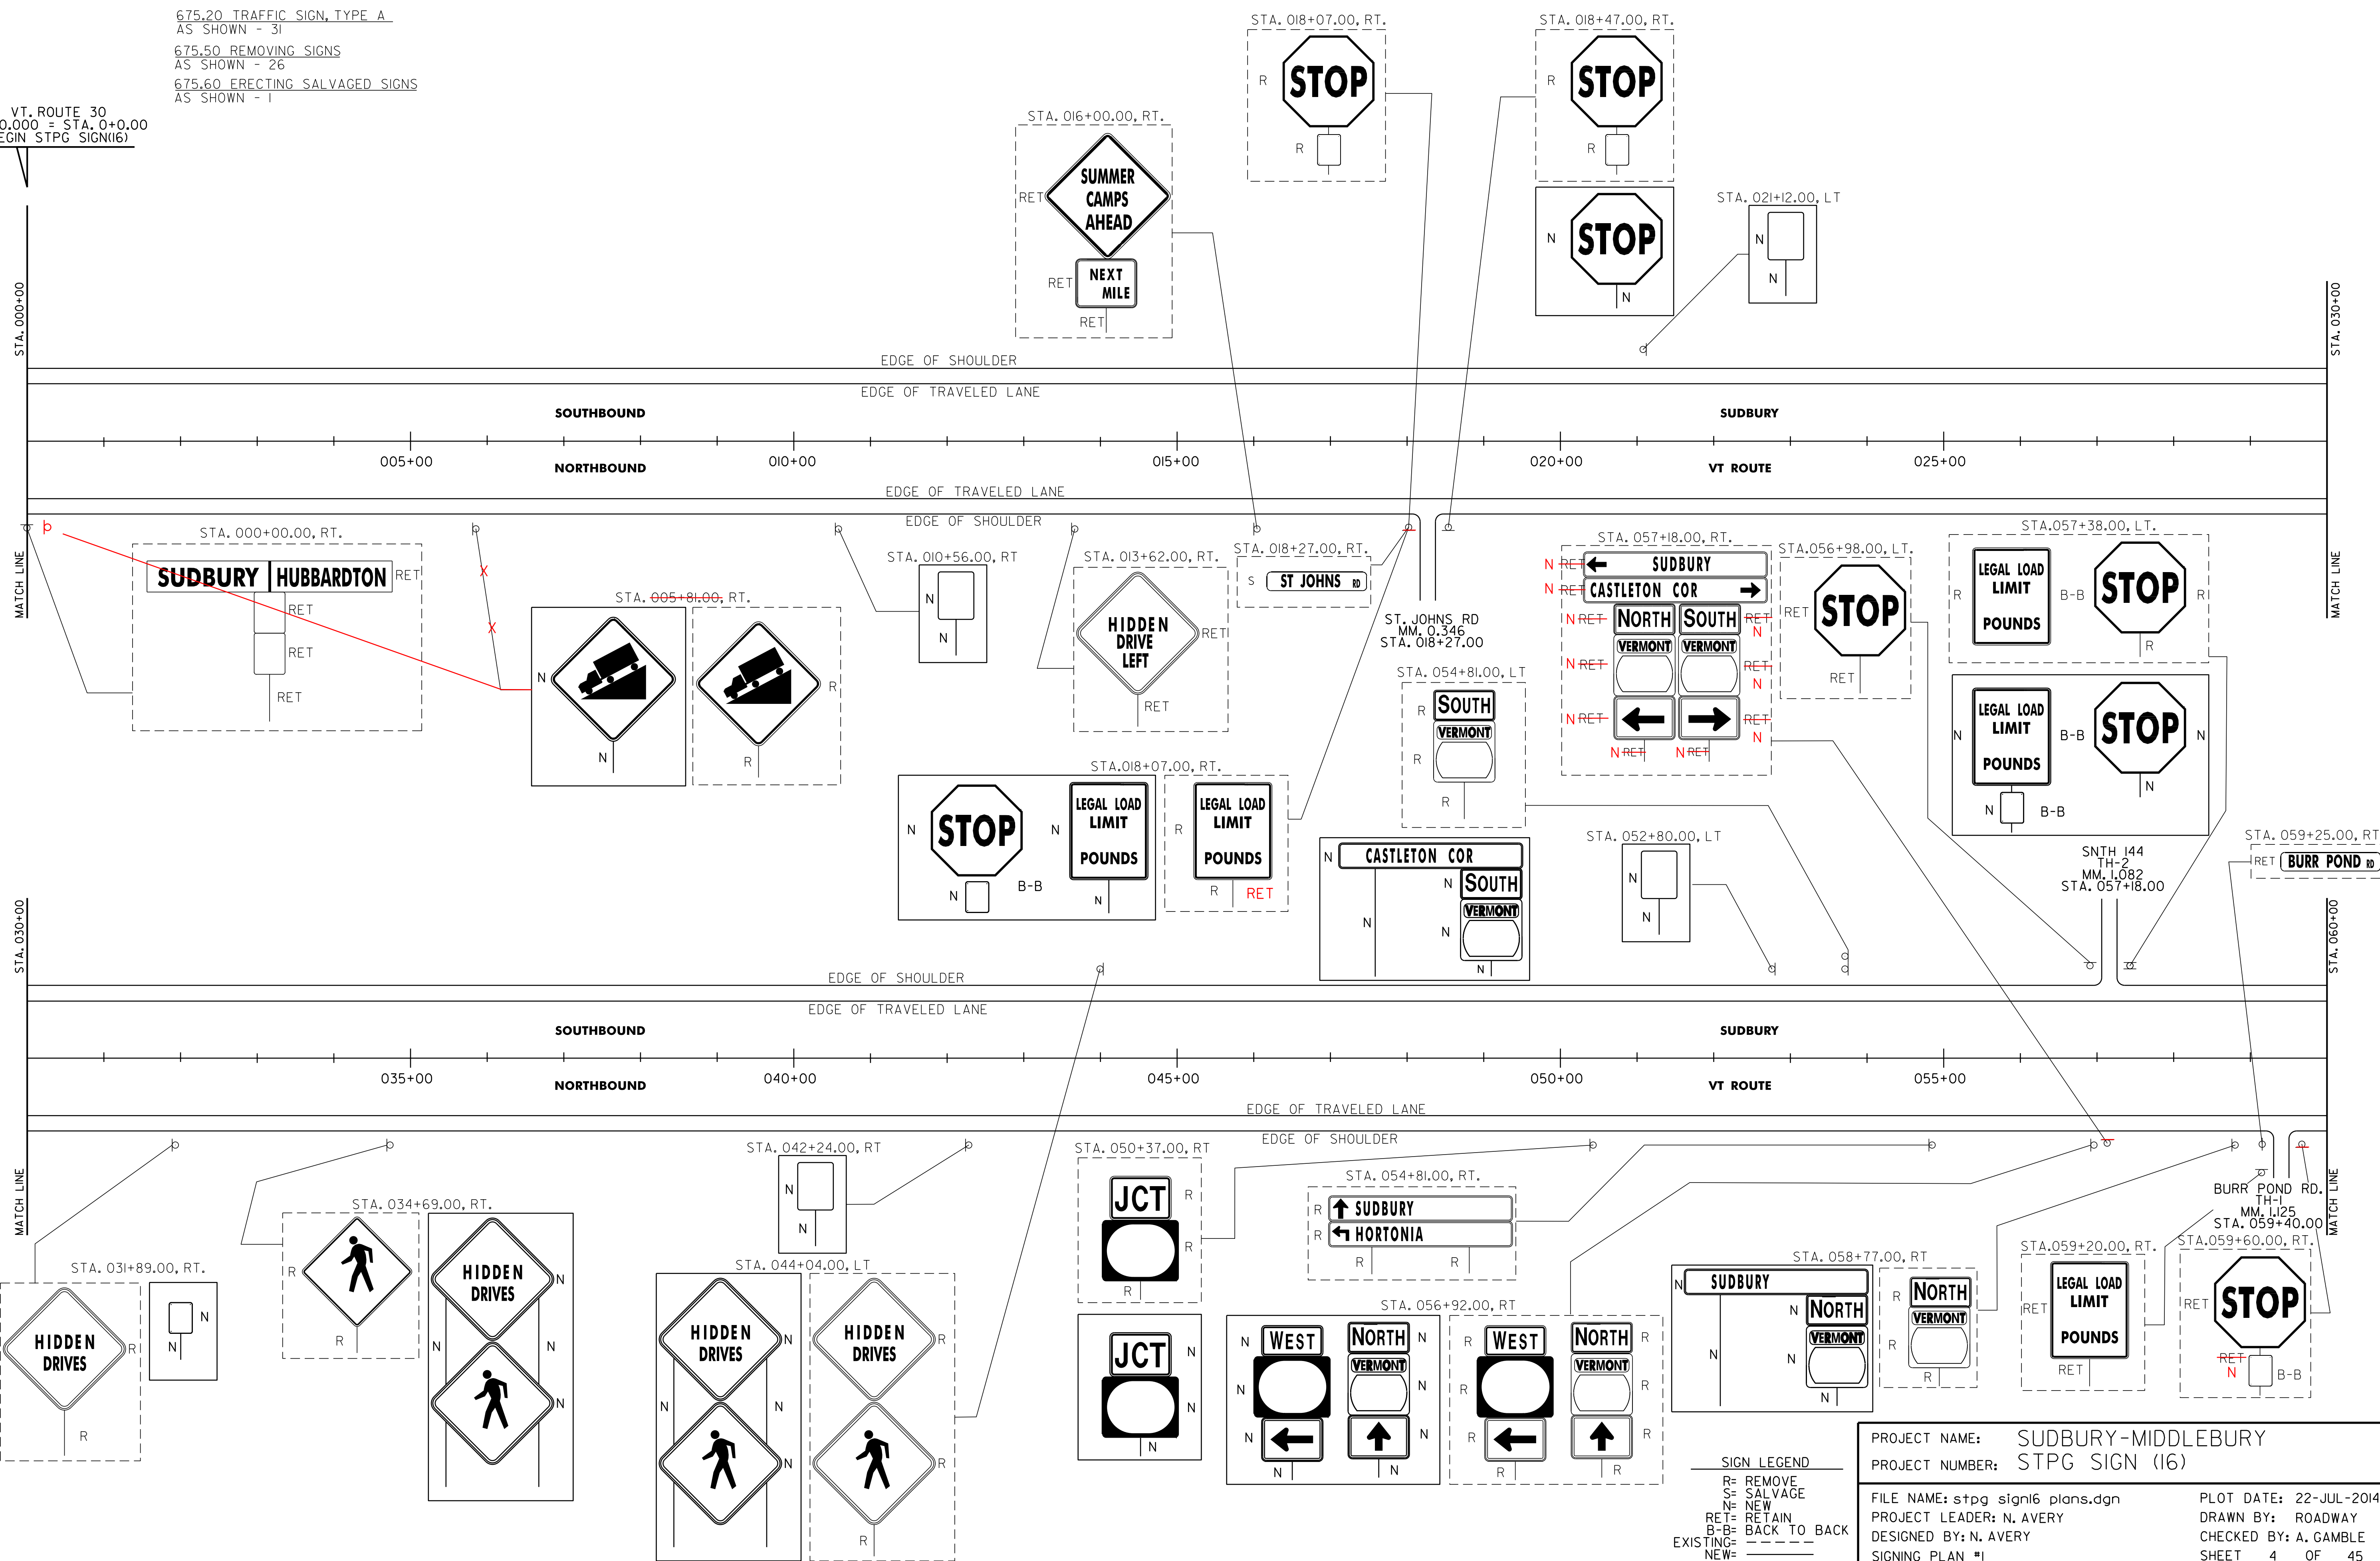

**SIGN LEGEND**  
 R= REMOVE  
 S= SALVAGE  
 N= NEW  
 RET= RETAIN  
 B-B= BACK TO BACK  
 EXISTING= - - - - -  
 NEW= \_\_\_\_\_

PROJECT NAME: SUDBURY-MIDDLEBURY  
 PROJECT NUMBER: STPG SIGN (16)  
 FILE NAME: stpg sign16 plans.dgn  
 PROJECT LEADER: N. AVERY  
 DESIGNED BY: N. AVERY  
 SIGNING PLAN #1  
 PLOT DATE: 22-JUL-2014 16:44  
 DRAWN BY: ROADWAY  
 CHECKED BY: A. GAMBLE  
 SHEET 4 OF 45