


675.20 TRAFFIC SIGN, TYPE A
 AS SHOWN - 37
 675.50 REMOVING SIGNS
 AS SHOWN - 35

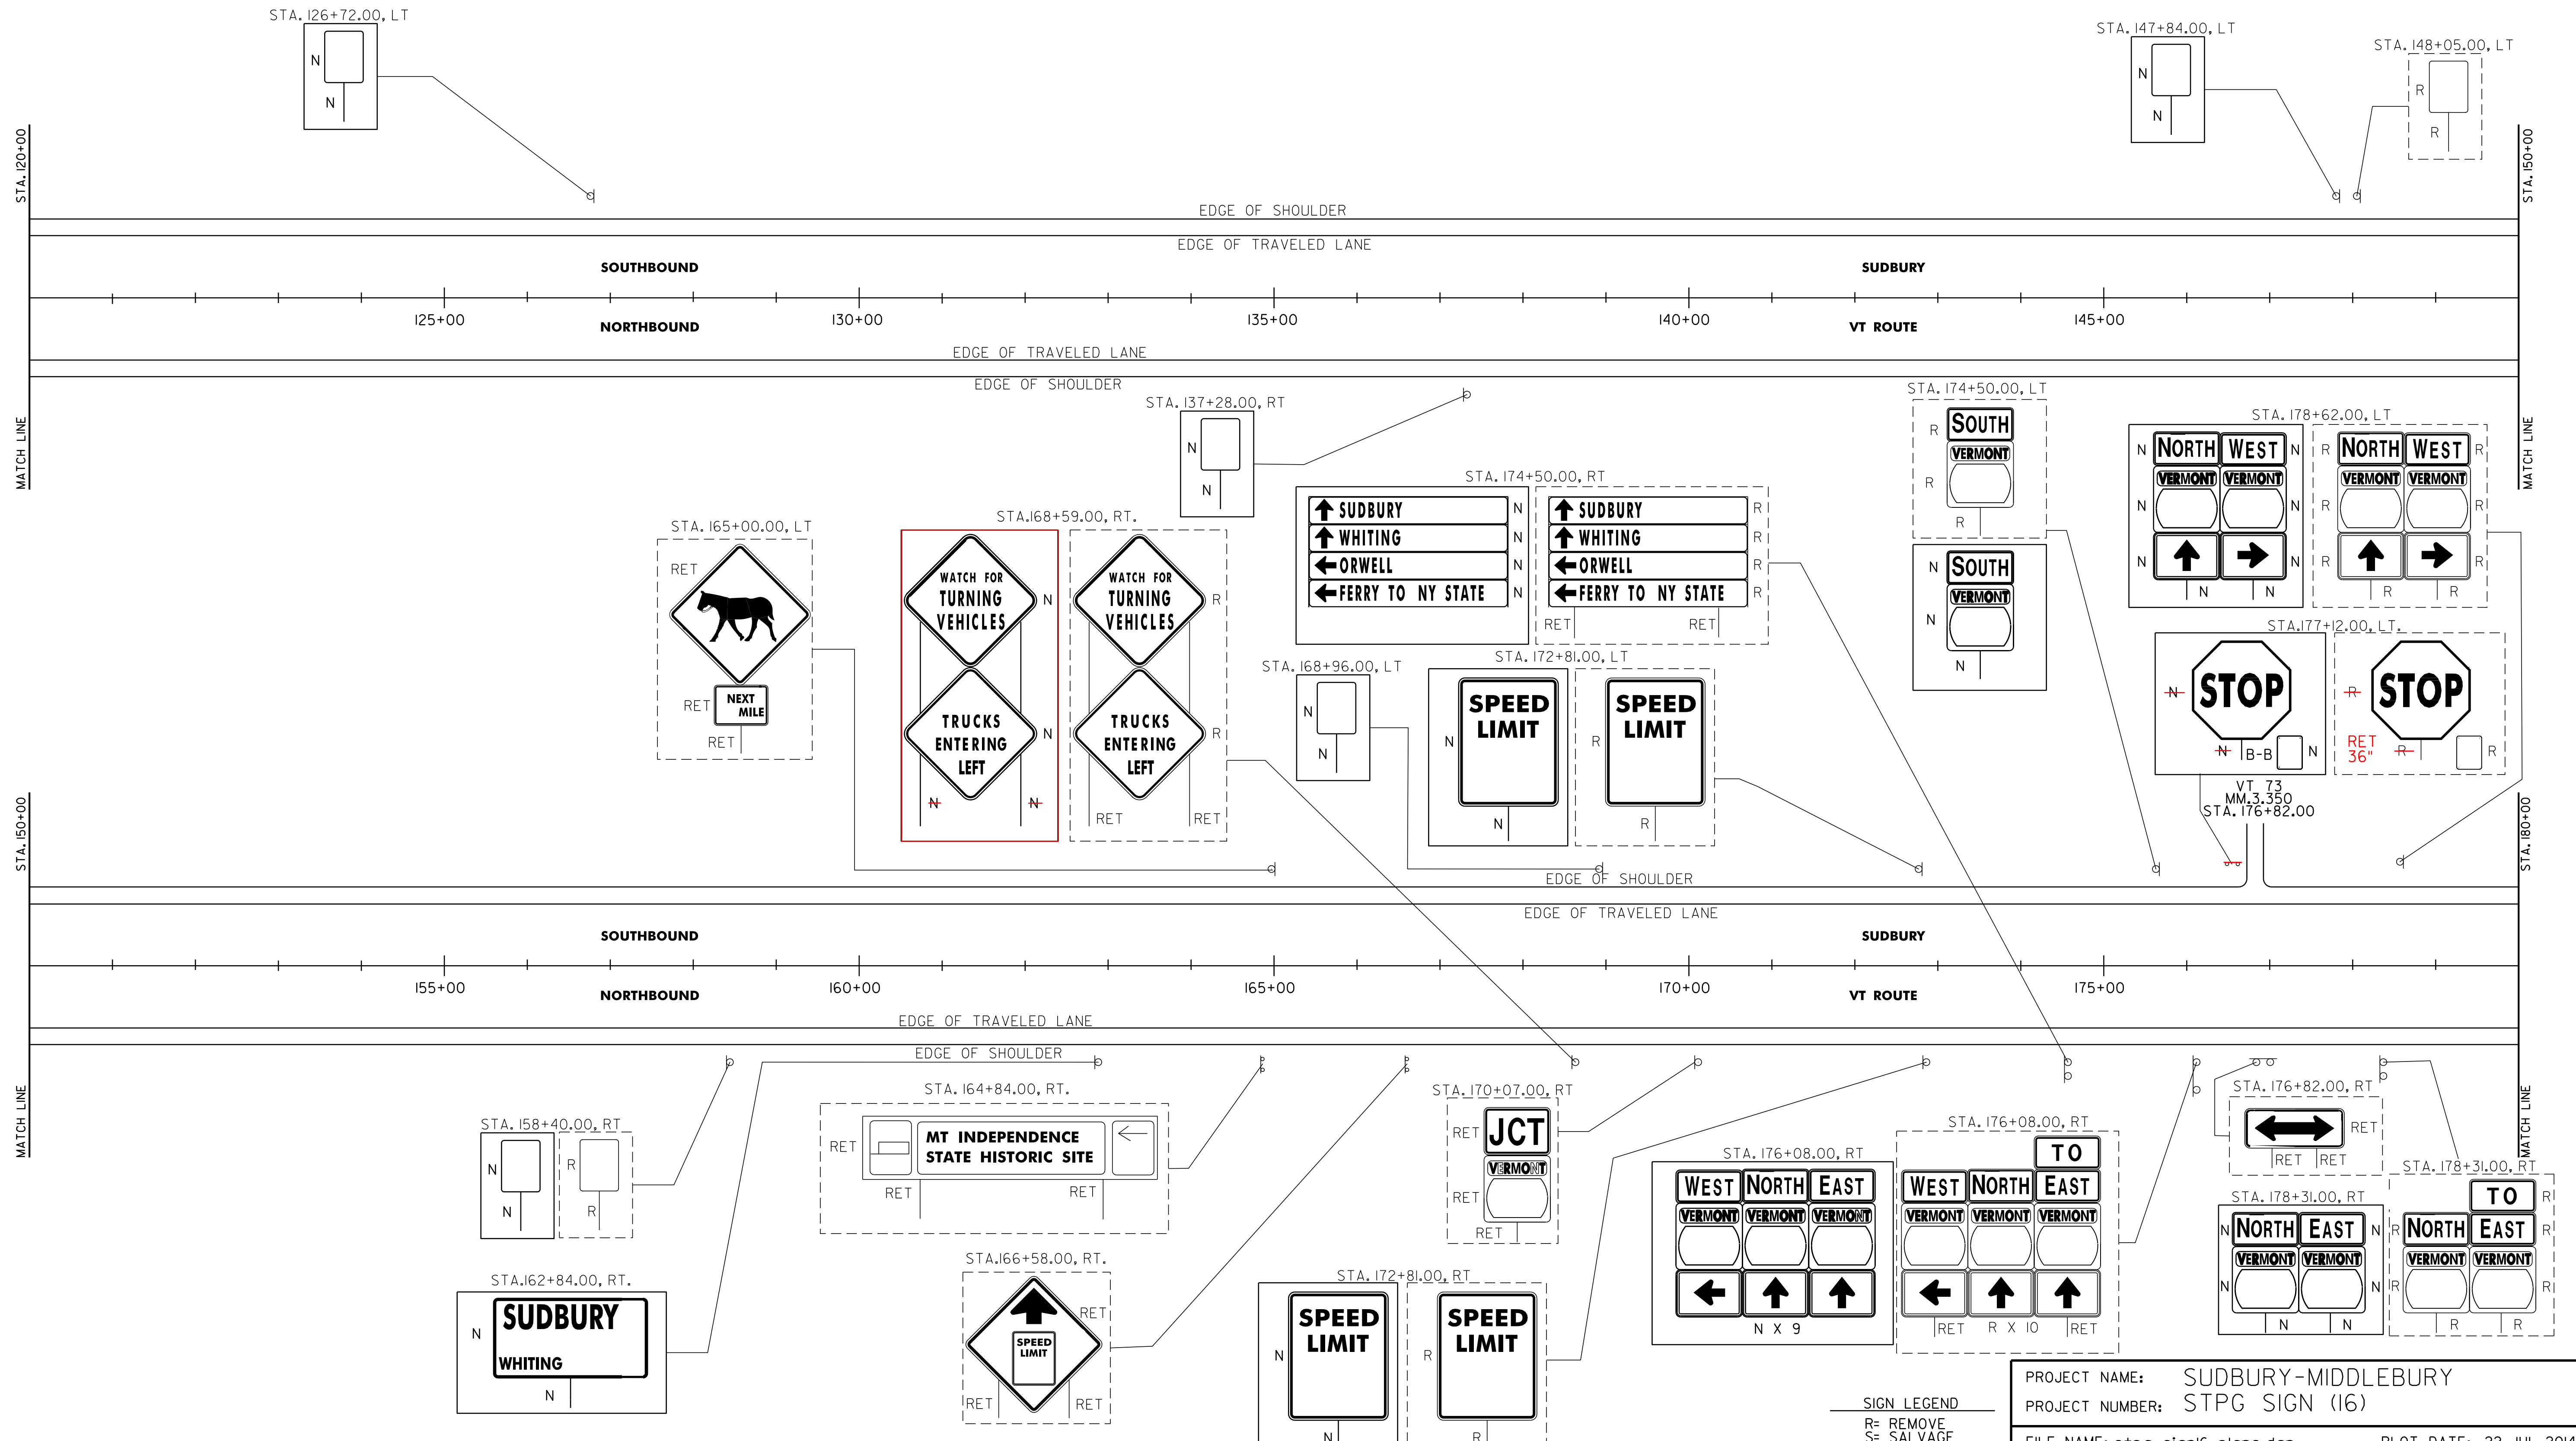

SIGN LEGEND
 R= REMOVE
 S= SALVAGE
 N= NEW
 RET= RETAIN
 B-B= BACK TO BACK
 EXISTING= - - - - -
 NEW= _____

PROJECT NAME: SUDBURY-MIDDLEBURY
 PROJECT NUMBER: STPG SIGN (16)
 FILE NAME: stpg sign16 plans.dgn
 PROJECT LEADER: N. AVERY
 DESIGNED BY: N. AVERY
 SIGNING PLAN #3
 PLOT DATE: 22-JUL-2014 16:49
 DRAWN BY: ROADWAY
 CHECKED BY: A. GAMBLE
 SHEET 6 OF 45