


675.20 TRAFFIC SIGN, TYPE A
AS SHOWN - 46
675.50 REMOVING SIGNS
AS SHOWN - 44

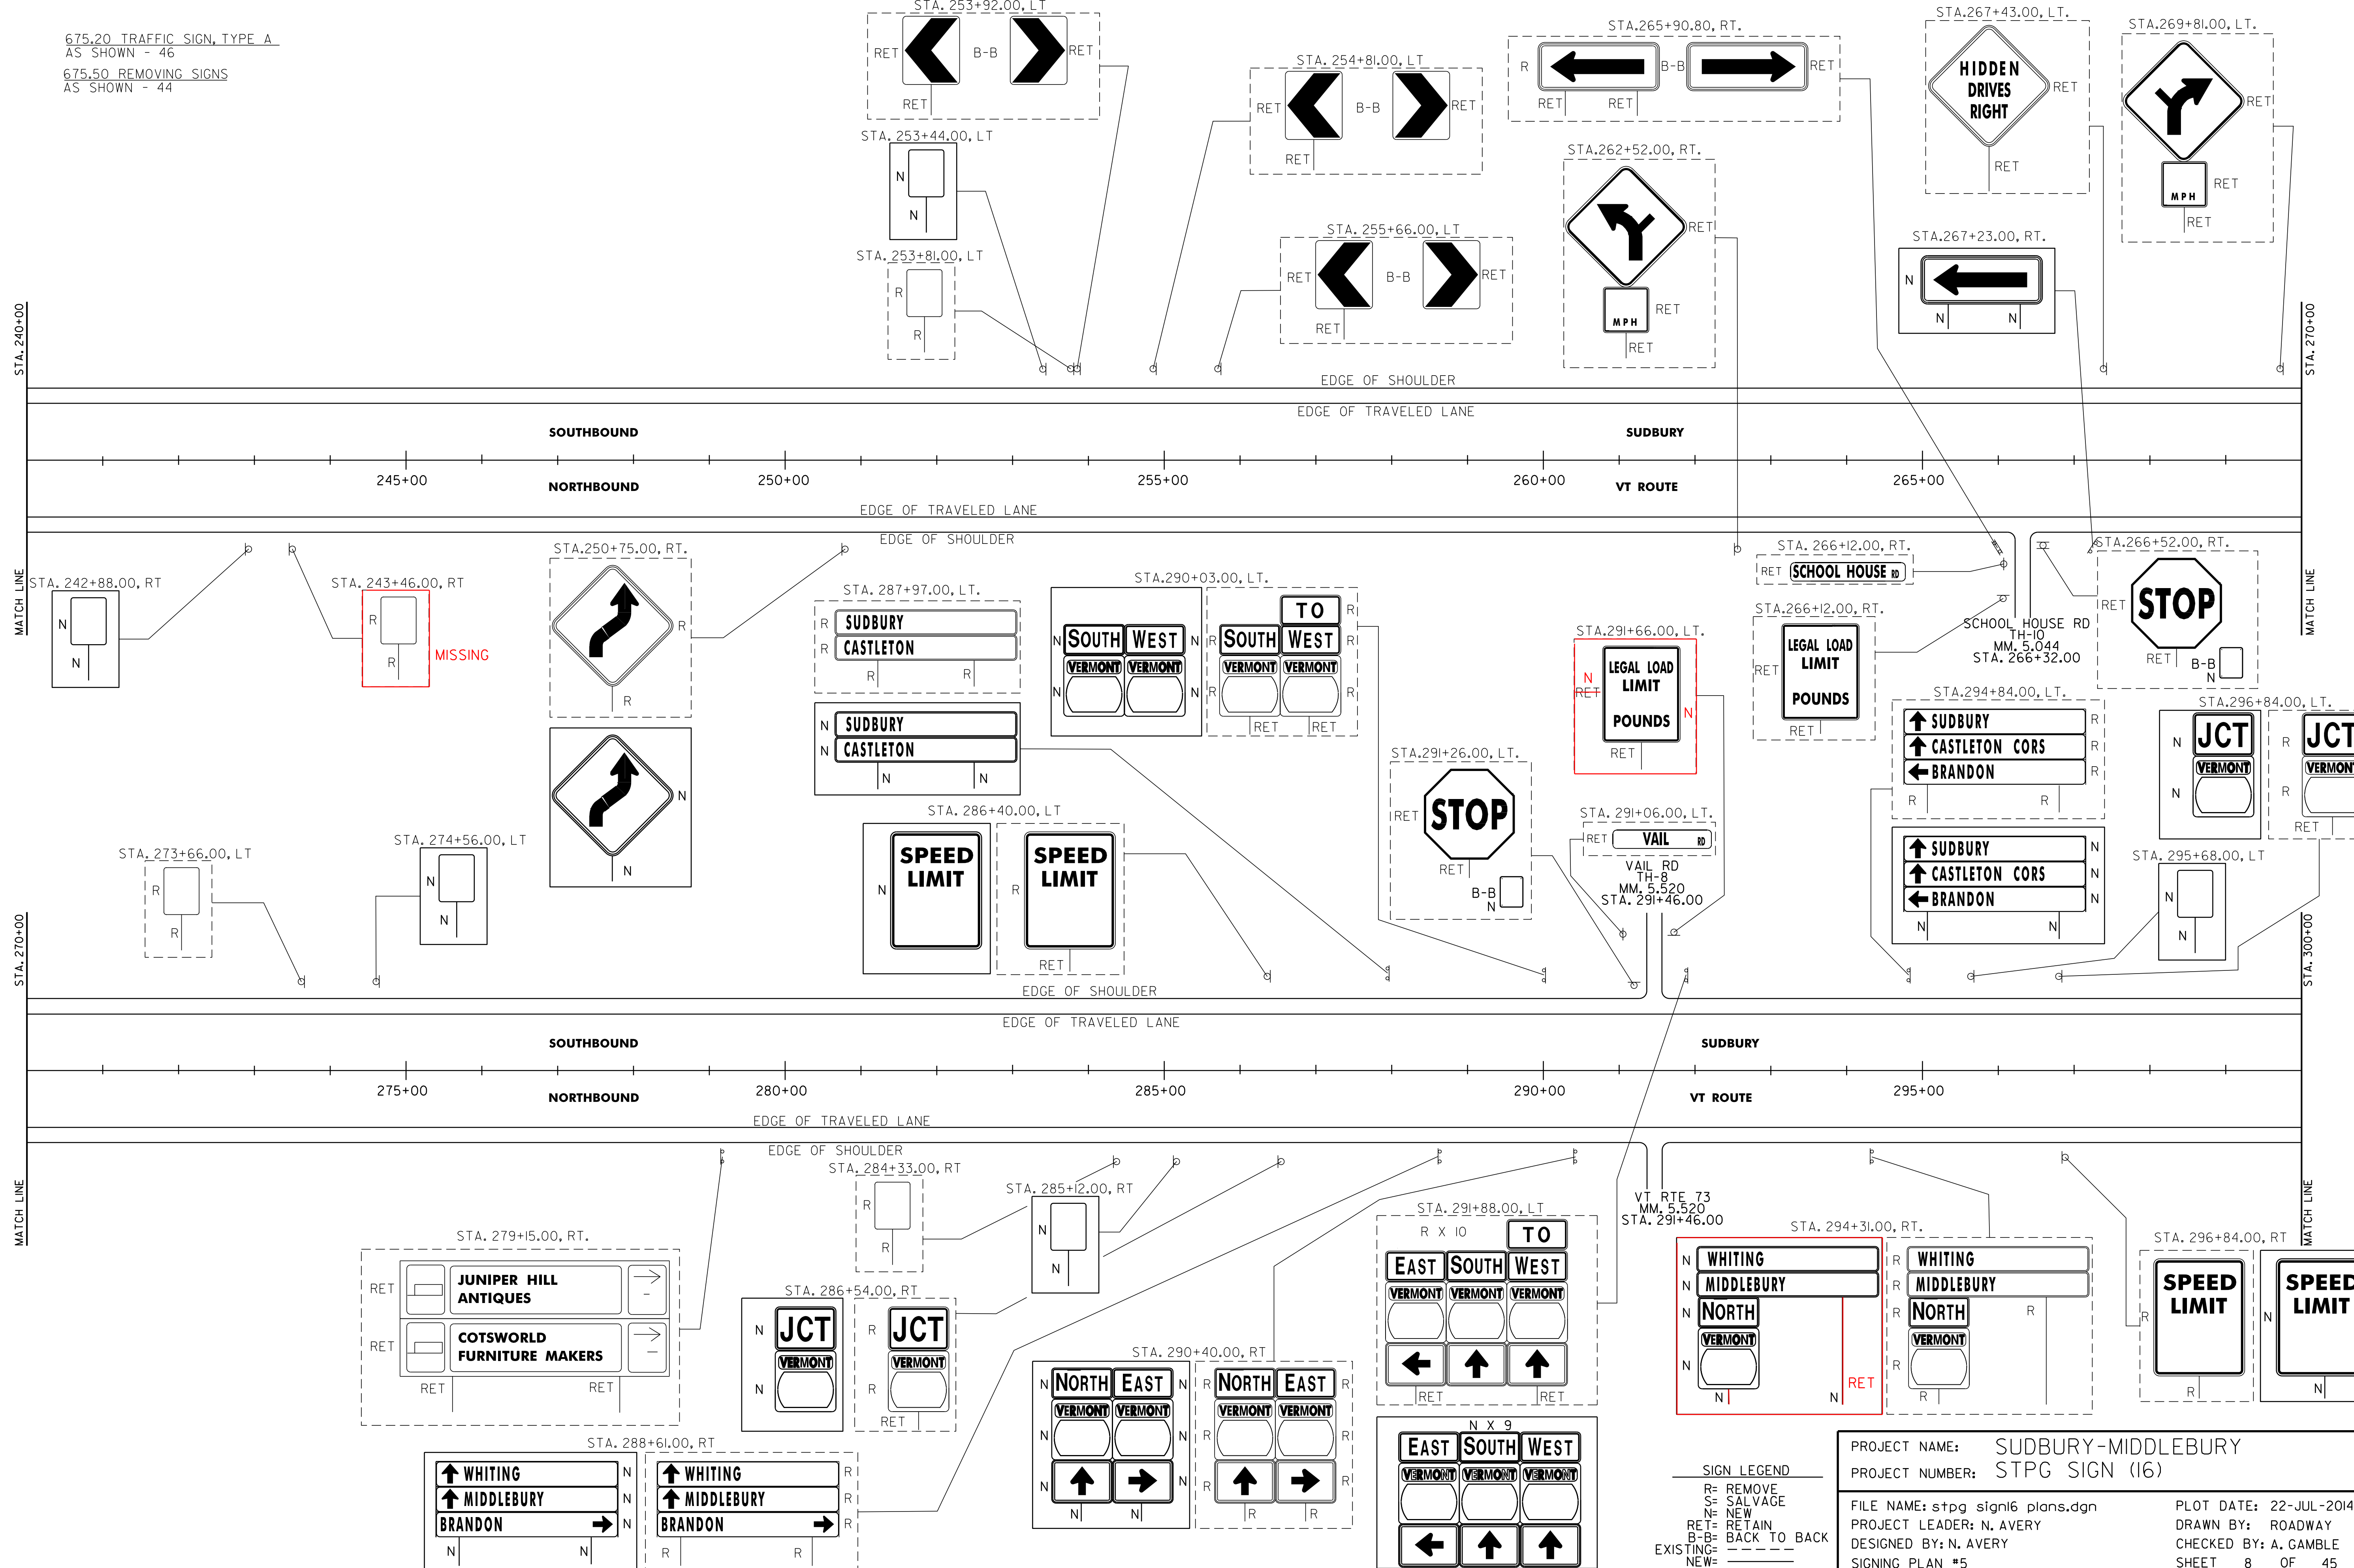

SIGN LEGEND
 R= REMOVE
 S= SALVAGE
 N= NEW
 RET= RETAIN
 B-B= BACK TO BACK
 EXISTING= ---
 NEW= - - -

PROJECT NAME: SUDBURY-MIDDLEBURY
 PROJECT NUMBER: STPG SIGN (16)
 FILE NAME: stpg sign16 plans.dgn
 PROJECT LEADER: N. AVERY
 DESIGNED BY: N. AVERY
 SIGNING PLAN #5
 PLOT DATE: 22-JUL-2014 16:49
 DRAWN BY: ROADWAY
 CHECKED BY: A. GAMBLE
 SHEET 8 OF 45