


675.20 TRAFFIC SIGN, TYPE A
AS SHOWN - 5
675.50 REMOVING SIGNS
AS SHOWN - 5
675.60 ERECTING SALVAGED SIGNS
AS SHOWN - 1
675.61 SETTING SALVAGED POSTS
AS SHOWN - 2

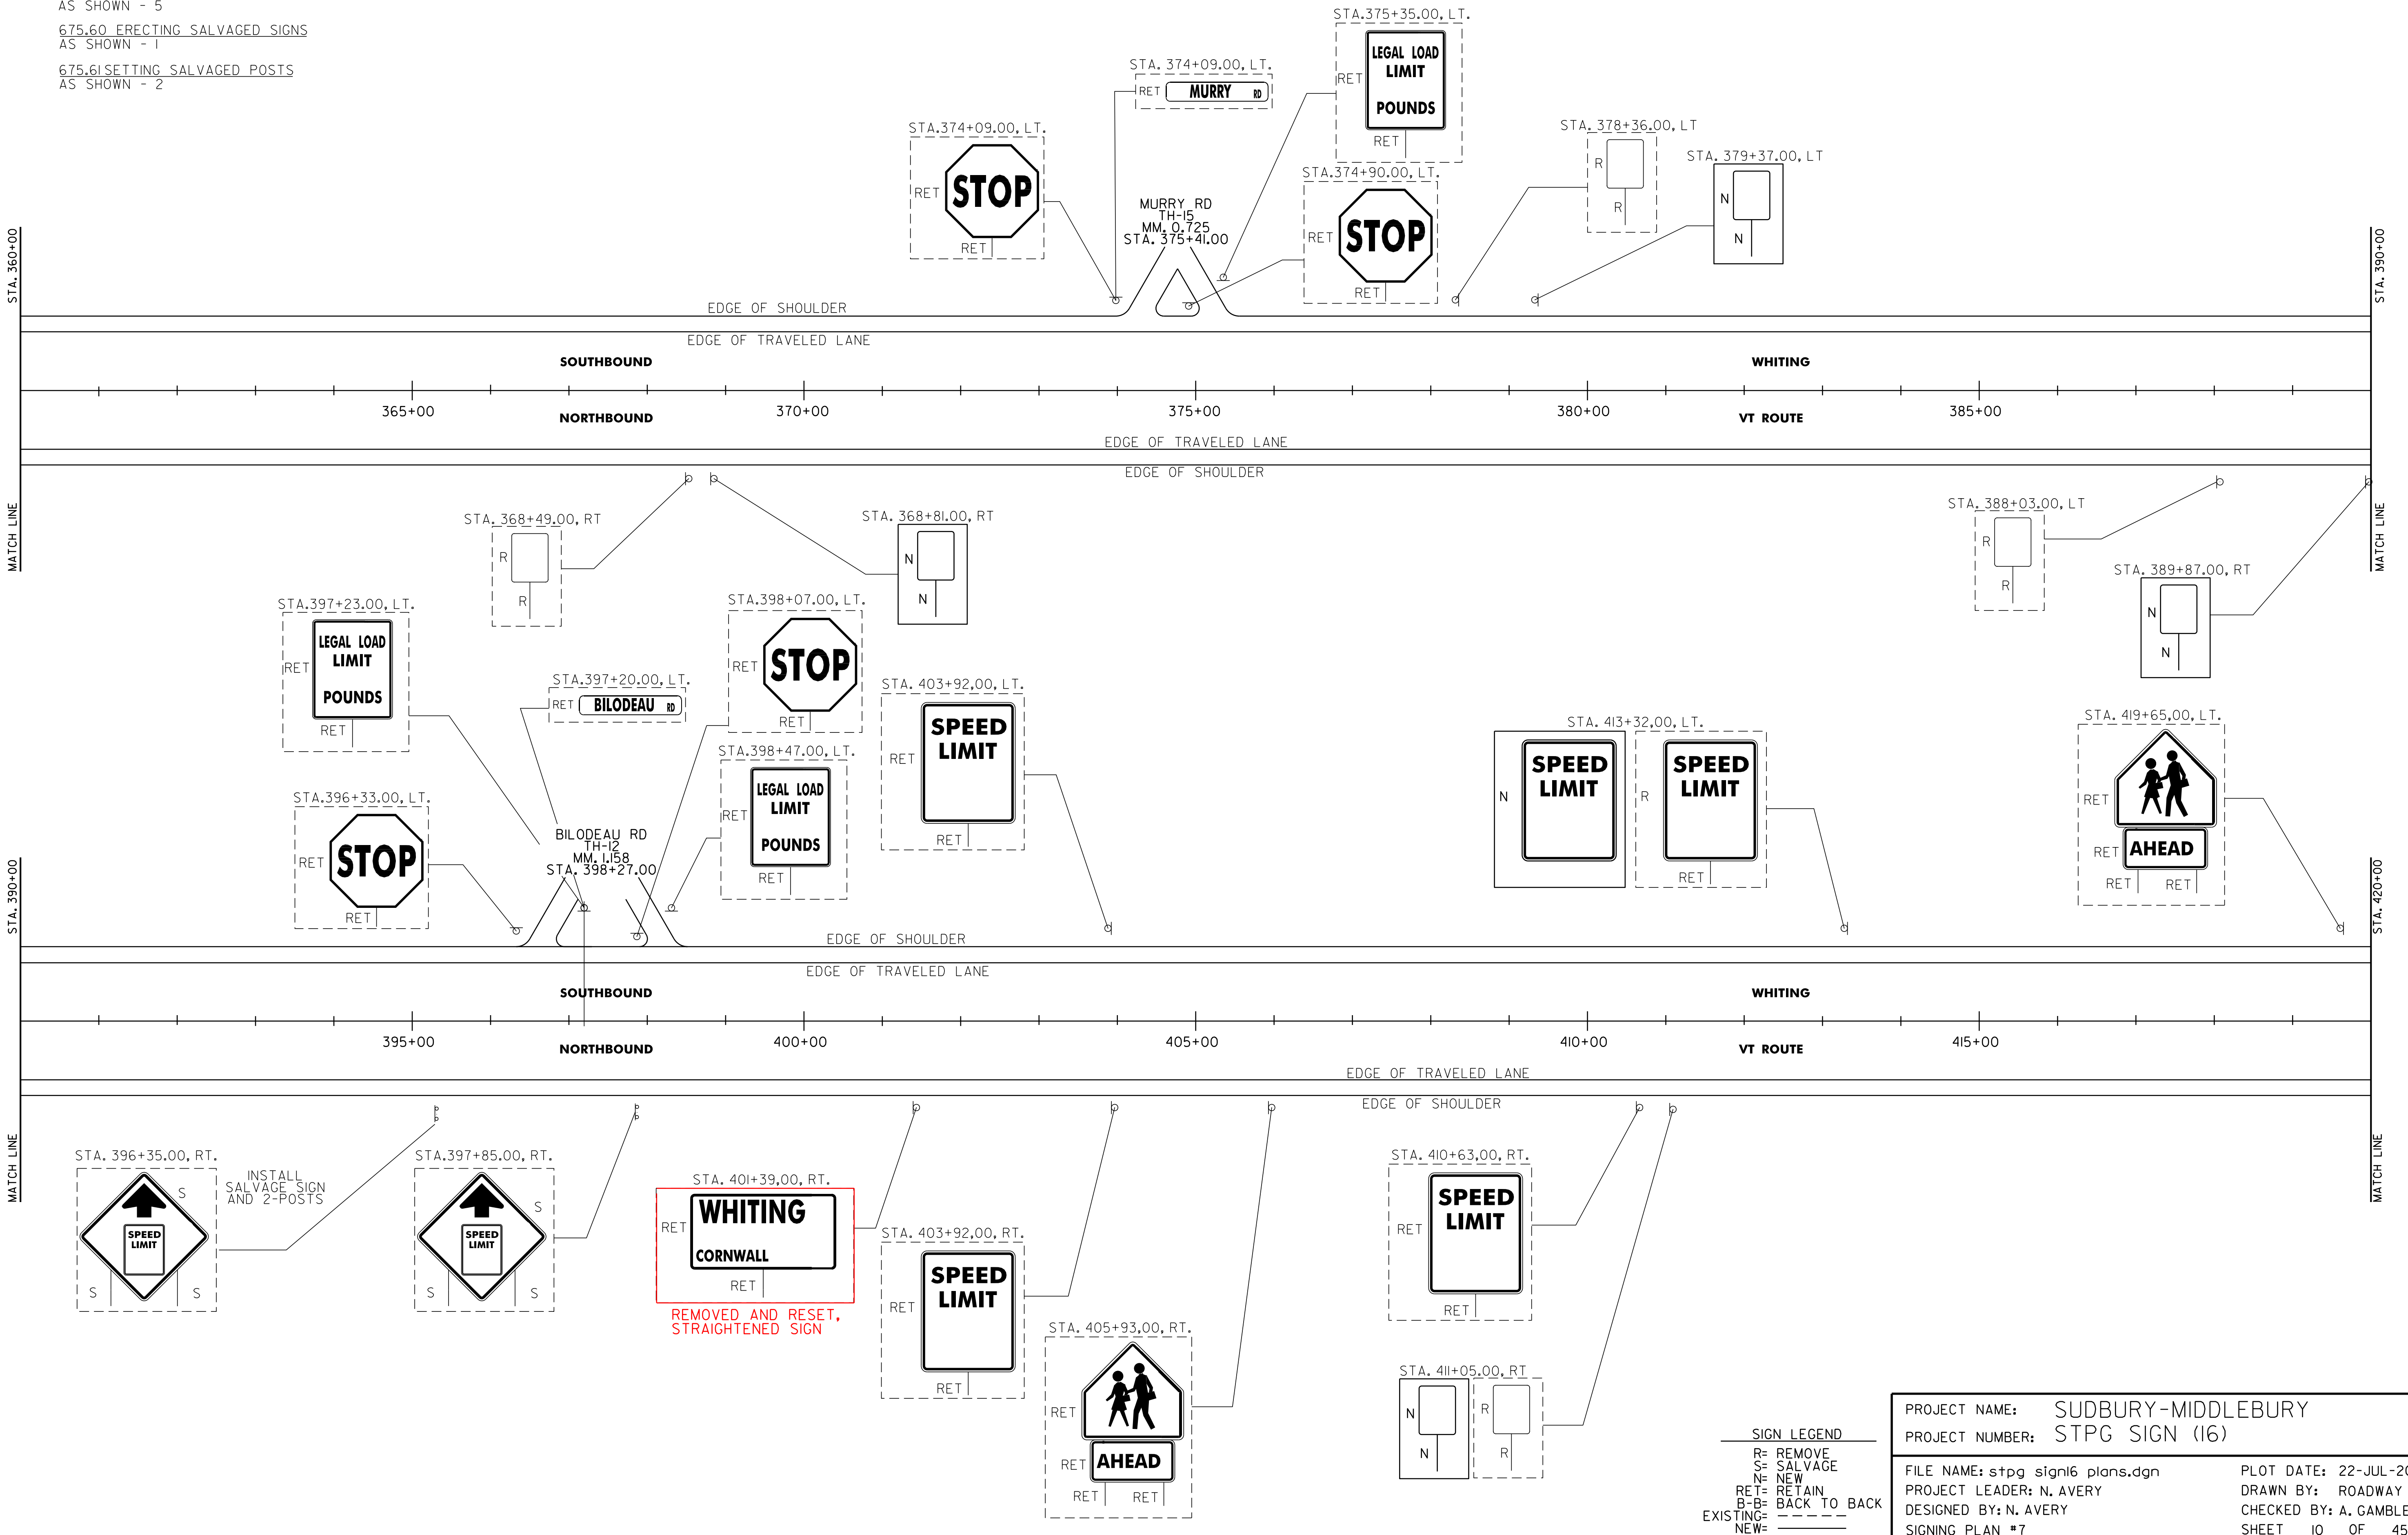

PROJECT NAME:	SUDBURY-MIDDLEBURY	FILE NAME:	stpg sign16 plans.dgn	PLOT DATE:	22-JUL-2014 16:49
PROJECT NUMBER:	STPG SIGN (16)	PROJECT LEADER:	N. AVERY	DRAWN BY:	ROADWAY
		DESIGNED BY:	N. AVERY	CHECKED BY:	A. GAMBLE
		SIGNING PLAN #	7	SHEET	10 OF 45

SIGN LEGEND
R= REMOVE
S= SALVAGE
N= NEW
RET= RETAIN
B-B= BACK TO BACK
EXISTING= - - - - -
NEW= _____

STA. 401+39.00, RT.
WHITING
CORNWALL
REMOVED AND RESET,
STRAIGHTENED SIGN

INSTALL
SALVAGE SIGN
AND 2-POSTS