


675.20 TRAFFIC SIGN, TYPE A
 AS SHOWN - 8
 675.50 REMOVING SIGNS
 AS SHOWN - 8

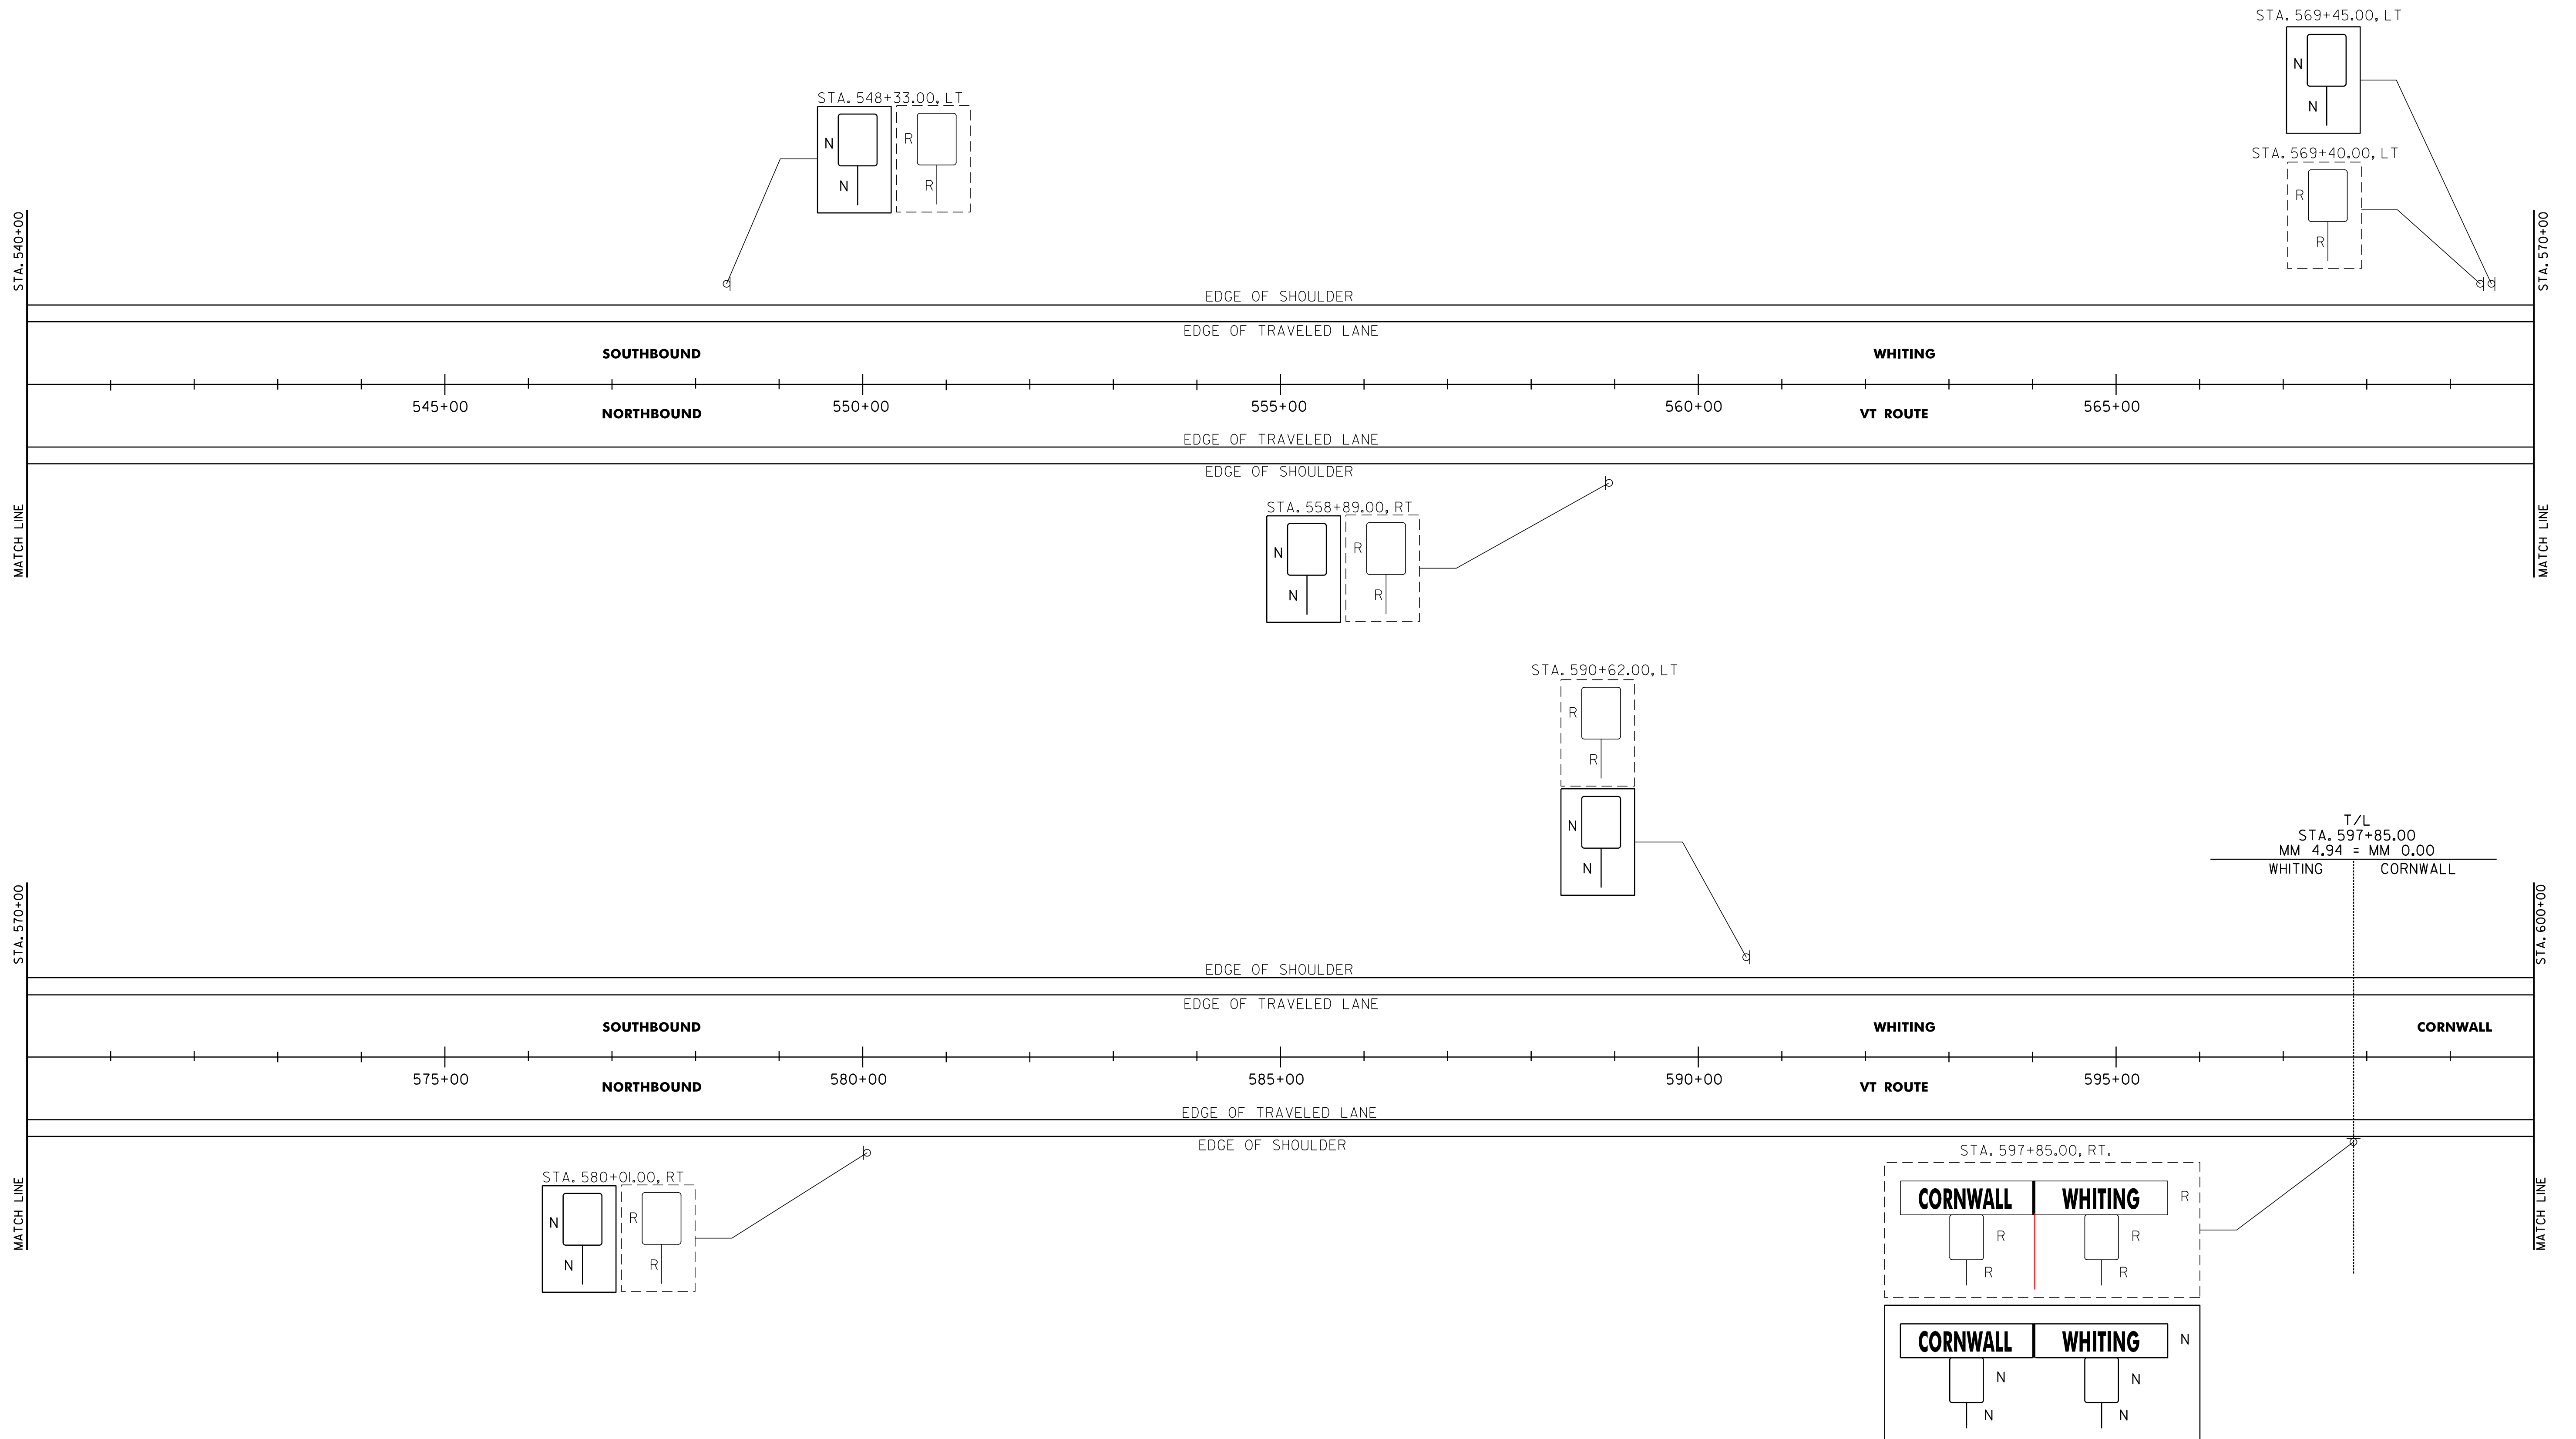

SIGN LEGEND
 R= REMOVE
 S= SALVAGE
 N= NEW
 RET= RETAIN
 B-B= BACK TO BACK
 EXISTING= - - - -
 NEW= _____

PROJECT NAME:	SUDBURY-MIDDLEBURY	FILE NAME:	stpg sign16 plans.dgn	PLOT DATE:	22-JUL-2014 16:49
PROJECT NUMBER:	STPG SIGN (16)	PROJECT LEADER:	N. AVERY	DRAWN BY:	ROADWAY
		DESIGNED BY:	N. AVERY	CHECKED BY:	A. GAMBLE
		SIGNING PLAN #10		SHEET	13 OF 45