


675.20 TRAFFIC SIGN, TYPE A  
 AS SHOWN - 14  
 675.50 REMOVING SIGNS  
 AS SHOWN - 12

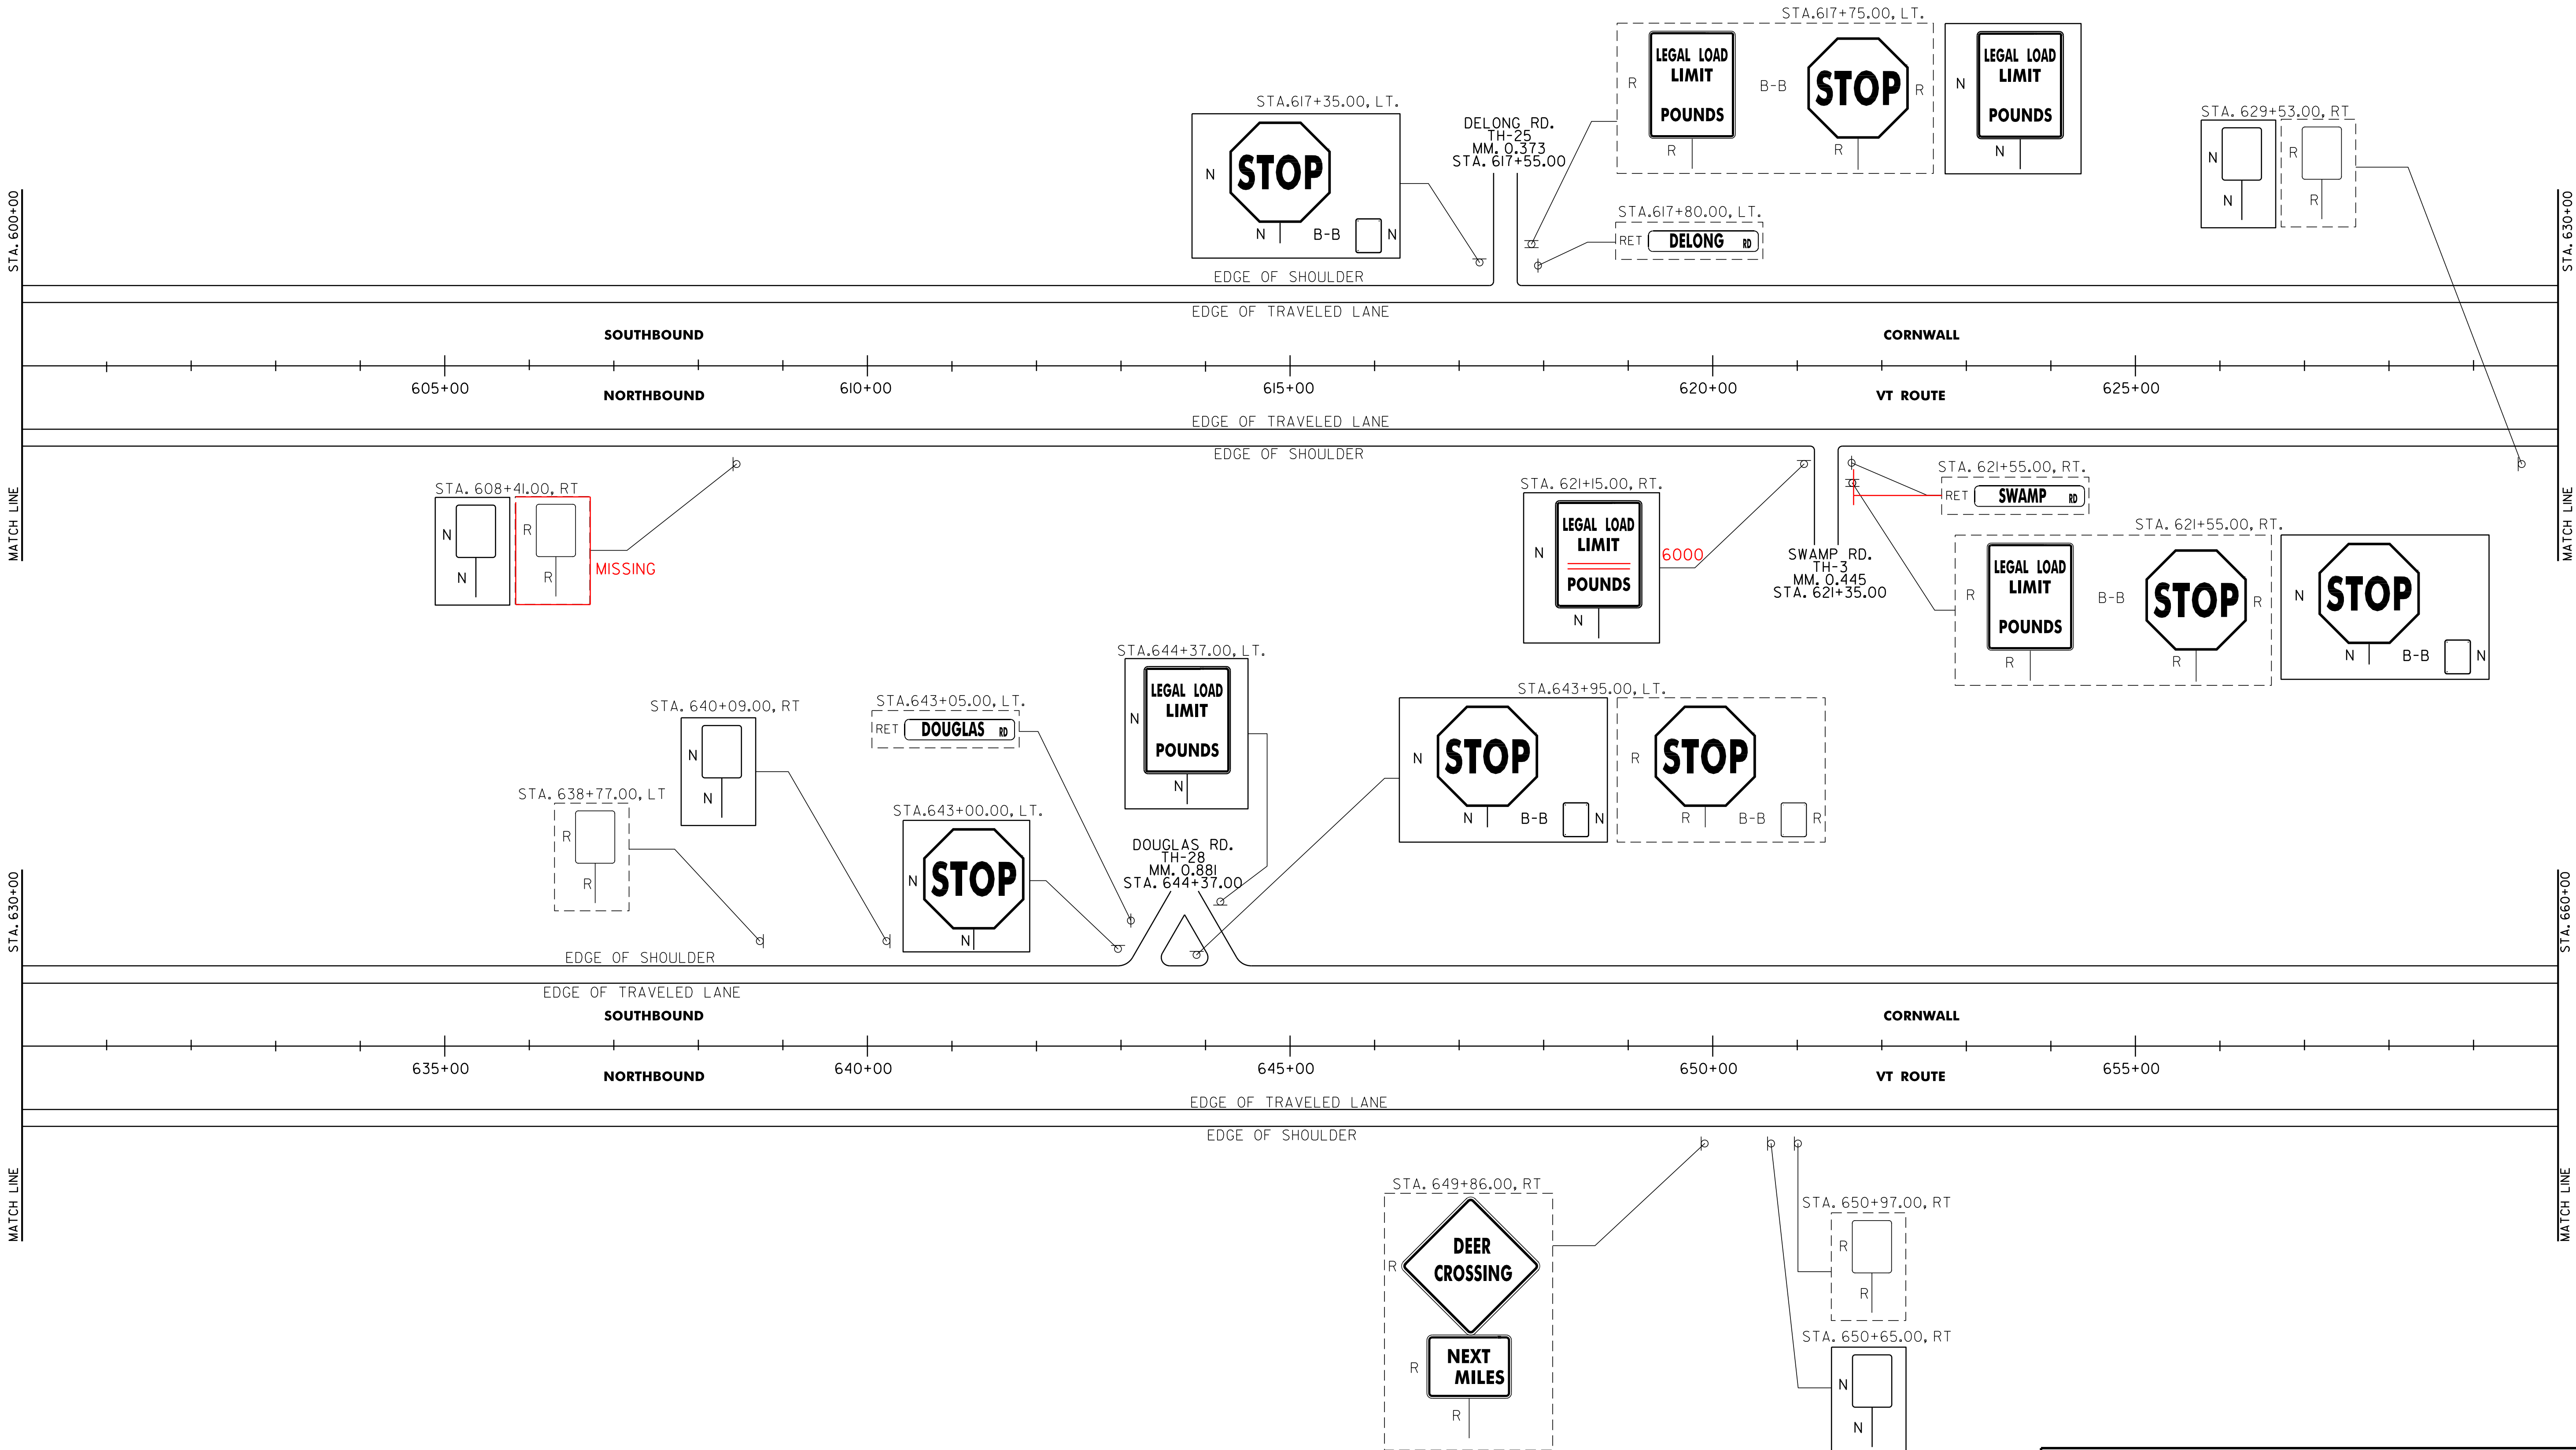

PROJECT NAME:	SUDBURY-MIDDLEBURY	FILE NAME:	stpg sign16 plans.dgn	PLOT DATE:	22-JUL-2014 16:49
PROJECT NUMBER:	STPG SIGN (16)	PROJECT LEADER:	N. AVERY	DRAWN BY:	ROADWAY
		DESIGNED BY:	N. AVERY	CHECKED BY:	A. GAMBLE
		SIGNING PLAN #11		SHEET	14 OF 45

**SIGN LEGEND**  
 R= REMOVE  
 S= SALVAGE  
 N= NEW  
 RET= RETAIN  
 B-B= BACK TO BACK  
 EXISTING= - - - - -  
 NEW= \_\_\_\_\_