


675.20 TRAFFIC SIGN, TYPE A  
AS SHOWN - 9

675.50 REMOVING SIGNS  
AS SHOWN - 10

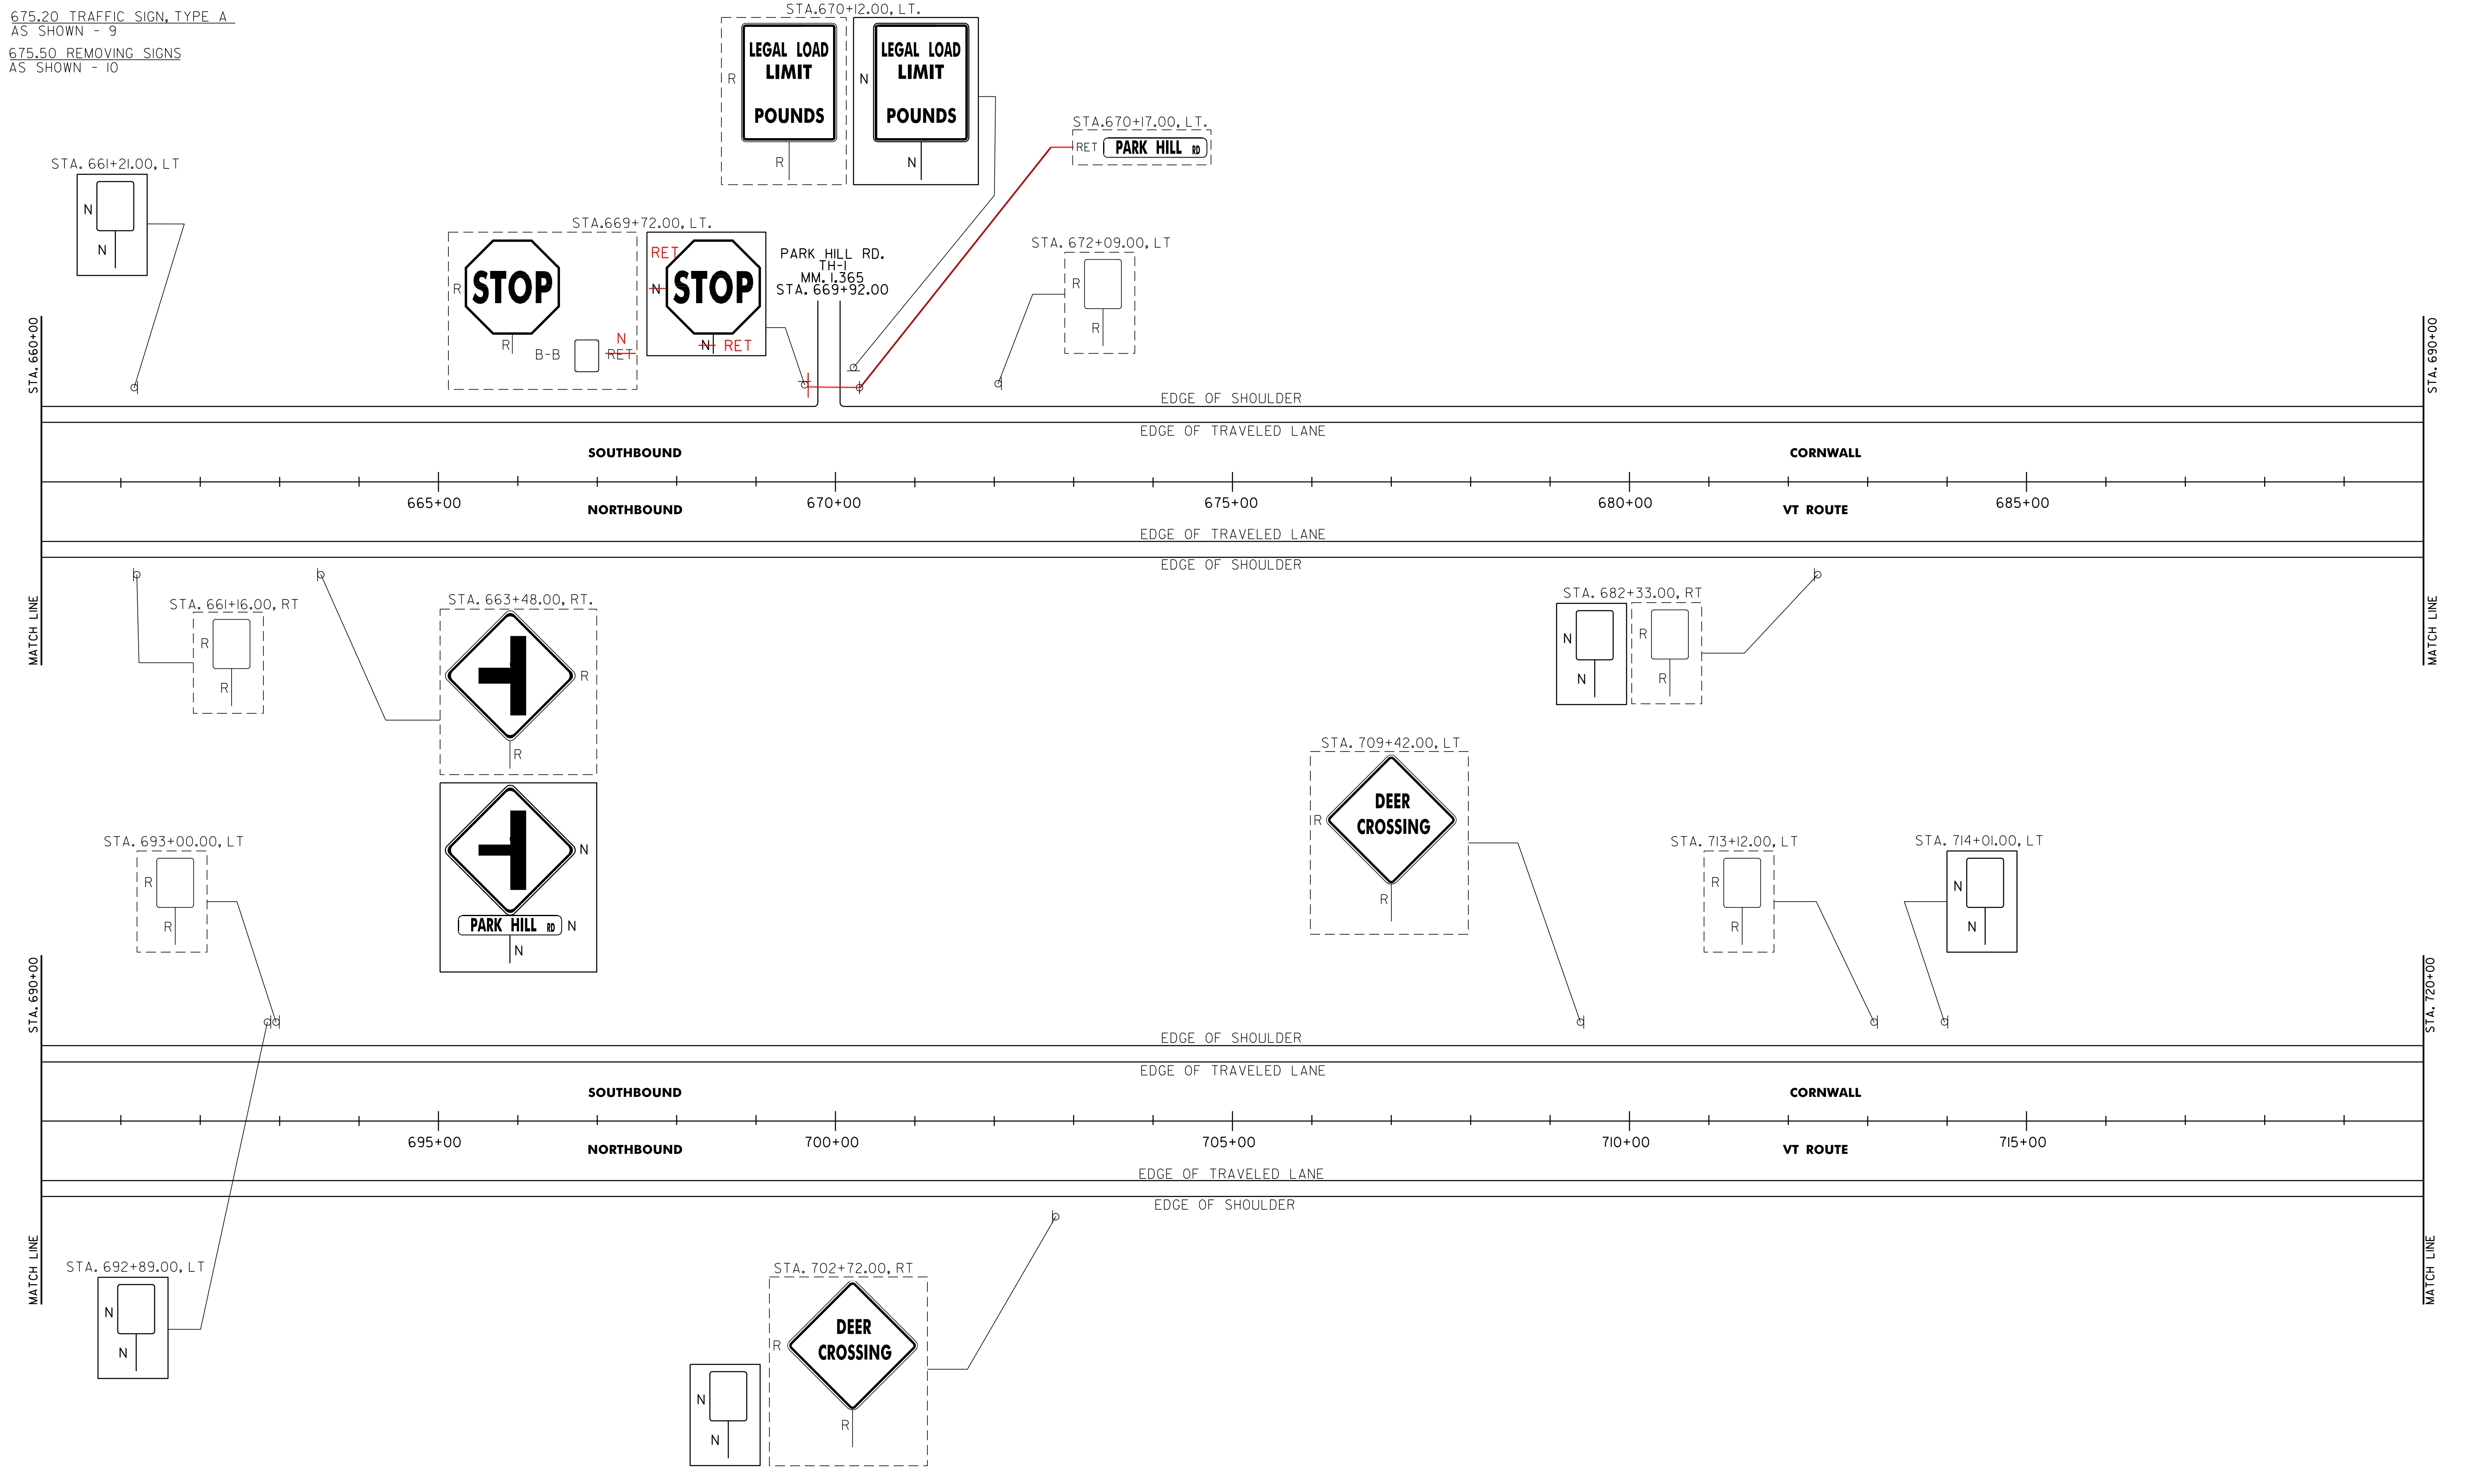

STA. 660+00

STA. 690+00

MATCH LINE

MATCH LINE

STA. 690+00

STA. 720+00

MATCH LINE

MATCH LINE

**SIGN LEGEND**

- R= REMOVE
- S= SALVAGE
- N= NEW
- RET= RETAIN
- B-B= BACK TO BACK
- EXISTING= - - - -
- NEW= \_\_\_\_\_

PROJECT NAME:	SUDBURY-MIDDLEBURY	FILE NAME:	stpg sign16 plans.dgn	PLOT DATE:	22-JUL-2014 16:49
PROJECT NUMBER:	STPG SIGN (16)	PROJECT LEADER:	N. AVERY	DRAWN BY:	ROADWAY
		DESIGNED BY:	N. AVERY	CHECKED BY:	A. GAMBLE
		SIGNING PLAN #12		SHEET	15 OF 45