
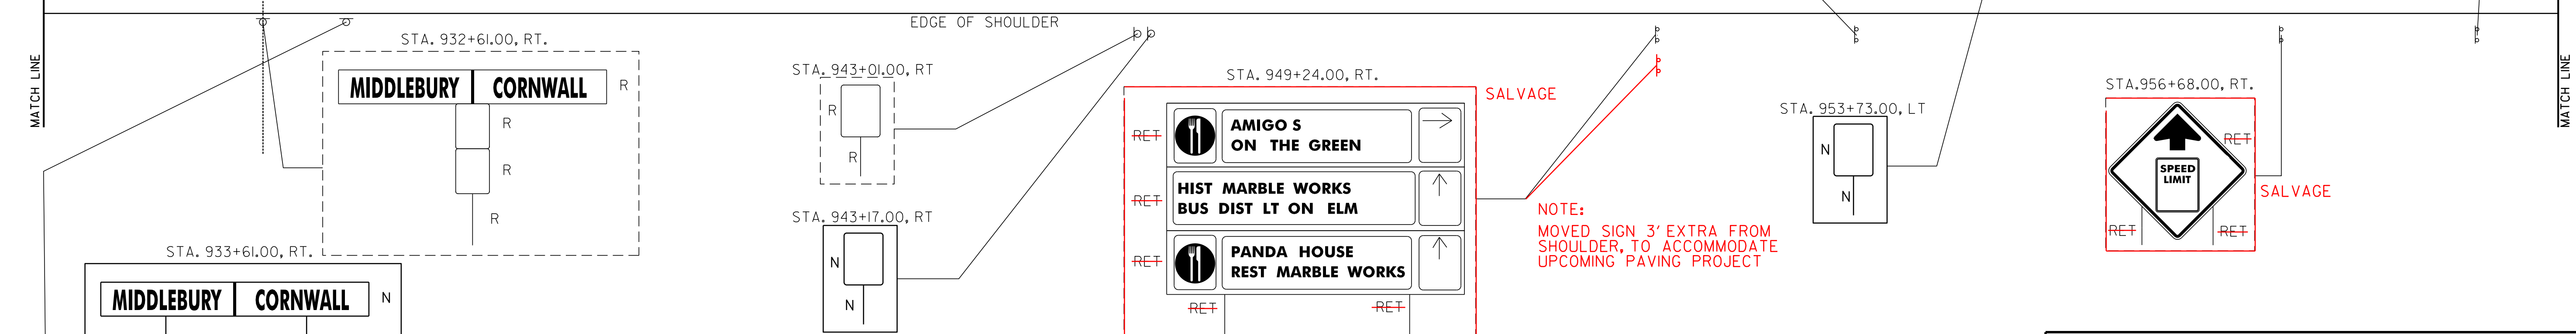
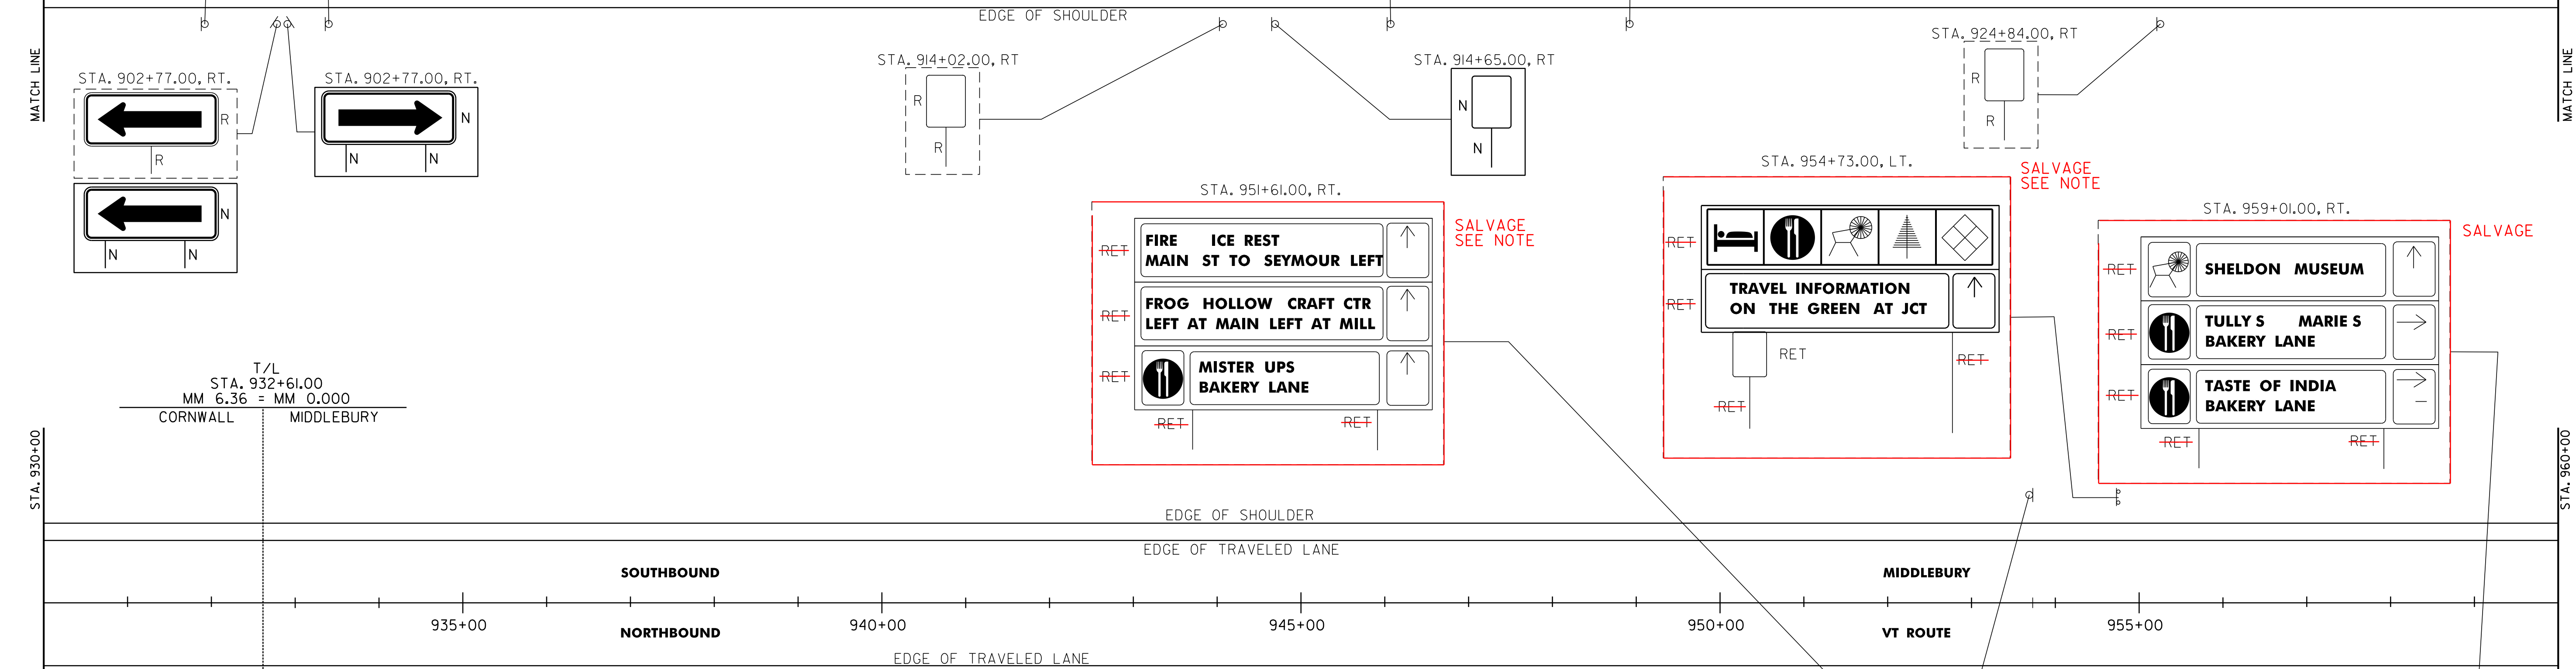


675.20 TRAFFIC SIGN, TYPE A
AS SHOWN - 17

675.50 REMOVING SIGNS
AS SHOWN - 14

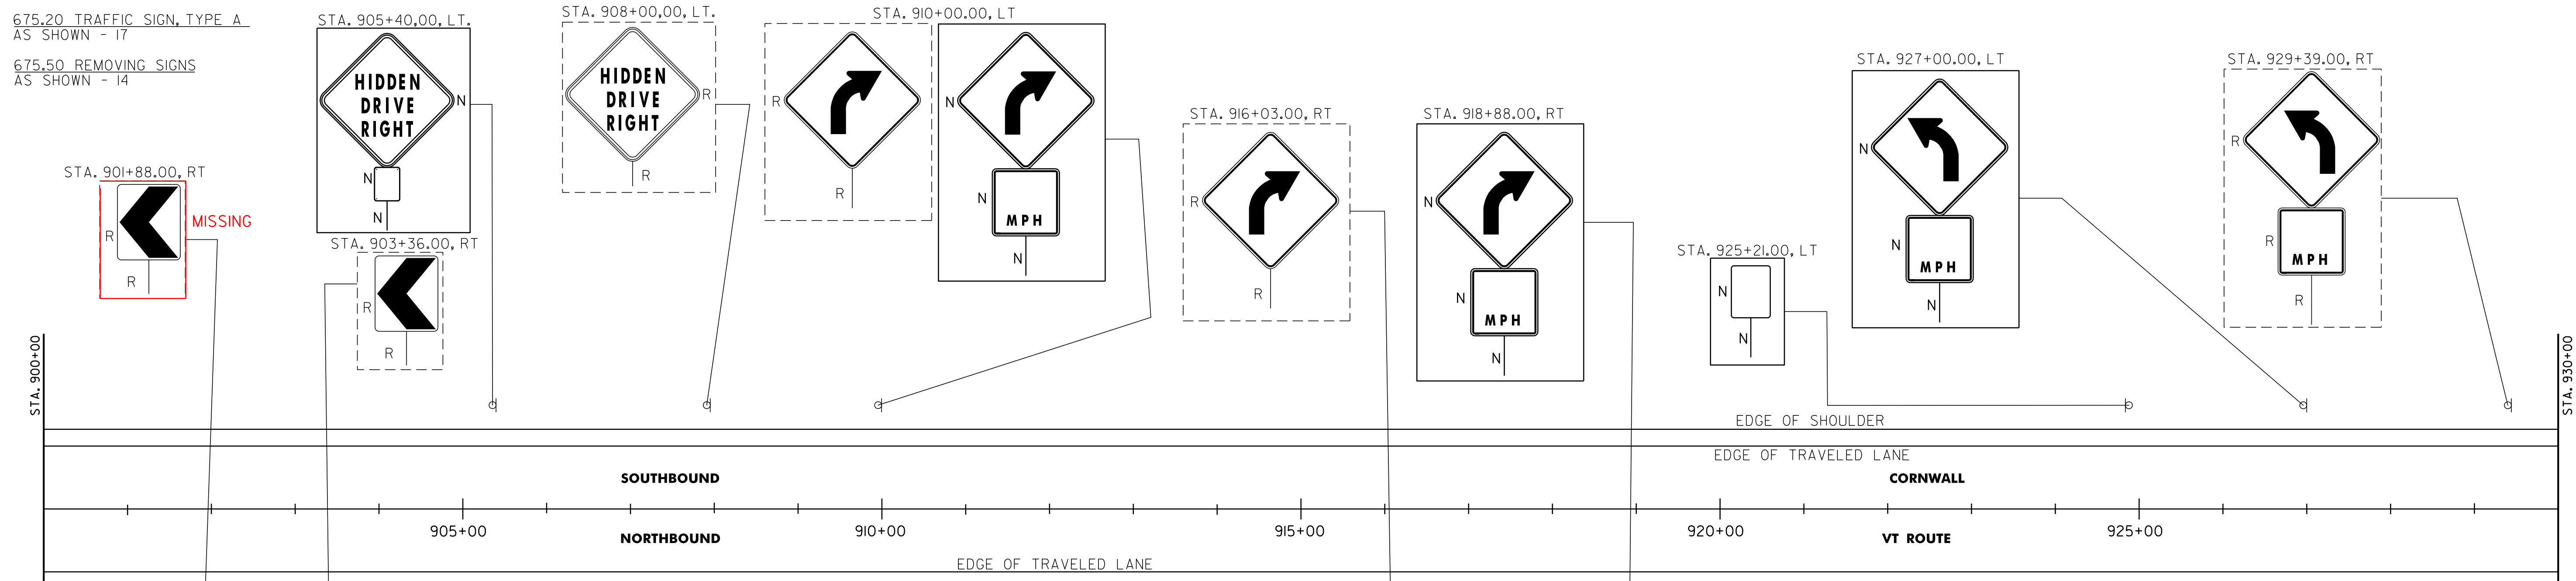

NOTE:
MOVED SIGN 3' EXTRA FROM
SHOULDER, TO ACCOMMODATE
UPCOMING PAVING PROJECT

SIGN LEGEND

- R= REMOVE
- S= SALVAGE
- N= NEW
- RET= RETAIN
- B-B= BACK TO BACK
- EXISTING= - - - - -
- NEW= _____

PROJECT NAME:	SUDBURY-MIDDLEBURY	FILE NAME:	stpg sign16 plans.dgn	PLOT DATE:	22-JUL-2014 16:49
PROJECT NUMBER:	STPG SIGN (16)	PROJECT LEADER:	N. AVERY	DRAWN BY:	ROADWAY
		DESIGNED BY:	N. AVERY	CHECKED BY:	A. GAMBLE
		SIGNING PLAN #17			SHEET 20 OF 45