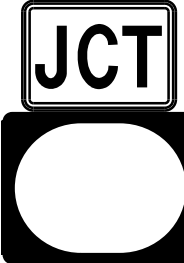

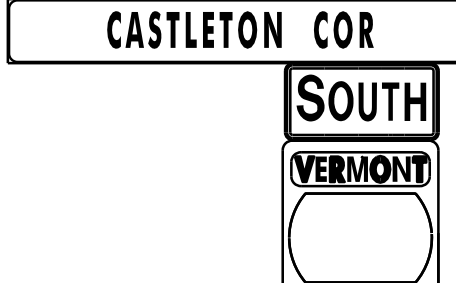


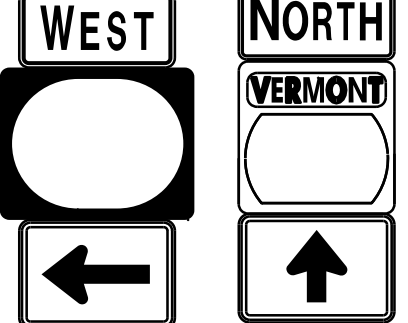
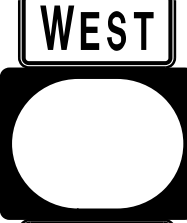


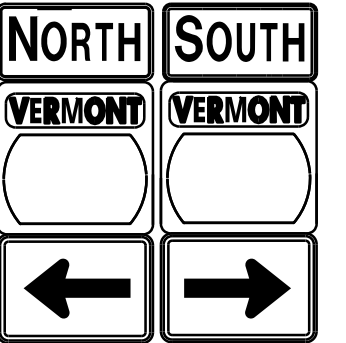





# TRAFFIC SIGN SUMMARY SHEET

MILEMARKER, STATION, OR SIGN NUMBER	SIGN LEGEND	SIGN DIMENSIONS		NEW & SALVAGED SIGNS				EXIST POST	NO. OF POSTS	NEW SIGN POSTS																REMARKS	SIGN DETAIL							
				"A"	"B"	SALV SIGN	SALV TIS			FLANGED CHANNEL			SQUARE STEEL (in)			TUBULAR ALUMINUM Ø (in)			TUBULAR STEEL Ø (in)				W-SHAPE STEEL		REQUIRE SIGNMENT		DETAIL ON SHEET NUMBER	STD. SHEET NUMBER						
		1.12	2.0							3.0	2.0	2.0	2.5	3.0	4.0	4.0 MOD	FOUND-ATION	3.0	3.5	4.0	5.0	FTG. SIZE	WEIGHT	POST SIZE										
		lb/ft		lb/ft			lb/ft			lb/ft				24"	30"																			
									OPTION ITEMS																									
STA. 050+37.00, RT.		1	21	15	2.19				1																		M2-1		E-136C					
		1	30	24	5.00																						MI-6							
STA. 54+81.00, LT.		1	72	12	6.00				2																		D2-1							
		1	24	12	2.00																													
		1	24	24	4.00																													
STA. 056+92.00, RT.		2	24	12	4.00																													
		1	30	24	5.00																													
		1	24	24	4.00																													
		2	21	15	4.38																													
STA. 057+18.00, RT.		2	72	12	6.0				2																									
		2	24	12	4.00																													
		2	24	24	8.00																													
		2	21	15	4.38																													
	