



SEE SHEET 2 FOR INDEX OF SHEETS
AND LIST OF STANDARDS

STATE OF VERMONT AGENCY OF TRANSPORTATION

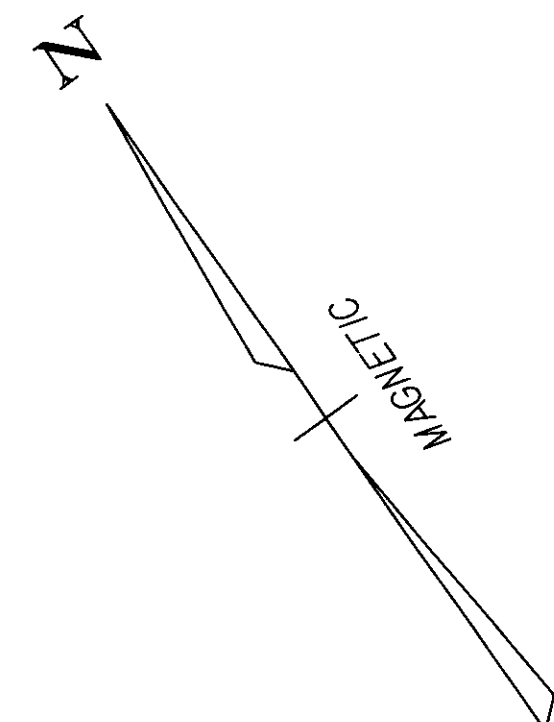

PROPOSED IMPROVEMENT BRIDGE PROJECT TOWN OF FAIRLEE COUNTY OF ORANGE

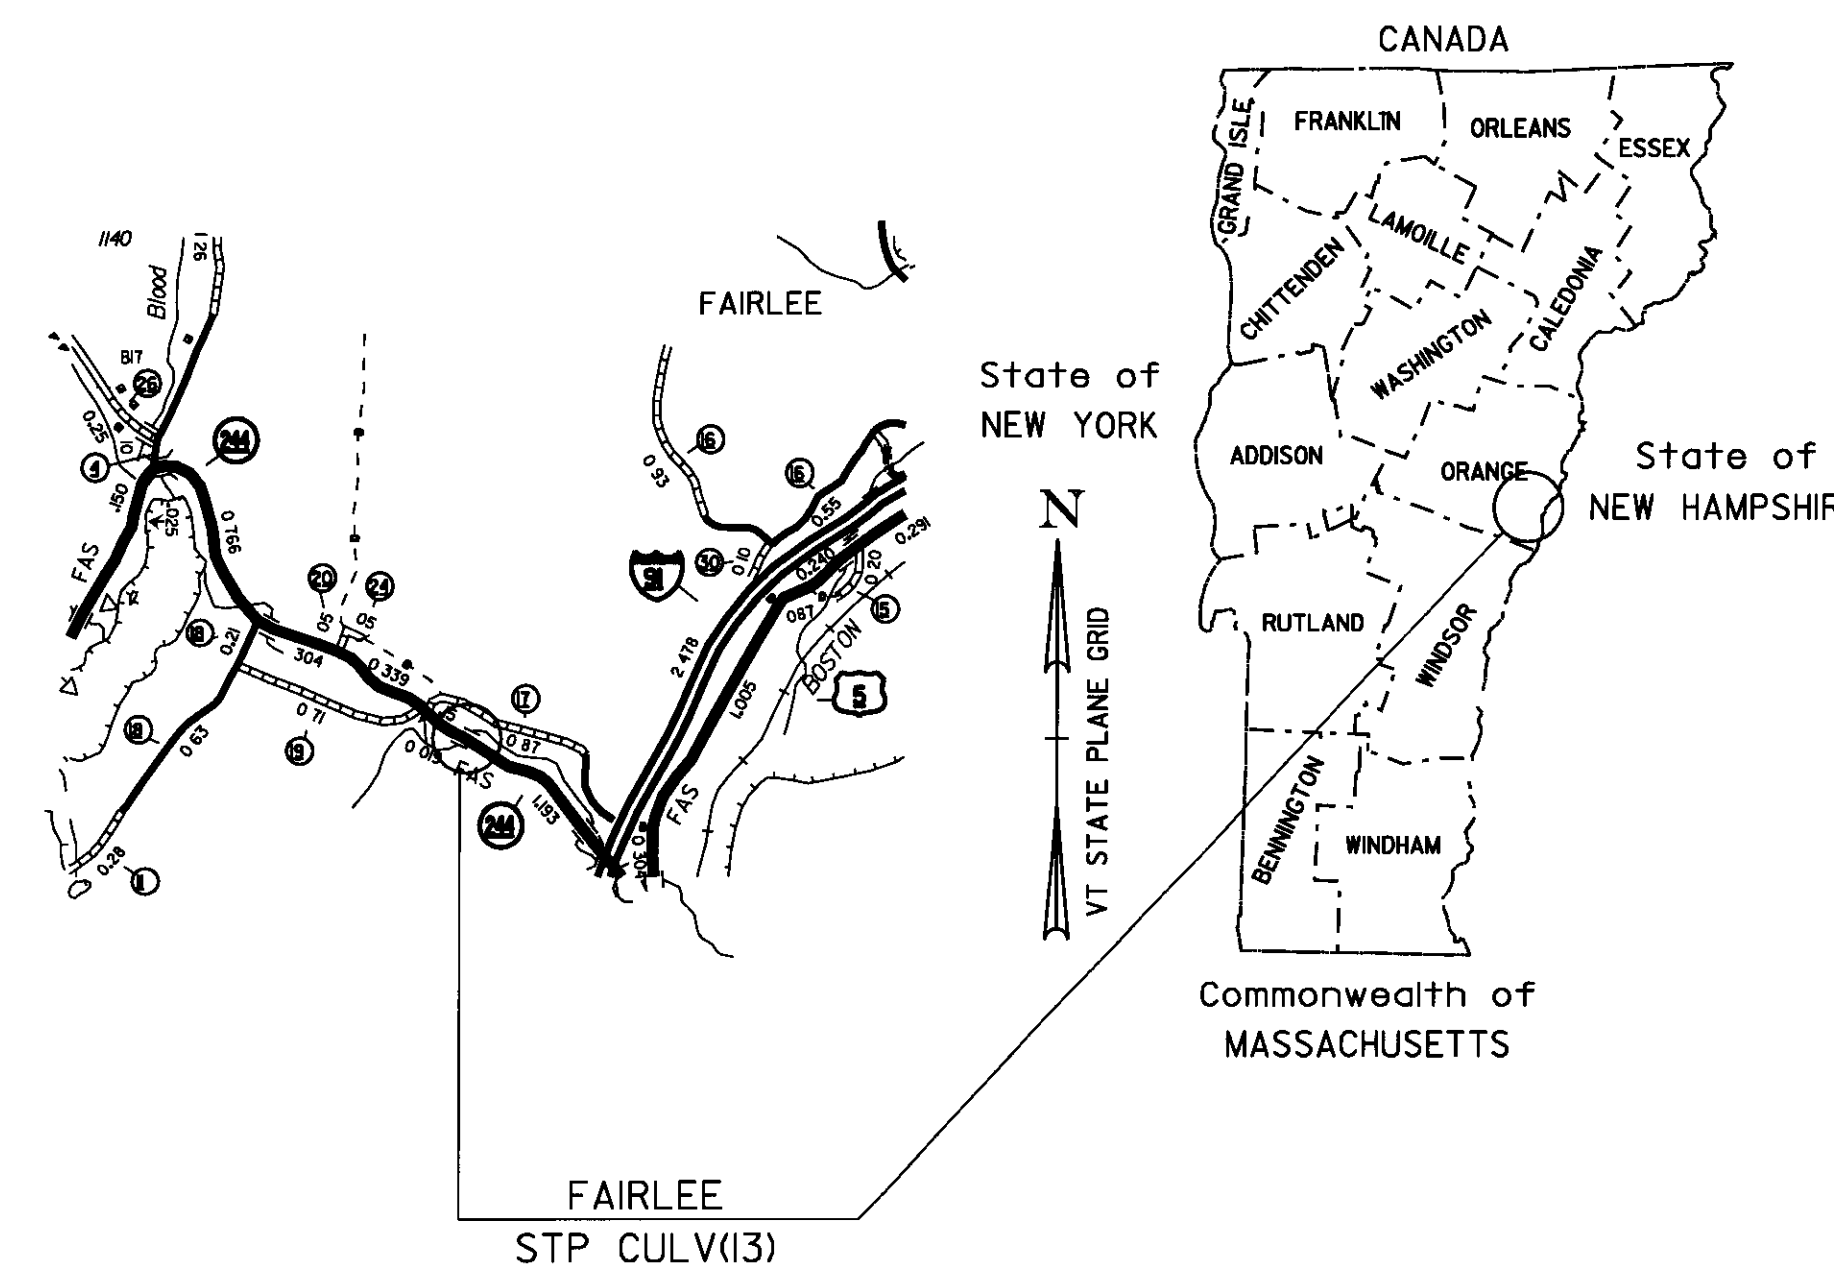


ROUTE NO : VT RT 244, RURAL MAJOR COLLECTOR BRIDGE NO : 9

PROJECT LOCATION: BEGINNING AT A POINT APPROXIMATELY 1.0 MI FROM THE JUNCTION OF VT 244 AND US 5 AND EXTENDING EASTERLY ALONG VT 244 FOR 125 FT.

PROJECT DESCRIPTION: REMOVAL OF EXISTING CULVERT AND REPLACEMENT WITH A NEW REINFORCED CONCRETE BOX CULVERT.

LENGTH OF STRUCTURE: N/A FEET
LENGTH OF ROADWAY: 125 FEET
LENGTH OF PROJECT: 125 FEET

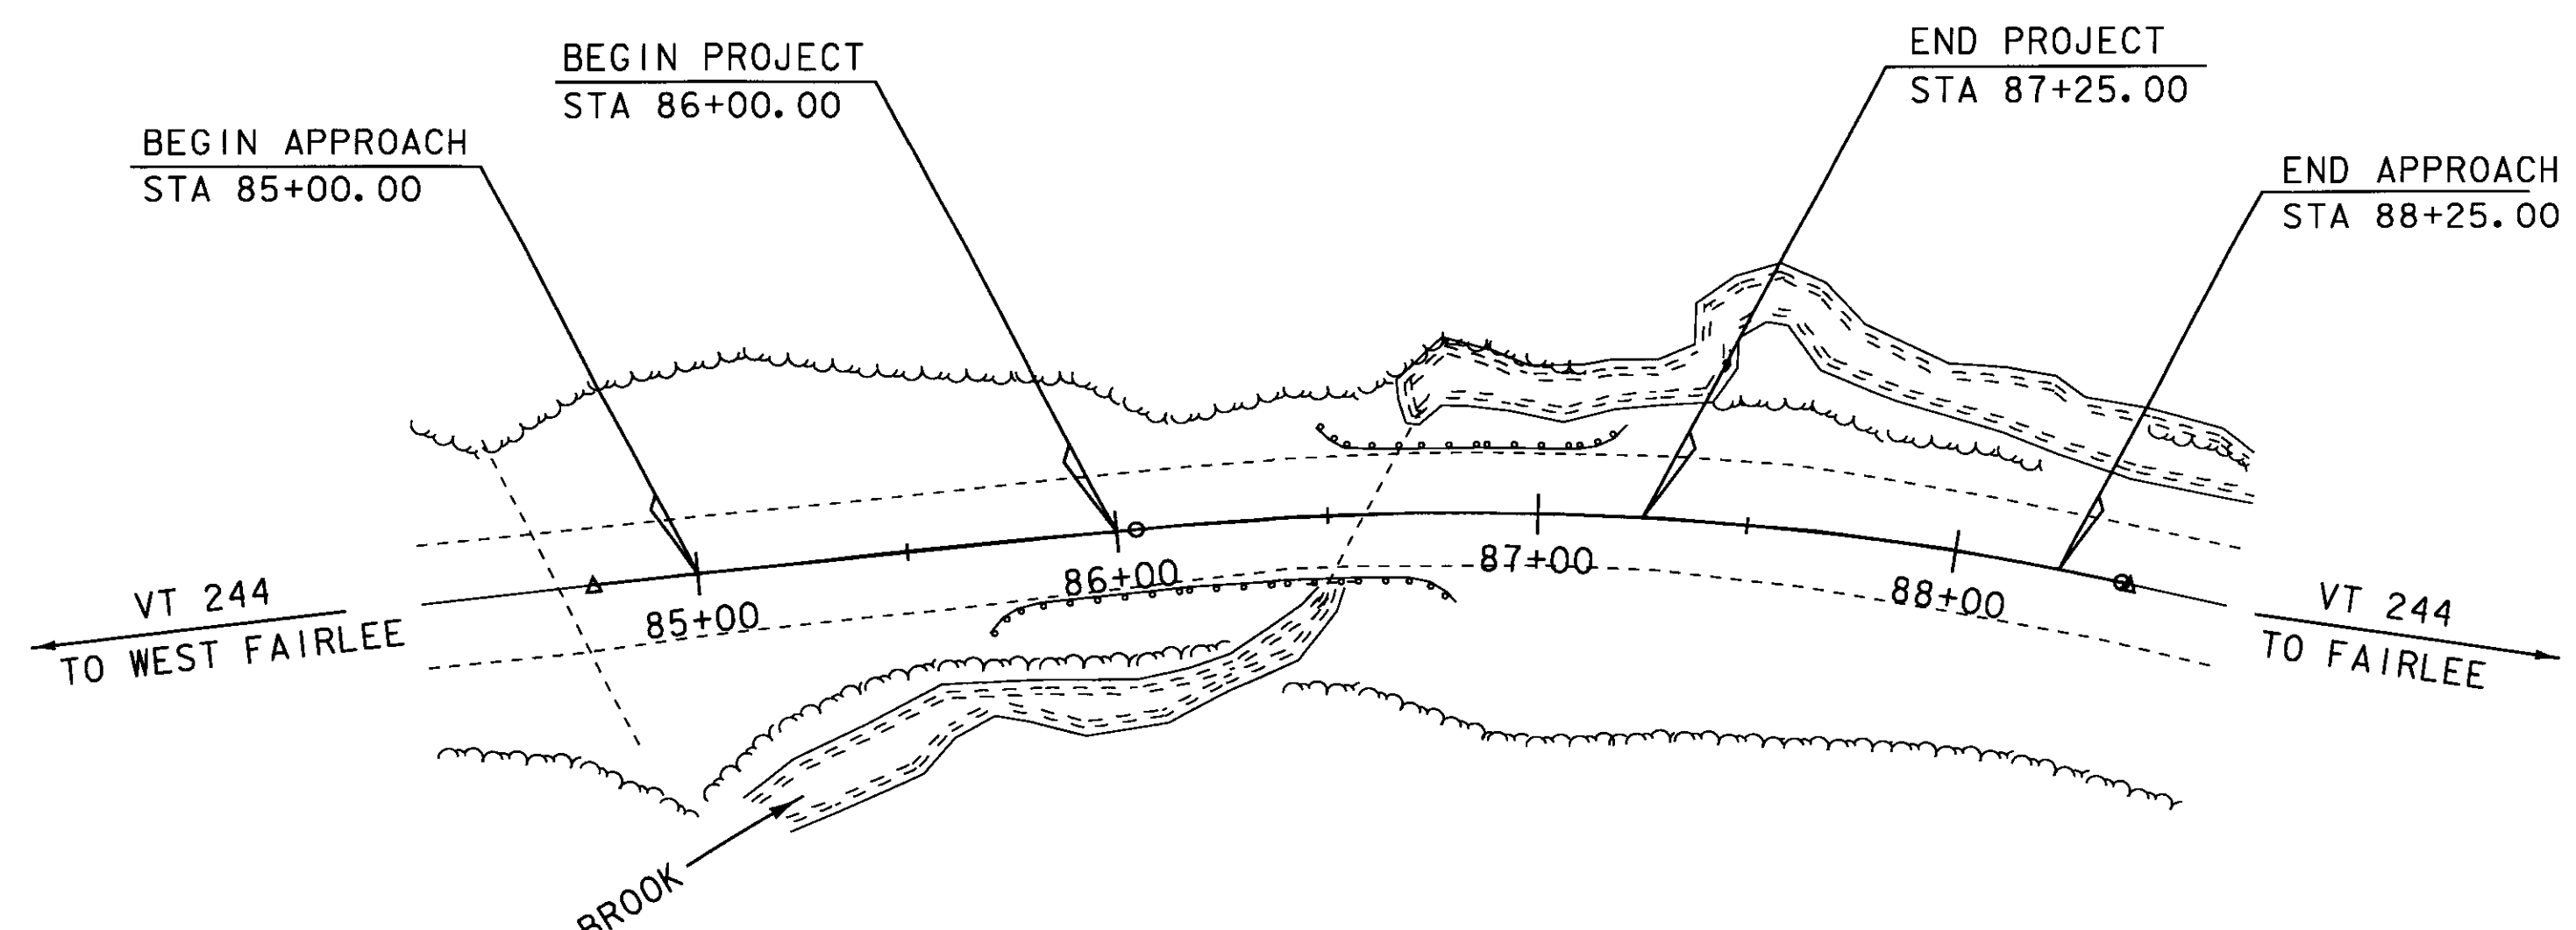

RECORD PLANS	
CONTRACTOR	G.W. TATRO CONSTRUCTION, INC. - JEFFERSONVILLE, VT
RESIDENT ENGINEER	JIM FOREST
CONSTRUCTION BEGAN	AUGUST 3, 2009
CONSTRUCTION COMPLETE	OCTOBER 30, 2009
RECORD PLANS BY	JIM FOREST & NICK GARBACIK
I HEREBY CERTIFY THAT ALL THE CONSTRUCTION REQUIRED BY THIS SET OF DRAWINGS HAS BEEN ACCOMPLISHED AS INDICATED HEREIN	
BY	<i>James C. Forest</i> RESIDENT ENGINEER
DATE	11-15-10
NOTE: Any further information concerning final quantities, amounts or other details relative to this project may be found at Central Files in the electronic archives	

CONVENTIONAL SYMBOLS	
COUNTY LINE	
TOWN LINE	
LIMITS OF ACCESS	
POINT OF ACCESS	
FENCE LINE	
STONE WALL	
TRAVELED WAY	
GUARD RAIL	
RAILROAD	
SURVEY LINE	
CULVERT	
POWER POLE	
TELEPHONE POLE	
TREES	
CONTROL OF ACCESS	
PROPERTY LINE	
R.O.W. TAKING LINE	
SLOPE RIGHTS	
TOP OF CUT	
TOE OF SLOPE	

SURVEYED BY : R. GILMAN
SURVEYED DATE : 6/18/2008
DATUM
VERTICAL NAVD88
HORIZONTAL NAD83 (2007)

SCALE 1" = 40'-0"
40 0 40

THESE PLANS ARE SUBJECT TO SUCH ENGINEERING CHANGES AS MAY BE REQUIRED BY THE FEDERAL HIGHWAY ADMINISTRATION OR THE DIRECTOR OF PROGRAM DEVELOPMENT.
CONSTRUCTION IS TO BE CARRIED ON IN ACCORDANCE WITH THESE PLANS AND THE STANDARD SPECIFICATIONS FOR CONSTRUCTION DATED 2006, AS APPROVED BY THE FEDERAL HIGHWAY ADMINISTRATION ON JUNE 15, 2006 FOR USE ON THIS PROJECT, INCLUDING ALL SUBSEQUENT REVISIONS AND SUCH REVISED SPECIFICATIONS AND SPECIAL PROVISIONS AS ARE INCORPORATED IN THESE PLANS.
PLOTTED 11-MAR-2009

DIRECTOR OF PROGRAM DEVELOPMENT
APPROVED *John P. ...* DATE 3/12/09
PROJECT MANAGER : C.P. WILLIAMS
PROJECT NAME : FAIRLEE
PROJECT NUMBER : STP CULV (13)
SHEET 1 OF 26 SHEETS