


VT114 Norton-Averill-Canaan IM SURF(13) (2009)

Profiled 11/5/08

NB Avg. IRI = 120.4 SB Avg. IRI = 101.7

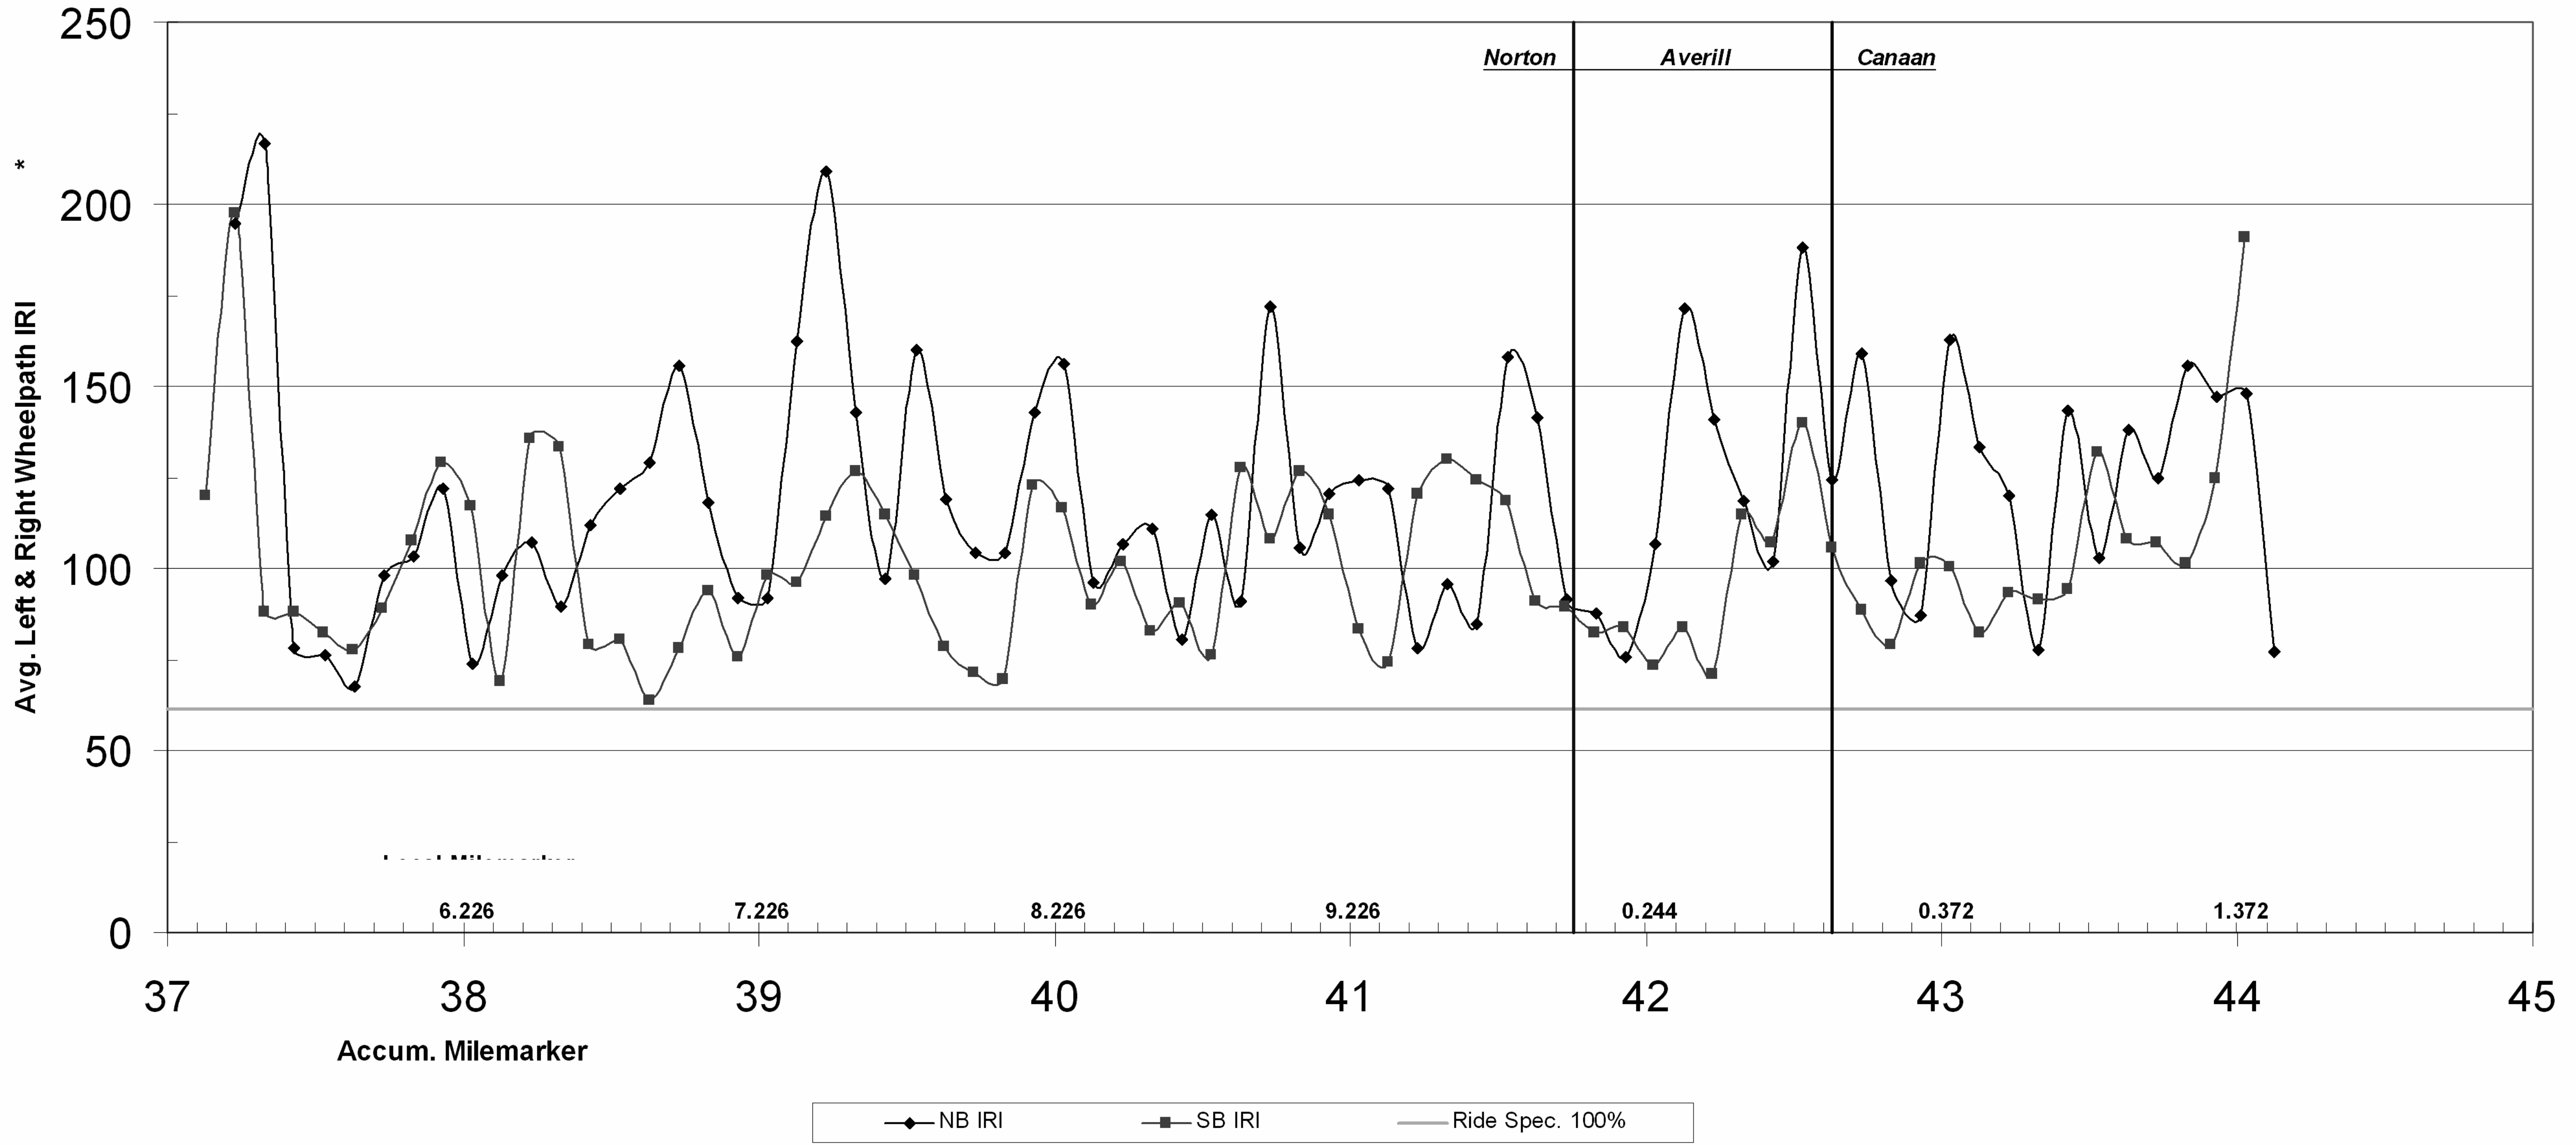

FOR INFORMATIONAL PURPOSES ONLY

ROUGHNESS DATA INFORMATION SHEET	PROJECT NAME: NORTON - CANAAN	PLOT DATE: 07-APR-2010
	PROJECT NUMBER: STP SURF(13)	DRAWN BY: LOCKE
	FILE NAME: p08cl56.dgn	CHECKED BY: PAVT MGMT
	DESIGNED BY: LOCKE	SHEET 10 OF 11
	p08cl561r1.1	