

INDEX OF SHEETS
SEE SHEET 2

RECORD PLANS

CONTRACTOR: F.W. WHITCOMB CONSTRUCTION CORP. - WALPOLE, NH
RESIDENT ENGINEER: JOSH HULETT
CONSTRUCTION BEGAN: MAY 10, 2010
CONSTRUCTION COMPLETE: JUNE 6, 2011
RECORD PLANS BY: JOSH HULETT & DARREN CONNOLLY

I HEREBY CERTIFY THAT ALL THE CONSTRUCTION REQUIRED BY
THIS SET OF DRAWINGS HAS BEEN ACCOMPLISHED AS INDICATED HEREIN.


BY Josh Hulett RESIDENT ENGINEER
DATE 9/10/2013

NOTE: Any further information concerning final quantities, amounts or other details
relative to this project may be found at Central Files in the electronic archives.

STATE OF VERMONT AGENCY OF TRANSPORTATION



PROPOSED IMPROVEMENT TOWNS OF MIDDLEBURY, RIPTON AND HANCOCK COUNTY OF ADDISON VT. ROUTE 125

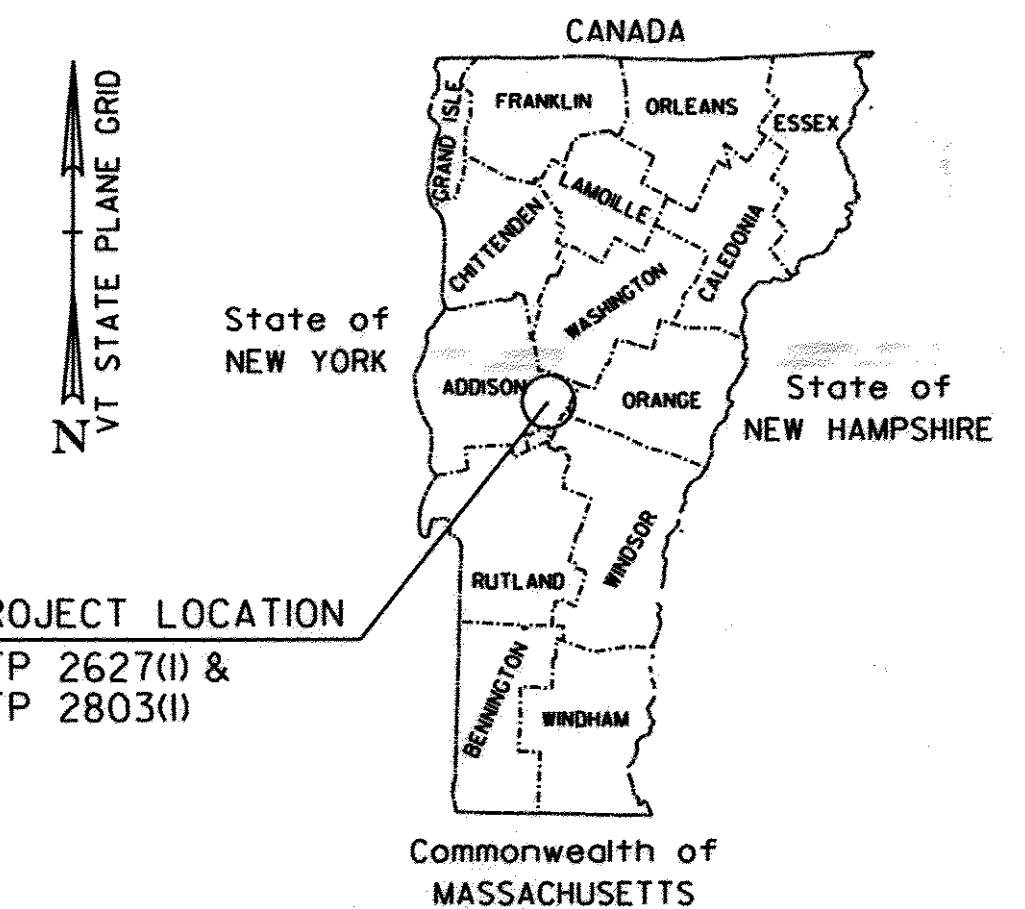

MIDDLEBURY
STP 2627(1)



SEE SHEET 11

FOR ADDITIONAL PROJECT INFORMATION
AND THE SUPERPAVE DESIGN CRITERIA

RIPTON - HANCOCK
STP 2803(1)

SEE SHEET 50

FOR ADDITIONAL PROJECT INFORMATION
AND THE SUPERPAVE DESIGN CRITERIA

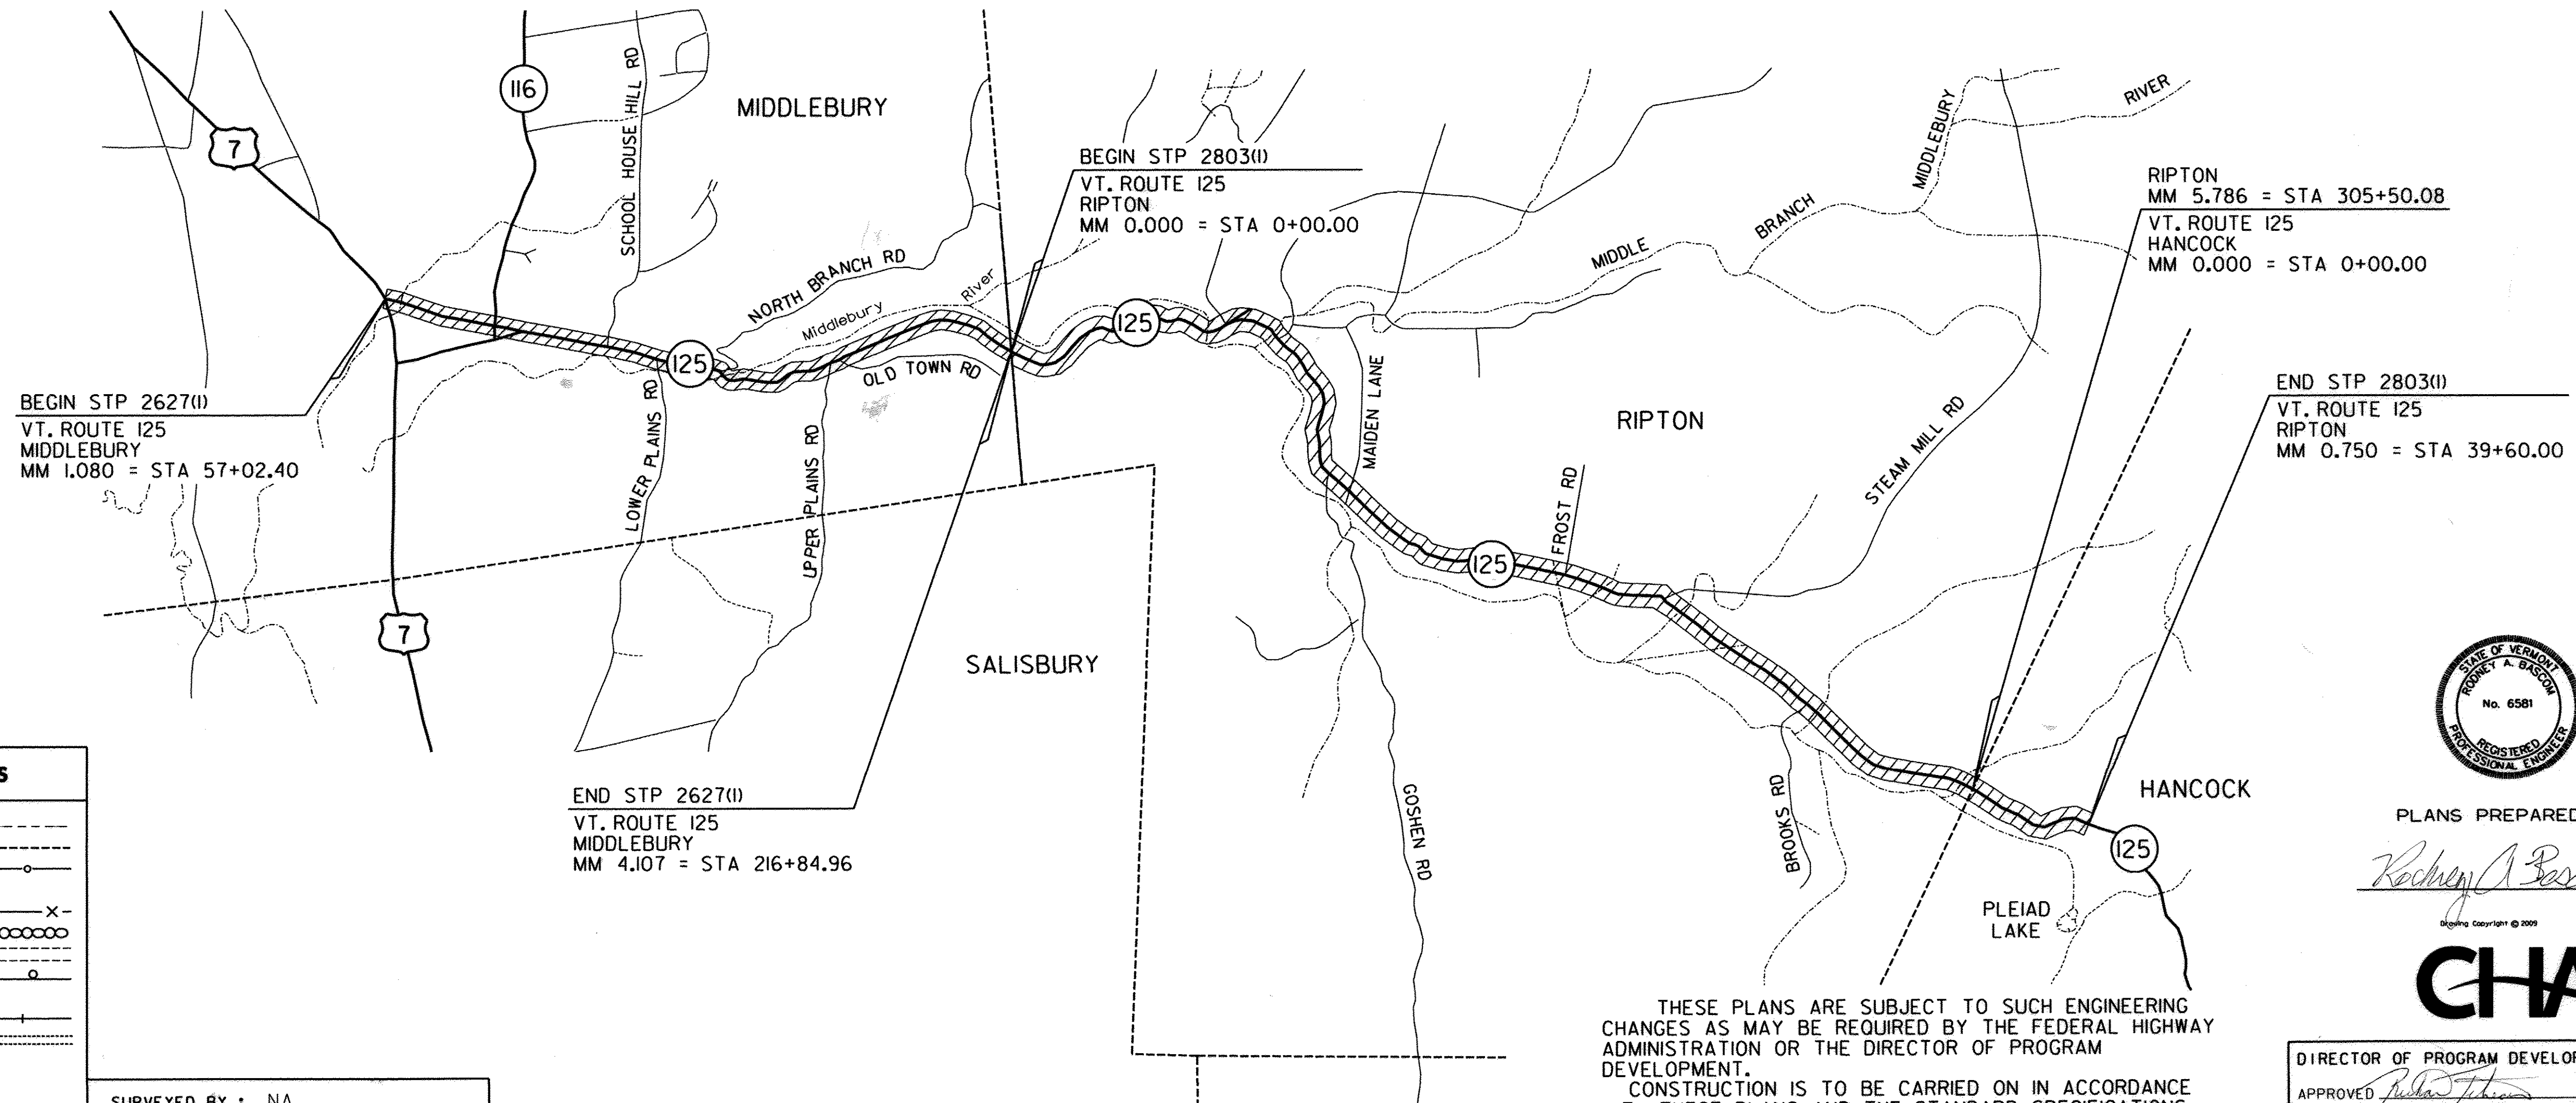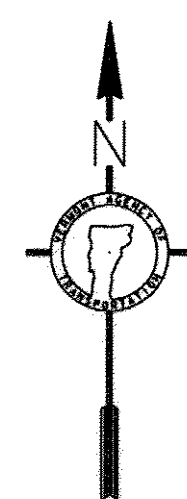


CONVENTIONAL SYMBOLS

COUNTY LINE	---
TOWN LINE	---
LIMITS OF ACCESS	---X---
POINT OF ACCESS	X
FENCE LINE	X-X-X-X-X
STONE WALL	---X---
TRAVELED WAY	---
GUARD RAIL	---X---
RAILROAD	---
SURVEY LINE	---
CULVERT	---
POWER POLE	---
TELEPHONE POLE	---
TREES	---
CONTROL OF ACCESS	---
PROPERTY LINE	---
R.O.W. TAKING LINE	---
SLOPE RIGHTS	---
TOP OF CUT	---
TOE OF SLOPE	---

SURVEYED BY : NA
SURVEYED DATE : NA

DATUM
VERTICAL NA
HORIZONTAL NA

THESE PLANS ARE SUBJECT TO SUCH ENGINEERING
CHANGES AS MAY BE REQUIRED BY THE FEDERAL HIGHWAY
ADMINISTRATION OR THE DIRECTOR OF PROGRAM
DEVELOPMENT.
CONSTRUCTION IS TO BE CARRIED ON IN ACCORDANCE
WITH THESE PLANS AND THE STANDARD SPECIFICATIONS
FOR CONSTRUCTION DATED 2006, AS APPROVED BY THE
FEDERAL HIGHWAY ADMINISTRATION ON JUNE 15, 2006
FOR USE ON THIS PROJECT, INCLUDING ALL SUBSEQUENT
REVISIONS AND SUCH REVISED SPECIFICATIONS AND
SPECIAL PROVISIONS AS ARE INCORPORATED IN THESE
PLANS.

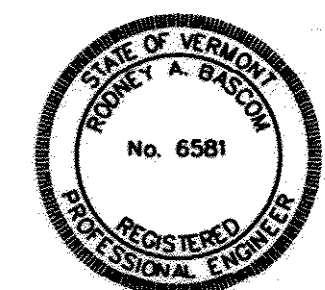

PLANS PREPARED BY

Kevin Marshia

CHA

DIRECTOR OF PROGRAM DEVELOPMENT
APPROVED Kevin Marshia DATE 1-11-10
PROJECT MANAGER : KEVIN MARSHIA
PROJECT NAME : MIDDLEBURY & RIPTON - HANCOCK
PROJECT NUMBER : STP 2627(1) & STP 2803(1)
SHEET 1 OF 114 SHEETS