

646.402 DURABLE 4 INCH WHITE LINE, THERMOPLASTIC
 (ALL LINES WILL INCLUDE EDGE LINE BREAKS AND
 RADIUS FOR TOWN HIGHWAYS)
 MIDDLEBURY:
 STA 57+02.40 - STA 67+00.00 EDGE LINE LT & RT


646.412 DURABLE 4 INCH YELLOW LINE, THERMOPLASTIC
 (ALL LINES WILL INCLUDE C/L BREAKS FOR
 TOWN HIGHWAYS) S=SOLID, D=DASHED
 MIDDLEBURY:
 STA 57+02.40 - STA 67+00.00 LT C RT
 S - S

646.602 TEMPORARY 4 INCH WHITE LINE, PAINT
 (ALL LINES WILL INCLUDE EDGE LINE BREAKS AND
 RADIUS FOR TOWN HIGHWAYS)
 MIDDLEBURY:
 STA 57+02.40 - STA 67+00.00 EDGE LINE LT & RT

646.612 TEMPORARY 4 INCH YELLOW LINE, PAINT
 (ALL LINES WILL INCLUDE C/L BREAKS FOR
 TOWN HIGHWAYS) S=SOLID, D=DASHED
 MIDDLEBURY:
 STA 57+02.40 - STA 67+00.00 LT C RT
 S - S

646.492 DURABLE LETTER OR SYMBOL, THERMOPLASTIC
 MIDDLEBURY:
 STA 64+51.80 LT, "A,H,E,A,D" (5 EA)
 STA 64+92.20 LT, "S,T,O,P" (4 EA)

646.692 TEMPORARY LETTER OR SYMBOL, PAINT
 MIDDLEBURY:
 STA 64+51.80 LT, "A,H,E,A,D" (5 EA)
 STA 64+92.20 LT, "S,T,O,P" (4 EA)

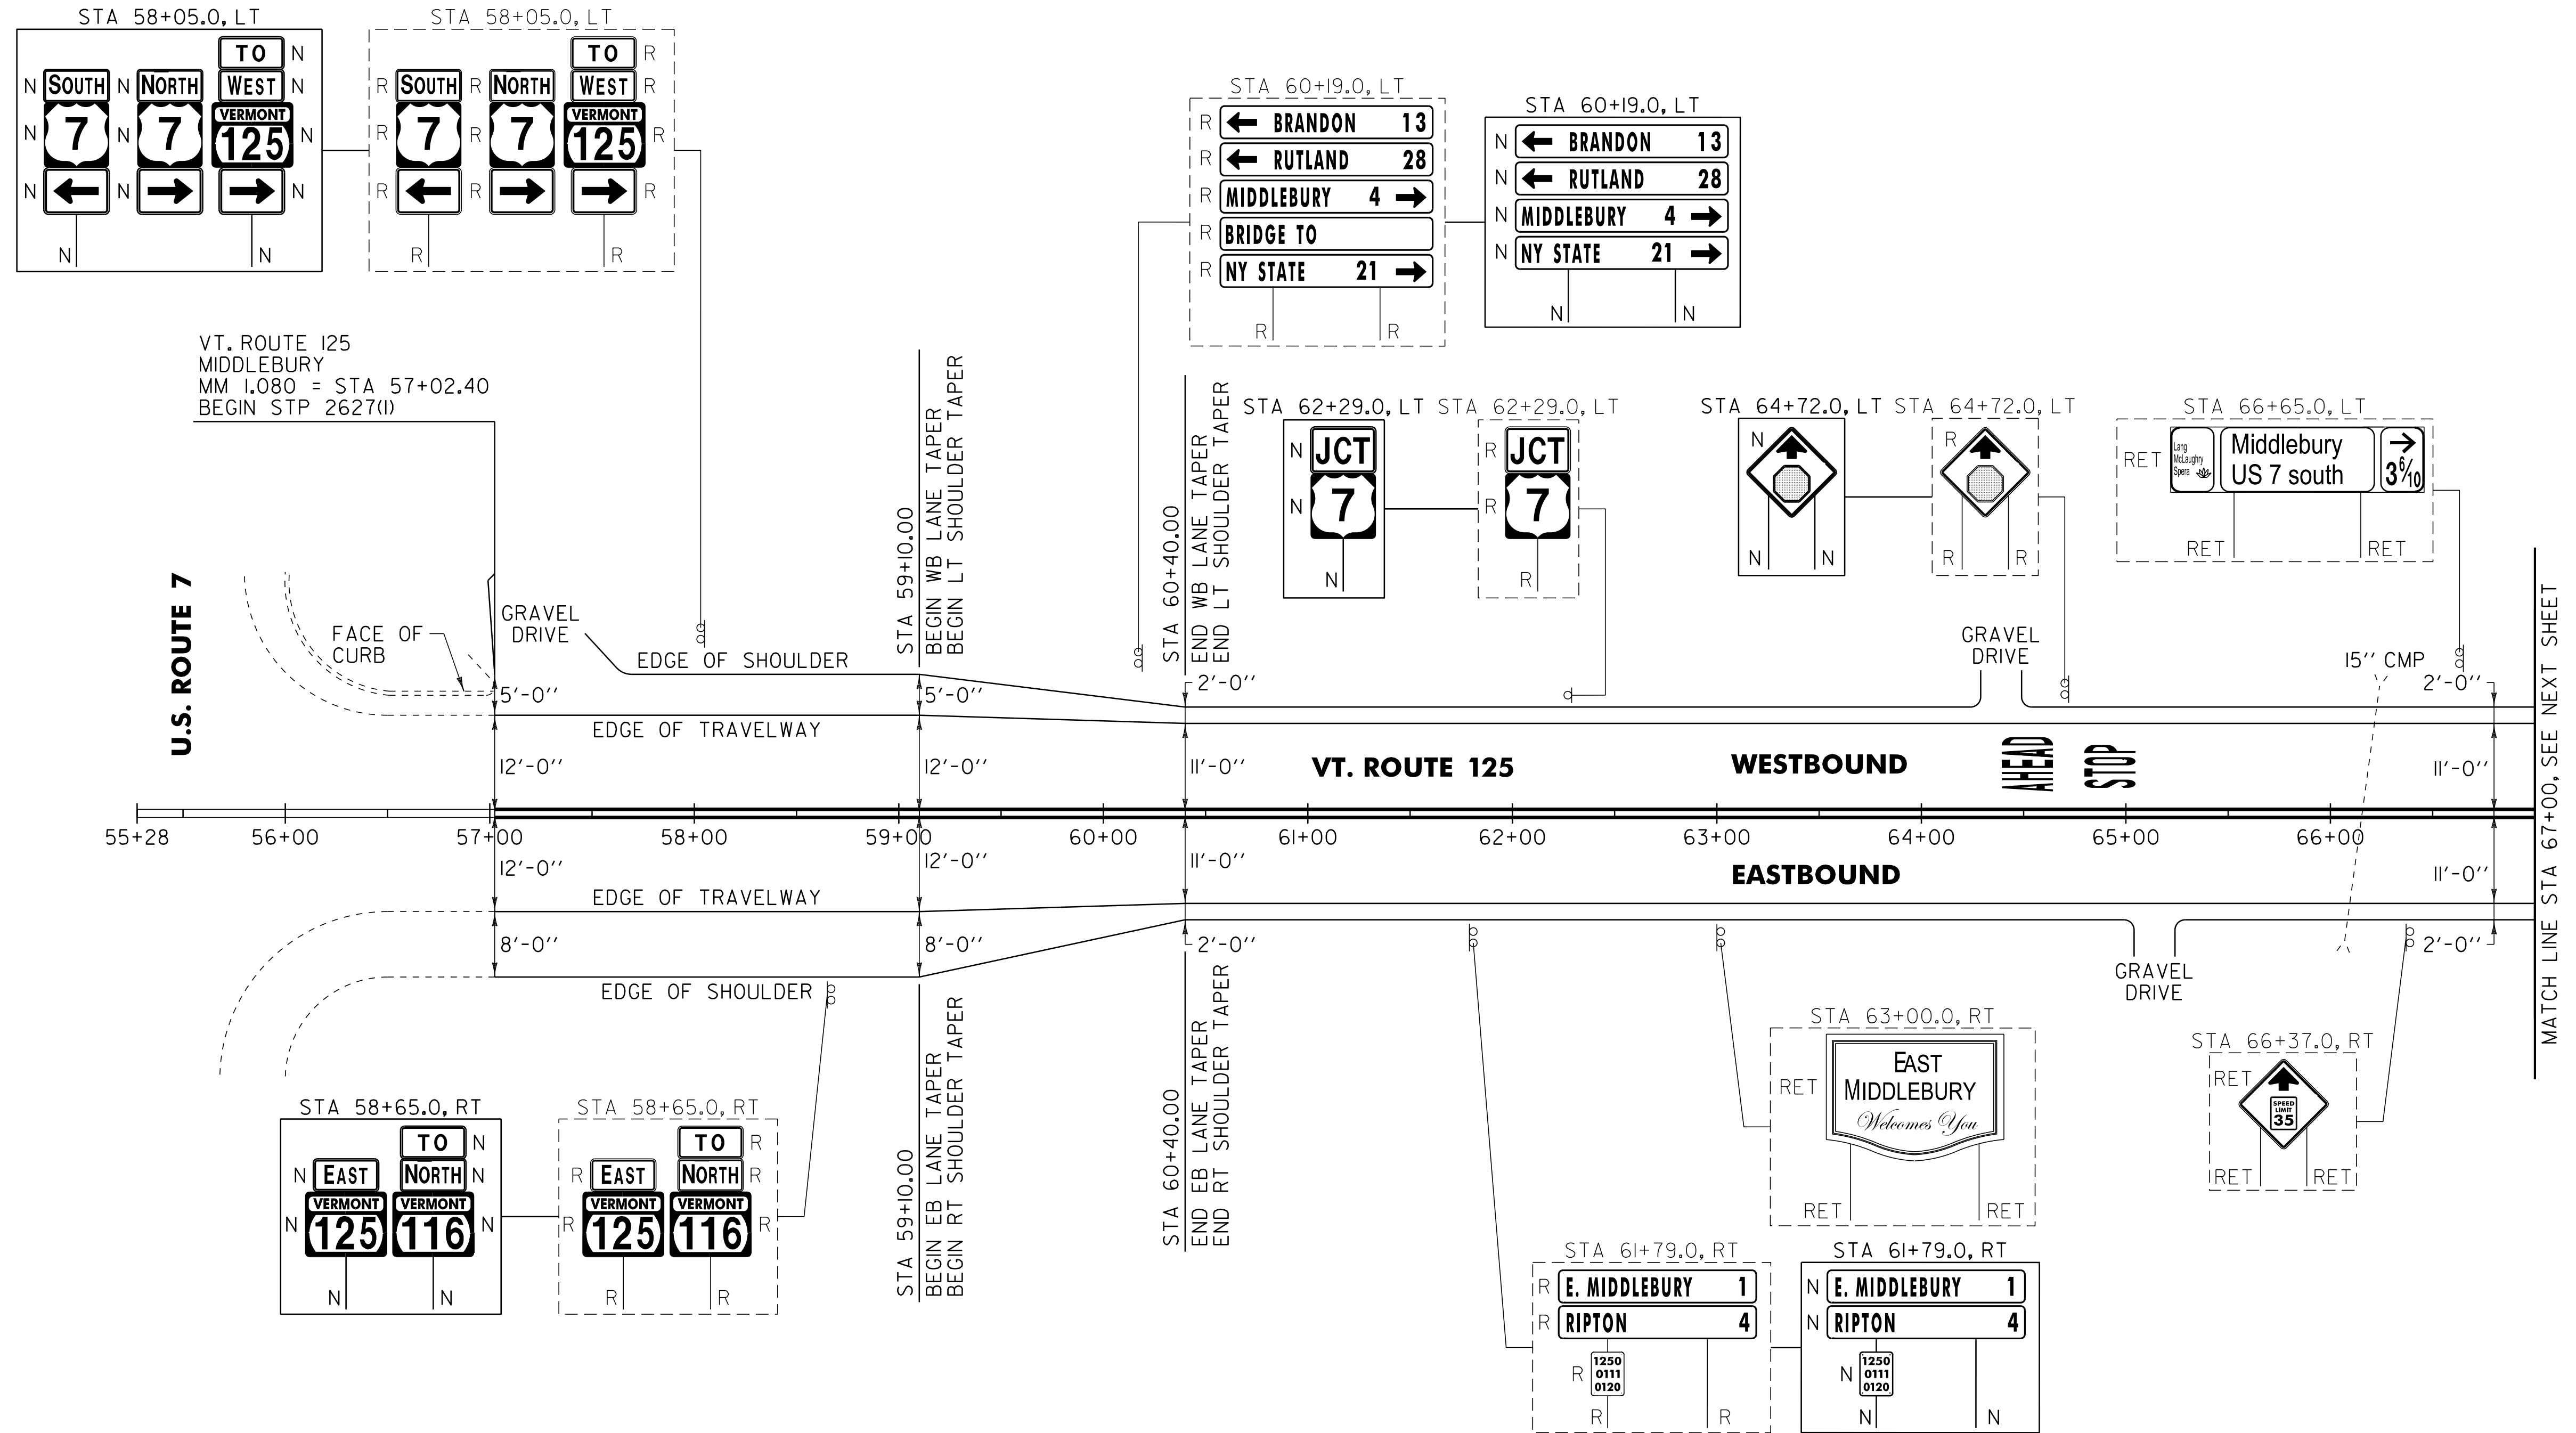

SIGN LEGEND
 R = REMOVE
 S = SALVAGE
 N = NEW
 RET = RETAIN
 B-B = BACK TO BACK
 EXISTING = - - - - -
 NEW = _____

NOT TO SCALE

PROJECT LAYOUT SHEET #1

PROJECT NAME: MIDDLEBURY
 PROJECT NUMBER: STP 2627(I)
 FILE NAME: p06c222.dgn
 PROJECT LEADER: D.E.G.
 DESIGNED BY: M.J.L.
 IPARM FILE: p06c222101

PLOT DATE: 18-SEP-2013 17:08
 DRAWN BY: C.A.K.
 CHECKED BY: D.W.E.
 SHEET 20 OF 114