

646.402 DURABLE 4 INCH WHITE LINE, THERMOPLASTIC
 (ALL LINES WILL INCLUDE EDGE LINE BREAKS AND RADIUS FOR TOWN HIGHWAYS)
 MIDDLEBURY:
 STA 114+50.00 - STA 128+50.00 EDGE LINE LT & RT

646.412 DURABLE 4 INCH YELLOW LINE, THERMOPLASTIC
 (ALL LINES WILL INCLUDE C/L BREAKS FOR TOWN HIGHWAYS) S=SOLID, D=DASHED
 MIDDLEBURY:
 STA 114+50.00 - STA 128+50.00 LT C RT
 STA 123+02.40 DOUBLE SOLID RT, TH-23 S - S

646.602 TEMPORARY 4 INCH WHITE LINE, PAINT
 (ALL LINES WILL INCLUDE EDGE LINE BREAKS AND RADIUS FOR TOWN HIGHWAYS)
 MIDDLEBURY:
 STA 114+50.00 - STA 128+50.00 EDGE LINE LT & RT

646.612 TEMPORARY 4 INCH YELLOW LINE, PAINT
 (ALL LINES WILL INCLUDE C/L BREAKS FOR TOWN HIGHWAYS) S=SOLID, D=DASHED
 MIDDLEBURY:
 STA 114+50.00 - STA 128+50.00 LT C RT
 STA 123+02.40 DOUBLE SOLID RT, TH-23 S - S

646.442 DURABLE 8 INCH WHITE LINE, THERMOPLASTIC
 MIDDLEBURY:
 STA 117+22.0 - STA 117+34.0 FIRE HYDRANT, NO PARKING, RT
 STA 122+54.0 - STA 122+66.0 FIRE HYDRANT, NO PARKING, RT
 STA 128+08.0 - STA 128+20.0 FIRE HYDRANT, NO PARKING, RT

646.482 DURABLE 24 INCH STOP BAR, THERMOPLASTIC
 MIDDLEBURY:
 STA 123+02.40 RT, TH-23

646.682 TEMPORARY 24 INCH STOP BAR, PAINT
 MIDDLEBURY:
 STA 123+02.40 RT, TH-23

646.502 DURABLE CROSSWALK MARKING, THERMOPLASTIC
 MIDDLEBURY:
 STA 123+02.40 RT, TH-23


646.702 TEMPORARY CROSSWALK MARKING, PAINT
 MIDDLEBURY:
 STA 123+02.40 RT, TH-23

675.50 REMOVING SIGNS
 AS SHOWN - 6

675.60 ERECTING SALVAGED SIGNS
 AS SHOWN - 2

646.492 DURABLE LETTER OR SYMBOL, THERMOPLASTIC
 MIDDLEBURY:
 STA 123+02.40 RT, TH-23 "S,T,O,P" (4 EA)

646.692 TEMPORARY LETTER OR SYMBOL, PAINT
 MIDDLEBURY:
 STA 123+02.40 RT, TH-23 "S,T,O,P" (4 EA)

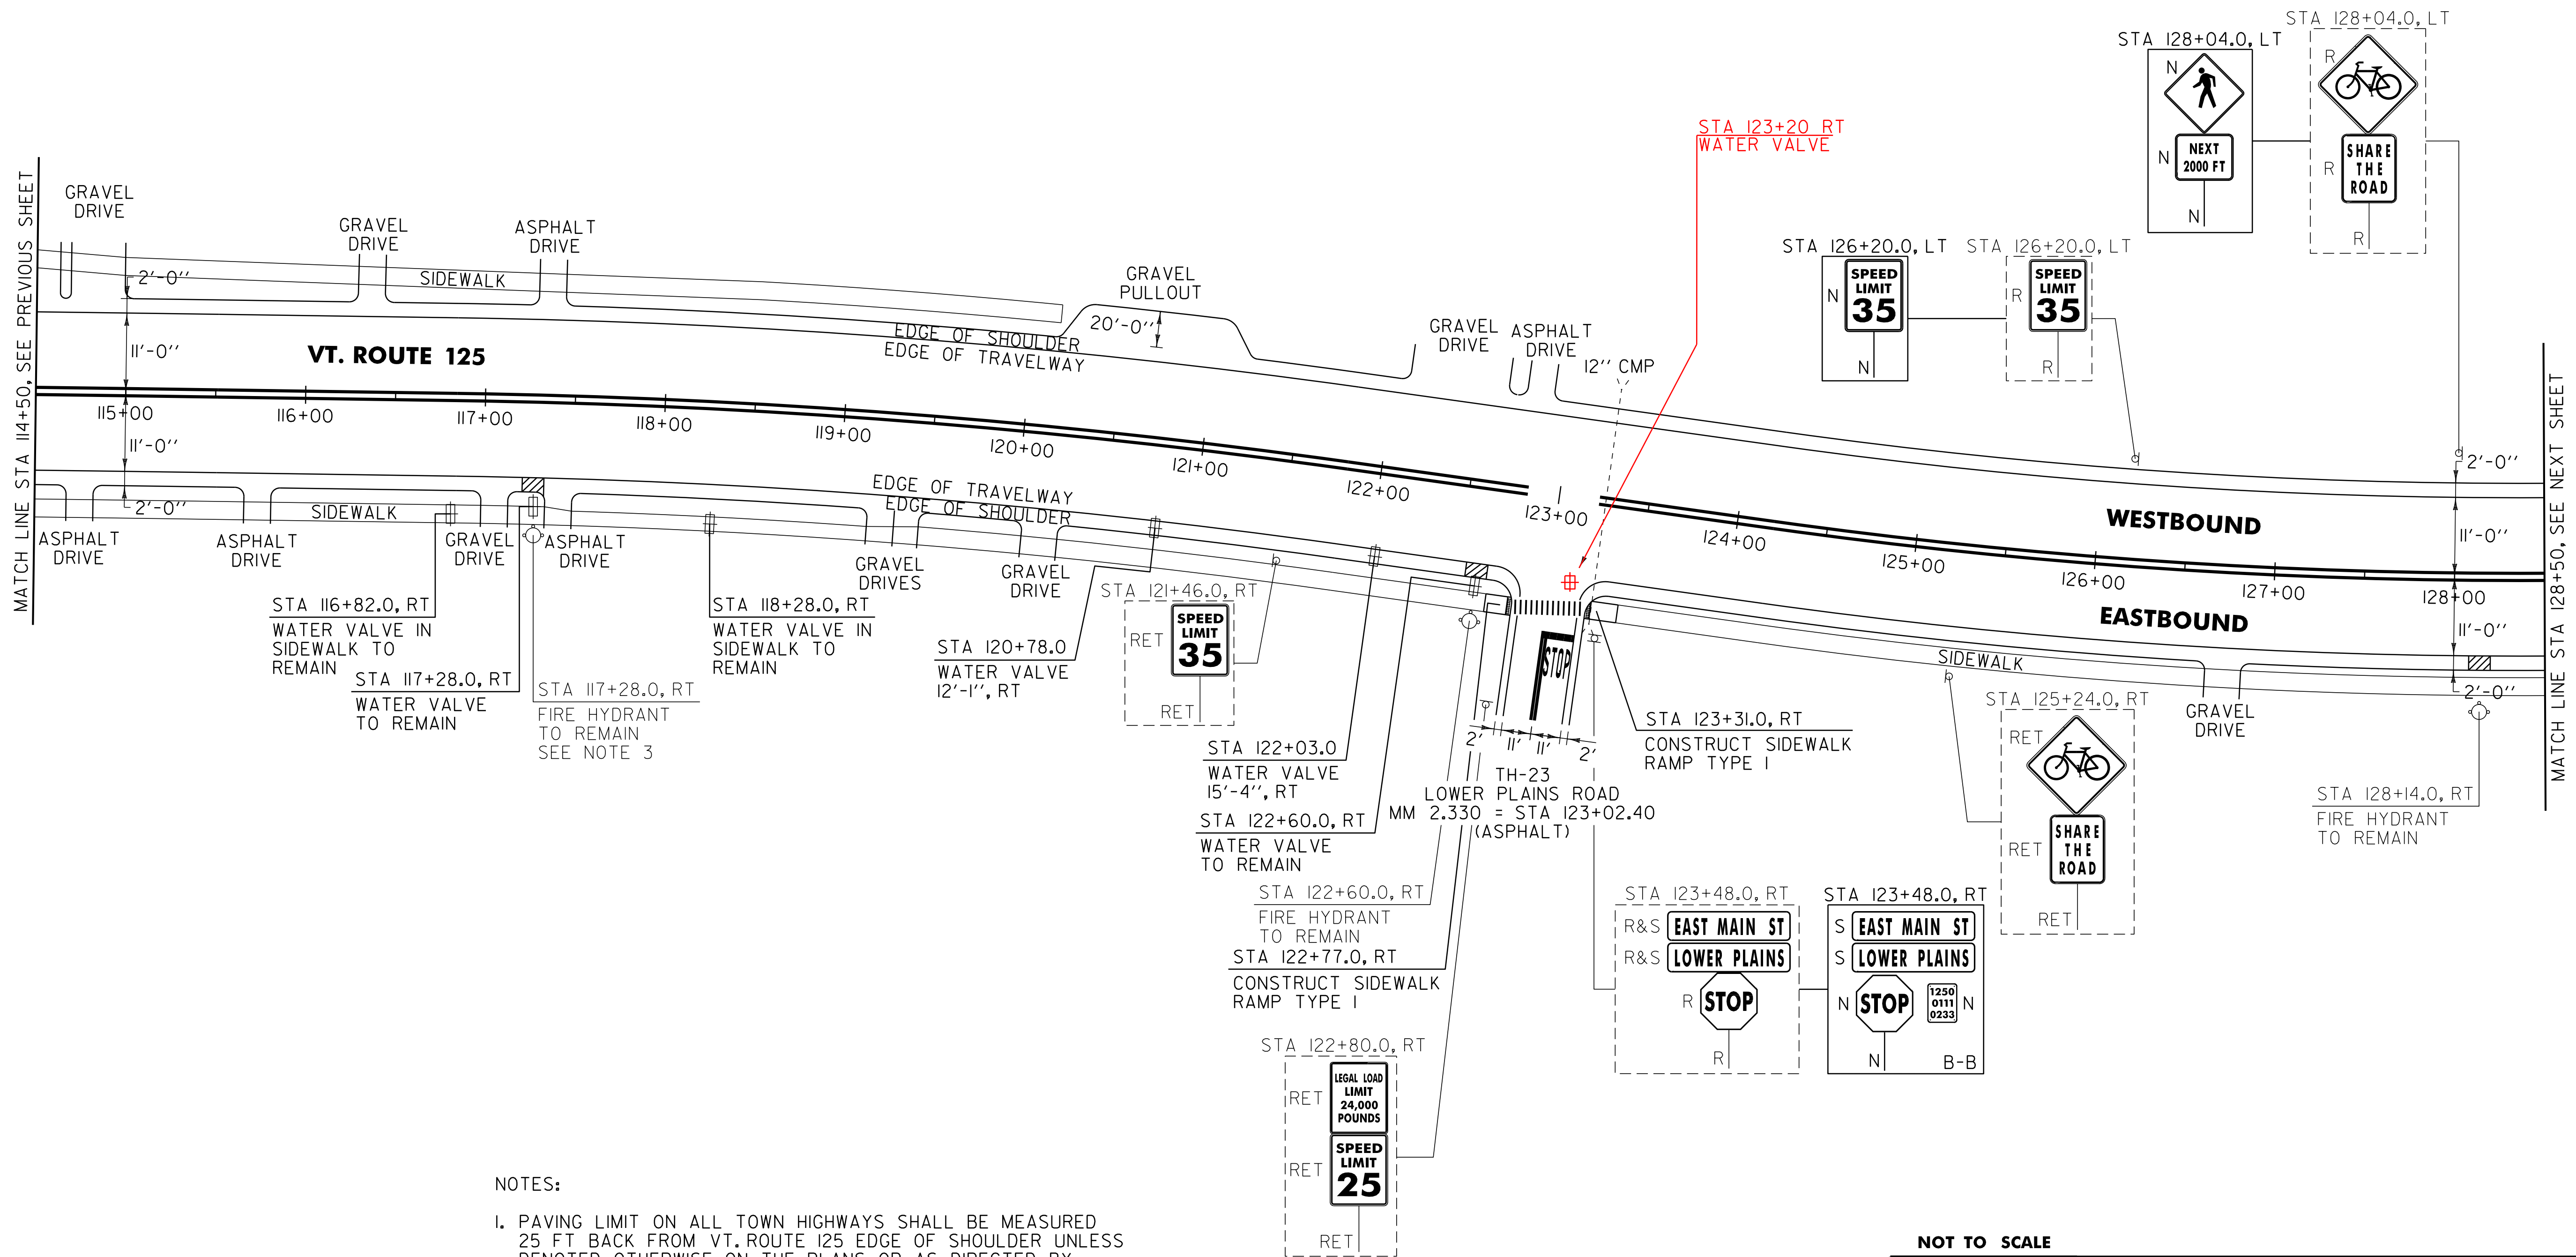

- NOTES:
- PAVING LIMIT ON ALL TOWN HIGHWAYS SHALL BE MEASURED 25 FT BACK FROM VT. ROUTE 125 EDGE OF SHOULDER UNLESS DENOTED OTHERWISE ON THE PLANS OR AS DIRECTED BY THE RESIDENT ENGINEER.
 - PAVE THE ENTIRE EXISTING GRAVEL PULLOUT WITH 1 1/2" TYPE IVS. ANY REQUIRED EXCAVATION SHALL BE PERFORMED AS DIRECTED BY THE RESIDENT ENGINEER AND PAID FOR UNDER ITEM 608.25 ALL PURPOSE EXCAVATION RENTAL, TYPE I.
 - SEE SHEET 9 FOR FIRE HYDRANT PAVEMENT MARKING DETAIL.

629.20 ADJUST ELEVATION OF VALVE BOX
 MIDDLEBURY:
 STA 120+78.0 RT
~~STA 122+03.0 RT - DID NOT FIND~~
 STA 123+20 RT

SIGN LEGEND
 R = REMOVE
 S = SALVAGE
 N = NEW
 RET = RETAIN
 B-B = BACK TO BACK
 EXISTING = _____
 NEW = _____

NOT TO SCALE

PROJECT LAYOUT SHEET #6	PROJECT NAME: MIDDLEBURY	PLOT DATE: 18-SEP-2013 17:09
	PROJECT NUMBER: STP 2627(1)	DRAWN BY: C.A.K.
	FILE NAME: p06c222.dgn	CHECKED BY: D.W.E.
	PROJECT LEADER: D.E.G.	SHEET 25 OF 114
	DESIGNED BY: M.J.L.	
	IPARM FILE: p06c222106.i	