


646.402 DURABLE 4 INCH WHITE LINE, THERMOPLASTIC
(ALL LINES WILL INCLUDE EDGE LINE BREAKS AND RADIUS FOR TOWN HIGHWAYS)
RIPTON:
STA 24+00.00 - STA 37+00.00 EDGE LINE LT & RT
646.412 DURABLE 4 INCH YELLOW LINE, THERMOPLASTIC
(ALL LINES WILL INCLUDE C/L BREAKS FOR TOWN HIGHWAYS) S=SOLID, D=DASHED
RIPTON:
STA 24+00.00 - STA 37+00.00 LT CL RT
S - S

646.602 TEMPORARY 4 INCH YELLOW LINE, PAINT
(ALL LINES WILL INCLUDE EDGE LINE BREAKS AND RADIUS FOR TOWN HIGHWAYS)
RIPTON:
STA 24+00.00 - STA 37+00.00 EDGE LINE LT & RT
646.612 TEMPORARY 4 INCH YELLOW LINE, PAINT
(ALL LINES WILL INCLUDE C/L BREAKS FOR TOWN HIGHWAYS) S=SOLID, D=DASHED
RIPTON:
STA 24+00.00 - STA 37+00.00 LT CL RT
S - S

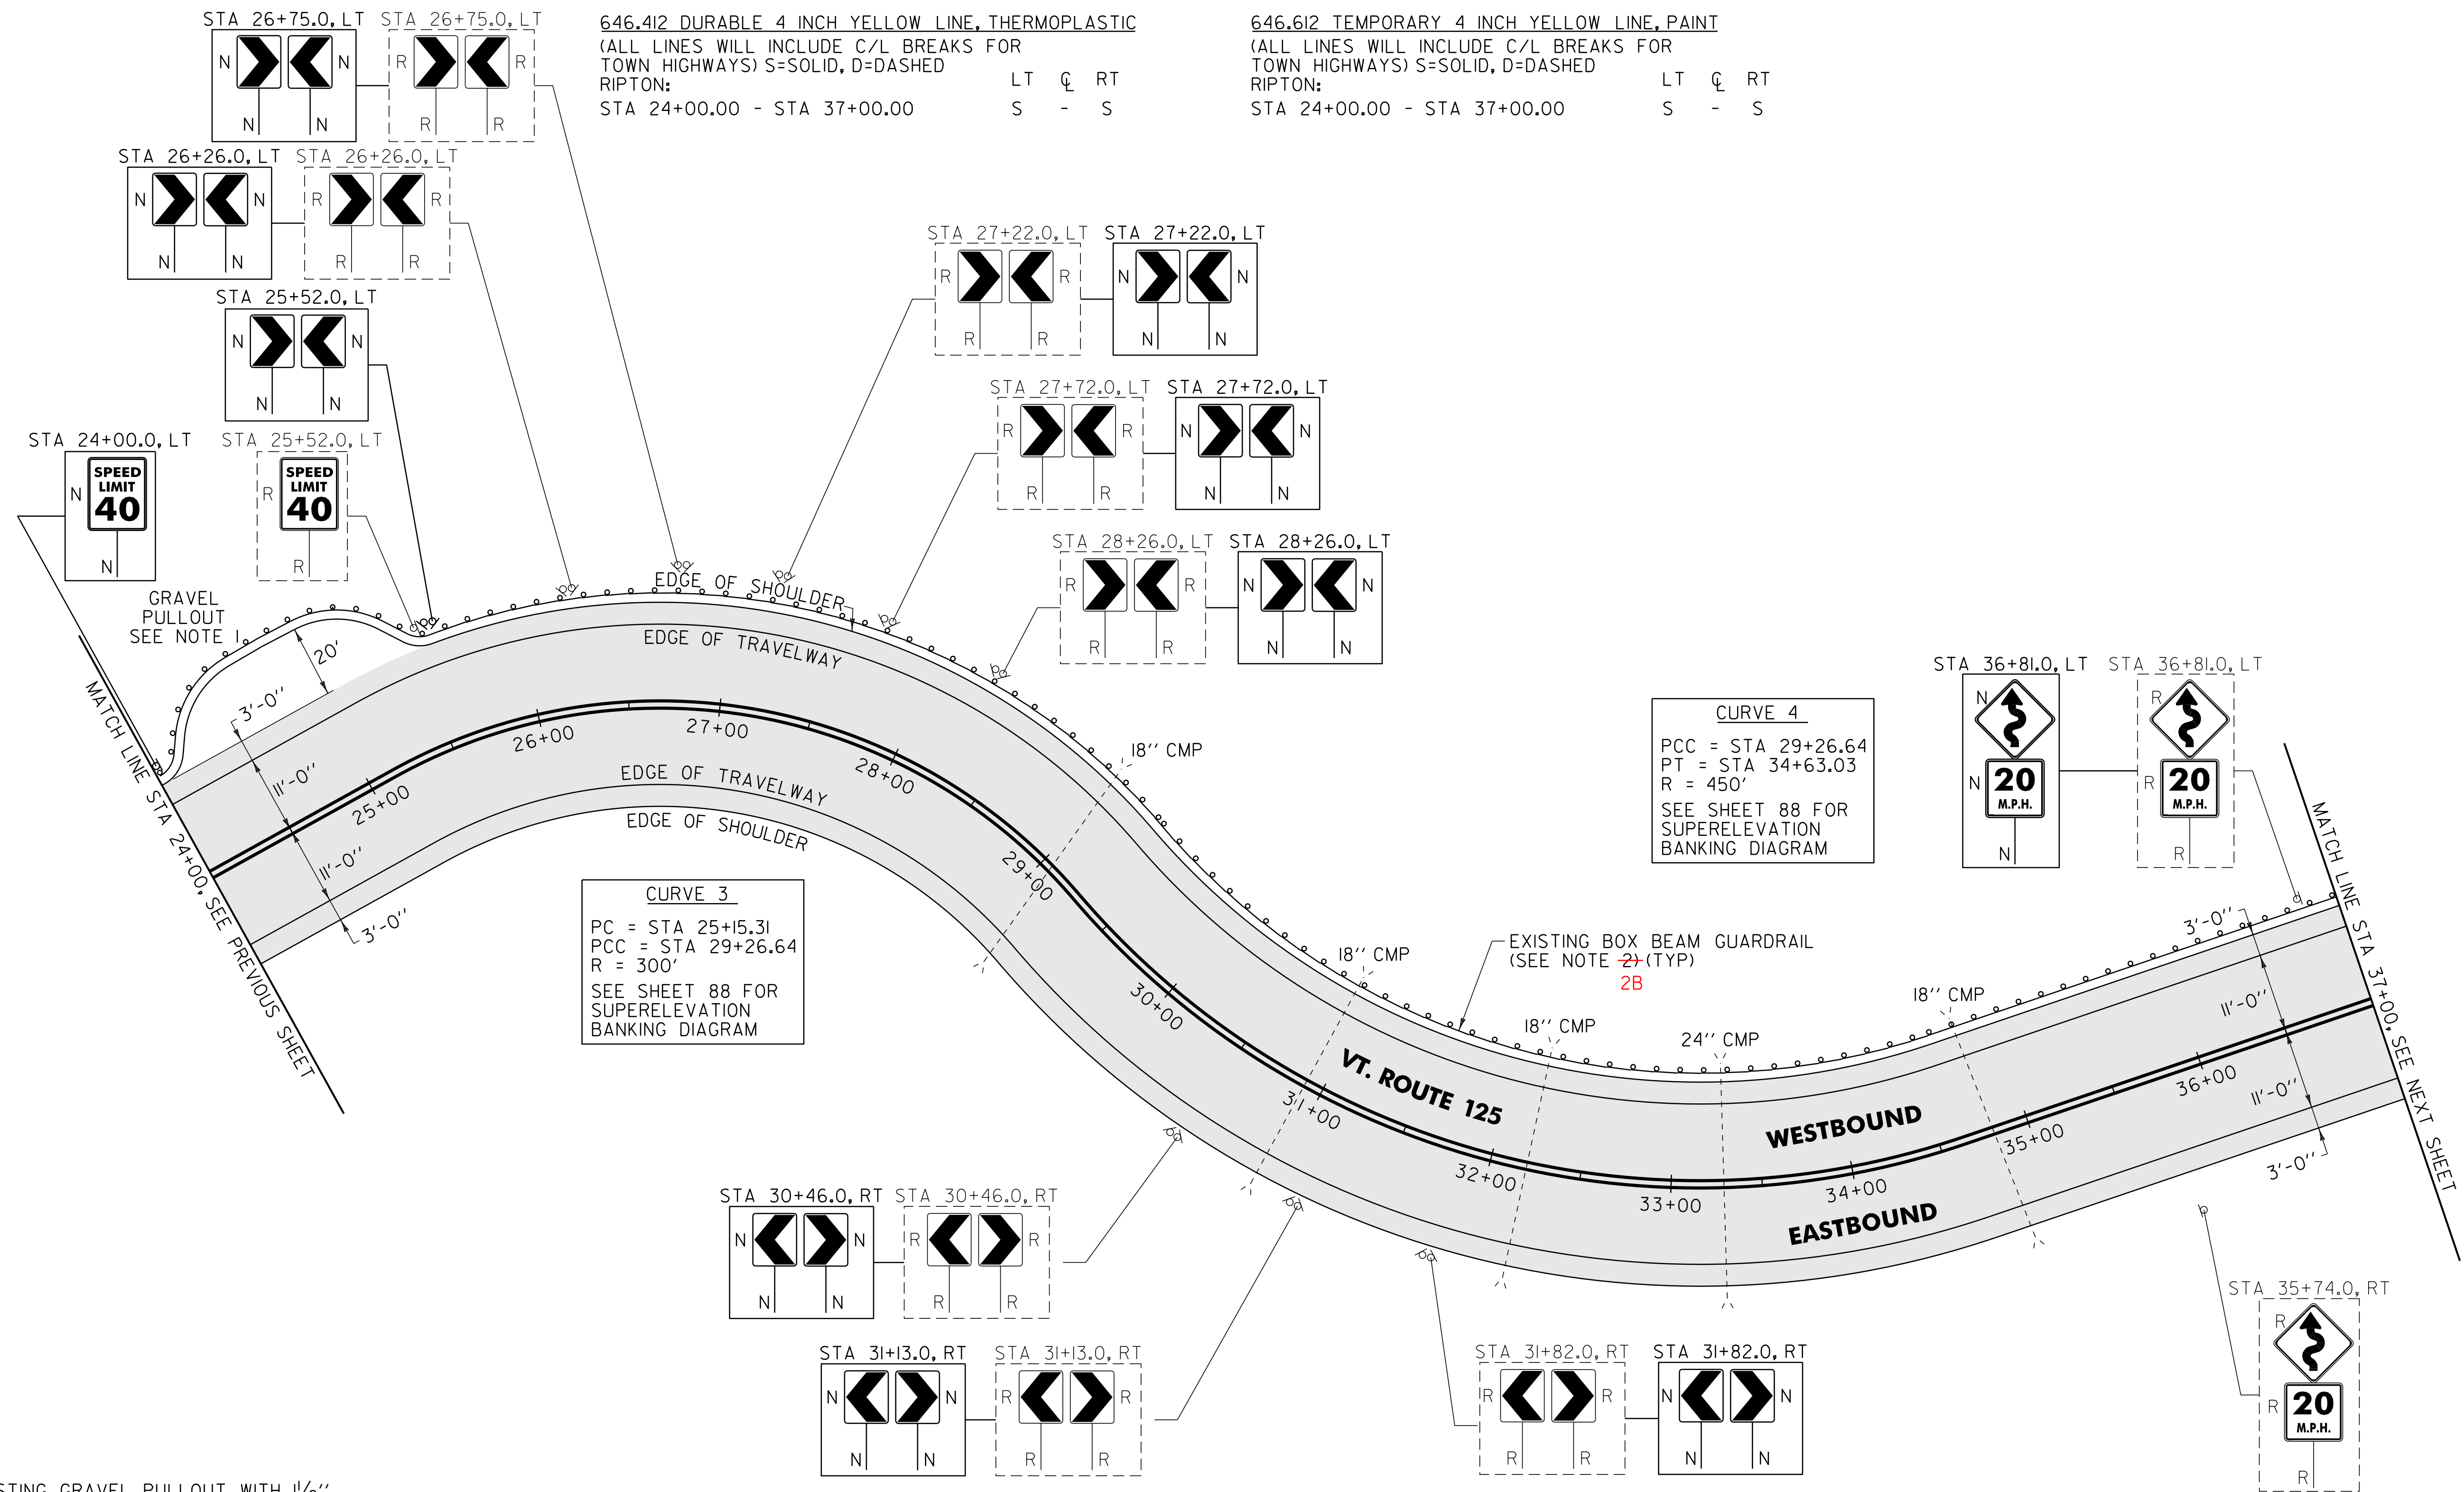

CURVE 3
PC = STA 25+15.31
PCC = STA 29+26.64
R = 300'
SEE SHEET 88 FOR SUPERELEVATION BANKING DIAGRAM

CURVE 4
PCC = STA 29+26.64
PT = STA 34+63.03
R = 450'
SEE SHEET 88 FOR SUPERELEVATION BANKING DIAGRAM

NOTES:
1. PAVE THE ENTIRE EXISTING GRAVEL PULLOUT WITH 1 1/2" TYPE IVS. ANY REQUIRED EXCAVATION SHALL BE PERFORMED AS DIRECTED BY THE RESIDENT ENGINEER AND PAID FOR UNDER ITEM 608.25 ALL PURPOSE EXCAVATOR RENTAL, TYPE I. THE CONTRACTOR SHALL REPAIR AND/OR MAKE HEIGHT ALTERATIONS PER SUBSECTION 621.13 OF THE STANDARD SPECIFICATIONS AS DIRECTED BY THE RESIDENT ENGINEER BETWEEN RIPTON STA 24+00 AND STA 37+00 LT. ALL WORK SHALL BE PAID FOR UNDER ITEM 900.640 SPECIAL PROVISION (BOX BEAM GUARDRAIL REPAIRS, WEATHERING). AN ESTIMATED QUANTITY FOR THIS ITEM HAS BEEN INCLUDED IN THE PLAN SET. SEE SHEET 9 FOR AVAILABLE BOX BEAM GUARDRAIL INVENTORY.

2. B. REFERENCE SHEET 31 OF I14 NOTE (KB).
STA 24+00 LT TO STA 37+00 LT

SIGN LEGEND
R = REMOVE
S = SALVAGE
N = NEW
RET = RETAIN
B-B = BACK TO BACK
EXISTING = _____
NEW = _____

NOT TO SCALE

PROJECT LAYOUT SHEET #3	PROJECT NAME: RIPTON - HANCOCK	PLOT DATE: 18-SEP-2013 17:09
	PROJECT NUMBER: STP 2803(1)	DRAWN BY: C.A.K.
	FILE NAME: p08cl60.dgn	CHECKED BY: D.W.E.
	PROJECT LEADER: D.E.G.	SHEET 62 OF 114
	DESIGNED BY: M.J.M.	
	IPARM FILE: p08cl60i03.i	

AREA TO BE RECLAIMED