


646.402 DURABLE 4 INCH WHITE LINE, THERMOPLASTIC
 (ALL LINES WILL INCLUDE EDGE LINE BREAKS AND RADIUS FOR TOWN HIGHWAYS)
 RIPTON:
 STA 115+00.00 - STA 128+00.00 EDGE LINE LT & RT
 646.412 DURABLE 4 INCH YELLOW LINE, THERMOPLASTIC
 (ALL LINES WILL INCLUDE C/L BREAKS FOR TOWN HIGHWAYS) S=SOLID, D=DASHED
 RIPTON:
 STA 115+00.00 - STA 128+00.00 LT C RT S - S
 STA 116+37.12 DOUBLE SOLID RT, TH-18

646.602 TEMPORARY 4 INCH WHITE LINE, PAINT
 (ALL LINES WILL INCLUDE EDGE LINE BREAKS AND RADIUS FOR TOWN HIGHWAYS)
 RIPTON:
 STA 115+00.00 - STA 128+00.00 EDGE LINE LT & RT
 646.612 TEMPORARY 4 INCH YELLOW LINE, PAINT
 (ALL LINES WILL INCLUDE C/L BREAKS FOR TOWN HIGHWAYS) S=SOLID, D=DASHED
 RIPTON:
 STA 115+00.00 - STA 128+00.00 LT C RT S - S
 STA 116+37.12 DOUBLE SOLID RT, TH-18

646.482 DURABLE 24 INCH STOP BAR, THERMOPLASTIC
 RIPTON:
 STA 116+37.12 RT, TH-18
 646.492 DURABLE LETTER OR SYMBOL, THERMOPLASTIC
 RIPTON:
 STA 116+37.12 RT, TH-18 "S,T,O,P" (4 EA)

646.682 TEMPORARY 24 INCH STOP BAR, PAINT
 RIPTON:
 STA 116+37.12 RT, TH-18
 646.692 TEMPORARY LETTER OR SYMBOL, PAINT
 RIPTON:
 STA 116+37.12 RT, TH-18 "S,T,O,P" (4 EA)

675.50 REMOVING SIGNS AS SHOWN - 16
 675.60 ERECTING SALVAGED SIGNS AS SHOWN - 3

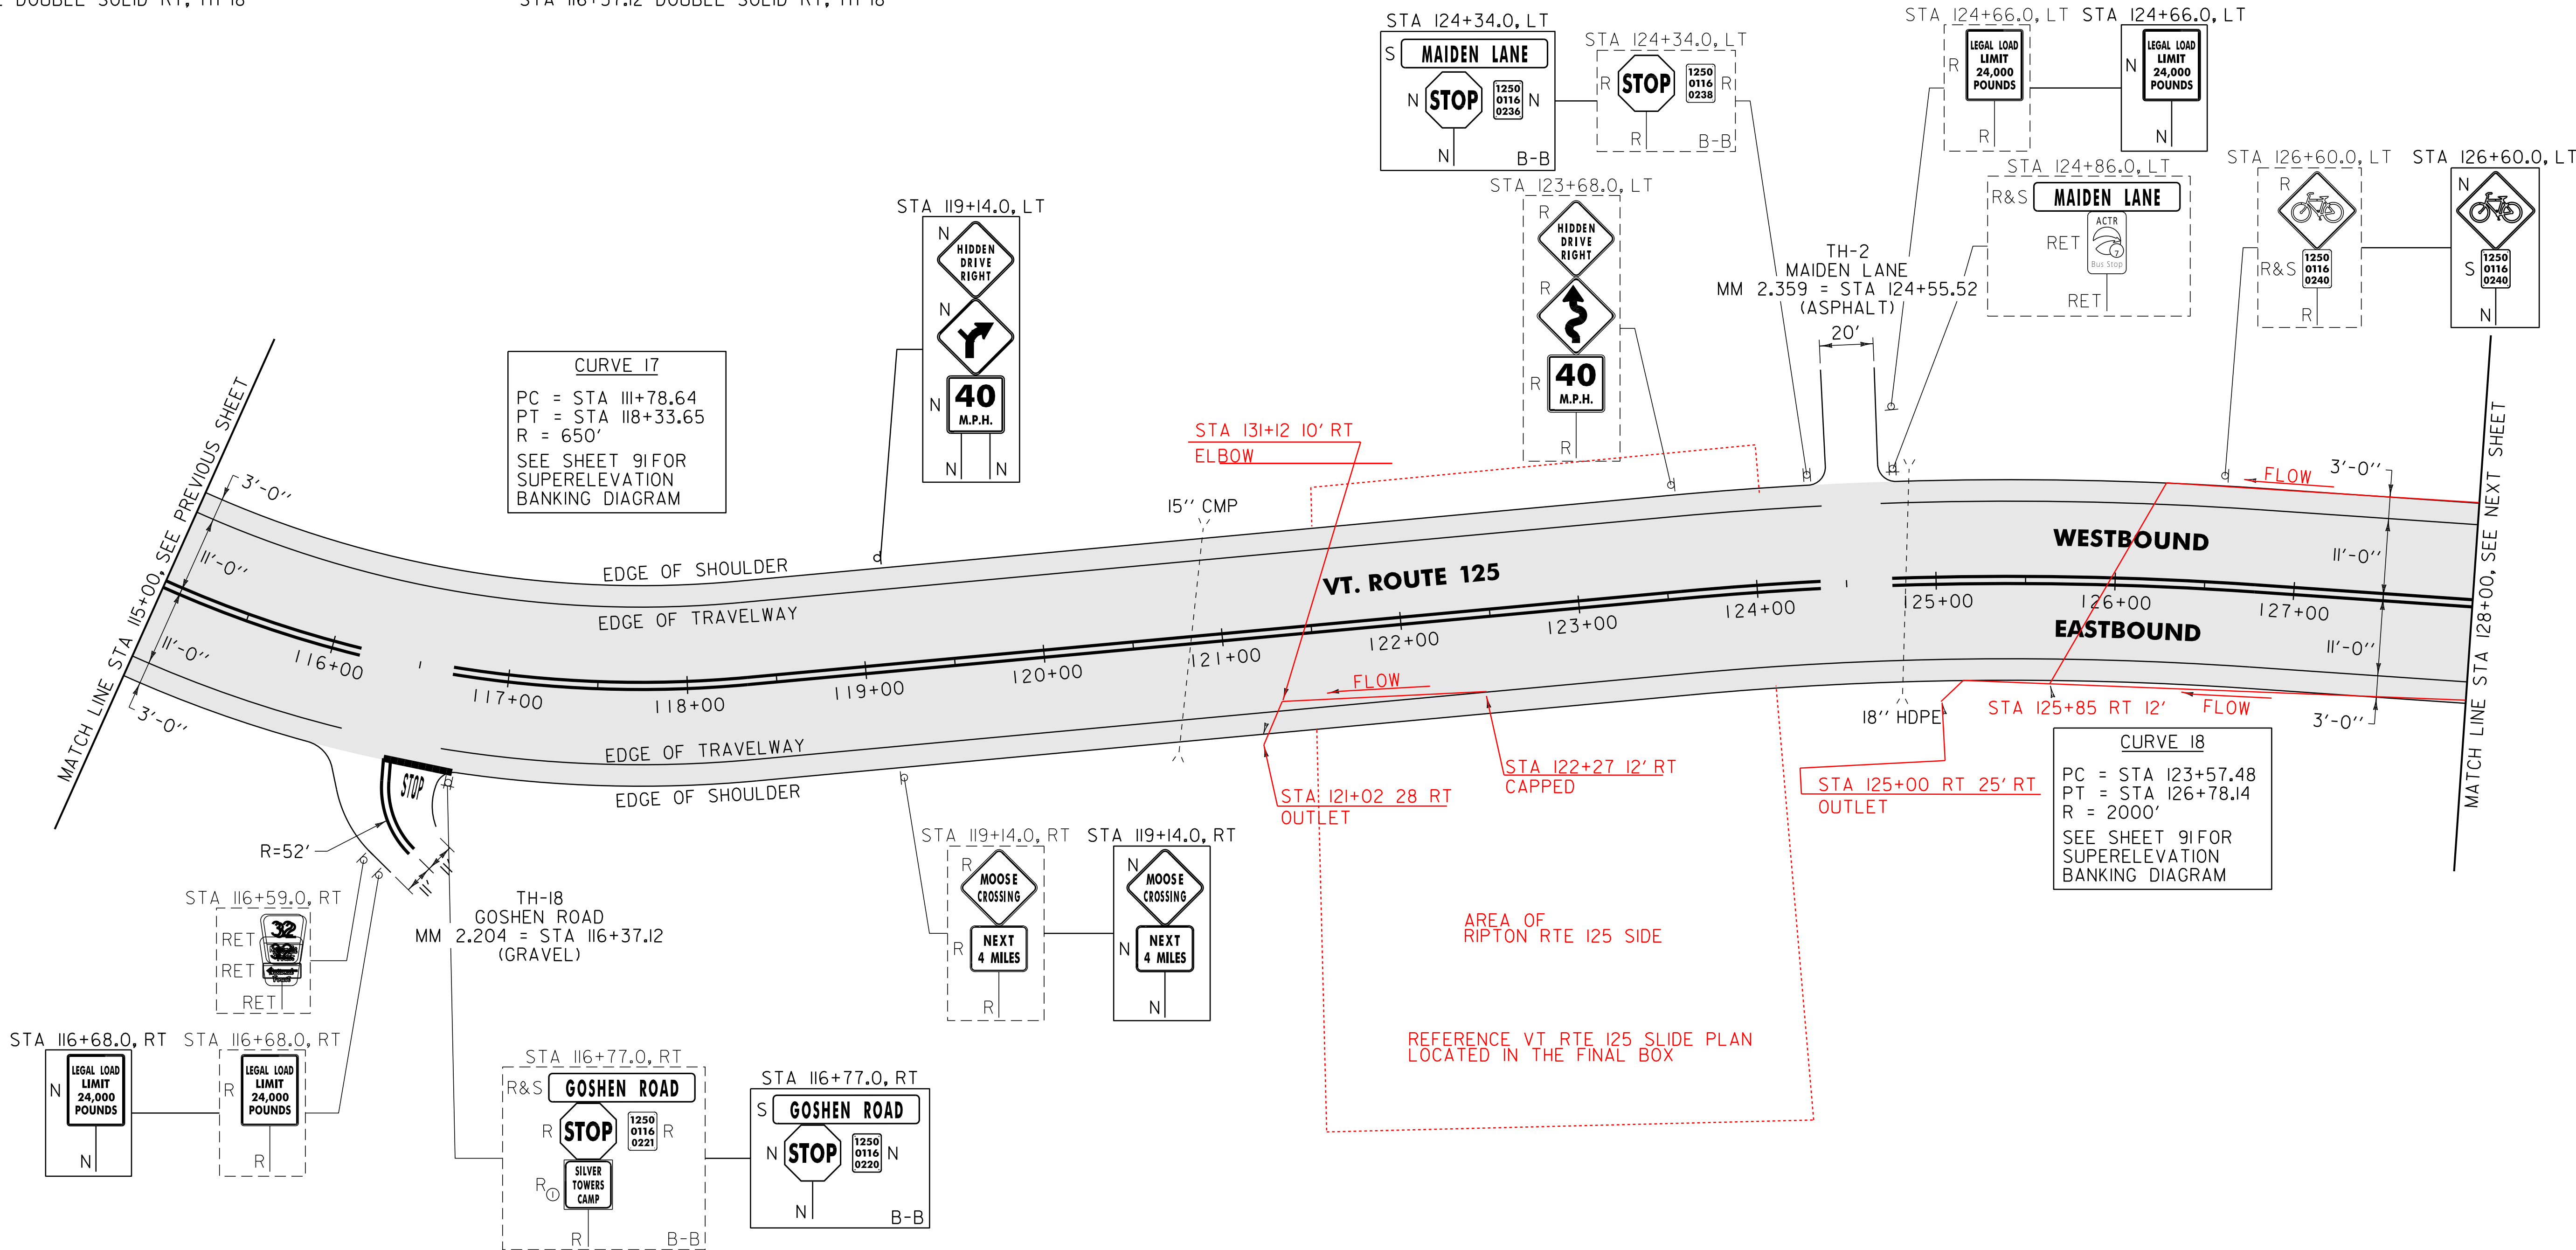

NOTE:
 1. PAVING LIMIT ON ALL TOWN HIGHWAYS SHALL BE MEASURED 25 FT BACK FROM VT. ROUTE 125 EDGE OF SHOULDER UNLESS DENOTED OTHERWISE ON THE PLANS OR AS DIRECTED BY THE RESIDENT ENGINEER.

SIGN LEGEND
 R = REMOVE
 S = SALVAGE
 N = NEW
 RET = RETAIN
 B-B = BACK TO BACK
 EXISTING = _____
 NEW = _____
 R⊙ = RETURN TO THE TOWN OF RIPTON

NOT TO SCALE
 PROJECT NAME: RIPTON - HANCOCK
 PROJECT NUMBER: STP 2803(1)
 FILE NAME: p08cl60.dgn
 PROJECT LEADER: D.E.G.
 DESIGNED BY: M.J.M.
 IPARM FILE: p08cl60i10.i
 PLOT DATE: 18-SEP-2013 17:10
 DRAWN BY: C.A.K.
 CHECKED BY: D.W.E.
 SHEET 69 OF 114

PROJECT LAYOUT SHEET #10