


646.402 DURABLE 4 INCH WHITE LINE, THERMOPLASTIC  
 (ALL LINES WILL INCLUDE EDGE LINE BREAKS AND RADIUS FOR TOWN HIGHWAYS)  
 RIPTON:  
 STA 128+00.00 - STA 141+00.00 EDGE LINE LT & RT  
 646.412 DURABLE 4 INCH YELLOW LINE, THERMOPLASTIC  
 (ALL LINES WILL INCLUDE C/L BREAKS FOR TOWN HIGHWAYS) S=SOLID, D=DASHED  
 RIPTON: LT C RT  
 STA 128+00.00 - STA 141+00.00 S - S

646.602 TEMPORARY 4 INCH WHITE LINE, PAINT  
 (ALL LINES WILL INCLUDE EDGE LINE BREAKS AND RADIUS FOR TOWN HIGHWAYS)  
 RIPTON:  
 STA 128+00.00 - STA 141+00.00 EDGE LINE LT & RT  
 646.612 TEMPORARY 4 INCH YELLOW LINE, PAINT  
 (ALL LINES WILL INCLUDE C/L BREAKS FOR TOWN HIGHWAYS) S=SOLID, D=DASHED  
 RIPTON: LT C RT  
 STA 128+00.00 - STA 141+00.00 S - S

675.50 REMOVING SIGNS  
 AS SHOWN - 2

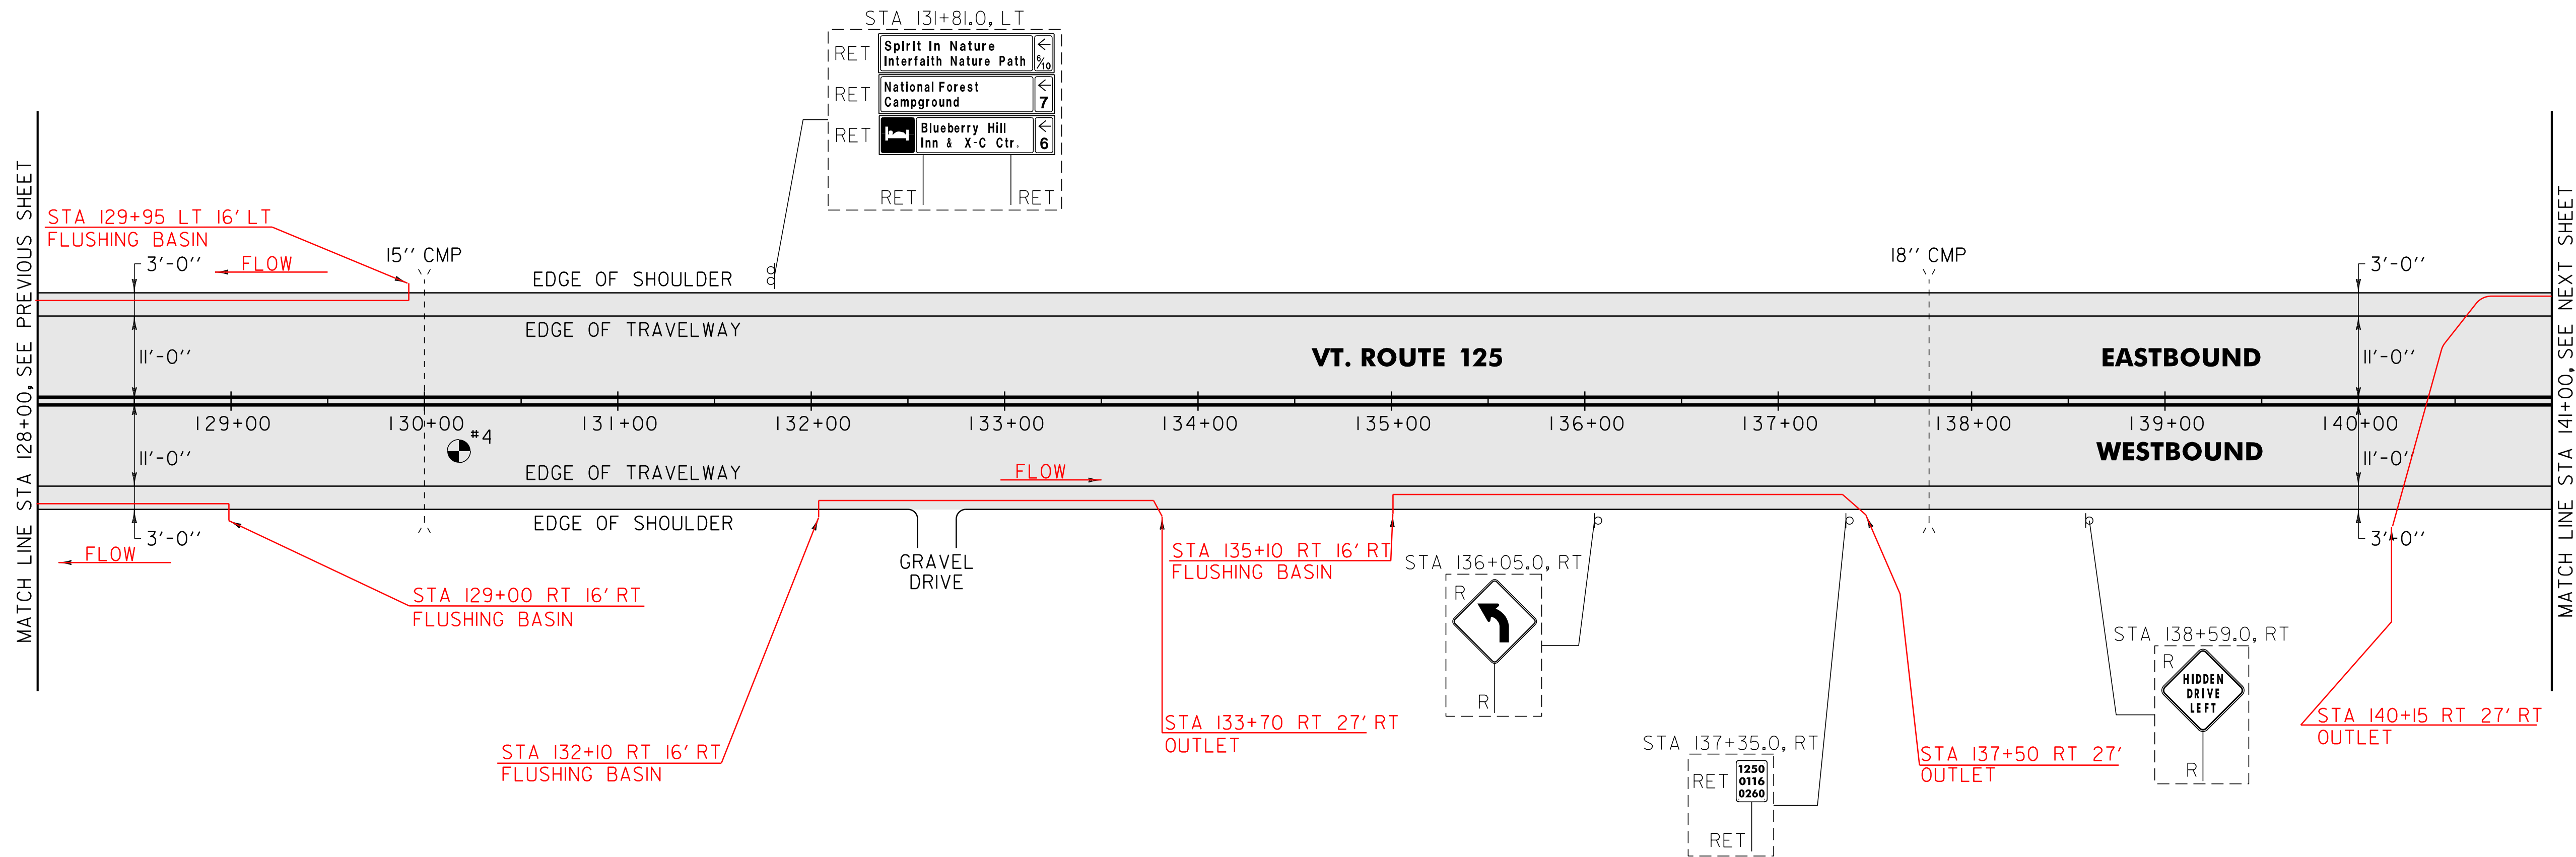

MATCH LINE STA 128+00.00, SEE PREVIOUS SHEET

MATCH LINE STA 141+00.00, SEE NEXT SHEET

PAVEMENT CORES = ●

#	TOTAL PCC COMMENTS DEPTH (INCH)
4	9" NO

**SIGN LEGEND**  
 R = REMOVE  
 S = SALVAGE  
 N = NEW  
 RET = RETAIN  
 B-B = BACK TO BACK  
 EXISTING = - - - - -  
 NEW = \_\_\_\_\_

NOT TO SCALE

<b>PROJECT LAYOUT SHEET #11</b>	PROJECT NAME: RIPTON - HANCOCK	PLOT DATE: 18-SEP-2013 17:10
	PROJECT NUMBER: STP 2803(1)	DRAWN BY: C.A.K.
	FILE NAME: p08c160.dgn	CHECKED BY: D.W.E.
	DESIGNED BY: M.J.M.	SHEET 70 OF 114
	IPARM FILE: p08c160i11.i	

AREA TO BE RECLAIMED