


646.402 DURABLE 4 INCH WHITE LINE, THERMOPLASTIC  
 (ALL LINES WILL INCLUDE EDGE LINE BREAKS AND RADIUS FOR TOWN HIGHWAYS)  
 RIPTON:  
 STA 141+00.00 - STA 154+00.00 EDGE LINE LT & RT

646.412 DURABLE 4 INCH YELLOW LINE, THERMOPLASTIC  
 (ALL LINES WILL INCLUDE C/L BREAKS FOR TOWN HIGHWAYS) S=SOLID, D=DASHED  
 RIPTON:  
 STA 141+00.00 - STA 154+00.00 LT ☐ RT  
 S - S

646.602 TEMPORARY 4 INCH WHITE LINE, PAINT  
 (ALL LINES WILL INCLUDE EDGE LINE BREAKS AND RADIUS FOR TOWN HIGHWAYS)  
 RIPTON:  
 STA 141+00.00 - STA 154+00.00 EDGE LINE LT & RT

646.612 TEMPORARY 4 INCH YELLOW LINE, PAINT  
 (ALL LINES WILL INCLUDE C/L BREAKS FOR TOWN HIGHWAYS) S=SOLID, D=DASHED  
 RIPTON:  
 STA 141+00.00 - STA 154+00.00 LT ☐ RT  
 S - S

675.50 REMOVING SIGNS AS SHOWN - 1

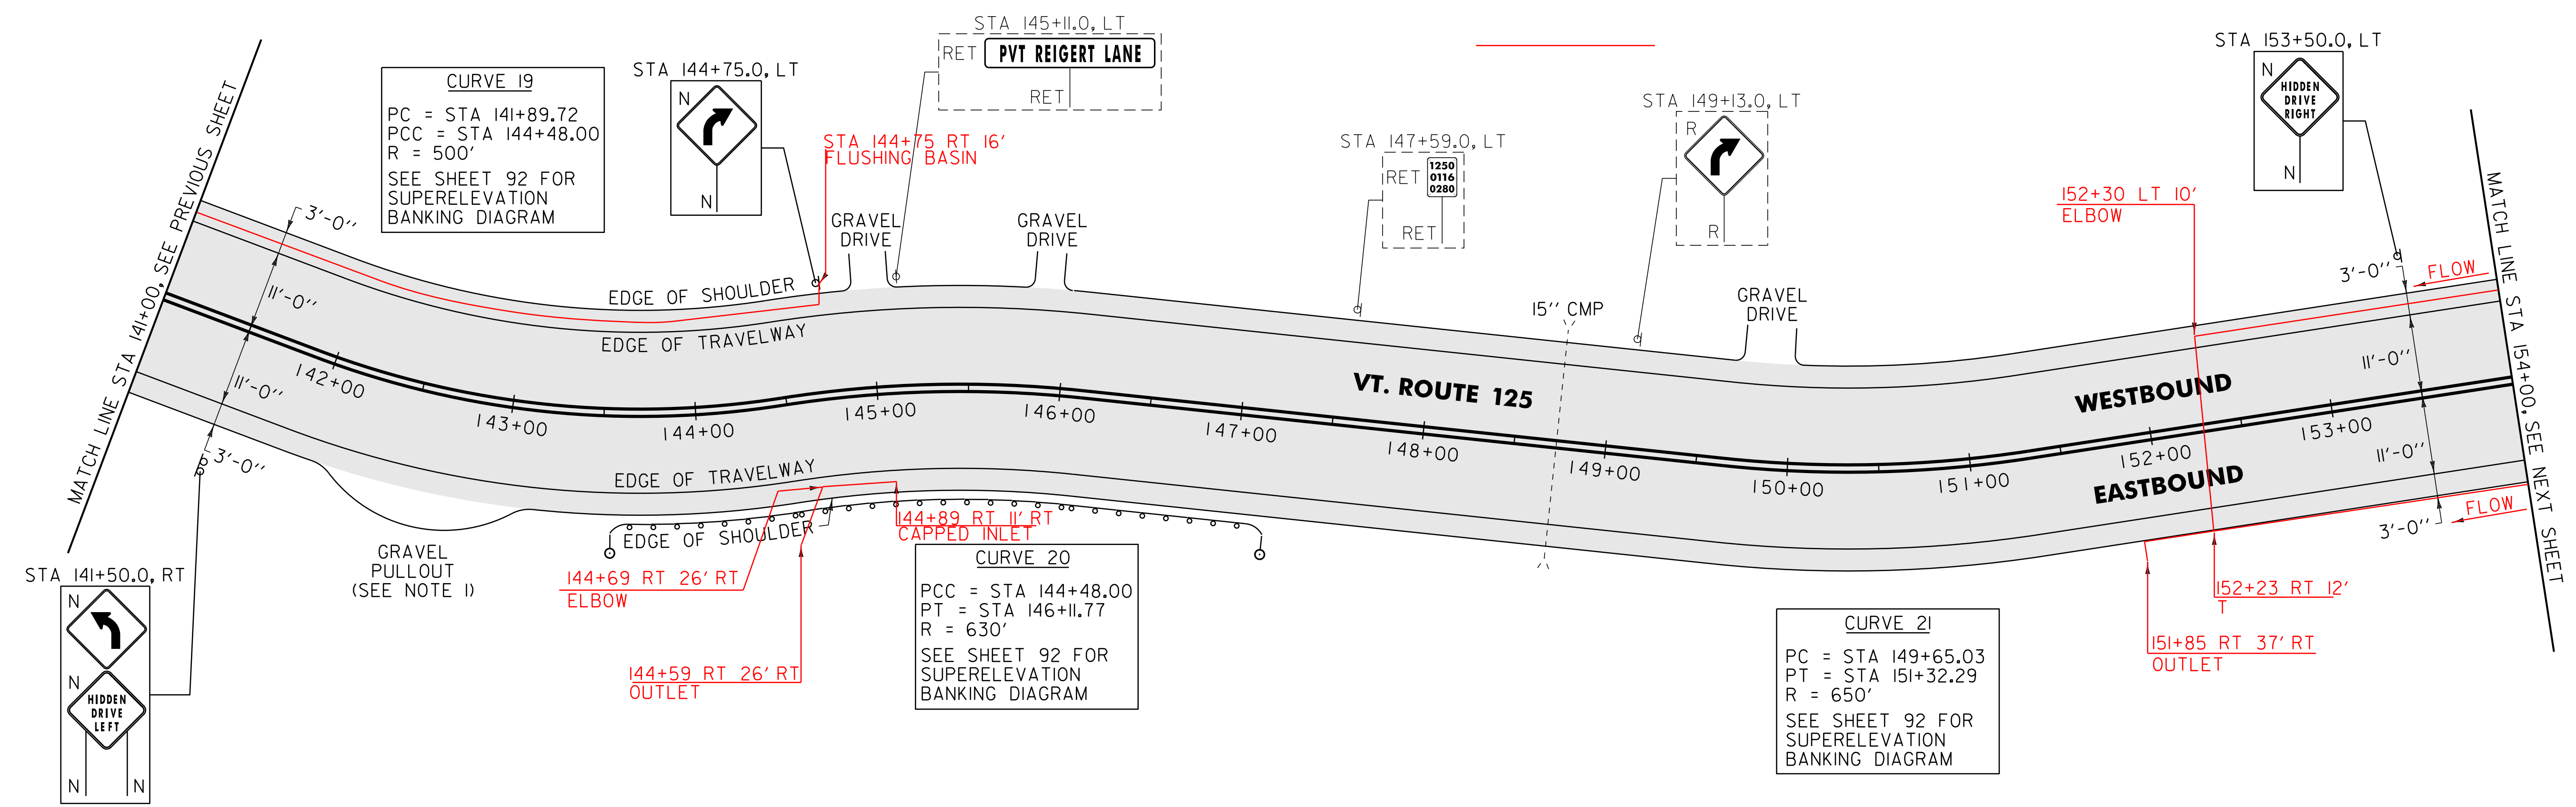

621.80 REMOVAL AND DISPOSAL OF GUARDRAIL  
 RIPTON:  
 STA 143+64.0 - STA 147+18.0 RT (354.0 LF)

676.10 DELINEATOR WITH STEEL POST  
 ♀ TYPE 1 WHITE  
 RIPTON:  
 STA 143+59.5 RT  
 STA 147+22.0 RT

900.620 SPECIAL PROVISION (MANUFACTURED TERMINAL SECTION, FLARED/WEATHERING)  
 RIPTON:  
 STA 143+59.5 - STA 143+97.0 RT  
 STA 146+84.5 - STA 147+22.0 RT

900.640 SPECIAL PROVISION (STEEL BEAM GUARDRAIL, WEATHERING)  
 RIPTON:  
 STA 143+97.0 - STA 146+84.5 RT (287.5 LF)

NOTE:  
 1. PAVE THE ENTIRE EXISTING GRAVEL PULLOUT WITH 1 1/2" TYPE IVS.  
 ANY REQUIRED EXCAVATION SHALL BE PERFORMED AS DIRECTED BY THE RESIDENT ENGINEER AND PAID FOR UNDER ITEM 608.25 ALL PURPOSE EXCAVATOR RENTAL, TYPE 1.

SIGN LEGEND  
 R = REMOVE  
 S = SALVAGE  
 N = NEW  
 RET = RETAIN  
 B-B = BACK TO BACK  
 EXISTING = - - - - -  
 NEW = \_\_\_\_\_

NOT TO SCALE

**PROJECT LAYOUT SHEET #12**

PROJECT NAME: RIPTON - HANCOCK	FILE NAME: p08cl60.dgn	PLOT DATE: 18-SEP-2013 17:10
PROJECT NUMBER: STP 2803(1)	PROJECT LEADER: D.E.G.	DRAWN BY: C.A.K.
	DESIGNED BY: M.J.M.	CHECKED BY: D.W.E.
	IPARM FILE: p08cl60i12.i	SHEET 71 OF 114

AREA TO BE RECLAIMED