


646.402 DURABLE 4 INCH WHITE LINE, THERMOPLASTIC  
 (ALL LINES WILL INCLUDE EDGE LINE BREAKS AND RADIUS FOR TOWN HIGHWAYS)  
 RIPTON:  
 STA 154+00.00 - STA 167+00.00 EDGE LINE LT & RT

646.412 DURABLE 4 INCH YELLOW LINE, THERMOPLASTIC  
 (ALL LINES WILL INCLUDE C/L BREAKS FOR TOWN HIGHWAYS) S=SOLID, D=DASHED  
 RIPTON:  
 STA 154+00.00 - STA 160+78.00 LT C RT  
 STA 160+78.00 - STA 167+00.00 S - D

646.602 TEMPORARY 4 INCH WHITE LINE, PAINT  
 (ALL LINES WILL INCLUDE EDGE LINE BREAKS AND RADIUS FOR TOWN HIGHWAYS)  
 RIPTON:  
 STA 154+00.00 - STA 167+00.00 EDGE LINE LT & RT

646.612 TEMPORARY 4 INCH YELLOW LINE, PAINT  
 (ALL LINES WILL INCLUDE C/L BREAKS FOR TOWN HIGHWAYS) S=SOLID, D=DASHED  
 RIPTON:  
 STA 154+00.00 - STA 160+78.00 LT C RT  
 STA 160+78.00 - STA 167+00.00 S - D

675.50 REMOVING SIGNS  
 AS SHOWN - I

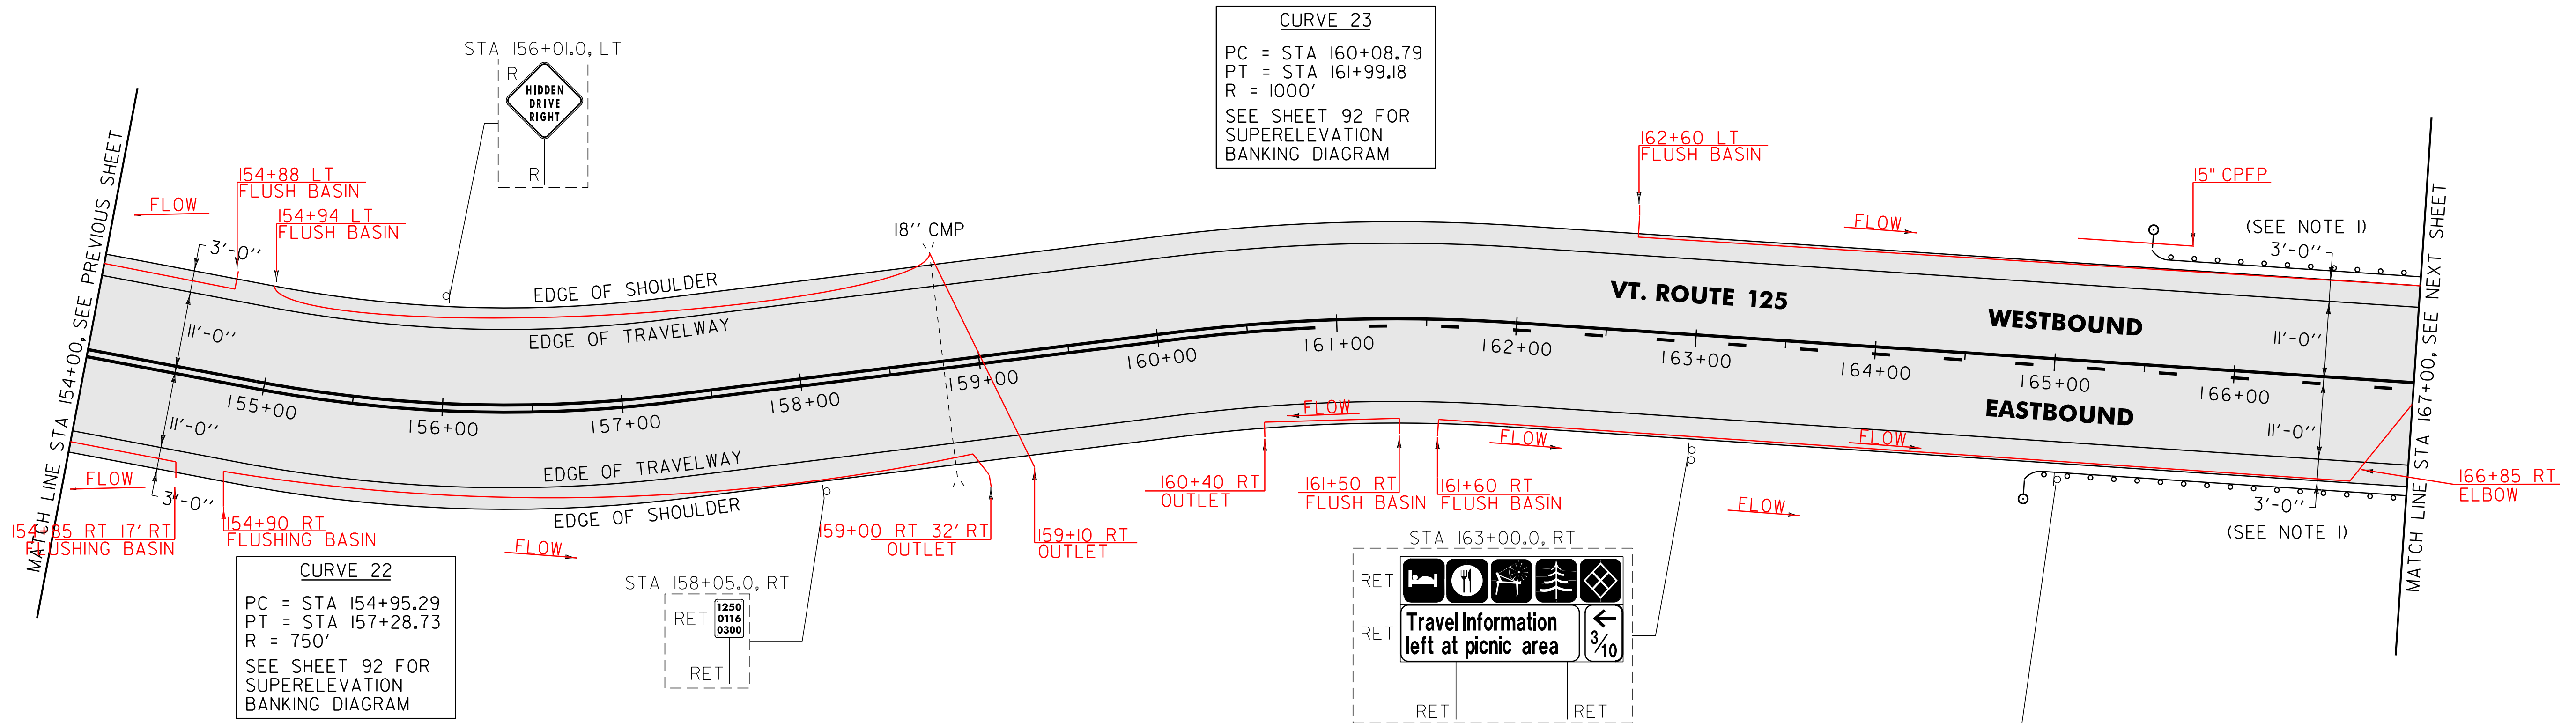

621.80 REMOVAL AND DISPOSAL OF GUARDRAIL  
 RIPTON:  
 STA 166+52.0 - STA 167+00.0 RT (48.0 LF)  
 STA 166+62.0 - STA 167+00.0 LT (38.0 LF)

676.10 DELINEATOR WITH STEEL POST  
 TYPE I WHITE  
 RIPTON:  
 STA 164+75.0 RT  
 STA 165+50.0 LT

900.620 SPECIAL PROVISION (MANUFACTURED TERMINAL SECTION, FLARED/WEATHERING)  
 RIPTON:  
 STA 164+75.0 - STA 165+12.5 RT  
 STA 165+50.0 - STA 165+87.5 LT

900.640 SPECIAL PROVISION (HD STEEL BEAM GUARDRAIL, WEATHERING/NESTED)  
 RIPTON:  
 STA 166+87.5 - STA 167+00.0 LT (12.5 LF)  
 STA 166+87.5 - STA 167+00.0 RT (12.5 LF)

900.640 SPECIAL PROVISION (STEEL BEAM GUARDRAIL, WEATHERING)  
 RIPTON:  
 STA 165+12.5 - STA 166+87.5 RT (175.0 LF)  
 STA 165+87.5 - STA 166+87.5 LT (100.0 LF)

NOTE:  
 I. SEE SHEET 114 FOR STEEL BEAM GUARDRAIL AT SMALL CULVERT DETAIL.

SIGN LEGEND  
 R = REMOVE  
 S = SALVAGE  
 N = NEW  
 RET = RETAIN  
 B-B = BACK TO BACK  
 EXISTING = - - - - -  
 NEW = \_\_\_\_\_

NOT TO SCALE

**PROJECT LAYOUT SHEET #13**

PROJECT NAME: RIPTON - HANCOCK	FILE NAME: p08cl60.dgn	PLOT DATE: 18-SEP-2013 17:10
PROJECT NUMBER: STP 2803(1)	PROJECT LEADER: D.E.G.	DRAWN BY: C.A.K.
	DESIGNED BY: M.J.M.	CHECKED BY: D.W.E.
	IPARM FILE: p08cl60113.1	SHEET 72 OF 114

AREA TO BE RECLAIMED