


646.402 DURABLE 4 INCH WHITE LINE, THERMOPLASTIC
 (ALL LINES WILL INCLUDE EDGE LINE BREAKS AND RADIUS FOR TOWN HIGHWAYS)
 RIPTON:
 STA 167+00.00 - STA 180+00.00 EDGE LINE LT & RT

646.412 DURABLE 4 INCH YELLOW LINE, THERMOPLASTIC
 (ALL LINES WILL INCLUDE C/L BREAKS FOR TOWN HIGHWAYS) S=SOLID, D=DASHED
 RIPTON:
 STA 167+00.00 - STA 167+38.00 S - D
 STA 167+38.00 - STA 167+90.00 S - S
 STA 167+90.00 - STA 174+77.00 D - S
 STA 174+77.00 - STA 180+00.00 S - S

646.602 TEMPORARY 4 INCH WHITE LINE, PAINT
 (ALL LINES WILL INCLUDE EDGE LINE BREAKS AND RADIUS FOR TOWN HIGHWAYS)
 RIPTON:
 STA 167+00.00 - STA 180+00.00 EDGE LINE LT & RT

646.612 TEMPORARY 4 INCH YELLOW LINE, PAINT
 (ALL LINES WILL INCLUDE C/L BREAKS FOR TOWN HIGHWAYS) S=SOLID, D=DASHED
 RIPTON:
 STA 167+00.00 - STA 167+38.00 S - D
 STA 167+38.00 - STA 167+90.00 S - S
 STA 167+90.00 - STA 174+77.00 D - S
 STA 174+77.00 - STA 180+00.00 S - S

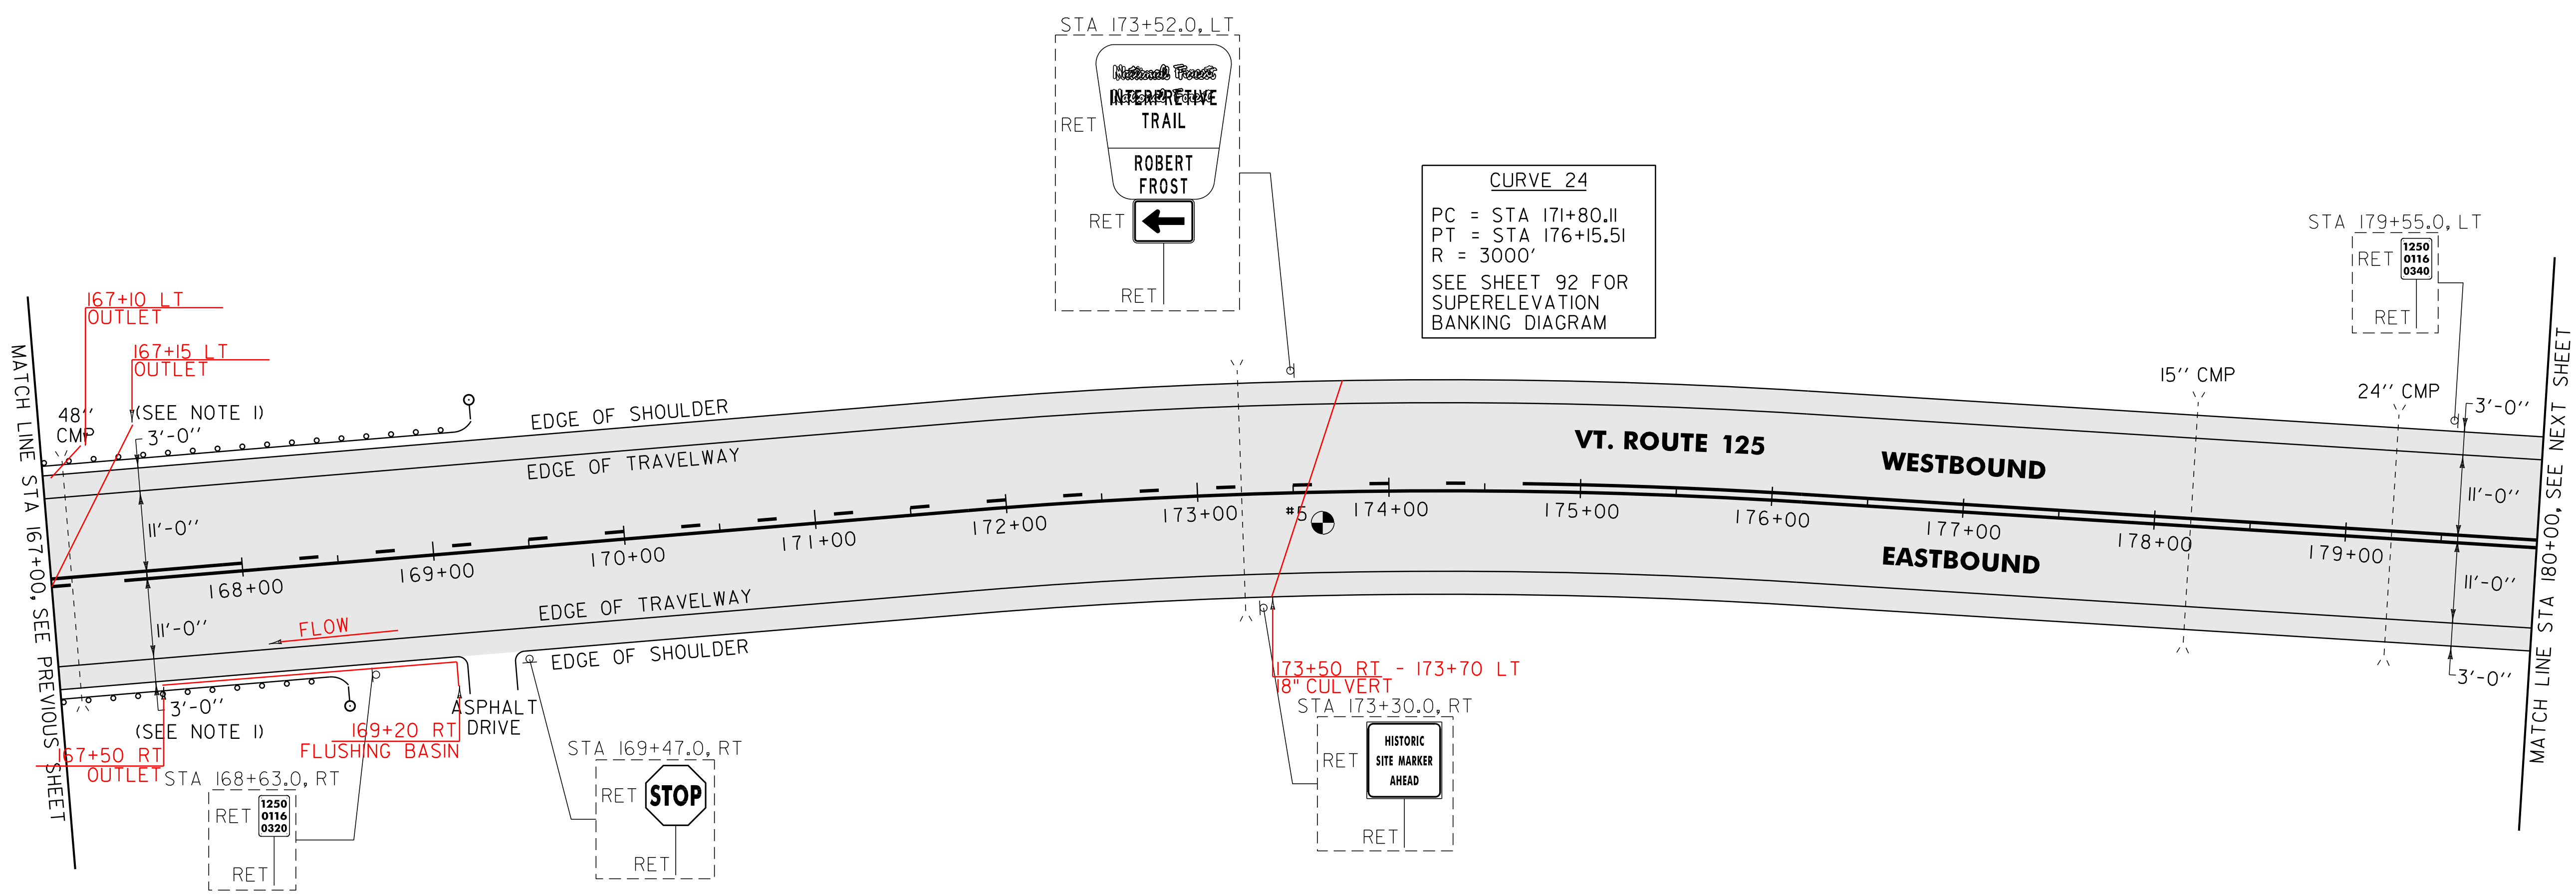

621.80 REMOVAL AND DISPOSAL OF GUARDRAIL
 RIPTON:
 STA 167+00.0 - STA 167+40.0 LT (40.0 LF)
 STA 167+00.0 - STA 167+74.0 RT (74.0 LF)

676.10 DELINEATOR WITH STEEL POST
 TYPE 1 WHITE
 RIPTON:
 STA 168+50.0 RT
 STA 169+25.0 LT

900.620 SPECIAL PROVISION (MANUFACTURED TERMINAL SECTION, FLARED/WEATHERING)
 RIPTON:
 STA 168+12.5 - STA 168+50.0 RT
 STA 168+87.5 - STA 169+25.0 LT

900.640 SPECIAL PROVISION (STEEL BEAM GUARDRAIL, WEATHERING)
 RIPTON:
 STA 167+12.5 - STA 168+12.5 RT (100.0 LF)
 STA 167+12.5 - STA 168+87.5 LT (175.0 LF)

900.640 SPECIAL PROVISION (HD STEEL BEAM GUARDRAIL, WEATHERING/NESTED)
 RIPTON:
 STA 167+00.0 - STA 167+12.5 LT (12.5 LF)
 STA 167+00.0 - STA 167+12.5 RT (12.5 LF)

PAVEMENT CORES =

TOTAL PCC COMMENTS DEPTH (INCH)

5 6 1/4" NO

SIGN LEGEND
 R = REMOVE
 S = SALVAGE
 N = NEW
 RET = RETAIN
 B-B = BACK TO BACK
 EXISTING =
 NEW =

NOT TO SCALE

PROJECT LAYOUT SHEET #14

NOTE:
 I. SEE SHEET 114 FOR NESTED GUARDRAIL DETAIL.

PROJECT NAME: RIPTON - HANCOCK	FILE NAME: p08cl60.dgn	PLOT DATE: 18-SEP-2013 17:10
PROJECT NUMBER: STP 2803(1)	PROJECT LEADER: D.E.G.	DRAWN BY: C.A.K.
	DESIGNED BY: M.J.M.	CHECKED BY: D.W.E.
	IPARM FILE: p08cl60114.1	SHEET 73 OF 114

AREA TO BE RECLAIMED