


646.402 DURABLE 4 INCH WHITE LINE, THERMOPLASTIC
 (ALL LINES WILL INCLUDE EDGE LINE BREAKS AND RADIUS FOR TOWN HIGHWAYS)
 RIPTON:
 STA 232+00.00 - STA 245+00.00 EDGE LINE LT & RT

646.412 DURABLE 4 INCH YELLOW LINE, THERMOPLASTIC
 (ALL LINES WILL INCLUDE C/L BREAKS FOR TOWN HIGHWAYS) S=SOLID, D=DASHED
 RIPTON:
 STA 232+00.00 - STA 245+00.00 LT CL RT
 S - S

646.602 TEMPORARY 4 INCH WHITE LINE, PAINT
 (ALL LINES WILL INCLUDE EDGE LINE BREAKS AND RADIUS FOR TOWN HIGHWAYS)
 RIPTON:
 STA 232+00.00 - STA 245+00.00 EDGE LINE LT & RT

646.612 TEMPORARY 4 INCH YELLOW LINE, PAINT
 (ALL LINES WILL INCLUDE C/L BREAKS FOR TOWN HIGHWAYS) S=SOLID, D=DASHED
 RIPTON:
 STA 232+00.00 - STA 245+00.00 LT CL RT
 S - S

675.50 REMOVING SIGNS
 AS SHOWN - 3

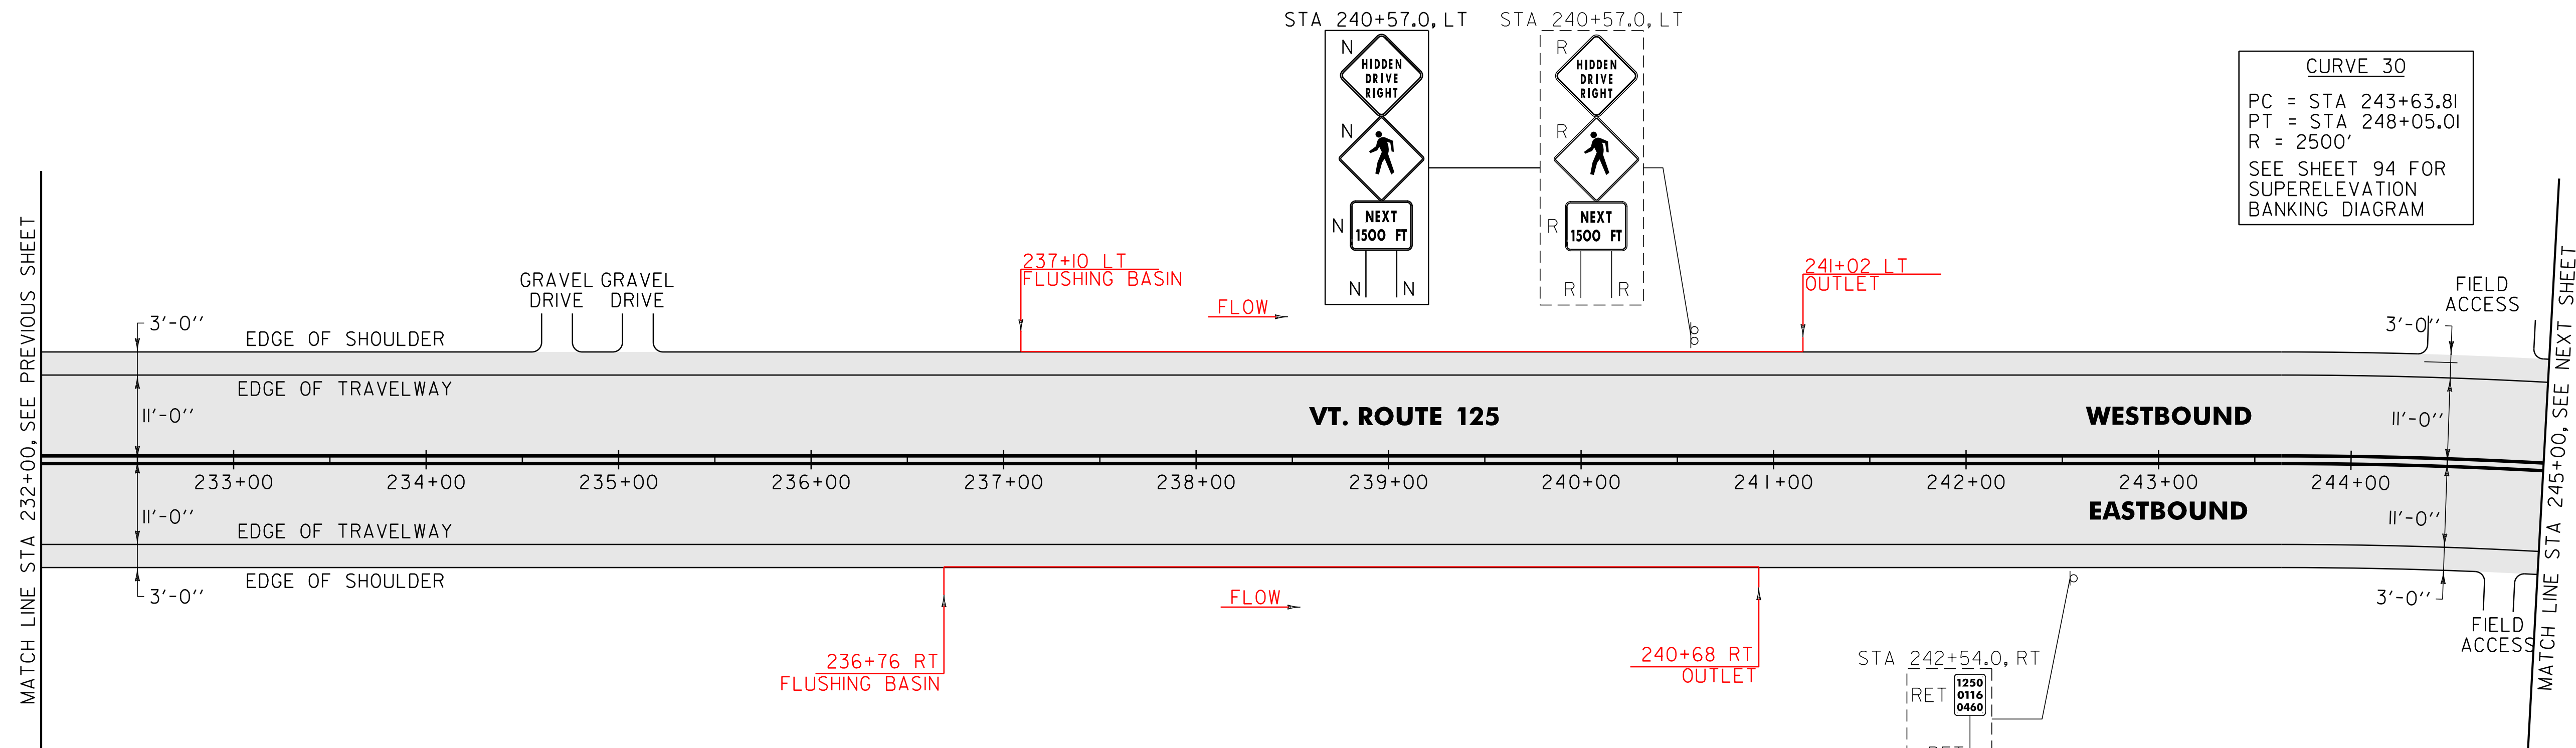

CURVE 30
 PC = STA 243+63.81
 PT = STA 248+05.01
 R = 2500'
 SEE SHEET 94 FOR SUPERELEVATION BANKING DIAGRAM

MATCH LINE STA 232+00, SEE PREVIOUS SHEET

MATCH LINE STA 245+00, SEE NEXT SHEET

AREA TO BE RECLAIMED

SIGN LEGEND
 R = REMOVE
 S = SALVAGE
 N = NEW
 RET = RETAIN
 B-B = BACK TO BACK
 EXISTING = - - - - -
 NEW = _____

NOT TO SCALE

PROJECT LAYOUT SHEET #19	PROJECT NAME: RIPTON - HANCOCK	PLOT DATE: 18-SEP-2013 17:10
	PROJECT NUMBER: STP 2803(1)	DRAWN BY: C.A.K.
	FILE NAME: p08cl60.dgn	CHECKED BY: D.W.E.
	PROJECT LEADER: D.E.G.	SHEET 78 OF 114
	DESIGNED BY: M.J.M.	
	IPARM FILE: p08cl60119.i	