


646.402 DURABLE 4 INCH WHITE LINE, THERMOPLASTIC
 (ALL LINES WILL INCLUDE EDGE LINE BREAKS AND RADIUS FOR TOWN HIGHWAYS)
 HANCOCK:
 STA 20+00.00 - STA 32+50.00 EDGE LINE LT & RT

646.412 DURABLE 4 INCH YELLOW LINE, THERMOPLASTIC
 (ALL LINES WILL INCLUDE C/L BREAKS FOR TOWN HIGHWAYS) S=SOLID, D=DASHED
 HANCOCK:
 STA 20+00.00 - STA 32+50.00 LT C RT S - S

646.602 TEMPORARY 4 INCH WHITE LINE, PAINT
 (ALL LINES WILL INCLUDE EDGE LINE BREAKS AND RADIUS FOR TOWN HIGHWAYS)
 HANCOCK:
 STA 20+00.00 - STA 32+50.00 EDGE LINE LT & RT

646.612 TEMPORARY 4 INCH YELLOW LINE, PAINT
 (ALL LINES WILL INCLUDE C/L BREAKS FOR TOWN HIGHWAYS) S=SOLID, D=DASHED
 HANCOCK:
 STA 20+00.00 - STA 32+50.00 LT C RT S - S

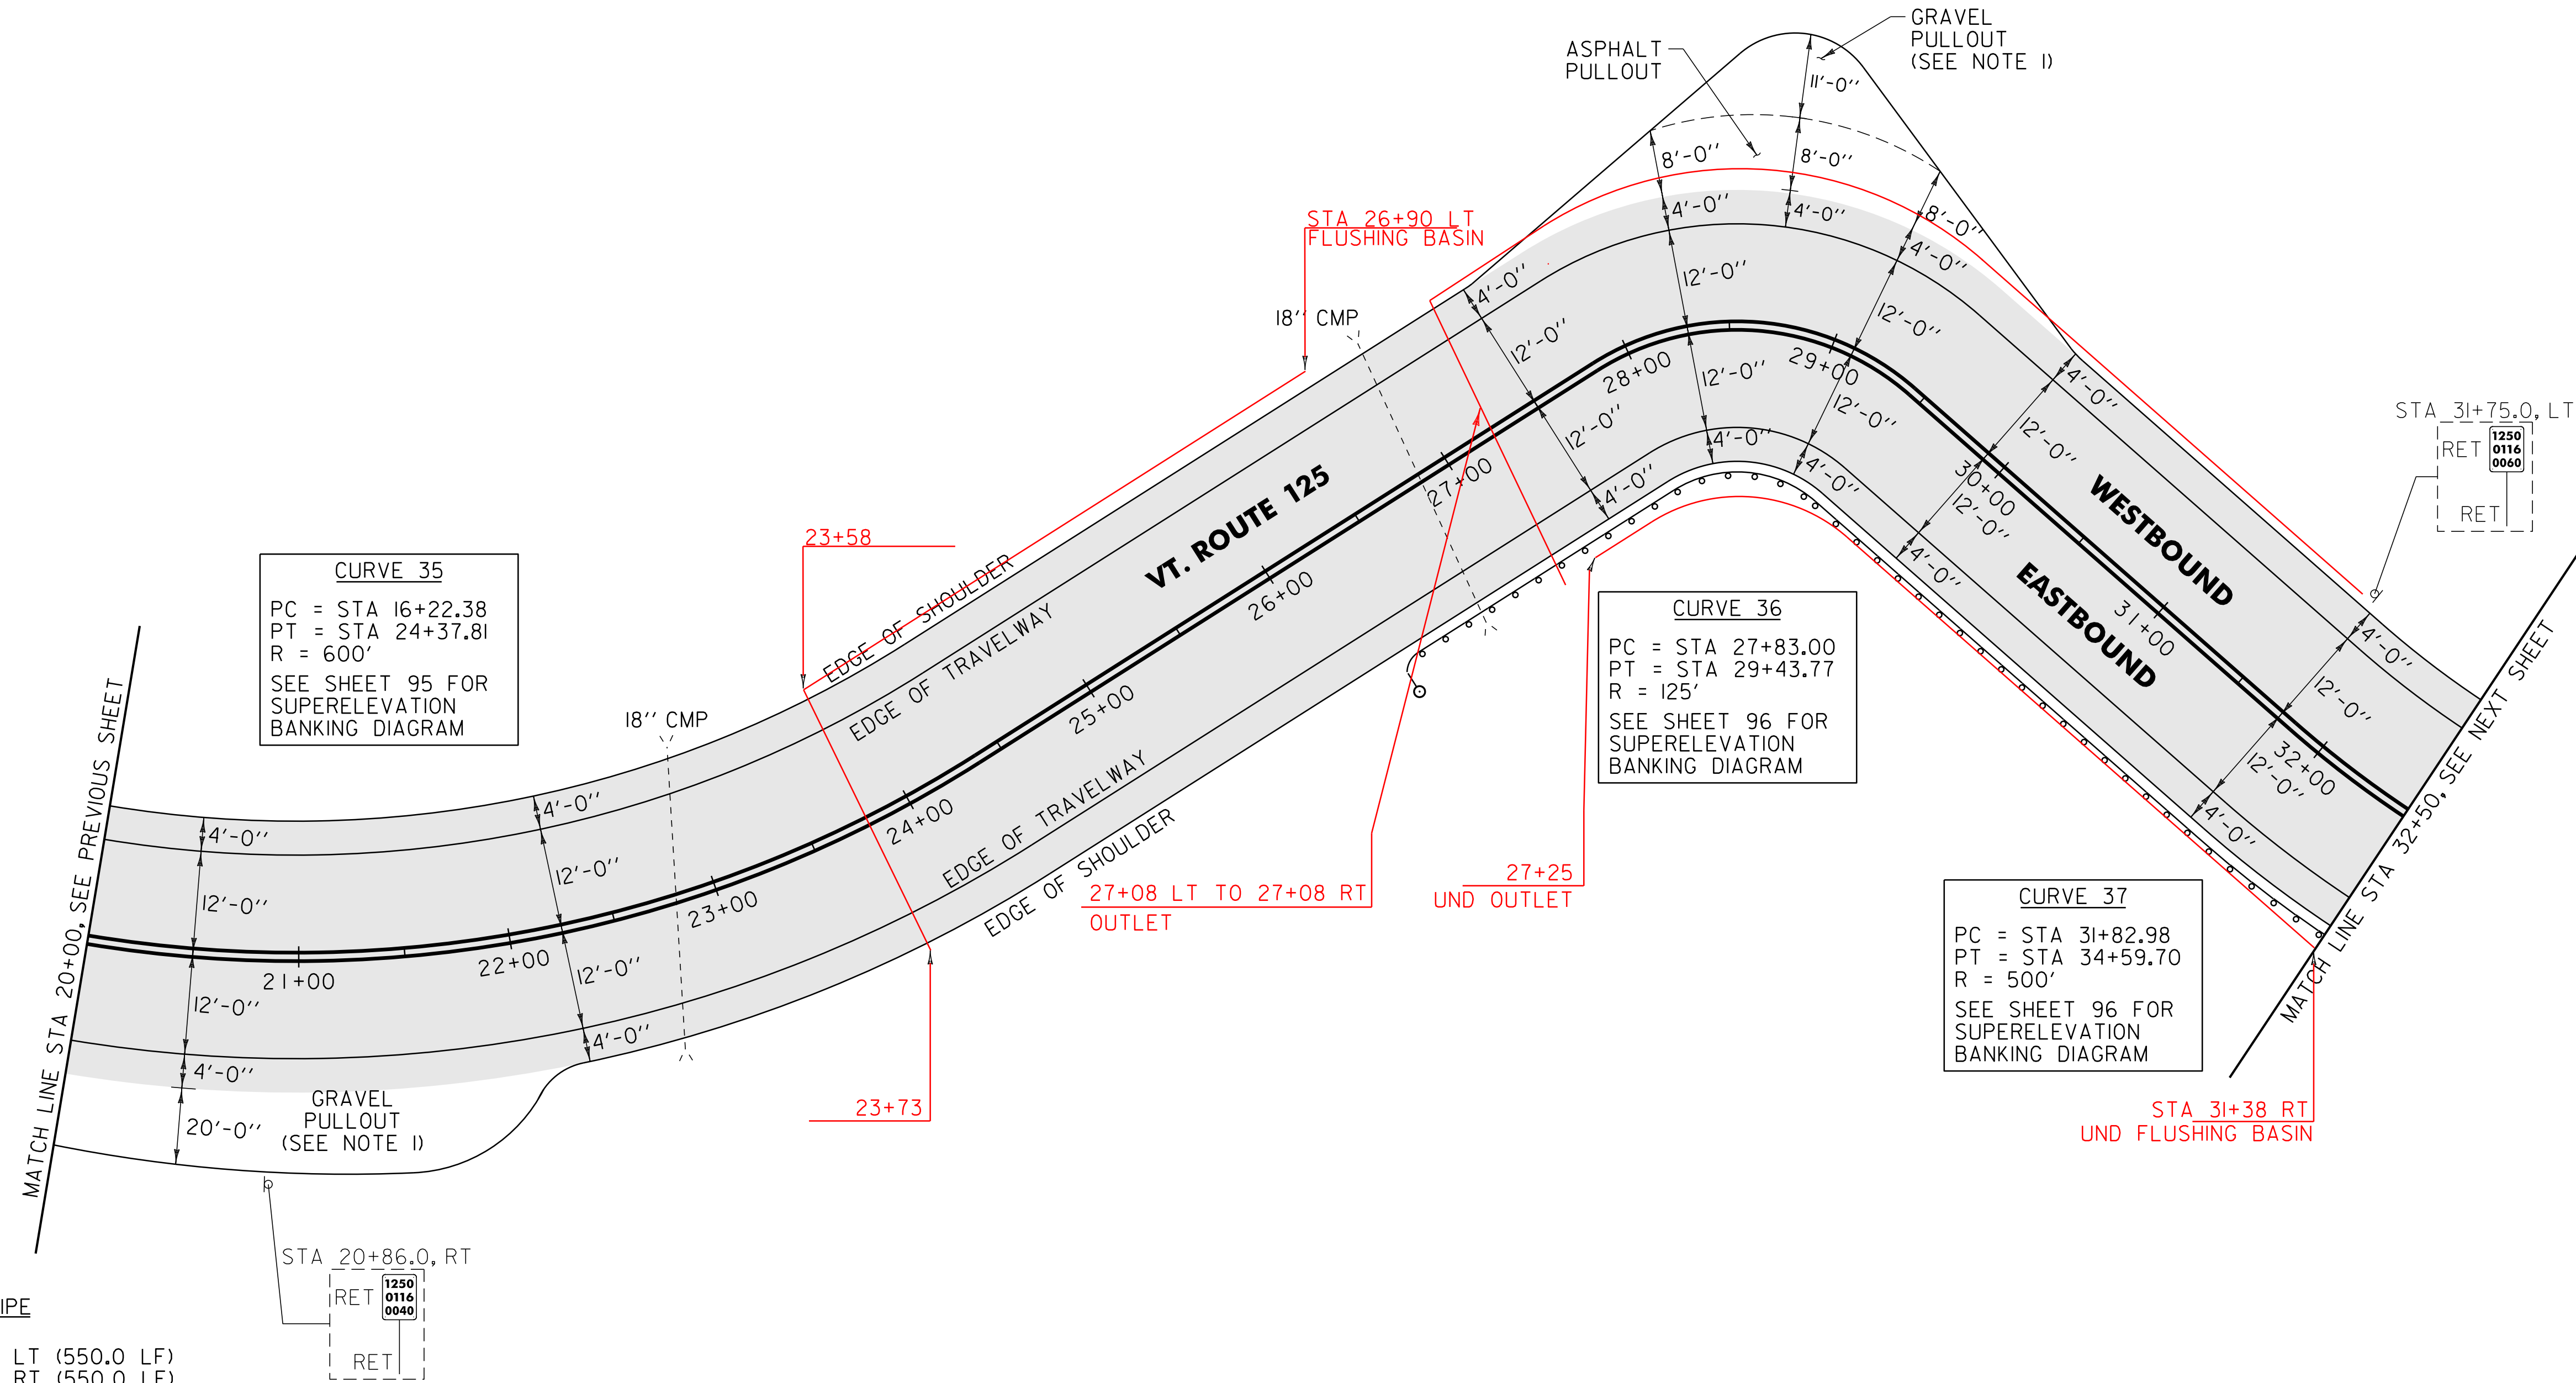

CURVE 35
 PC = STA 16+22.38
 PT = STA 24+37.81
 R = 600'
 SEE SHEET 95 FOR SUPERELEVATION BANKING DIAGRAM

CURVE 36
 PC = STA 27+83.00
 PT = STA 29+43.77
 R = 125'
 SEE SHEET 96 FOR SUPERELEVATION BANKING DIAGRAM

CURVE 37
 PC = STA 31+82.98
 PT = STA 34+59.70
 R = 500'
 SEE SHEET 96 FOR SUPERELEVATION BANKING DIAGRAM

605.10 6 INCH UNDERDRAIN PIPE
 HANCOCK:
 STA 26+00.0 - STA 31+50.0 LT (550.0 LF)
 STA 26+00.0 - STA 31+50.0 RT (550.0 LF)

621.80 REMOVAL AND DISPOSAL OF GUARDRAIL
 HANCOCK:
 STA 26+31.0 STA 32+50.0 RT (619.0 LF)

676.10 DELINEATOR WITH STEEL POST
 TYPE I WHITE
 HANCOCK:
 STA 26+31.0 RT

900.620 SPECIAL PROVISION (MANUFACTURED TERMINAL SECTION, FLARED/WEATHERING)
 HANCOCK:
 STA 26+31.0 - STA 26+68.5 RT

900.640 SPECIAL PROVISION (STEEL BEAM GUARDRAIL, WEATHERING)
 HANCOCK:
 STA 26+68.5 - STA 32+50.0 RT (581.5 LF)

NOTE:

1. PAVE THE ENTIRE EXISTING GRAVEL PULLOUT WITH 1/2" TYPE IVS. ANY REQUIRED EXCAVATION SHALL BE PERFORMED AS DIRECTED BY THE RESIDENT ENGINEER AND PAID FOR UNDER ITEM 608.25 ALL PURPOSE EXCAVATOR RENTAL, TYPE I.

SIGN LEGEND
 R = REMOVE
 S = SALVAGE
 N = NEW
 RET = RETAIN
 B-B = BACK TO BACK
 EXISTING = - - - - -
 NEW = _____

NOT TO SCALE

PROJECT LAYOUT SHEET #26	PROJECT NAME: RIPTON - HANCOCK	PLOT DATE: 18-SEP-2013 17:10
	PROJECT NUMBER: STP 2803(1)	DRAWN BY: C.A.K.
	FILE NAME: p08cl60.dgn	CHECKED BY: D.W.E.
	PROJECT LEADER: D.E.G.	SHEET 85 OF 114
	DESIGNED BY: M.J.M.	
	IPARM FILE: p08cl60126.i	

AREA TO BE RECLAIMED