


646.402 DURABLE 4 INCH WHITE LINE, THERMOPLASTIC
 (ALL LINES WILL INCLUDE EDGE LINE BREAKS AND
 RADIUS FOR TOWN HIGHWAYS)
 HANCOCK:
 STA 32+50.00 - STA 39+60.00 EDGE LINE LT & RT

646.412 DURABLE 4 INCH YELLOW LINE, THERMOPLASTIC
 (ALL LINES WILL INCLUDE C/L BREAKS FOR
 TOWN HIGHWAYS) S=SOLID, D=DASHED
 HANCOCK: LT C RT
 STA 32+50.00 - STA 39+60.00 S - S

646.602 TEMPORARY 4 INCH WHITE LINE, PAINT
 (ALL LINES WILL INCLUDE EDGE LINE BREAKS AND
 RADIUS FOR TOWN HIGHWAYS)
 HANCOCK:
 STA 32+50.00 - STA 39+60.00 EDGE LINE LT & RT

646.612 TEMPORARY 4 INCH YELLOW LINE, PAINT
 (ALL LINES WILL INCLUDE C/L BREAKS FOR
 TOWN HIGHWAYS) S=SOLID, D=DASHED
 HANCOCK: LT C RT
 STA 32+50.00 - STA 39+60.00 S - S

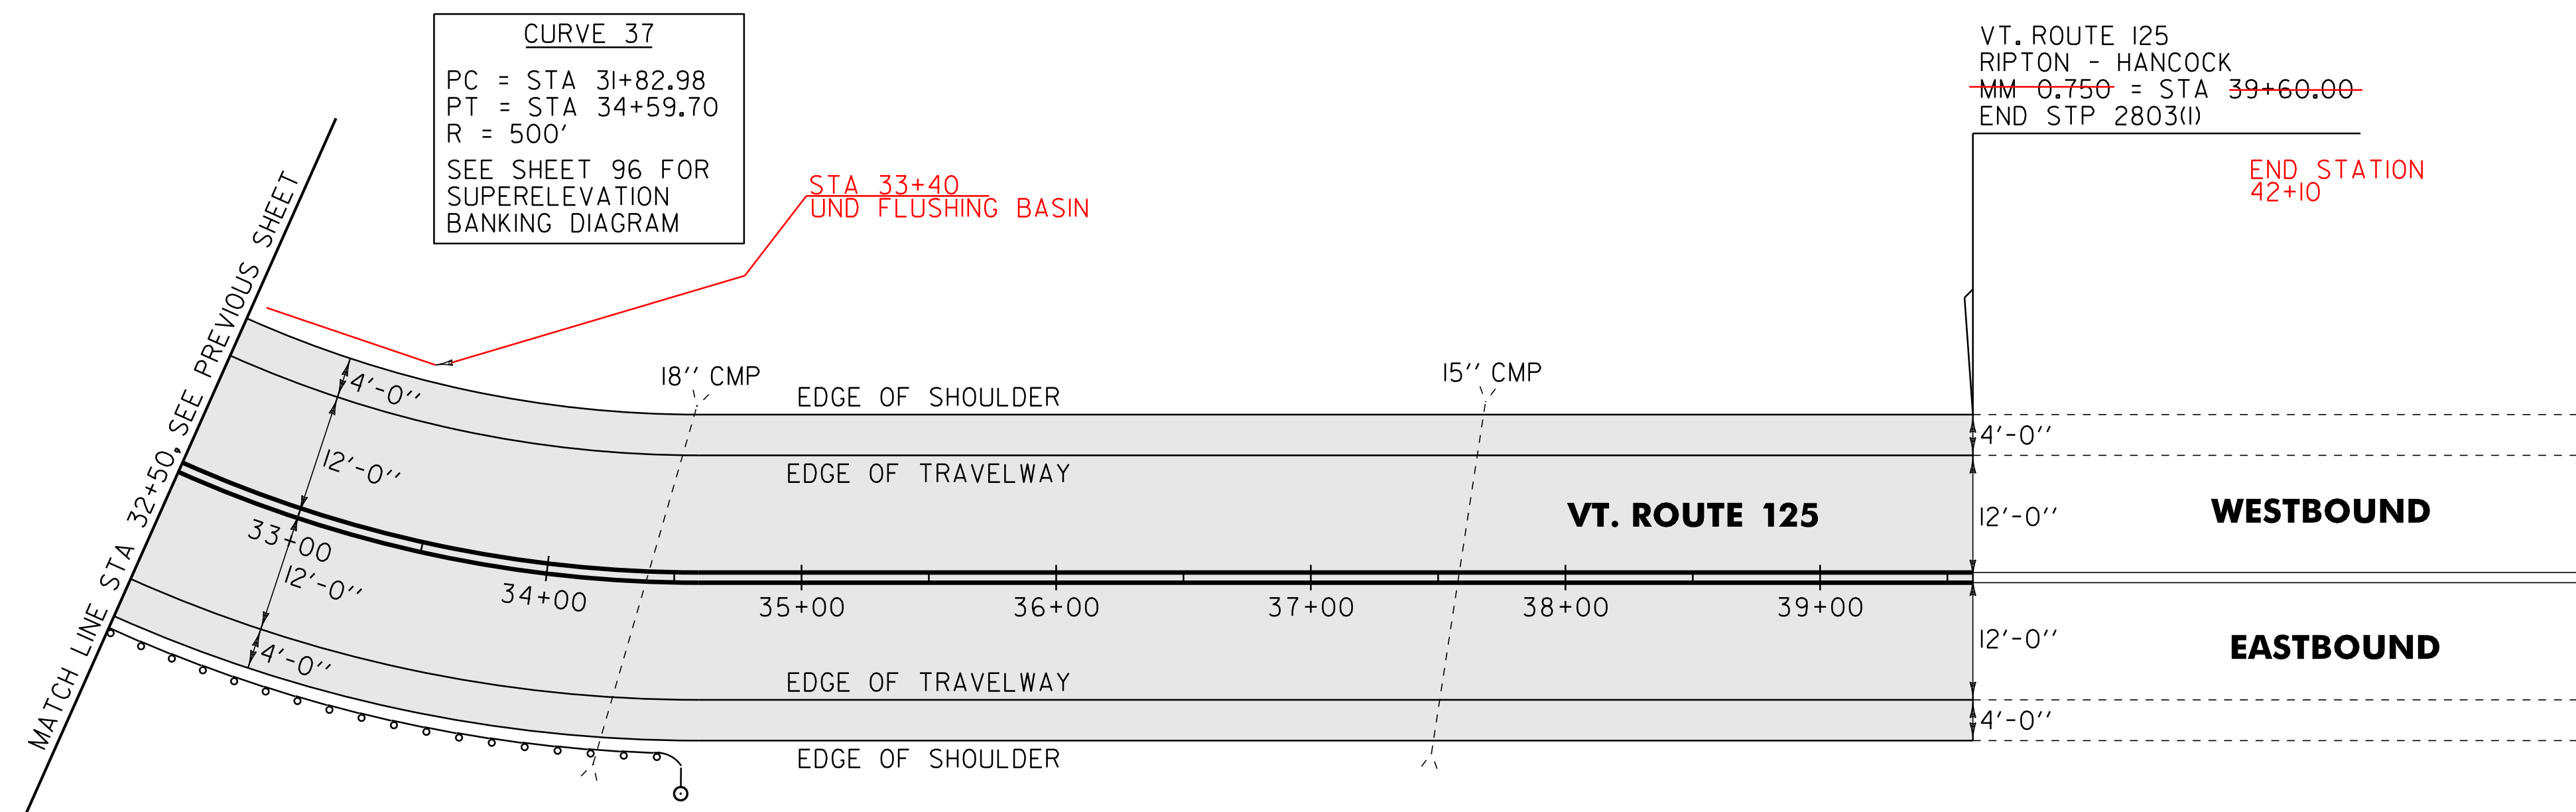

621.80 REMOVAL AND DISPOSAL OF GUARDRAIL
 HANCOCK:
 STA 32+50.0 - STA 34+54.0 RT (204.0 LF)

676.10 DELINEATOR WITH STEEL POST
 TYPE 1 WHITE
 HANCOCK:
 STA 34+56.0 RT

900.620 SPECIAL PROVISION (MANUFACTURED TERMINAL SECTION, FLARED/WEATHERING)
 HANCOCK:
 STA 34+18.5 - STA 34+56.0 RT

900.640 SPECIAL PROVISION (STEEL BEAM GUARDRAIL, WEATHERING)
 HANCOCK:
 STA 32+50.0 - STA 34+18.5 RT (168.5 LF)

SIGN LEGEND
 R = REMOVE
 S = SALVAGE
 N = NEW
 RET = RETAIN
 B-B = BACK TO BACK
 EXISTING = -----
 NEW = _____

NOT TO SCALE

**PROJECT
 LAYOUT
 SHEET #27**

PROJECT NAME: RIPTON - HANCOCK
 PROJECT NUMBER: STP 2803(I)

FILE NAME: p08cl60.dgn
 PROJECT LEADER: D.E.G.
 DESIGNED BY: M.J.M.
 IPARM FILE: p08cl60i27.i

PLOT DATE: 18-SEP-2013 17:10
 DRAWN BY: C.A.K.
 CHECKED BY: D.W.E.
 SHEET 86 OF 114

AREA TO BE RECLAIMED