


LEGEND	
— AER EXT —	AERIAL ELECTRIC & TELEPHONE
○ ○ ○	LIMITS OF SOIL DISTURBANCE
	PERMANENT EROSION MATTING, DISTURBED AREAS REQUIRING RE-VEGETATION
	GABION RETAINING WALL
	2'-0" STONE FILL, TYPE II WITH GRUBBING MATERIAL
	3'-0" STONE FILL, TYPE III
-----	RIPARIAN BUFFER ZONE

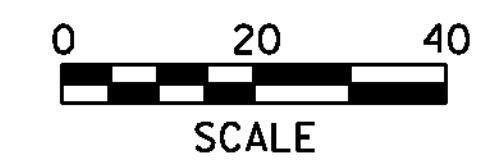

EPSC FINAL CONDITIONS SITE PLAN

PROJECT NAME:	IRASBURG	FILE NAME:	...drawing\z08cl94ero.dgn	PLOT DATE:	10/28/2010
PROJECT NUMBER:	STP CULV(20)	PROJECT LEADER:	G. BOGUE	DRAWN BY:	J. SOTER
		DESIGNED BY:	M. CHENETTE	CHECKED BY:	T. KNIGHT
			EPSC FINAL CONDITIONS SITE PLAN		SHEET 11 OF 15