



INDEX OF SHEETS
SEE SHEET 2

VAOT STANDARD SHEETS
SEE SHEET 2

STATE OF VERMONT AGENCY OF TRANSPORTATION

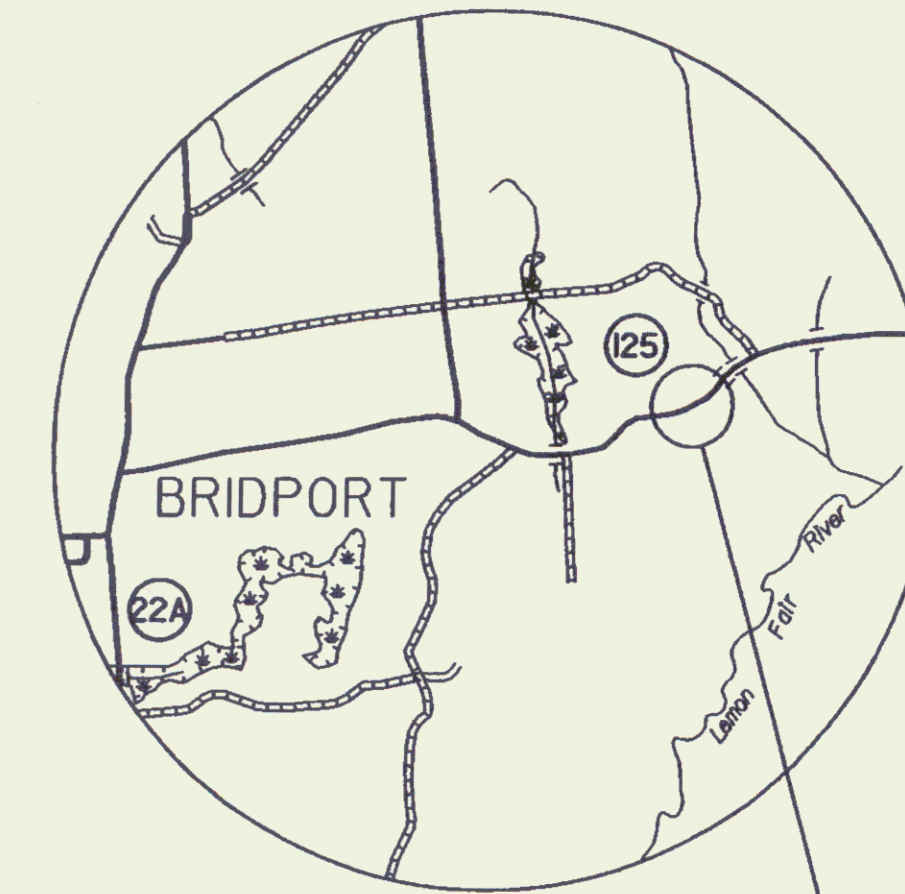

LOCATION MAP
NOT TO SCALE

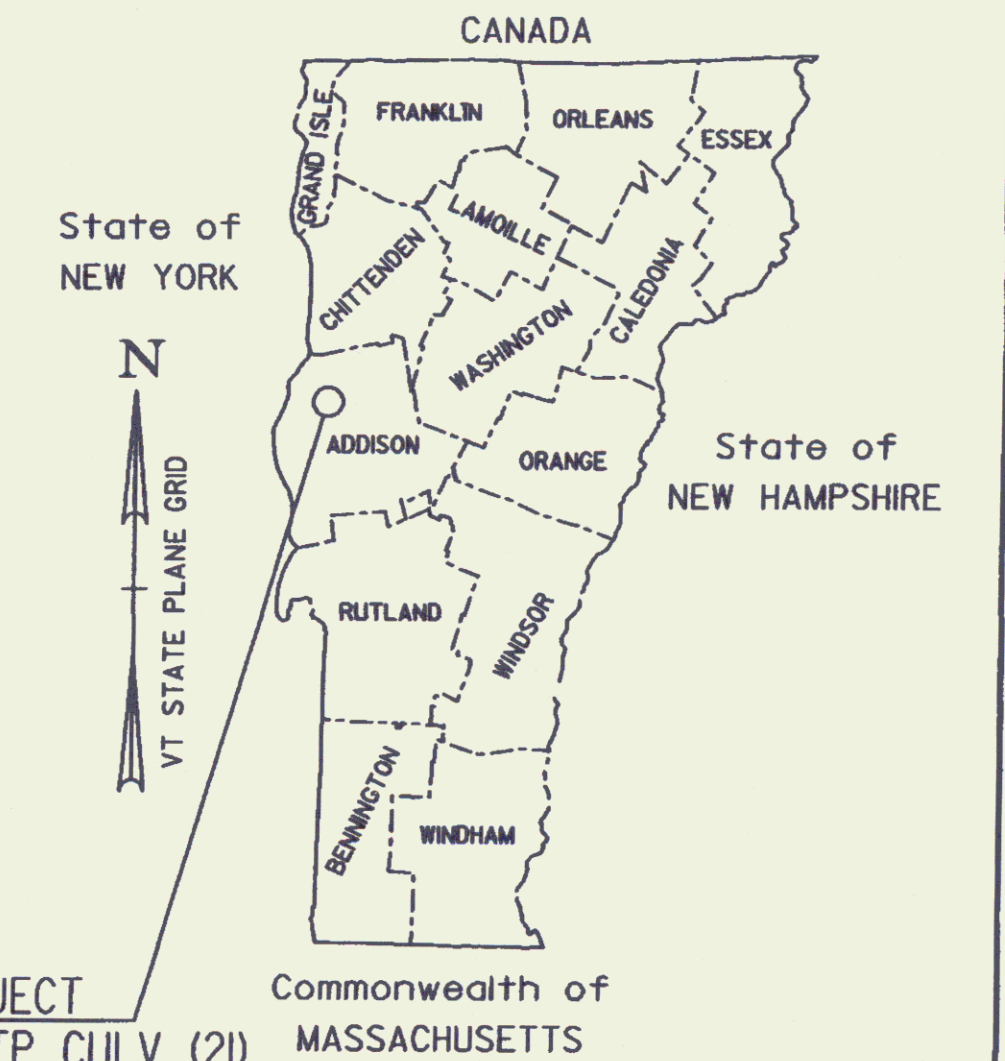

PROJECT
BRIDPORT STP CULV (21)

Commonwealth of
MASSACHUSETTS

PROPOSED IMPROVEMENT CULVERT REHABILITATION PROJECT TOWN OF BRIDPORT COUNTY OF ADDISON VERMONT ROUTE 125 (MAJOR COLLECTOR)

RECORD PLANS

CONTRACTOR: CHAMPLAIN CONSTRUCTION CO. - MIDDLEBURY, VT

RESIDENT ENGINEER: JOE KNIPES

CONSTRUCTION BEGAN: JULY 28, 2011

CONSTRUCTION COMPLETE: NOVEMBER 16, 2011

RECORD PLANS BY: JOE KNIPES & JENNA HYDE

I HEREBY CERTIFY THAT ALL THE CONSTRUCTION REQUIRED BY THIS SET OF DRAWINGS HAS BEEN ACCOMPLISHED AS INDICATED HEREIN.

BY: *[Signature]* RESIDENT ENGINEER


DATE: 5-20-13

NOTE: Any further information concerning final quantities, amounts or other details relative to this project may be found at Central Files in the electronic archives.

PROJECT LOCATION: WORK TO BE PERFORMED ON VERMONT ROUTE 125, 2.2 MILES EAST OF THE JUNCTION WITH VERMONT ROUTE 22A.

PROJECT DESCRIPTION: THIS PROJECT INCLUDES THE PARTIAL REMOVAL AND FILLING OF APPROXIMATELY 56 FEET OF 72" DIA. CULVERT, AND RELATED ROADWAY AND GUARDRAIL RECONSTRUCTION.

LENGTH OF PROJECT: 66 FEET

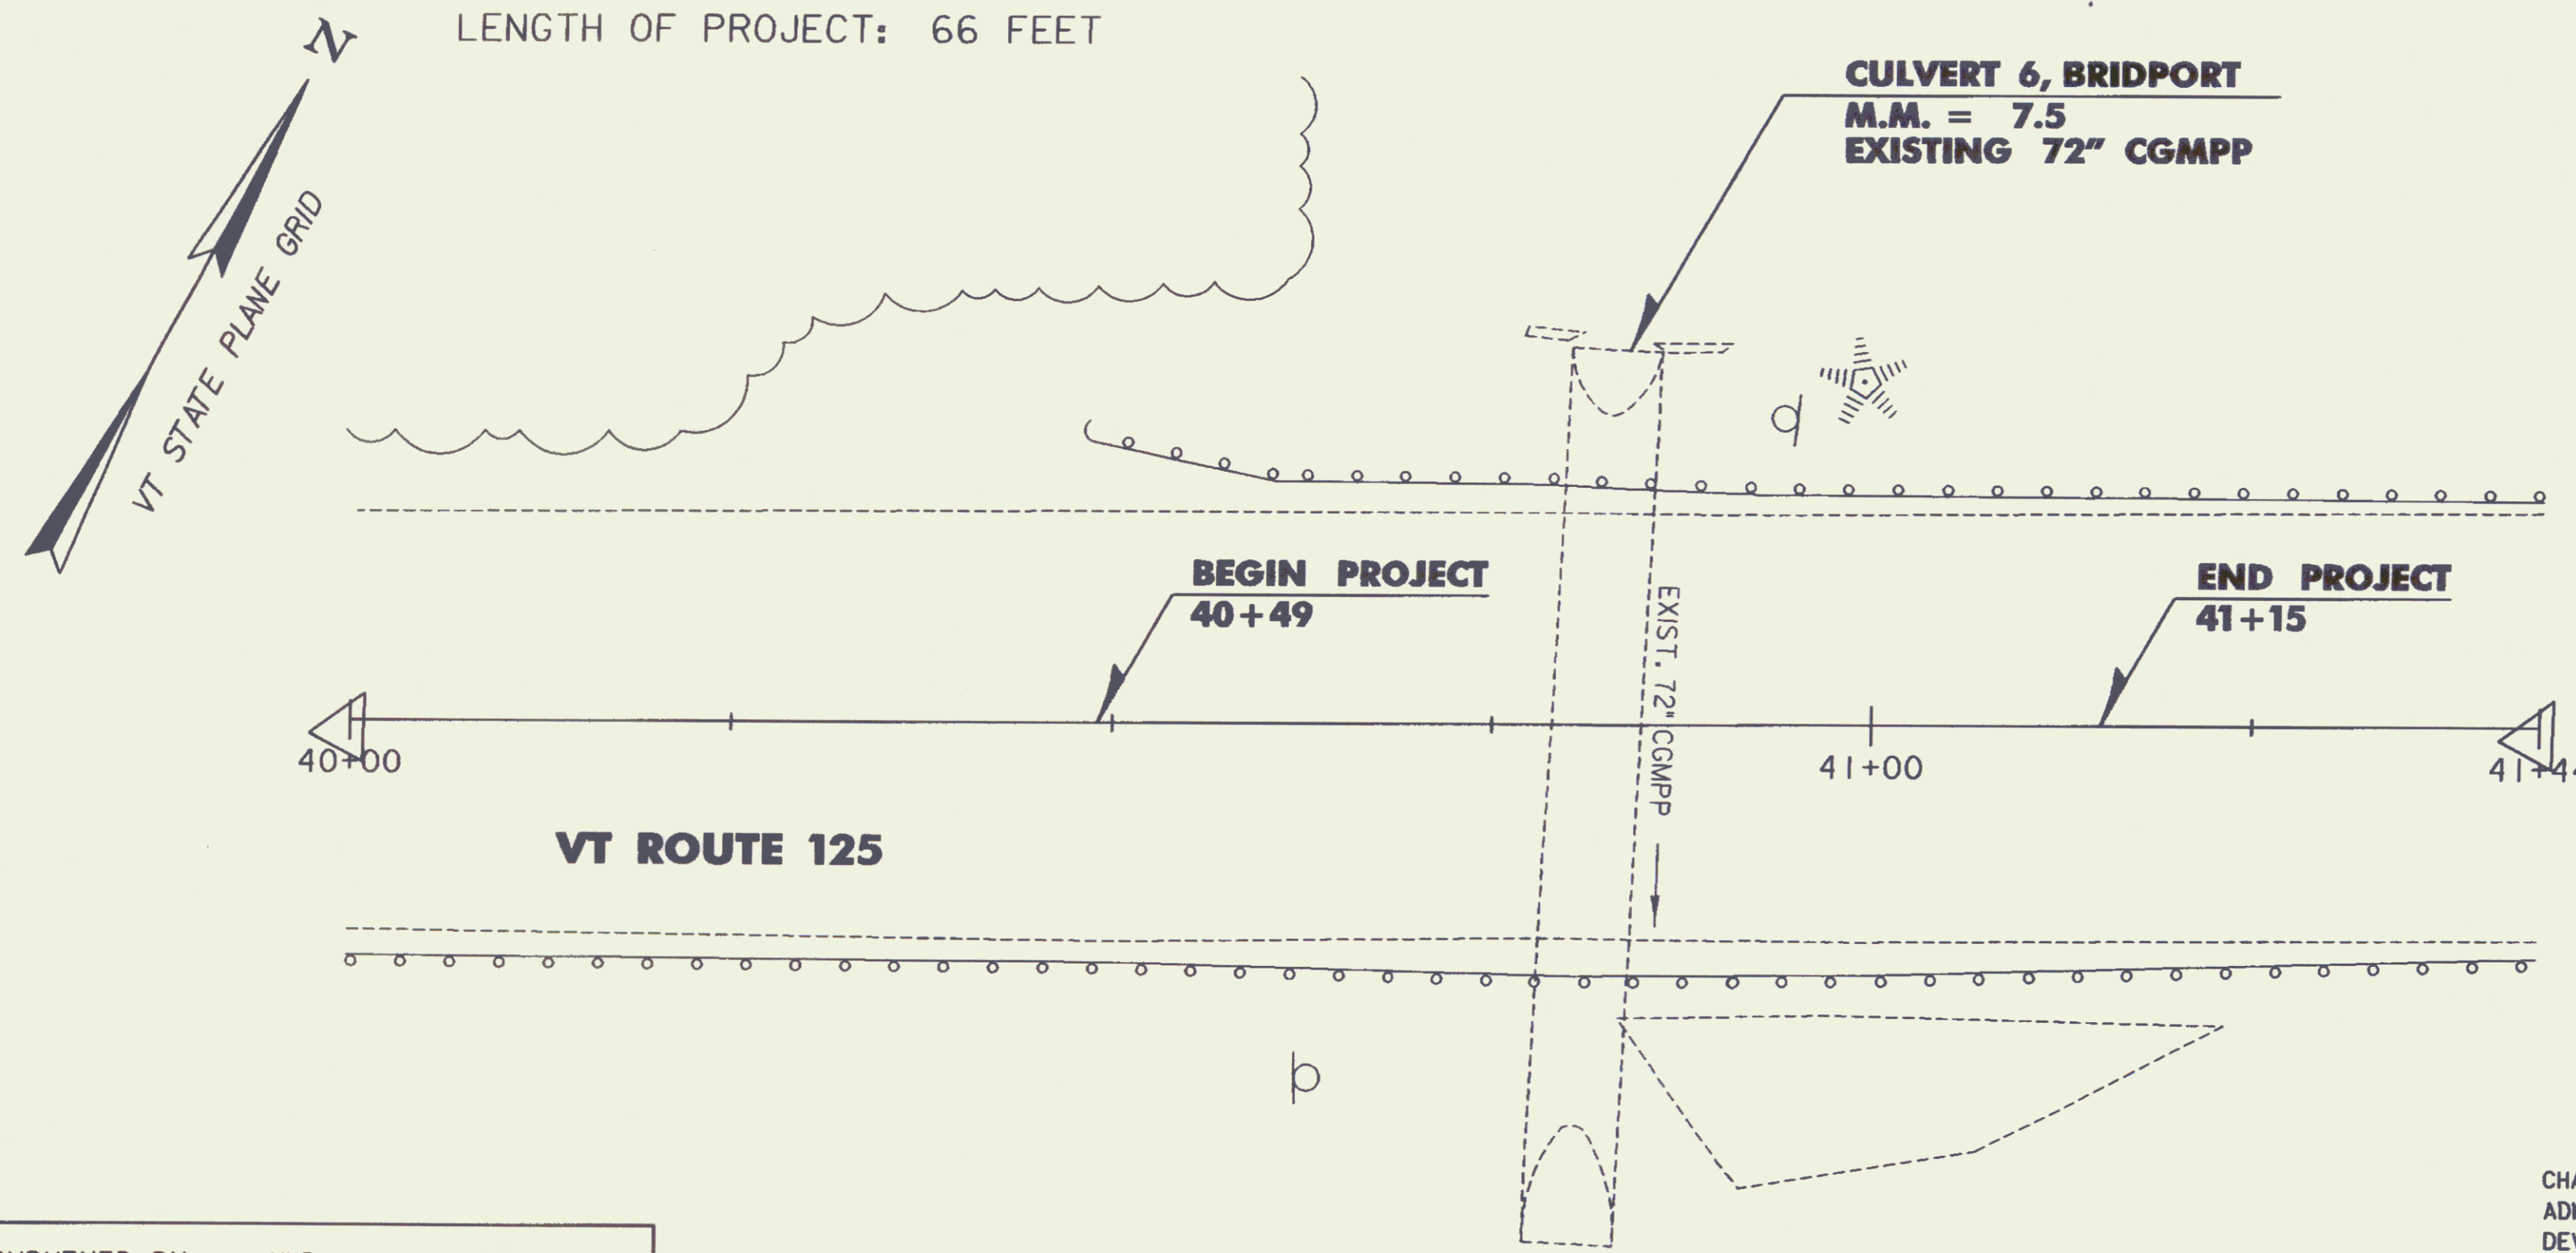

QUALITY ASSURANCE PROGRAM: LEVEL 2

CONVENTIONAL SYMBOLS

COUNTY LINE	
TOWN LINE	
LIMITS OF ACCESS	
POINT OF ACCESS	
FENCE LINE	
STONE WALL	
TRAVELED WAY	
GUARD RAIL	
RAILROAD	
SURVEY LINE	
CULVERT	
POWER POLE	
TELEPHONE POLE	
TREES	
CONTROL OF ACCESS	
PROPERTY LINE	
R.O.W. TAKING LINE	
SLOPE RIGHTS	
TOP OF CUT	
TOE OF SLOPE	

SURVEYED BY: VHB
SURVEYED DATE: DECEMBER 2008

DATUM
VERTICAL ASSUMED
HORIZONTAL ASSUMED



THESE PLANS ARE SUBJECT TO SUCH ENGINEERING CHANGES AS MAY BE REQUIRED BY THE FEDERAL HIGHWAY ADMINISTRATION OR THE DIRECTOR OF PROGRAM DEVELOPMENT.

CONSTRUCTION IS TO BE CARRIED ON IN ACCORDANCE WITH THESE PLANS AND THE STANDARD SPECIFICATIONS FOR CONSTRUCTION DATED 2006, AS APPROVED BY THE FEDERAL HIGHWAY ADMINISTRATION ON JUNE 15, 2006 FOR USE ON THIS PROJECT, INCLUDING ALL SUBSEQUENT REVISIONS AND SUCH REVISED SPECIFICATIONS AND SPECIAL PROVISIONS AS ARE INCORPORATED IN THESE PLANS.



DIRECTOR OF PROGRAM DEVELOPMENT
APPROVED: *[Signature]* DATE 11-3-10

PROJECT MANAGER: MARK SARGENT

PROJECT NAME: BRIDPORT
PROJECT NUMBER: STP CULV (21)

SHEET 1 OF 14 SHEETS