


**SOIL CLASSIFICATION**  
 VERGENNES CLAY  
 25-50% SLOPES  
 \*K FACTOR\* .49  
 CLASSIFIED HIGHLY ERODIBLE

**LEGEND**  
 - - - - - RIPARIAN BUFFER ZONE  
 —▲— CLASS III WETLAND LIMITS

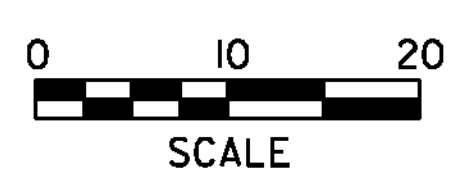

**EPSC EXISTING CONDITIONS SITE PLAN**

PROJECT NAME: BRIDPORT  
 PROJECT NUMBER: STP CULV(2)

FILE NAME: ...\\4-erosion control\sheets.dgn PLOT DATE: 10/7/2010  
 PROJECT LEADER: G. BOGUE DRAWN BY: E. ALLING  
 DESIGNED BY: M. CHENETTE CHECKED BY: M. CHENETTE  
**EPSC EXISTING CONDITIONS SITE PLAN** SHEET 8 OF 14